




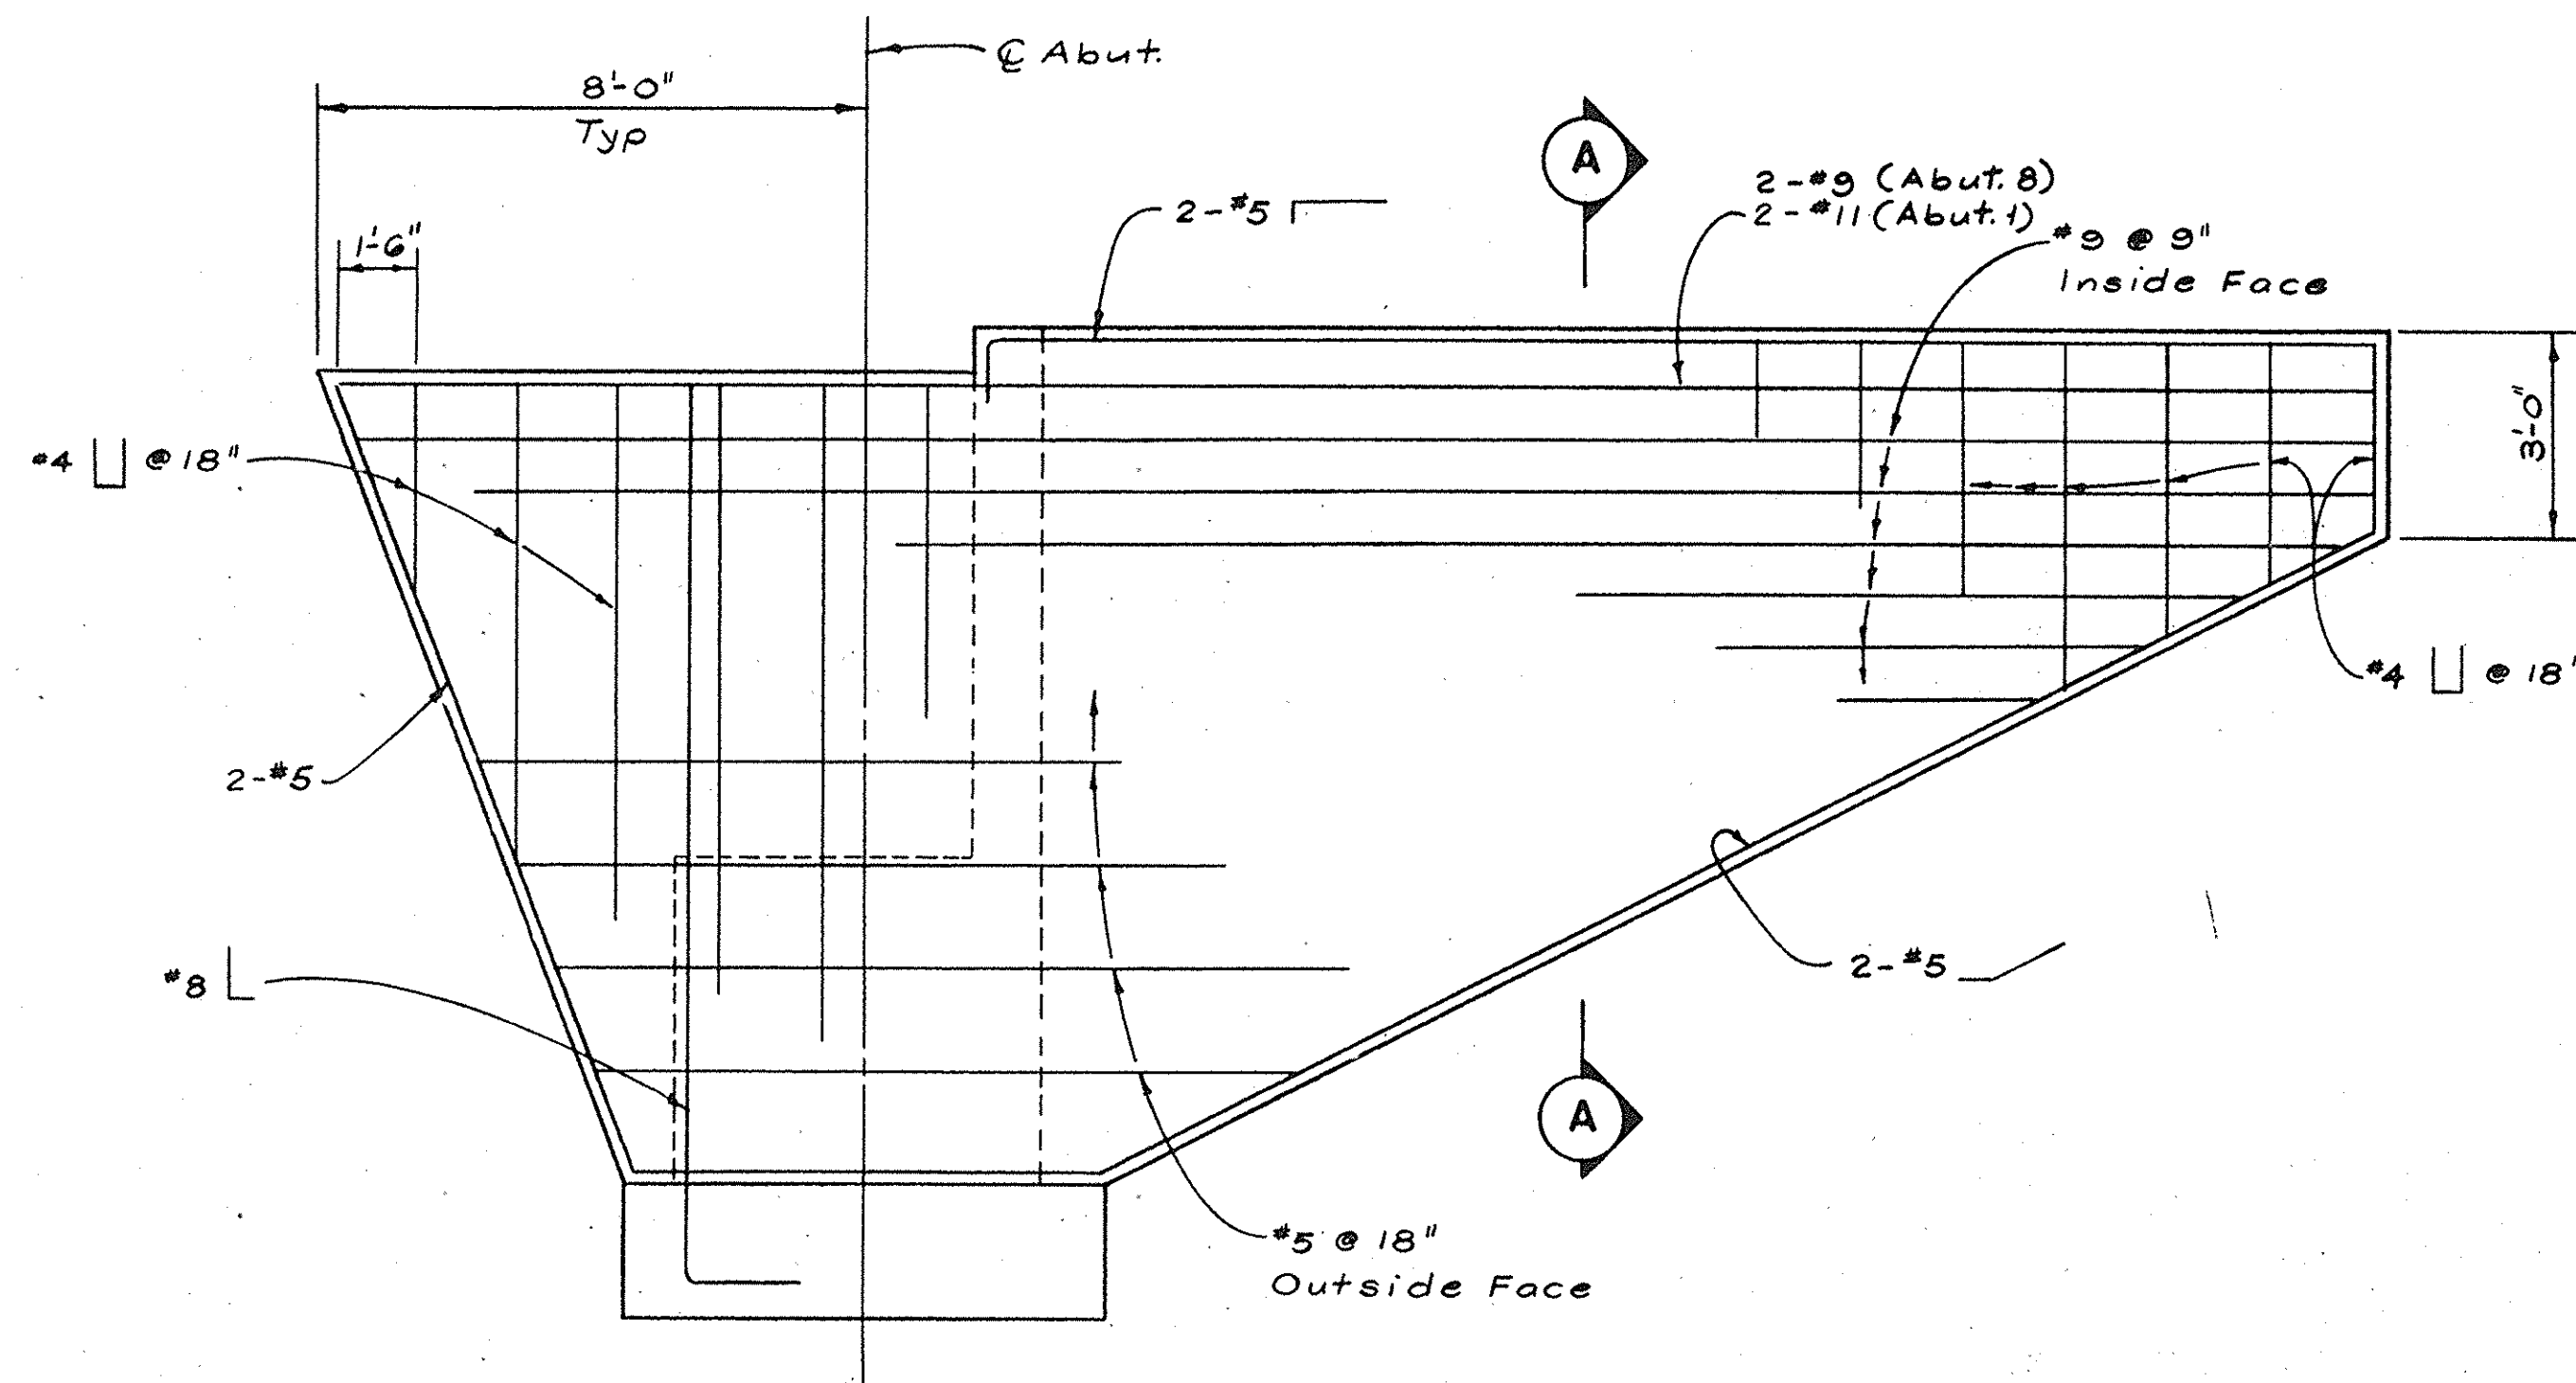


ELEVATION
3/8" = 1'

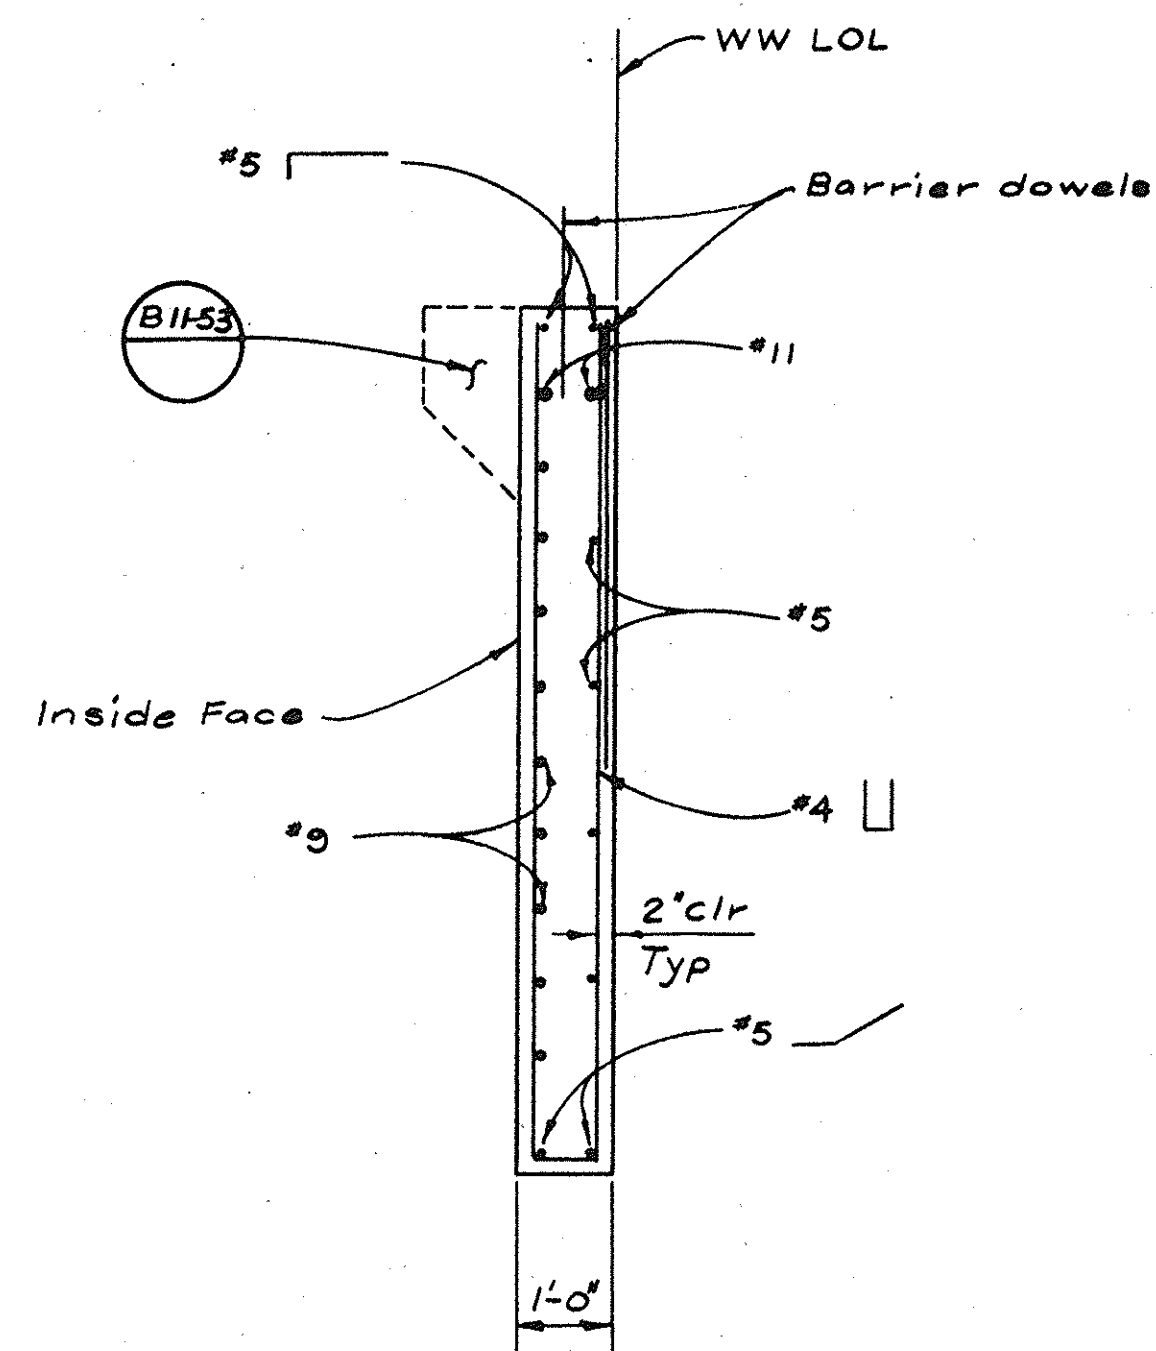


SECTION A-A
1/2" = 1'

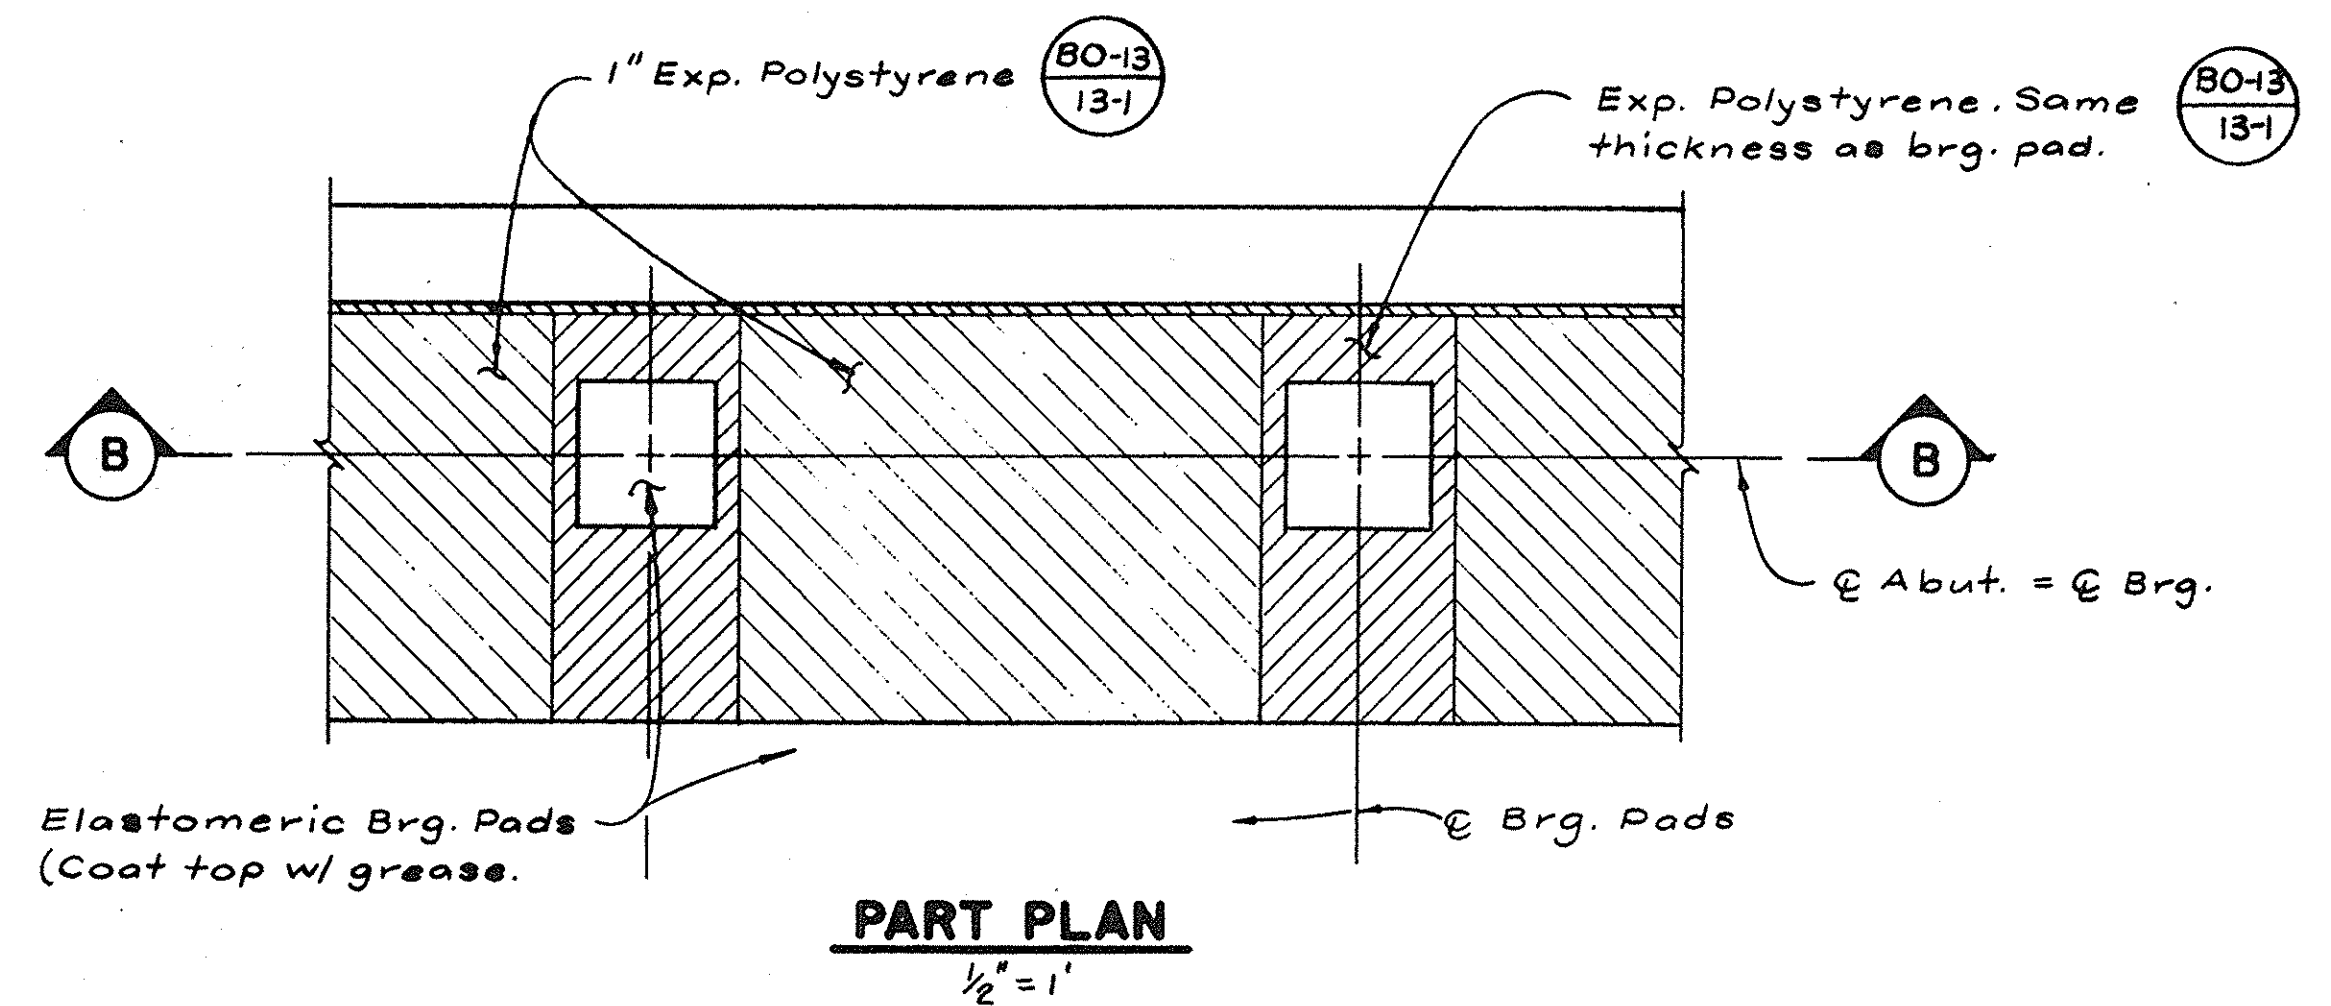


PART PLAN
1/2" = 1'

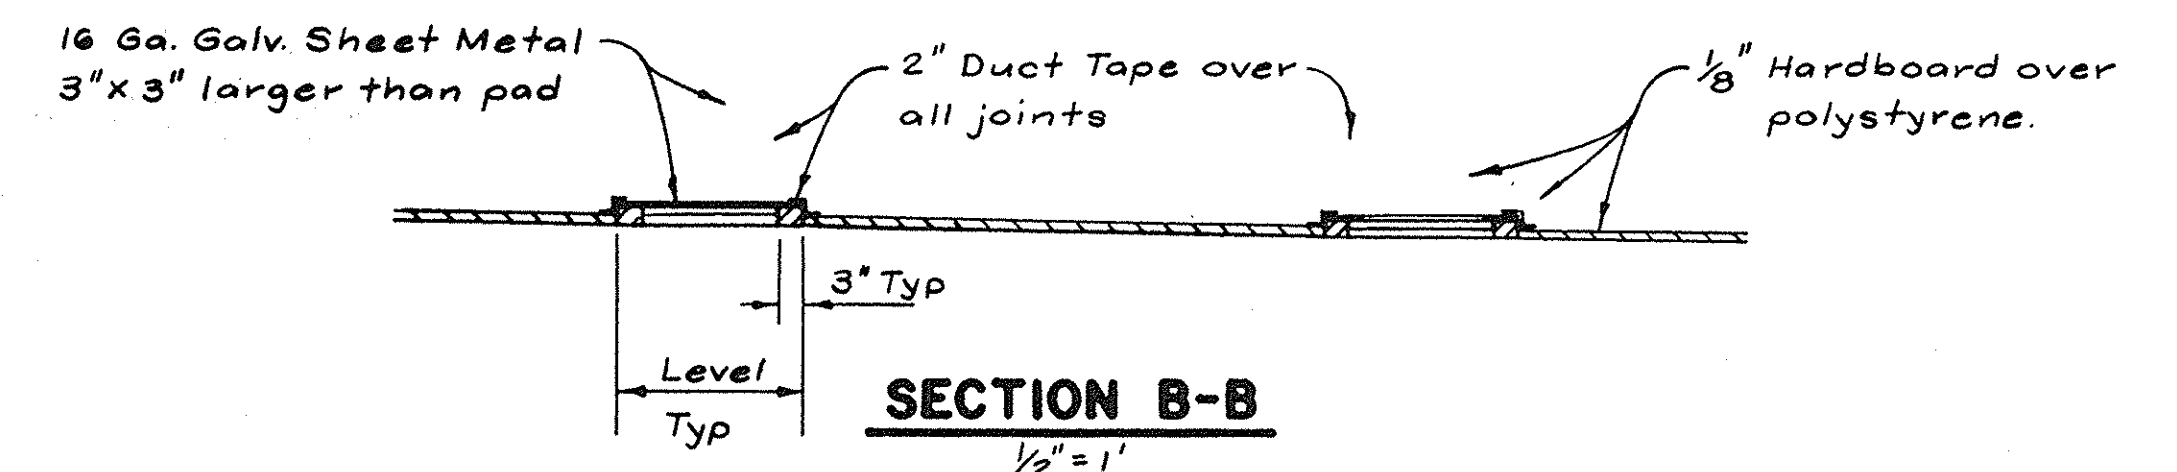

SECTION B-B
1/2" = 1'

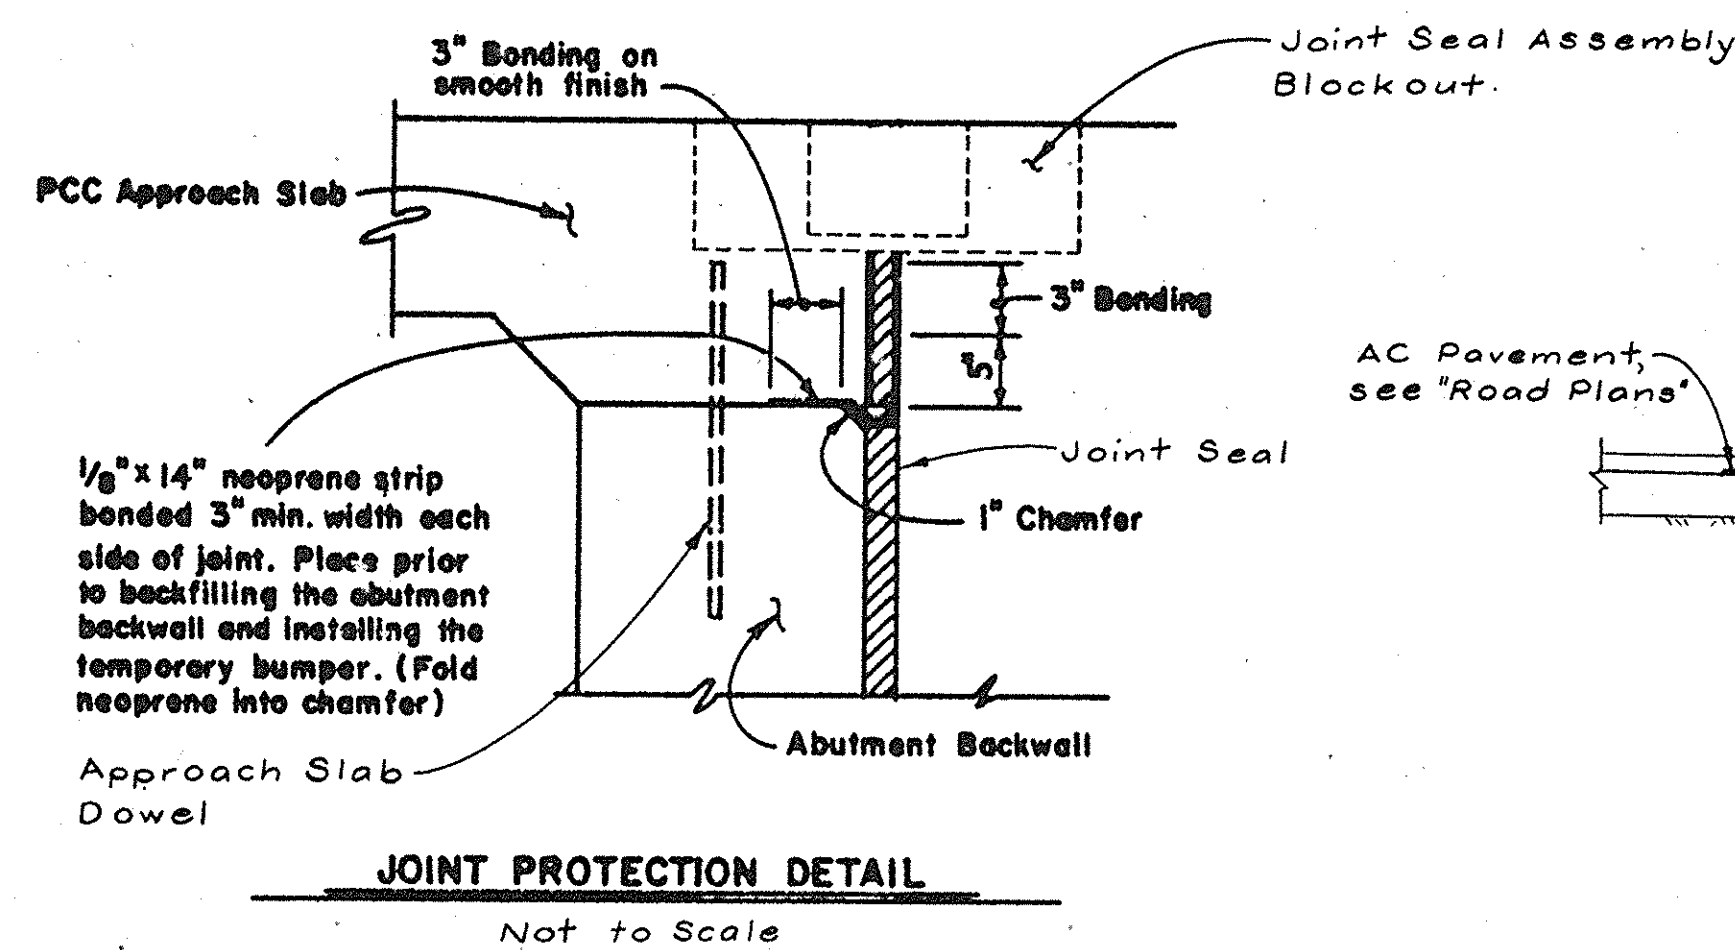


JOINT PROTECTION DETAIL
Not to Scale

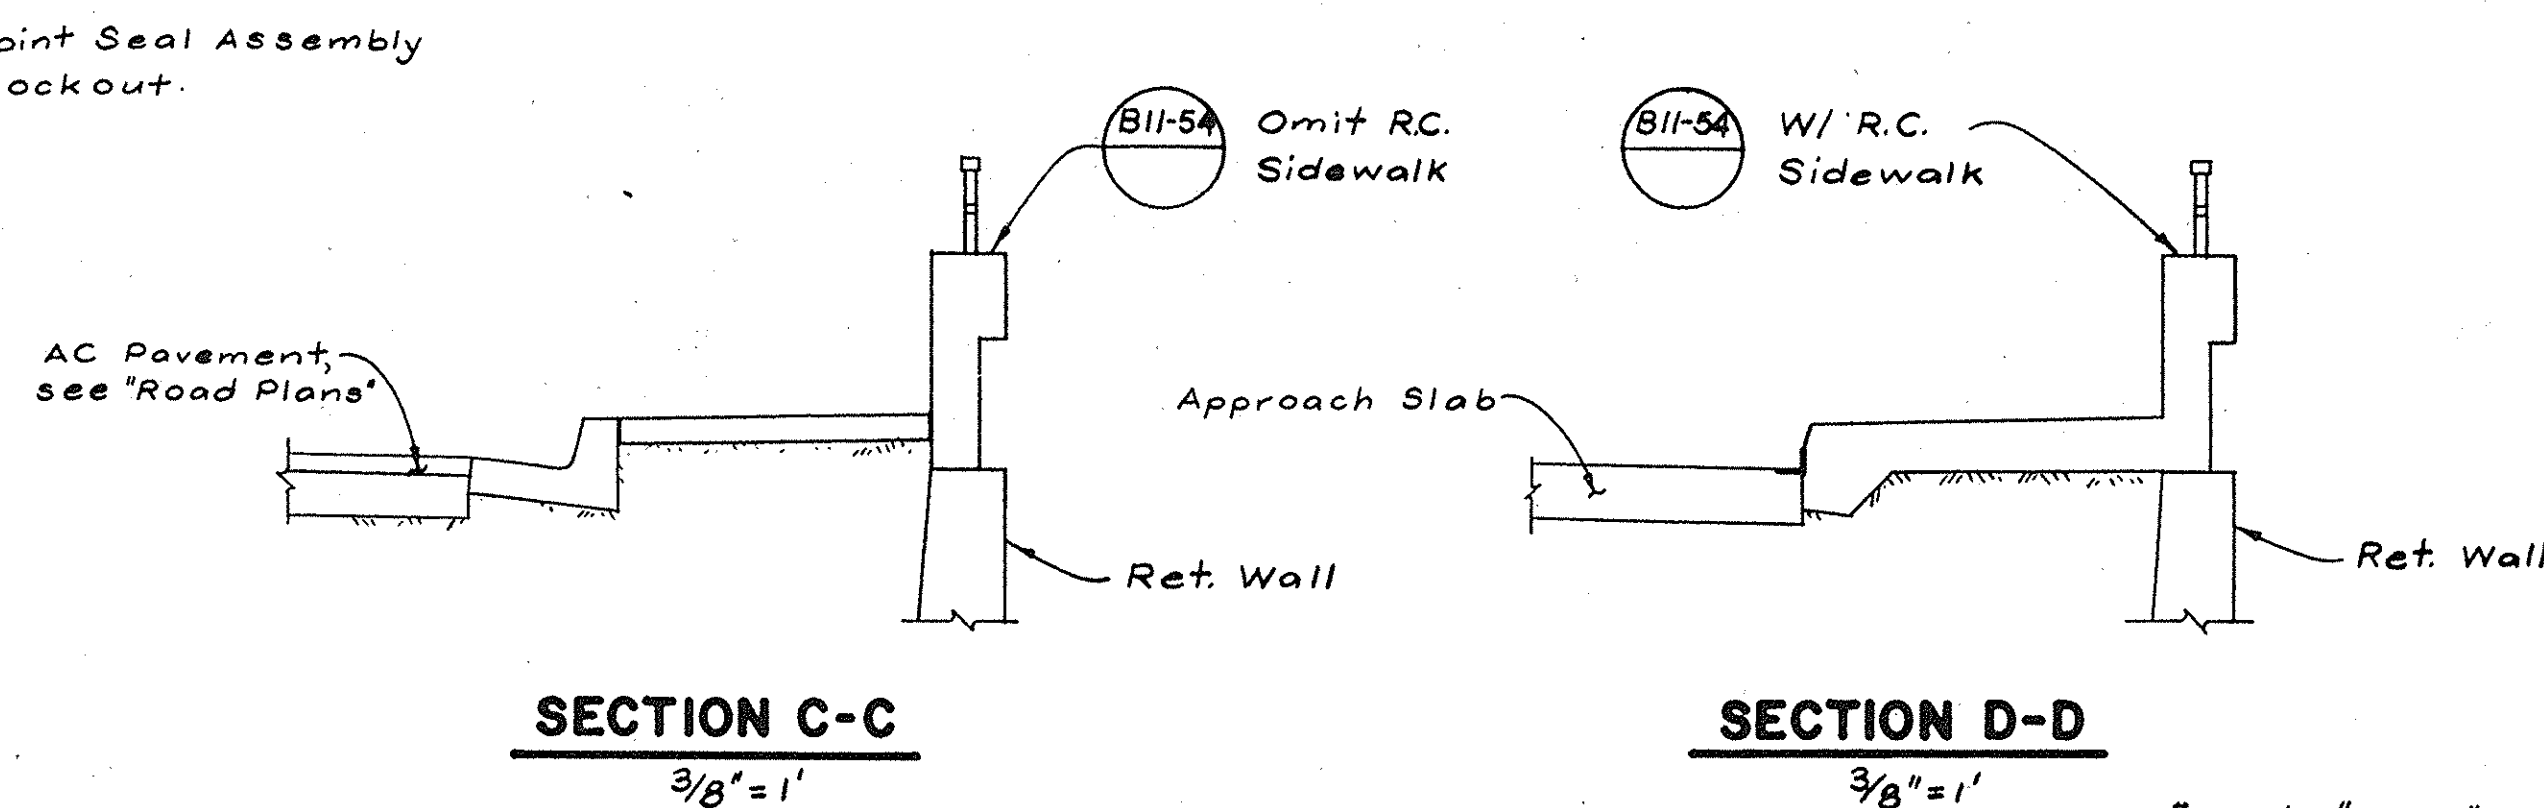


SECTION C-C
3/8" = 1'


SECTION D-D
3/8" = 1'

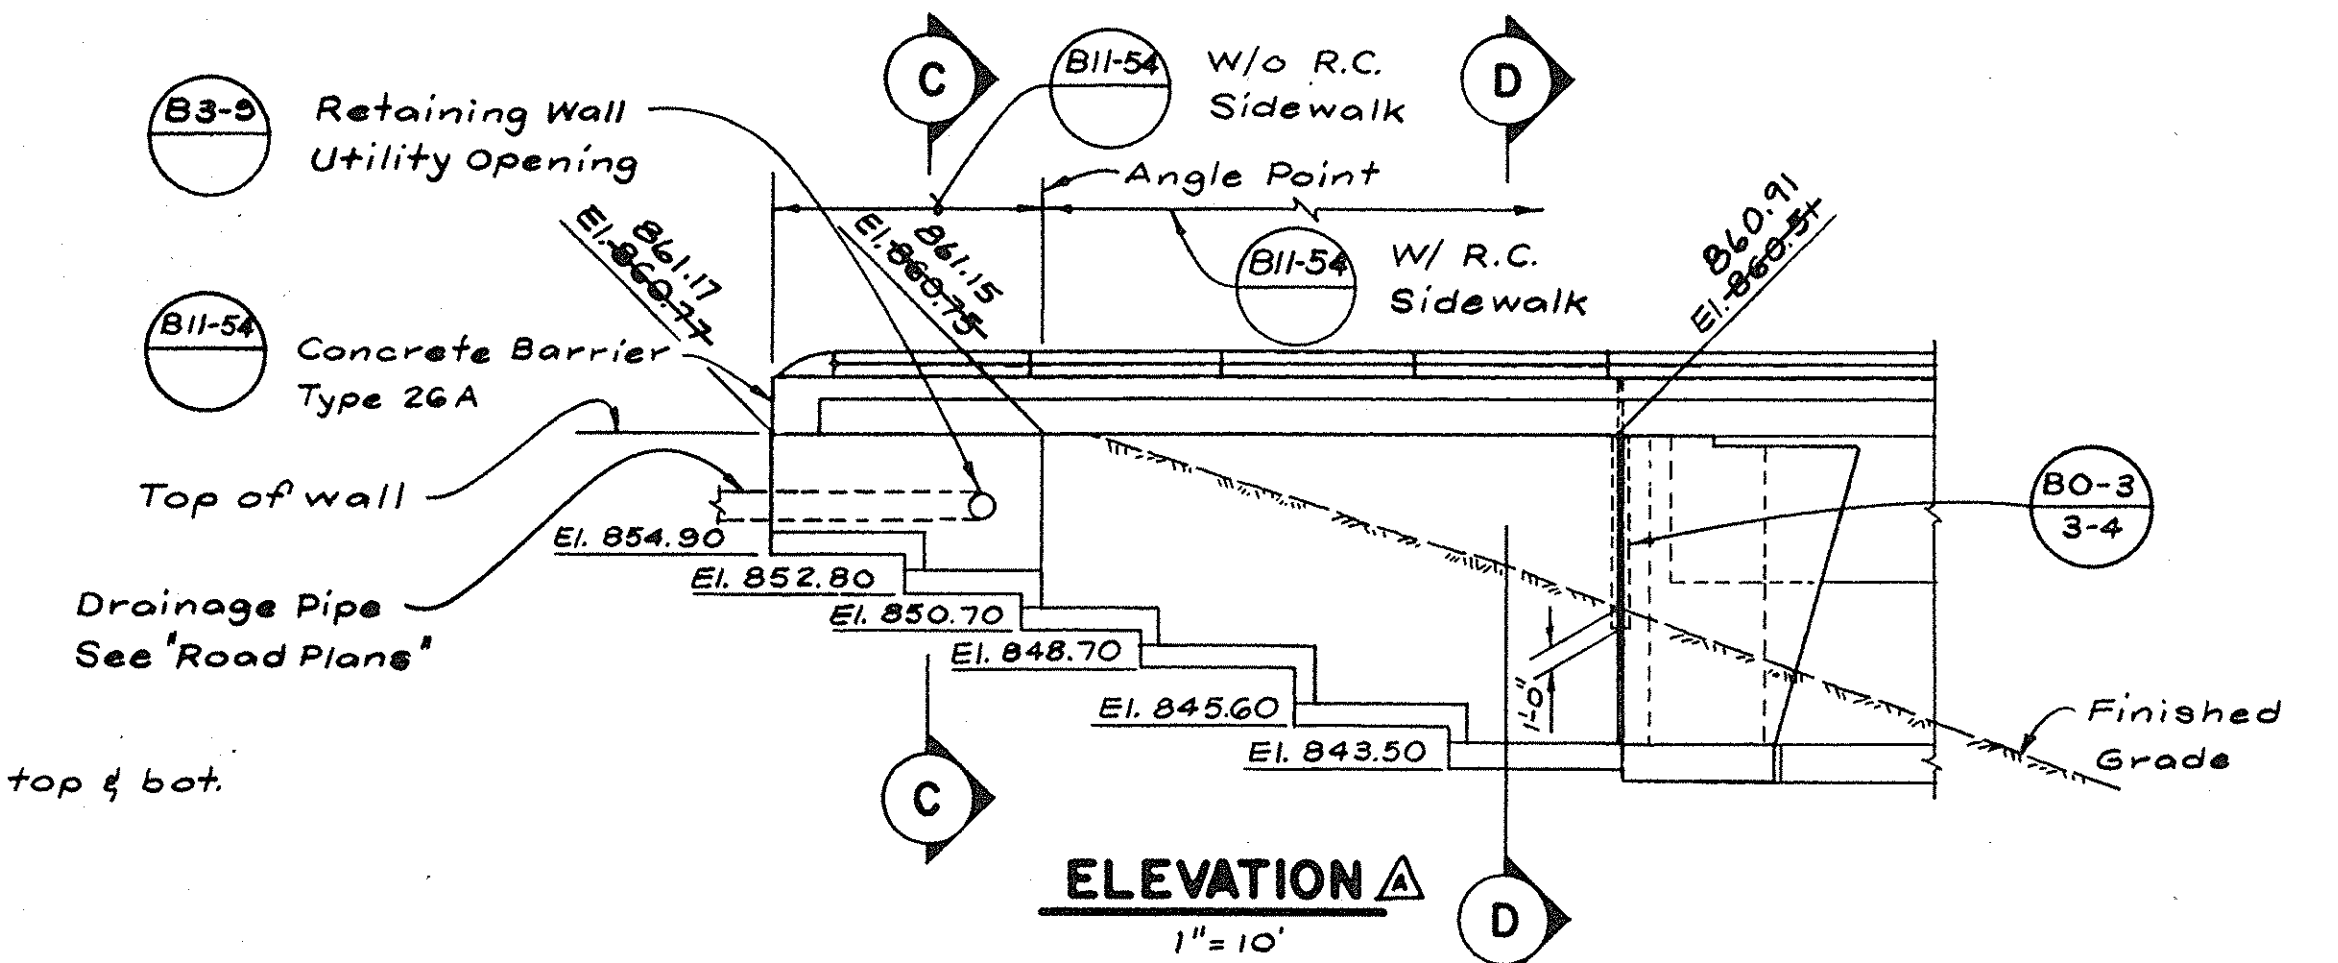

ELEVATION
1" = 10'

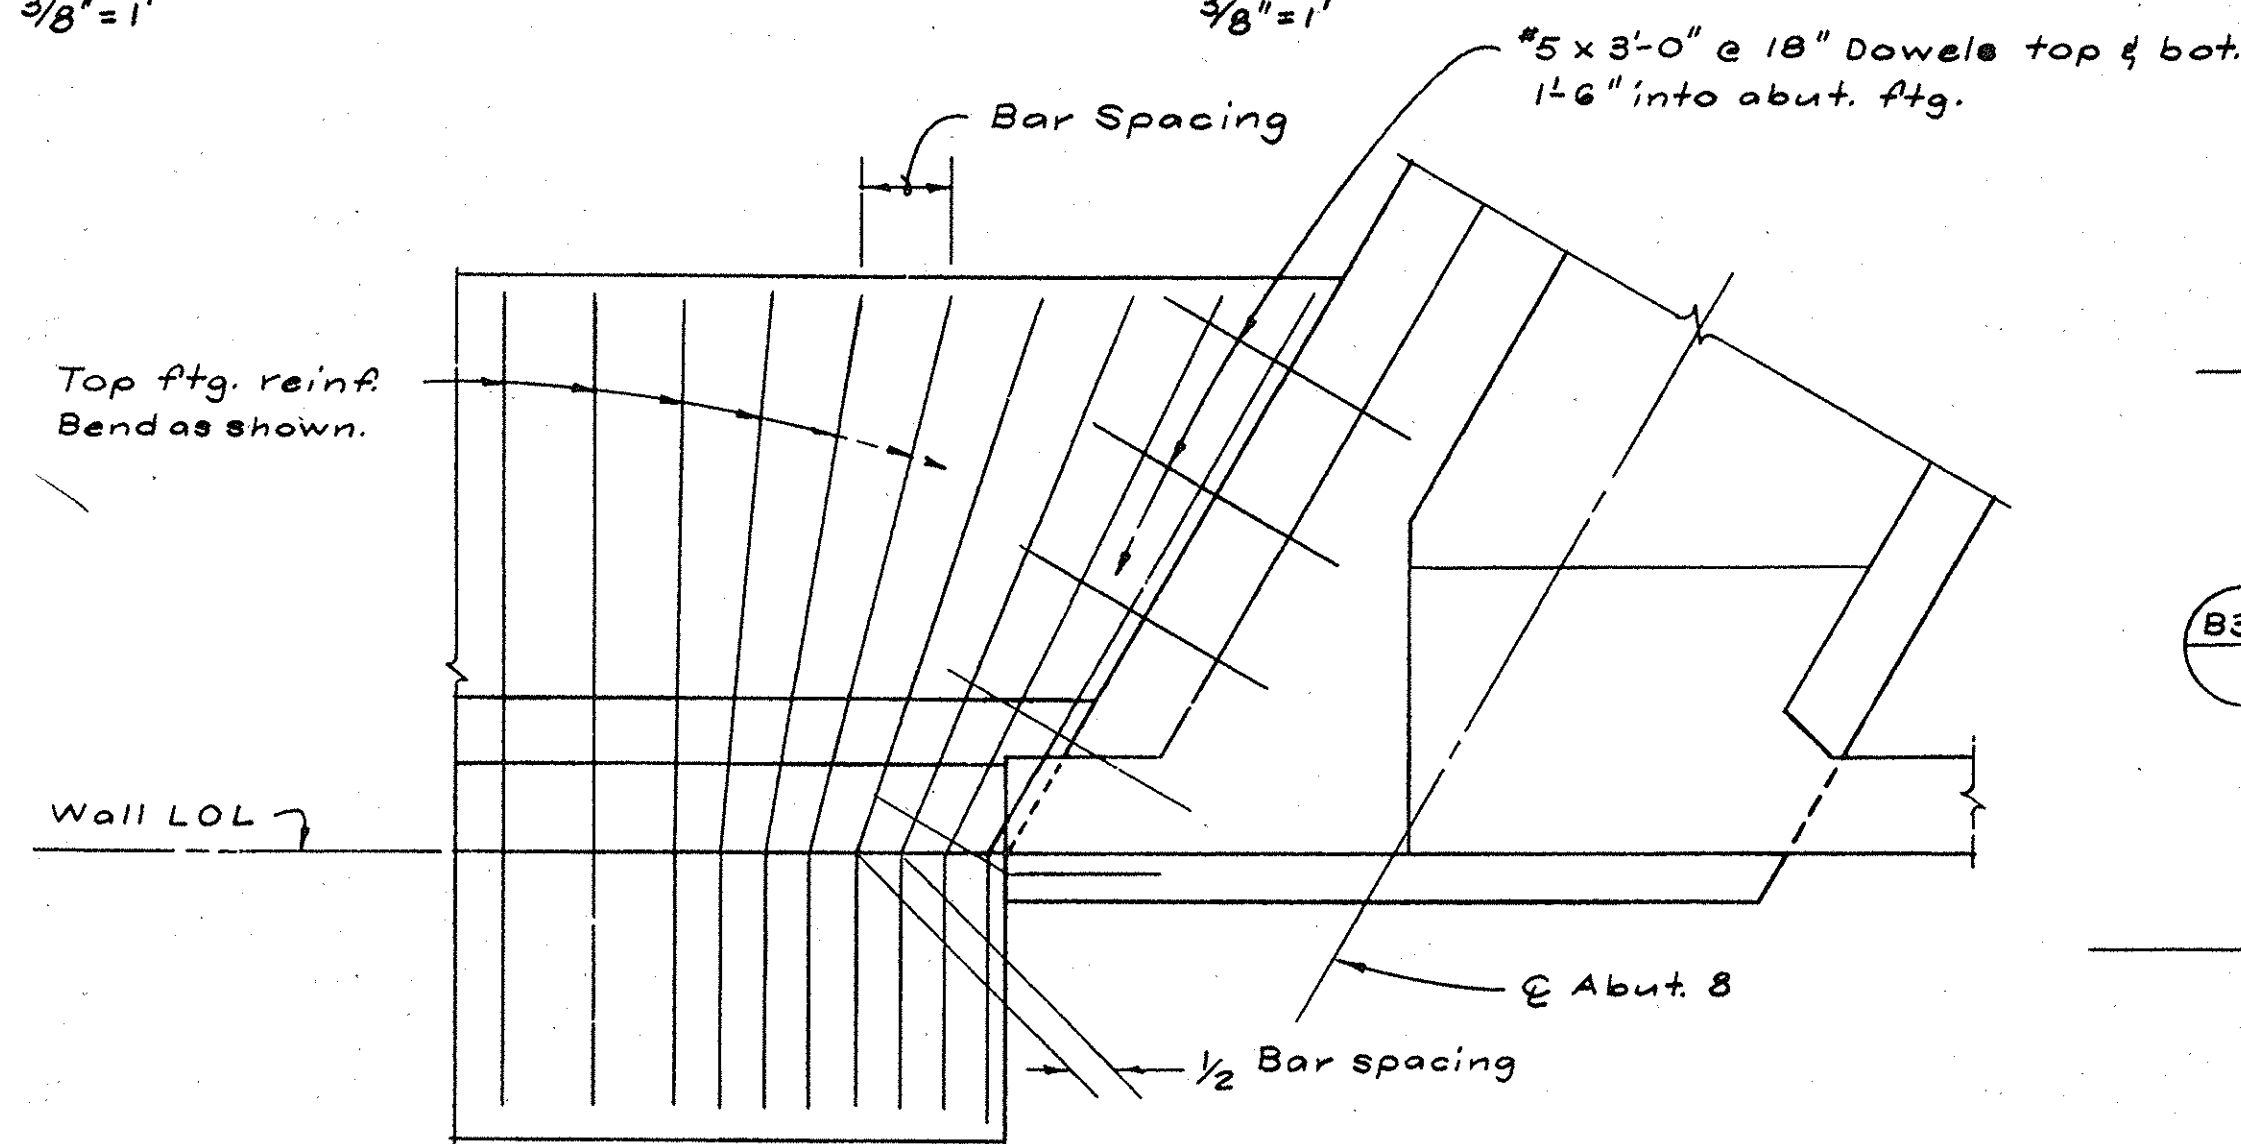

DETAIL "C"
1/2" = 1'

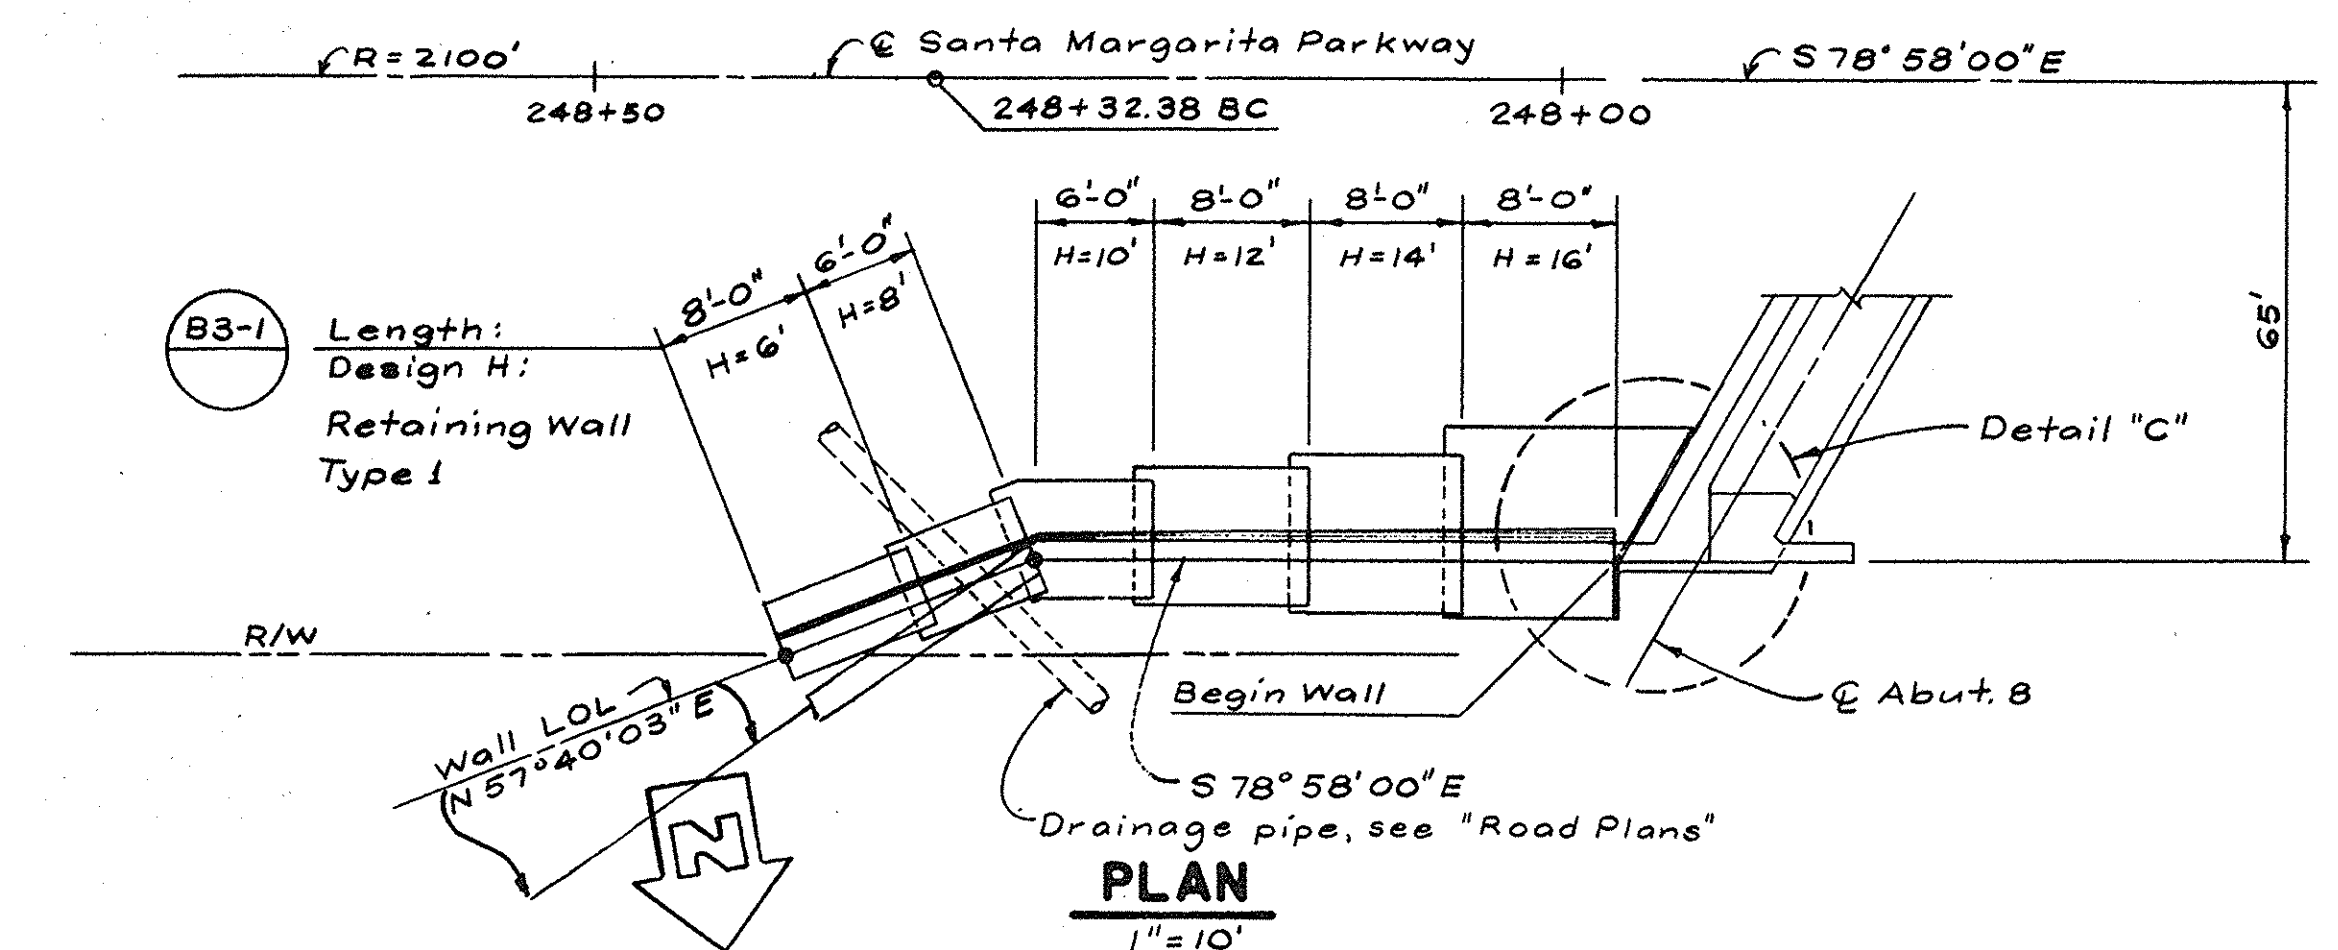

RETAINING WALL DETAILS



AS BUILT 3.93 SL4

McDANIEL ENGINEERING COMPANY, INC. 8888 OLD TOWN AVE., SUITE 207E, SAN DIEGO, CA 92116 (619) 592-1000 APPROVED BY: <i>W. Mark Ashley</i> R.C.E. C 34299 9-30-91 6-28-89	DESIGNED BY: W.M.A. DRAWN BY: R.L.A. CHECKED BY: C.C.C. FIELD BOOK:	SANTA MARGARITA PARKWAY BRIDGE OVER ARROYO TRABUCO - WIDENING ABUTMENT DETAILS - 2	SHEET 27 OF 57
--	--	---	----------------

DR. 19 15799