



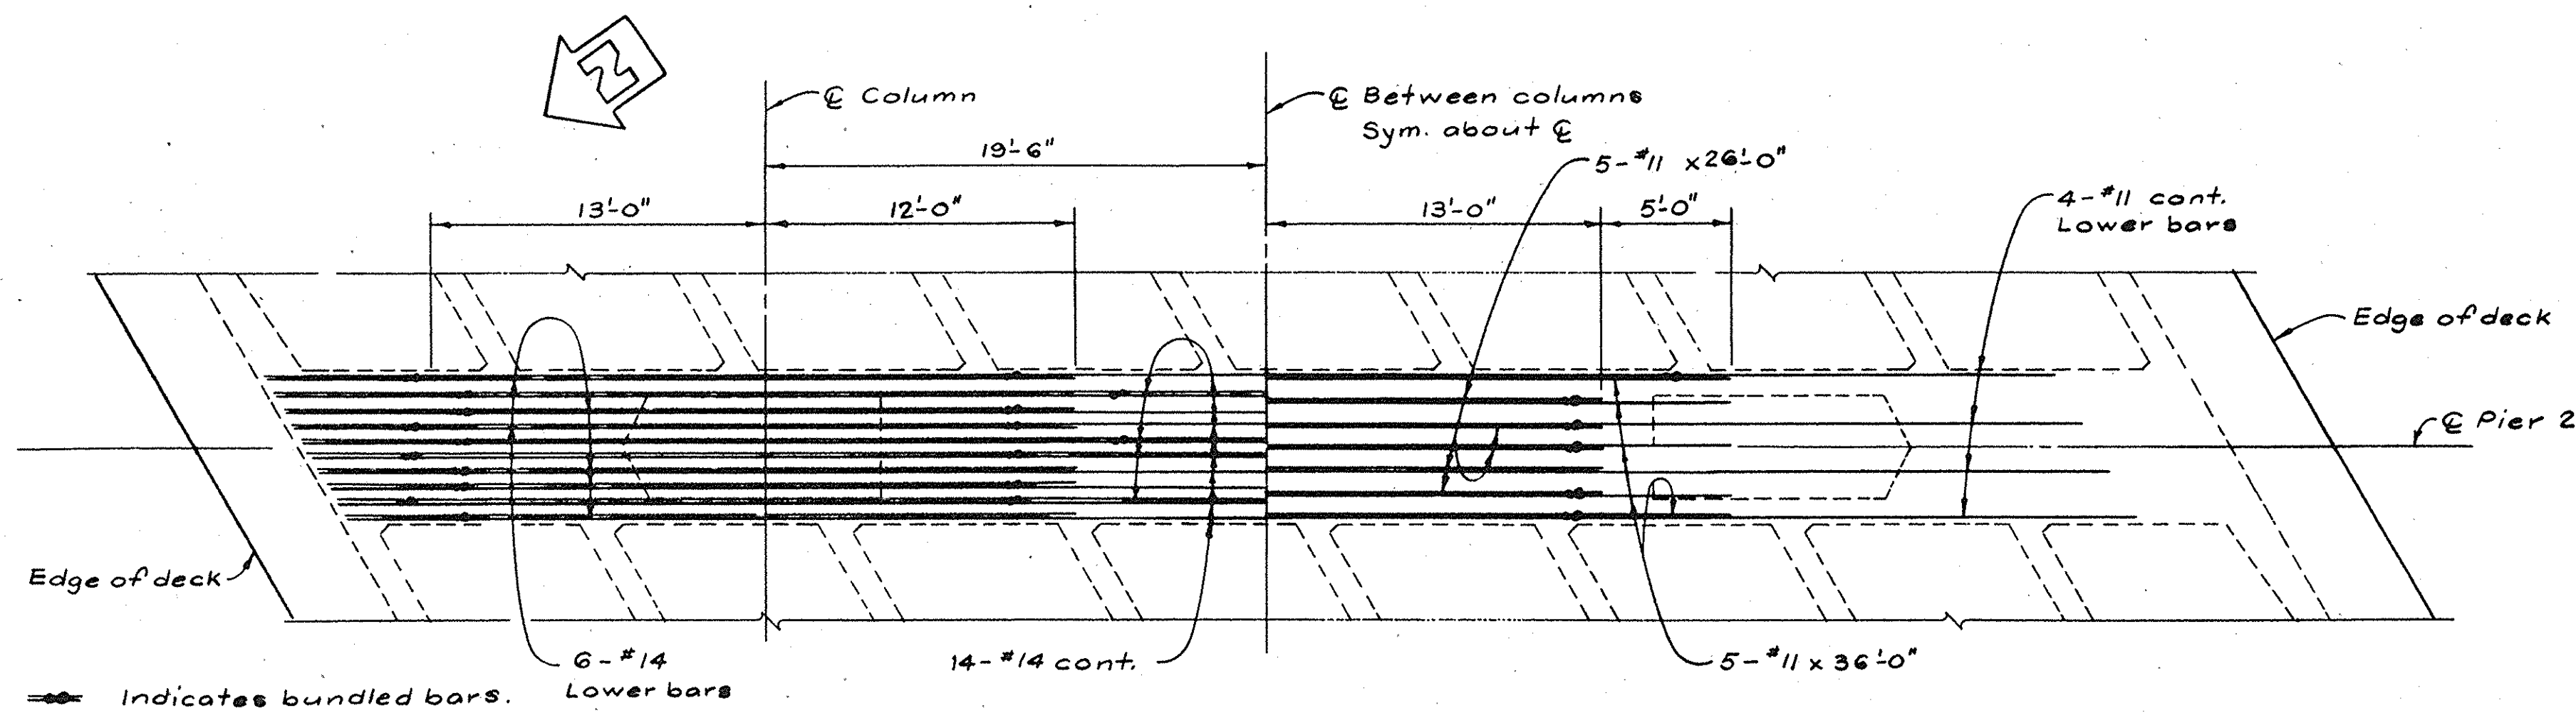

TOP CAP REINFORCEMENT

PLAN


BOTTOM CAP REINFORCEMENT

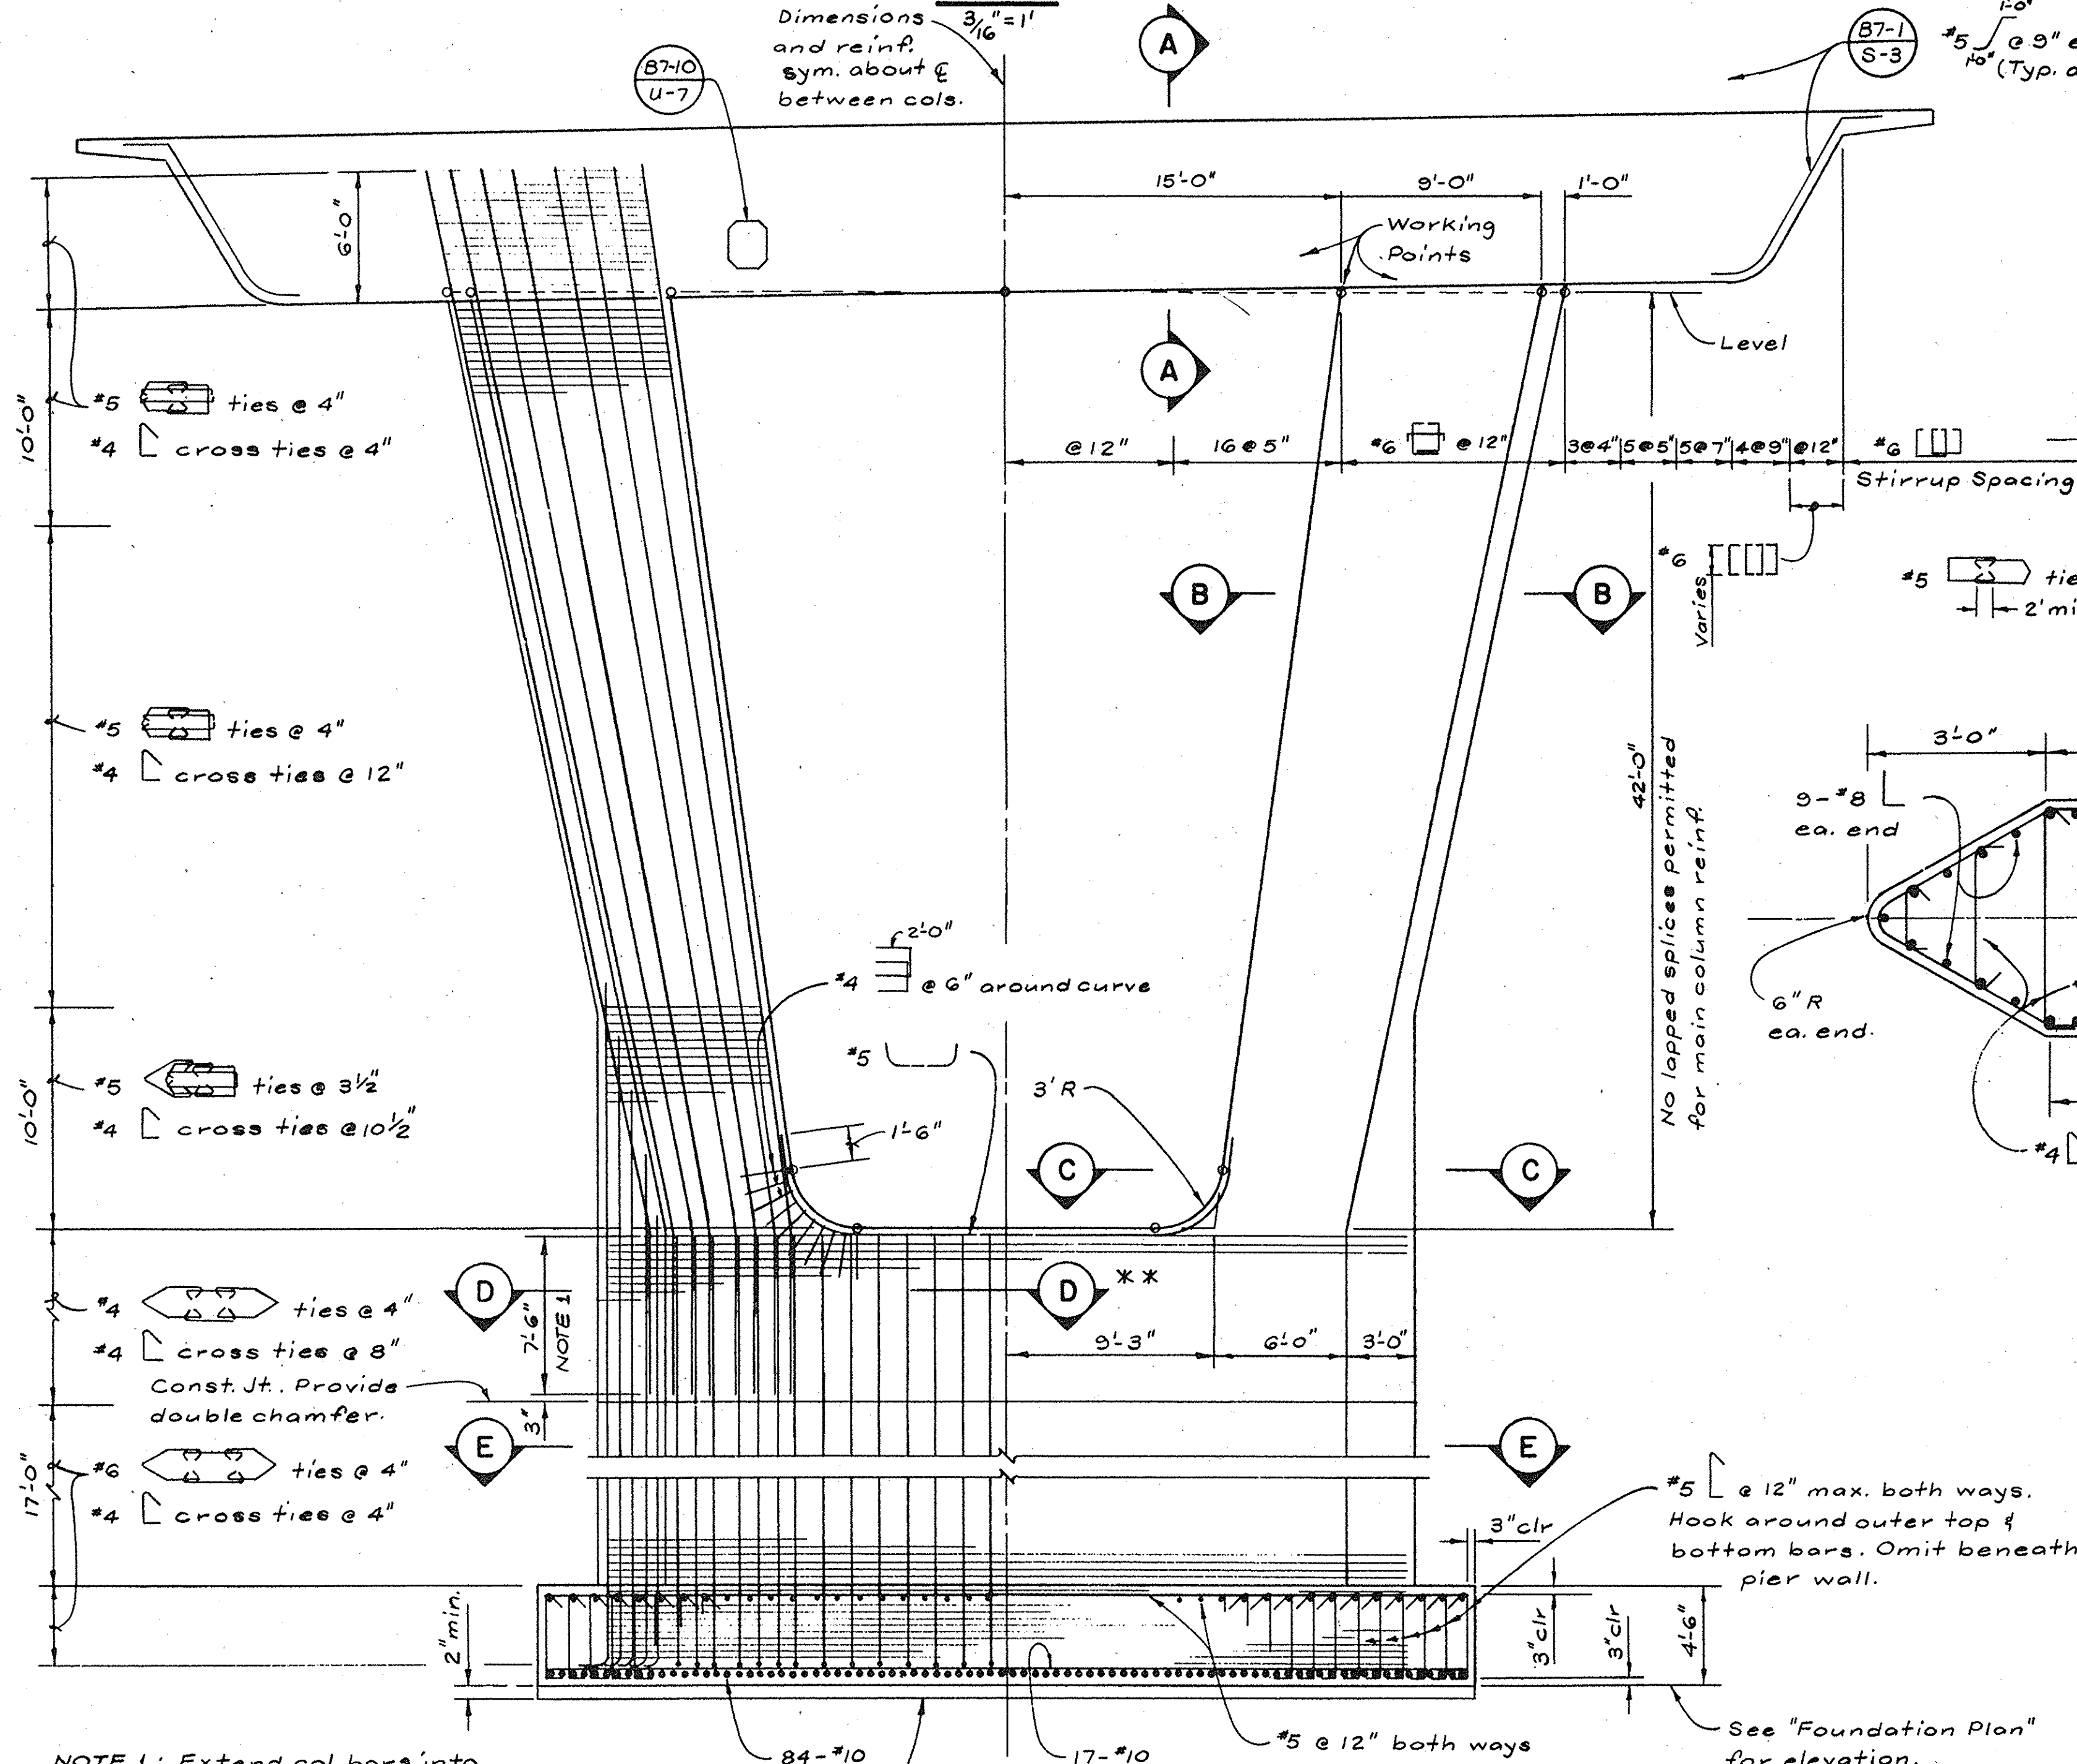





ELEVATION

3/16" = 1'

** For "Section D-D" see "Pier 3 Details" sheet.

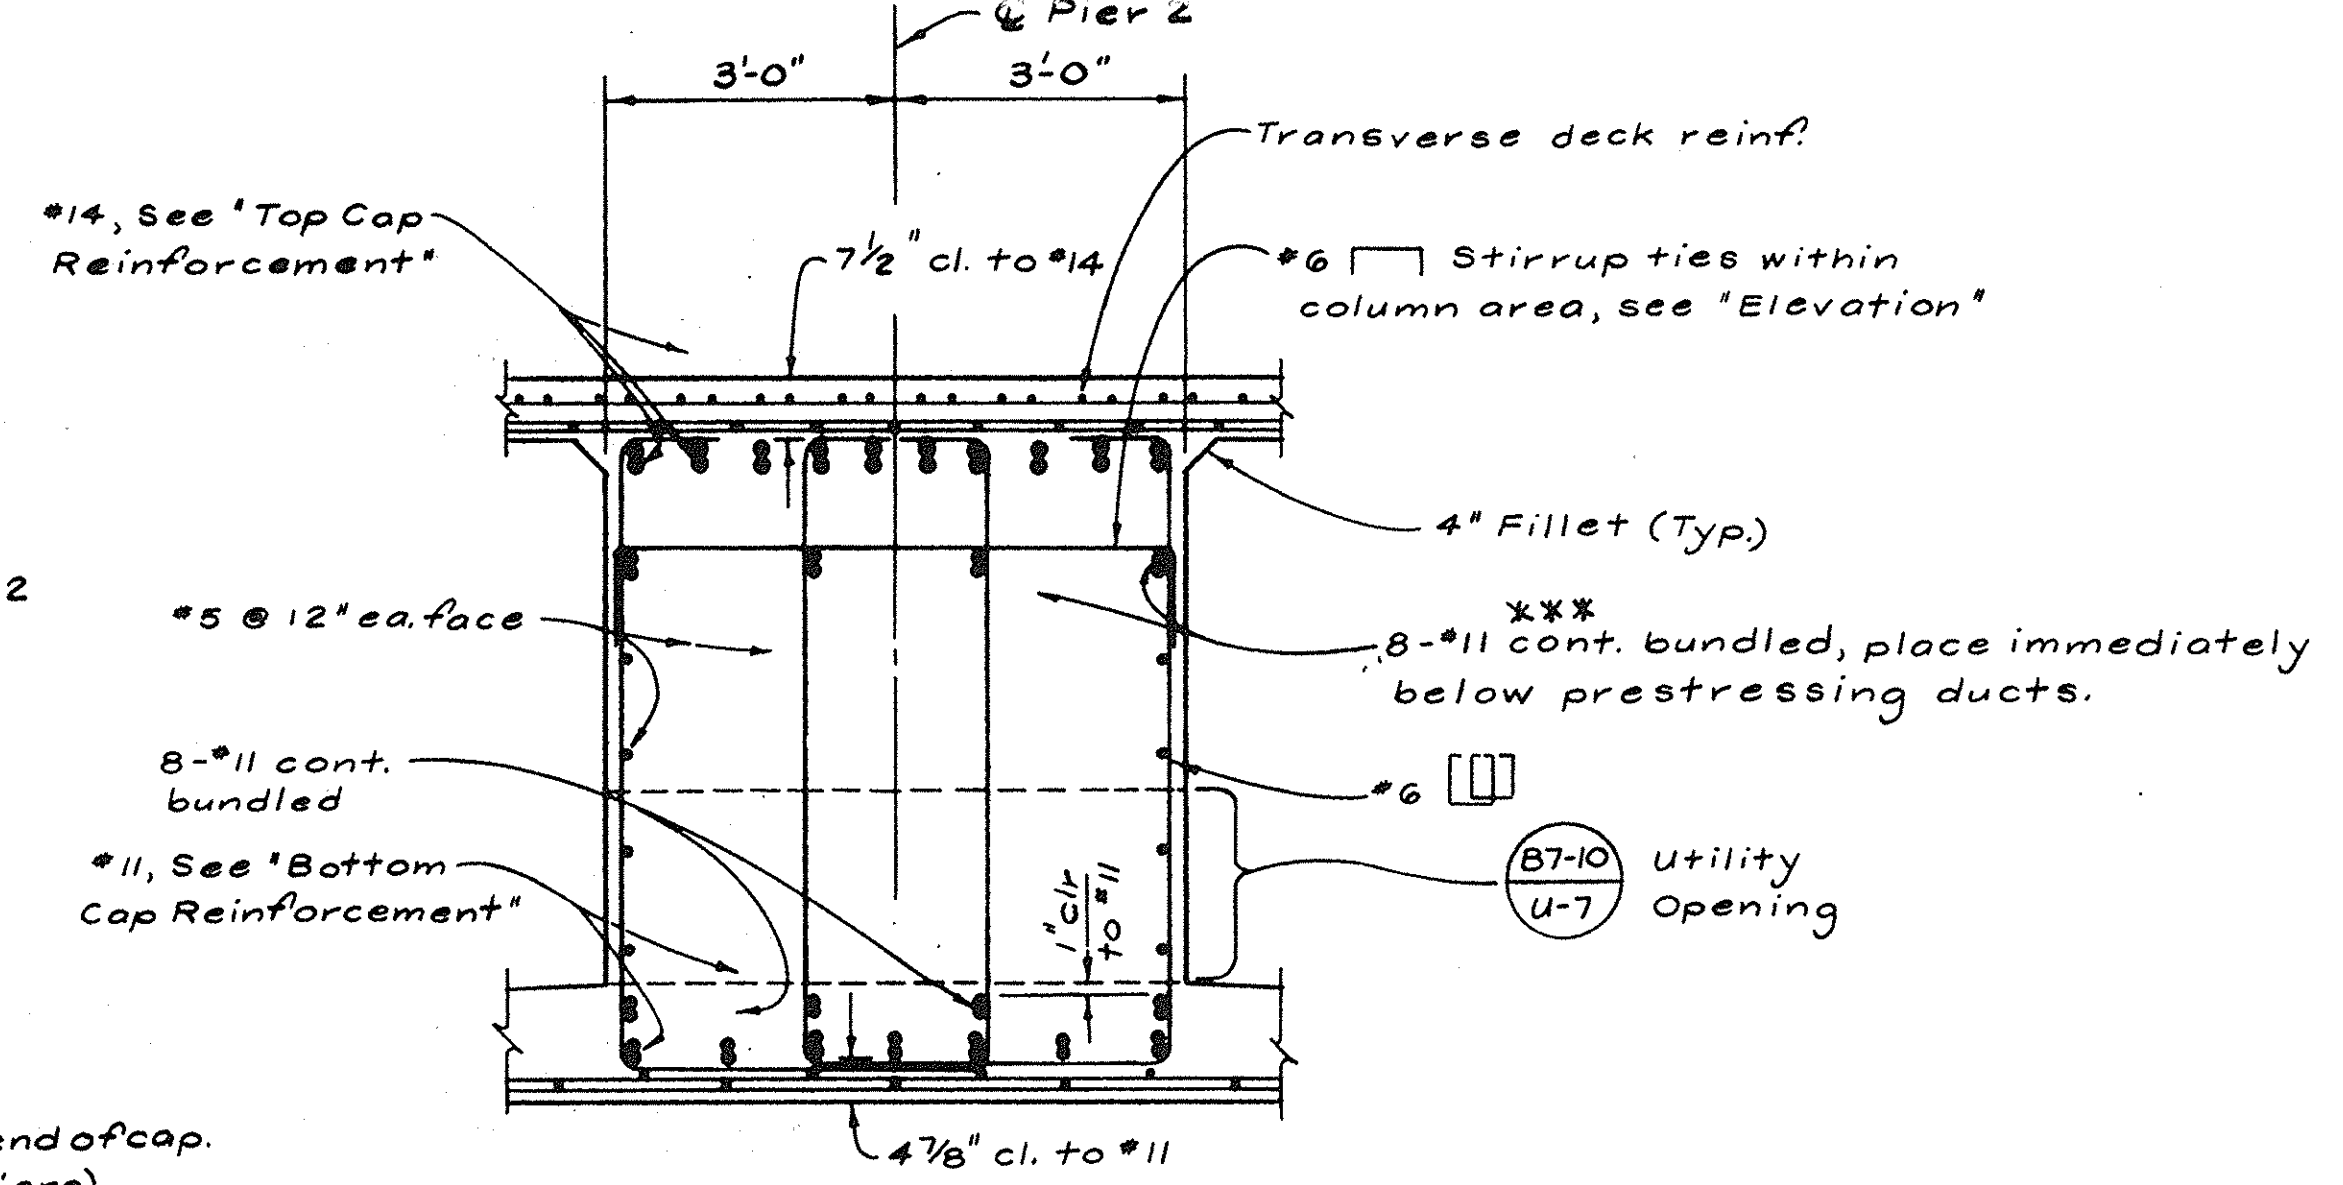

SECTION A-A

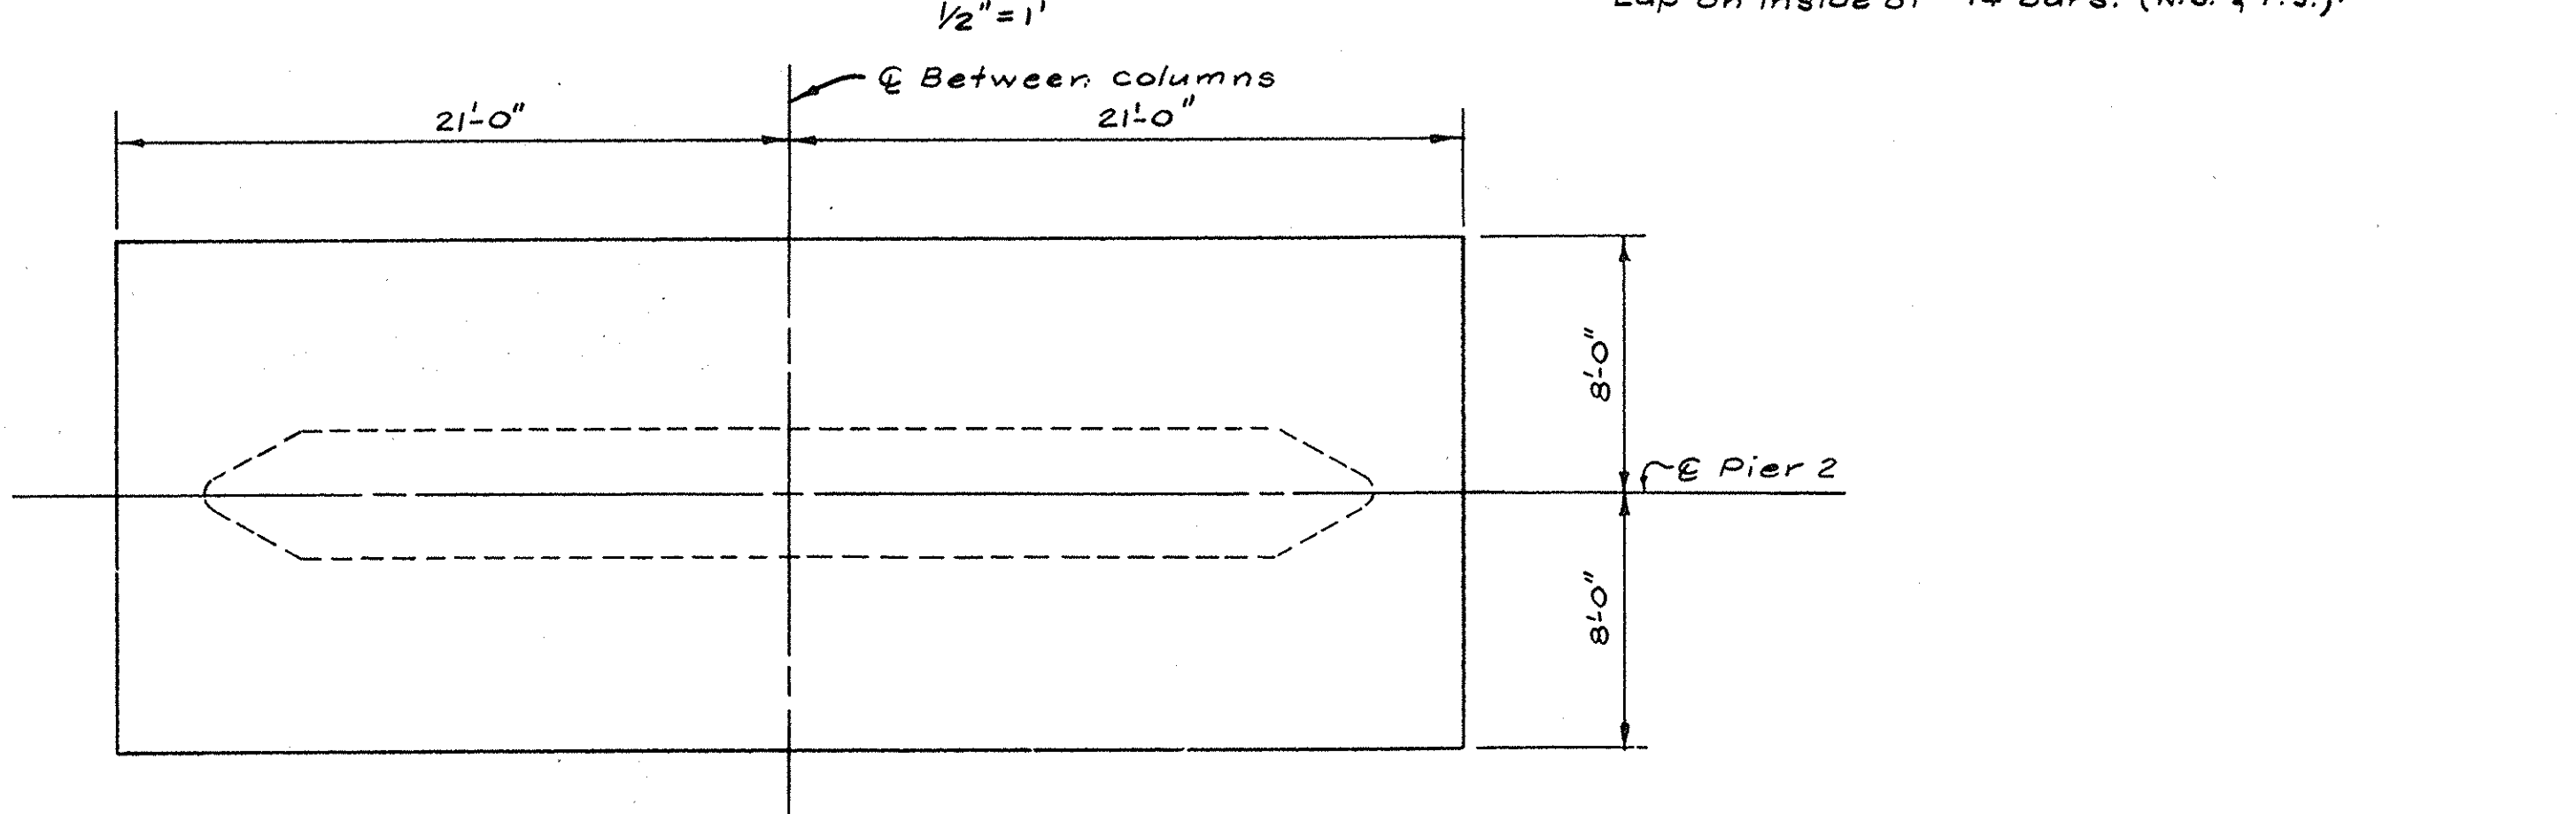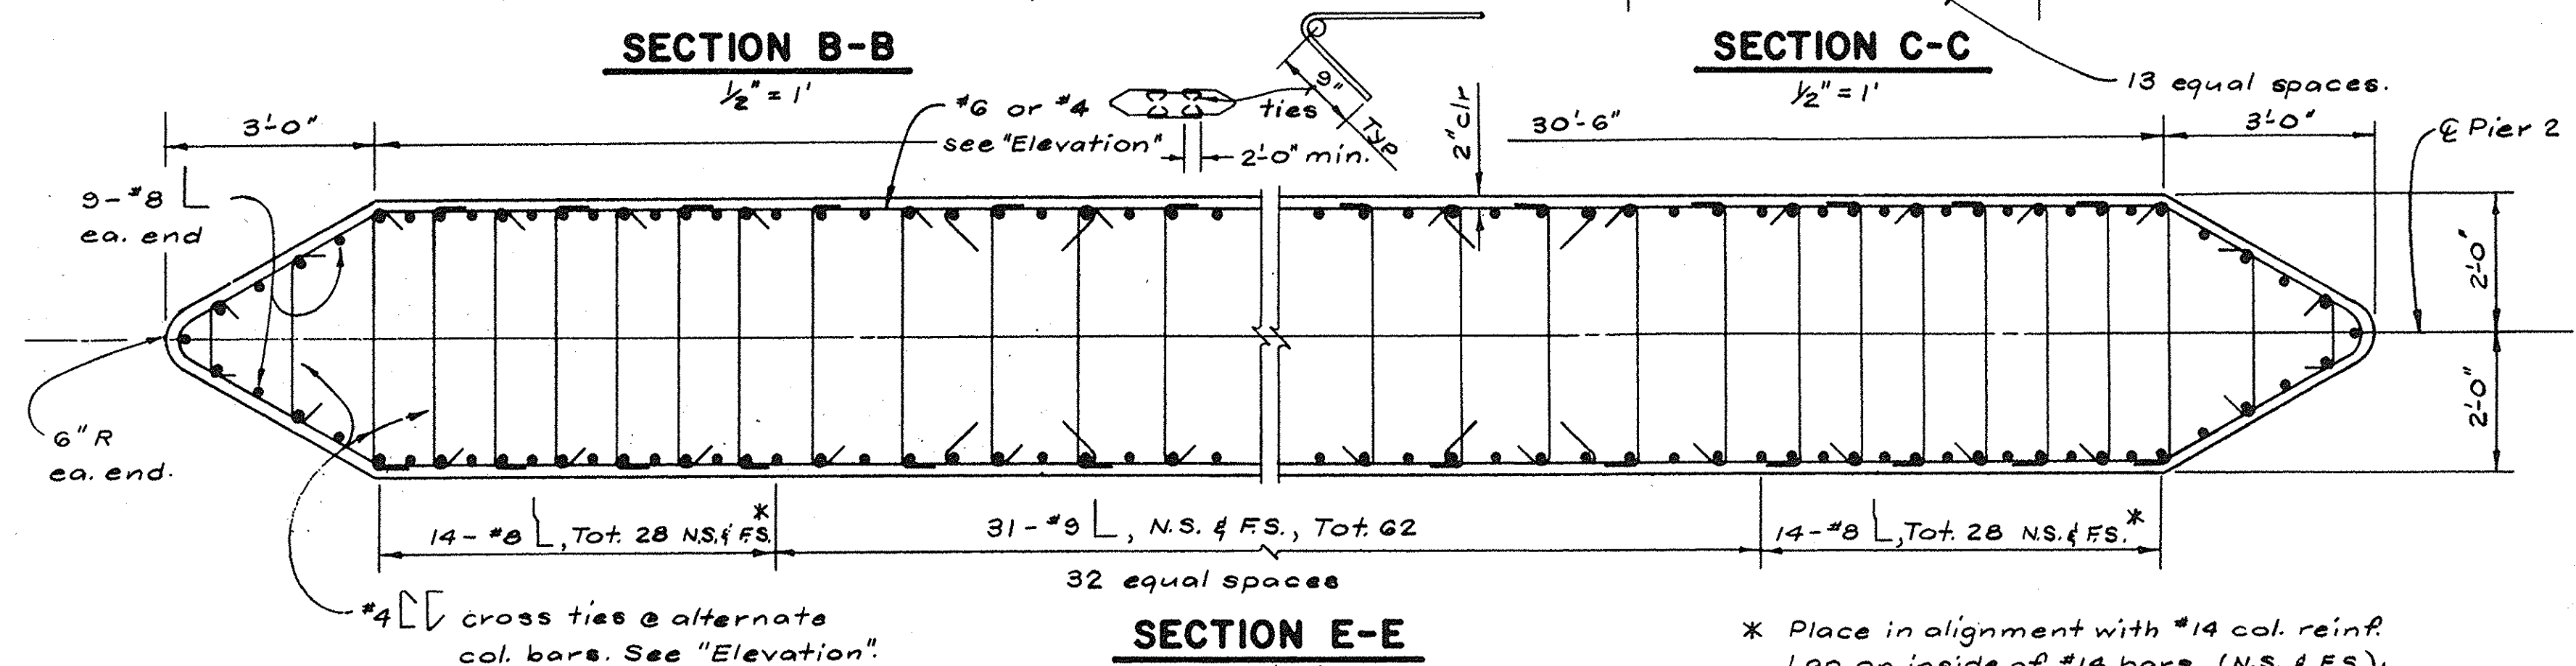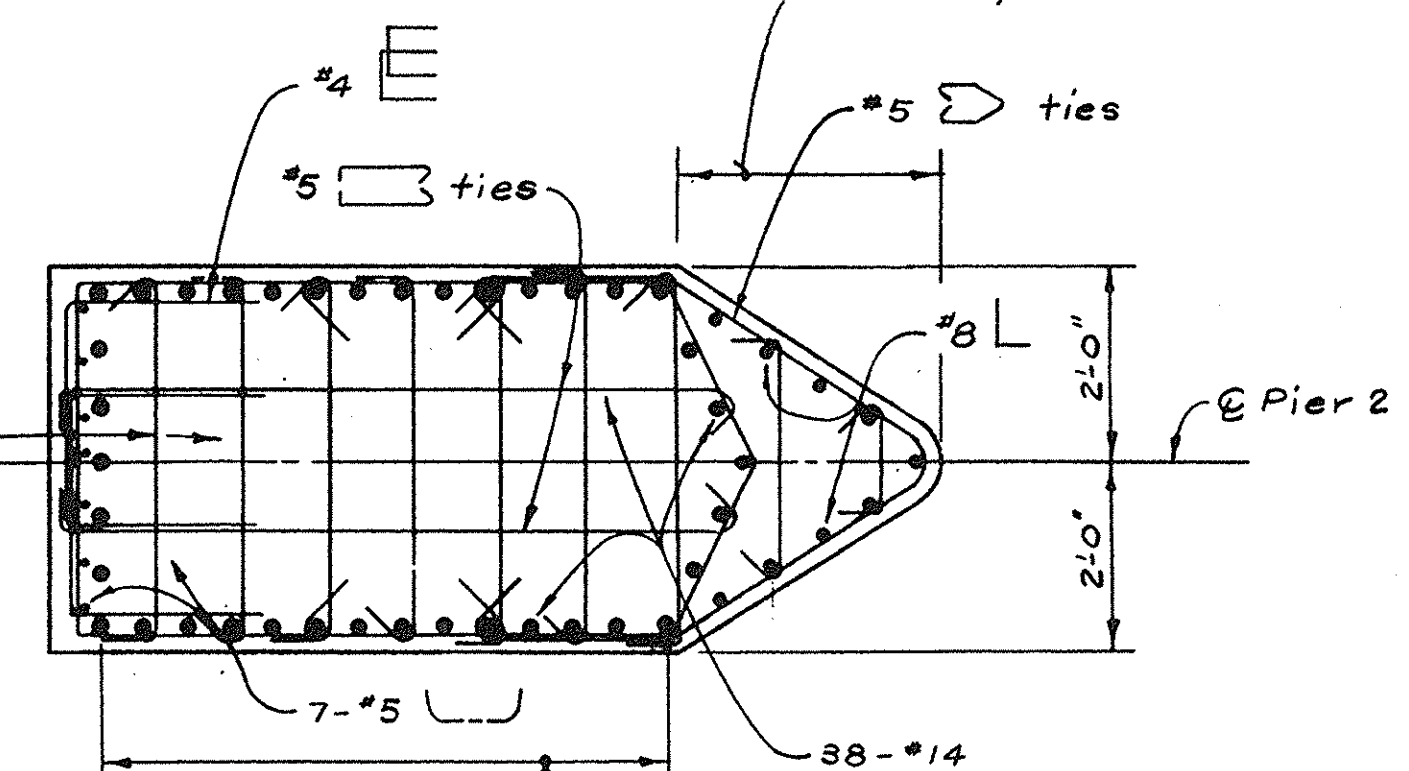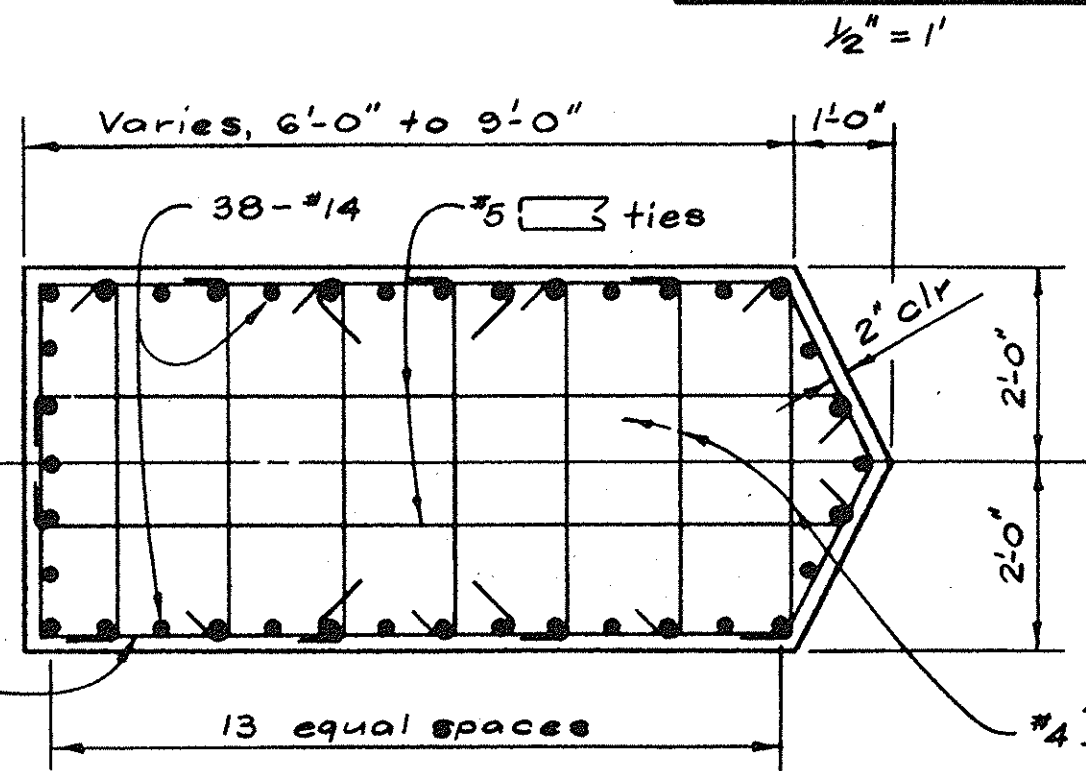

Slurry cement backfill to be placed against undisturbed, dense, competent sandstone or siltstone (bedrock), see special provisions.



McDANIEL ENGINEERING COMPANY, INC.
3000 OLD TOWN AVE., SUITE 207E, SAN DIEGO, CA 92110 (619) 592-1000

APPROVED BY: [Signature] R.C.E. C 34299 EXPIRES 9-30-91 DATE 6-28-89

DESIGNED BY: WMA
DRAWN BY: RLA
CHECKED BY: CCC
FIELD BOOK

SANTA MARGARITA PARKWAY BRIDGE
OVER ARROYO TRABUCO - WIDENING

PIER 2 DETAILS

SHEET 28 OF 57
JES

AS BUILT 3.93 SLH

DR. 19-15799