

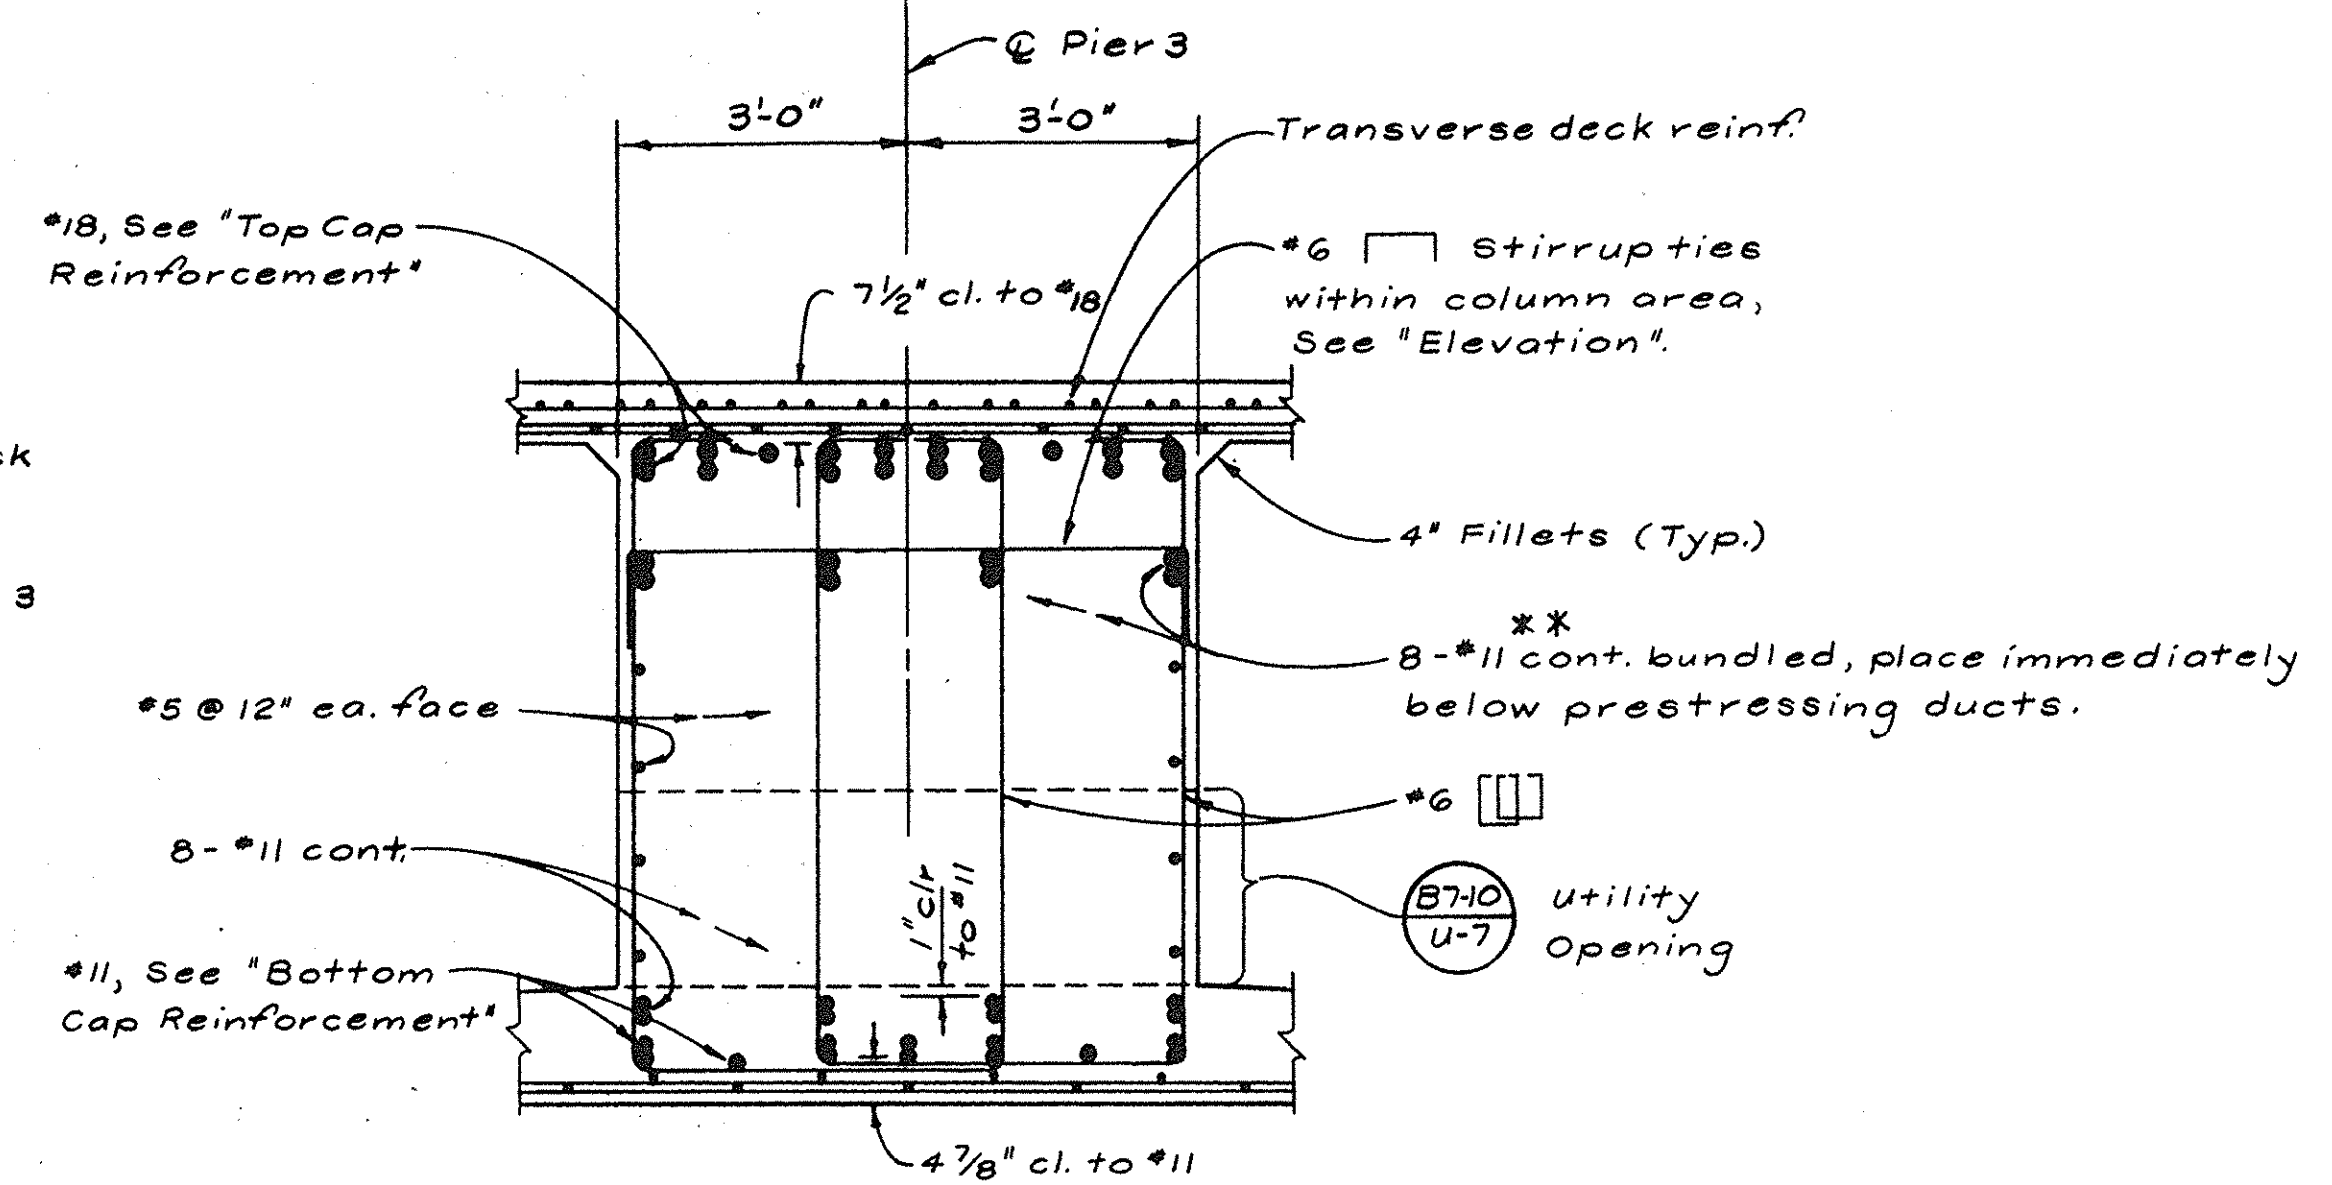


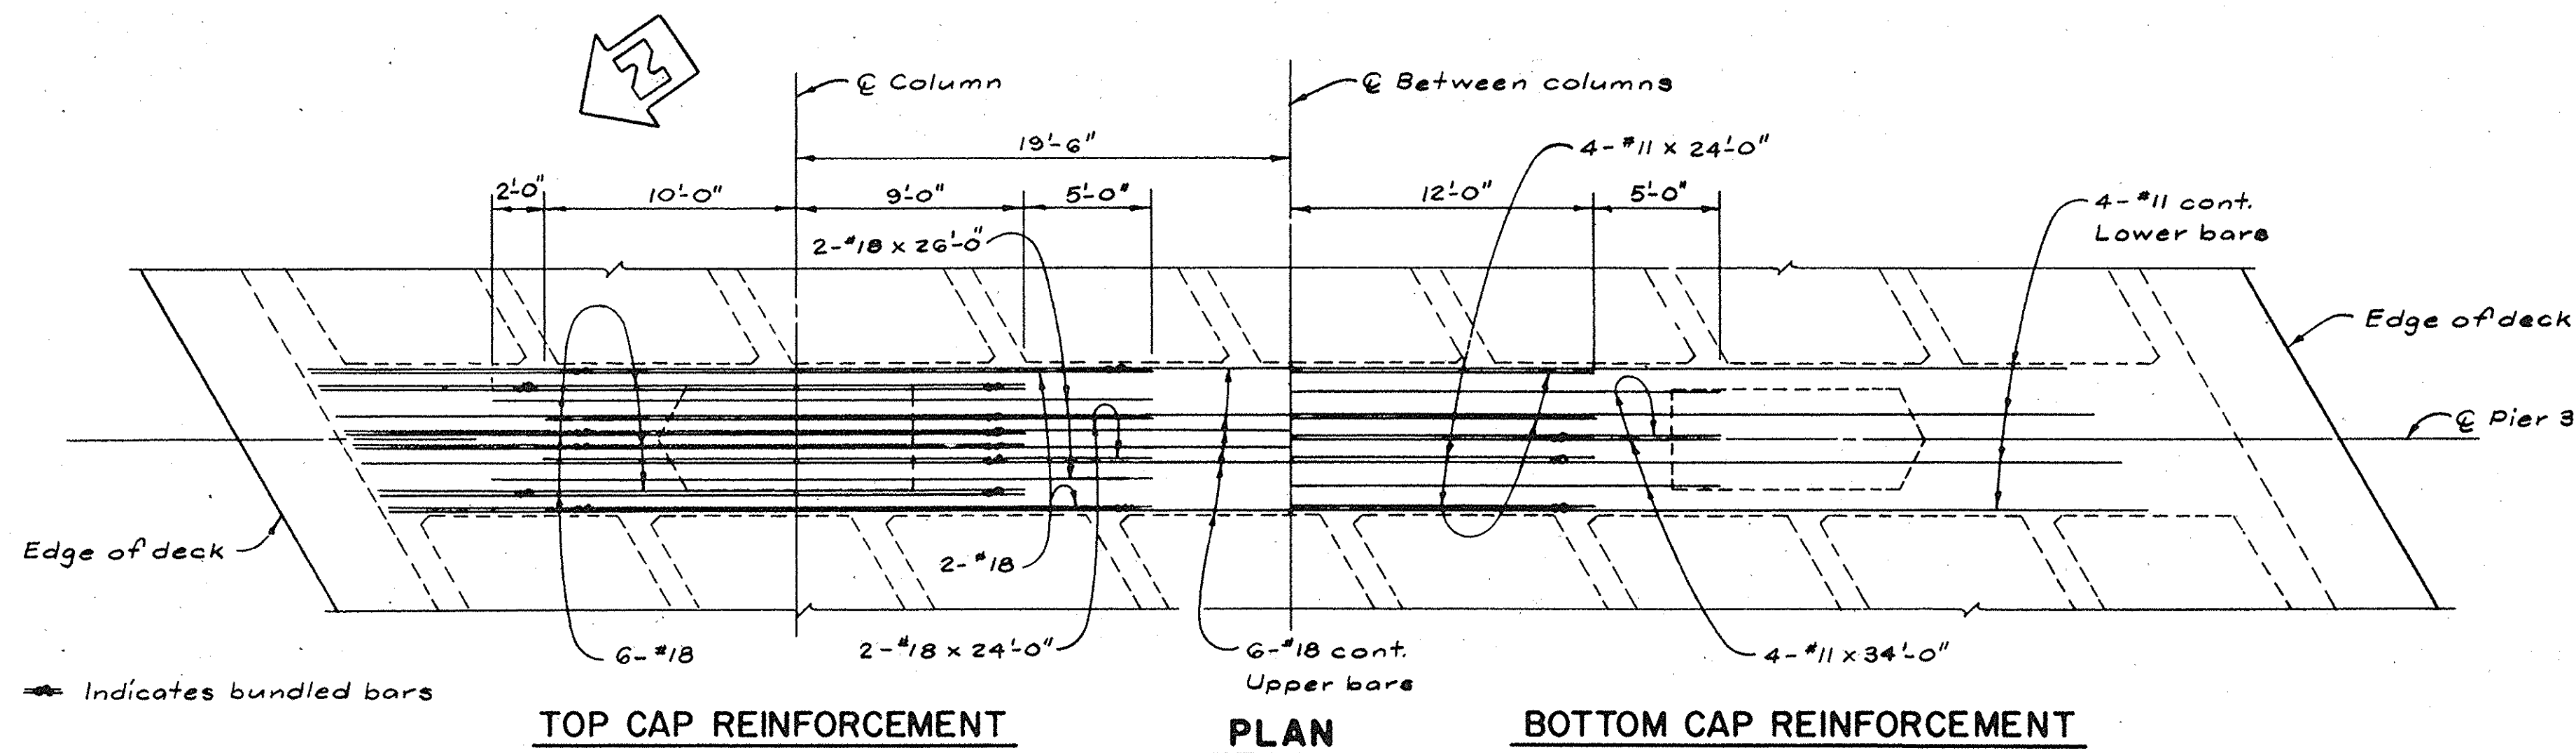

SECTION A-A
1/2" = 1'

** No lapped splice allowed

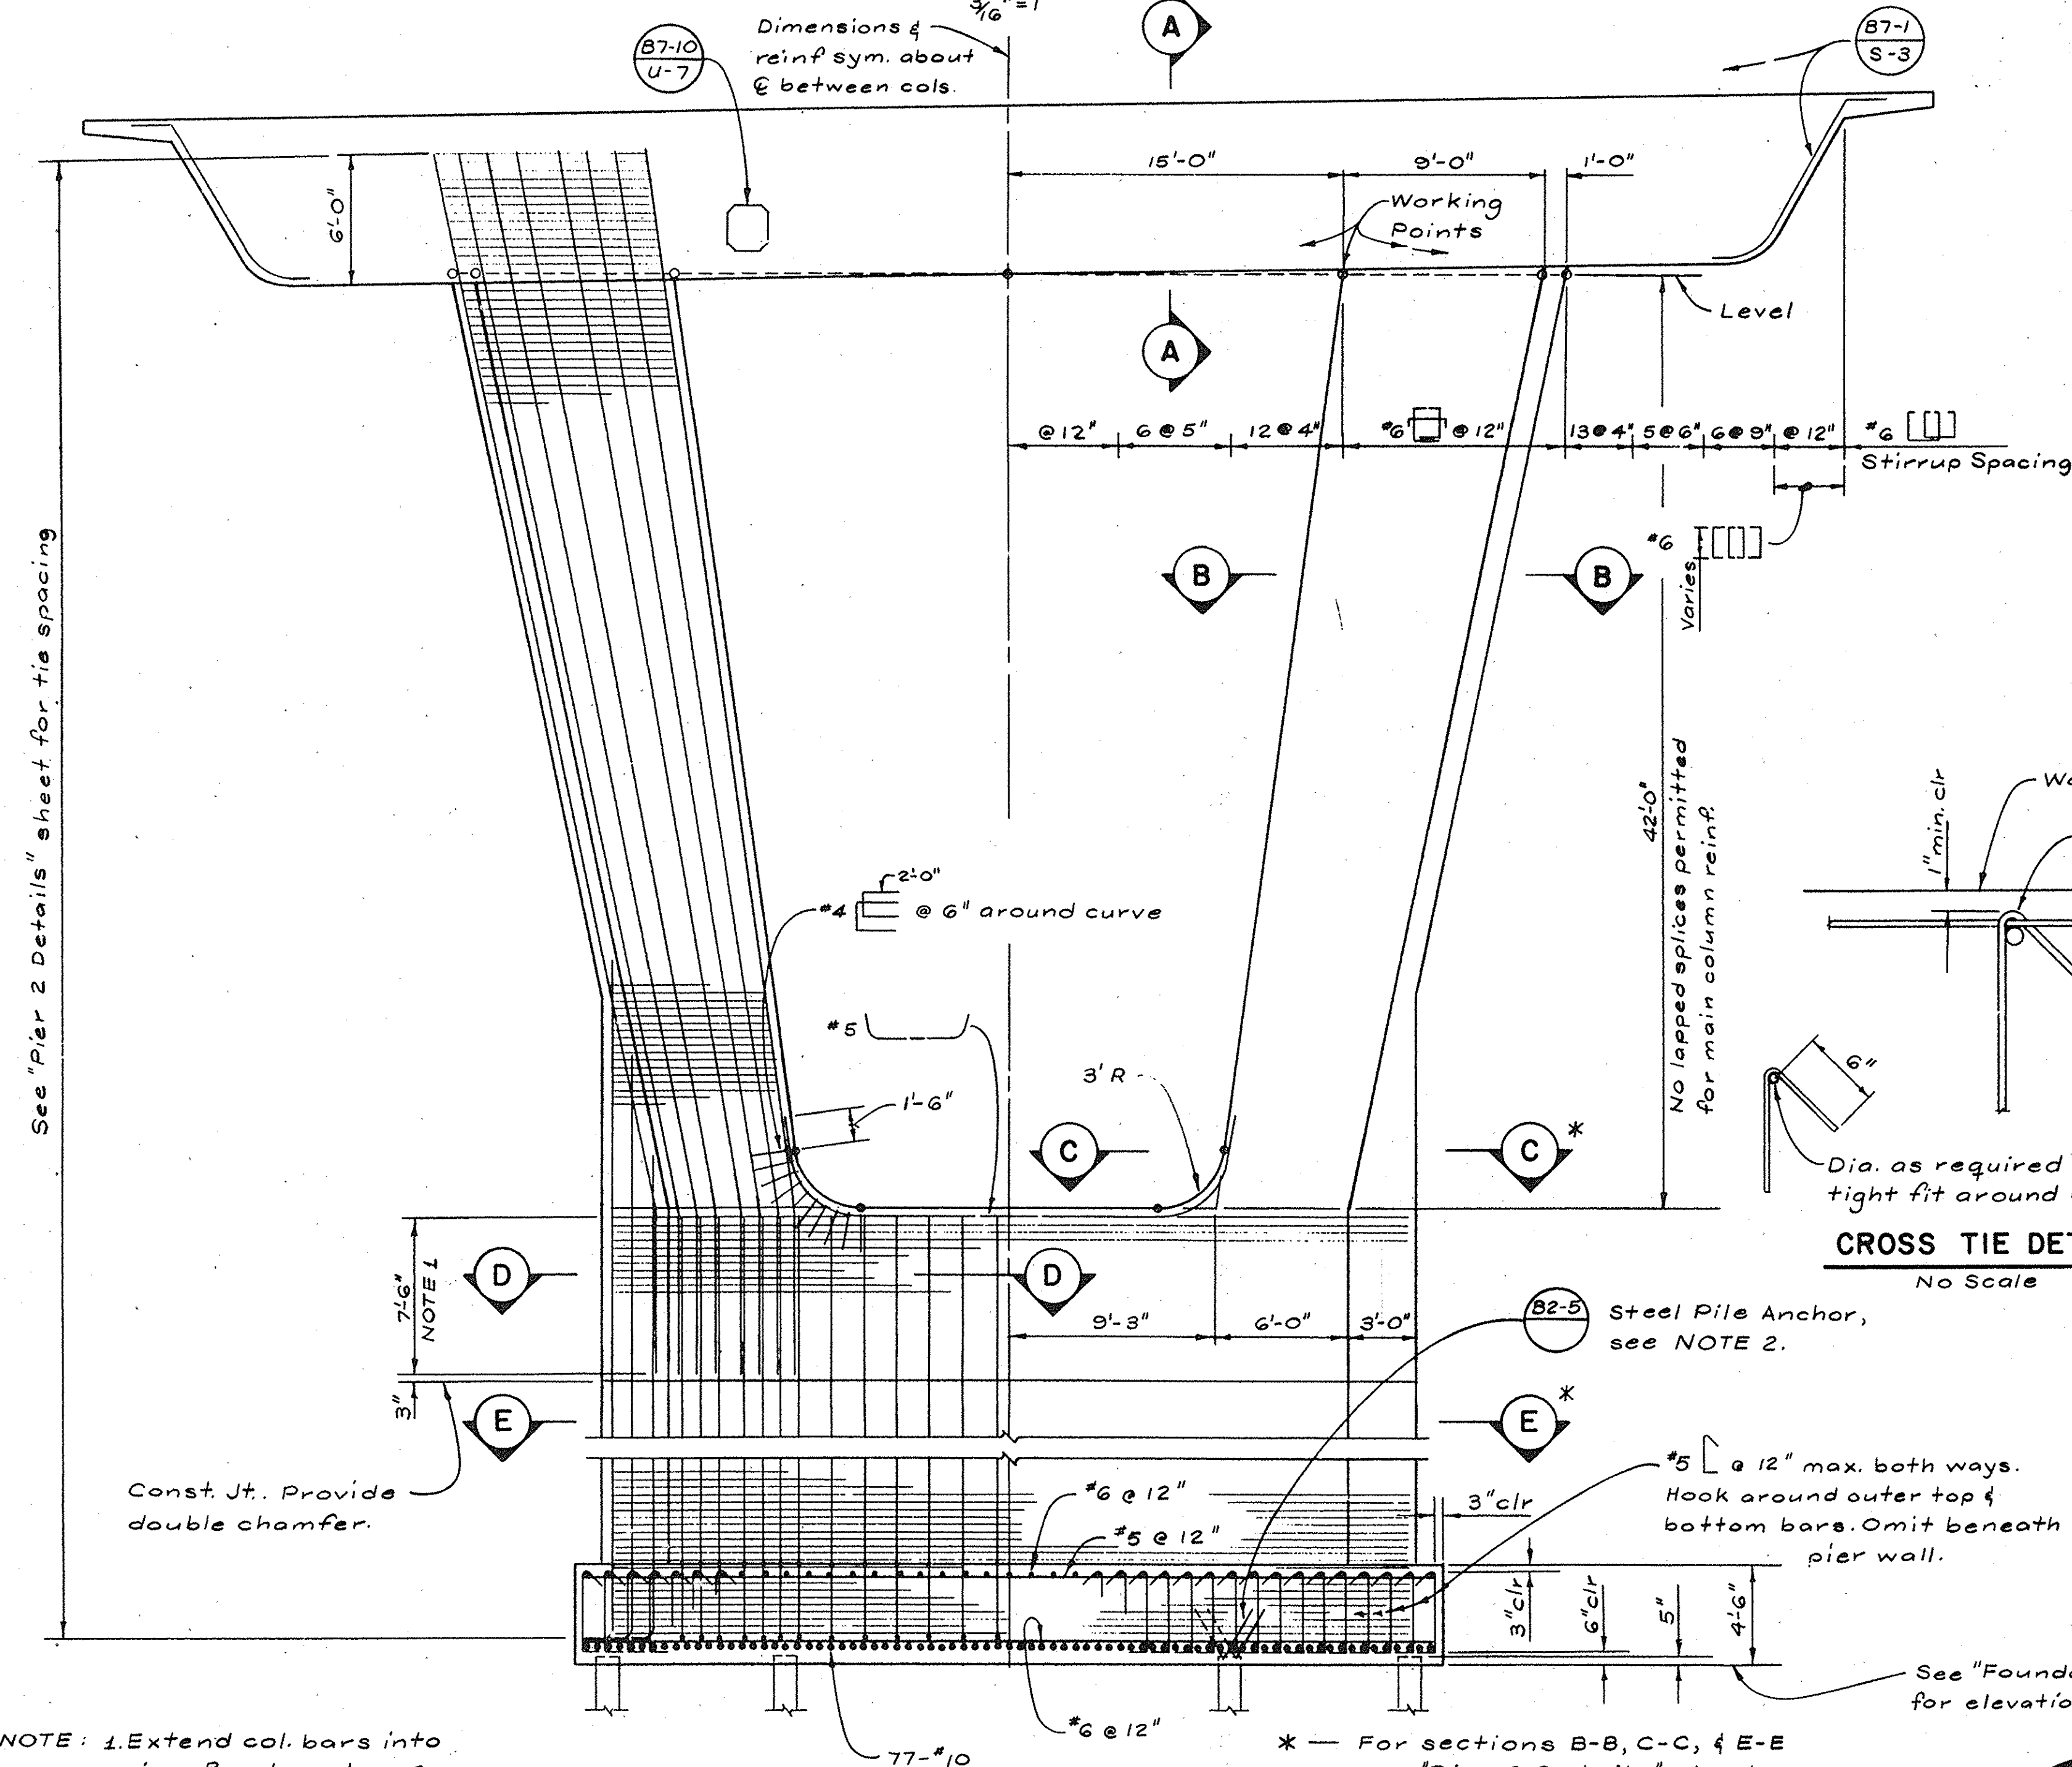

NOTE: 1. Extend col. bars into pier. Bend as shown.
2. Manufactured points required for steel piles, see special provisions.

ELEVATION
3/16" = 1'




AS BUILT 3.93 SLH

McDANIEL ENGINEERING COMPANY, INC.
3000 OLD TOWN AVE., SUITE 200, SAN DIEGO, CA 92116 (619) 592-1000

DESIGNED BY: WMA
DRAWN BY: RLA
CHECKED BY: CCC
FIELD BOOK:

APPROVED BY: [Signature]
R.C.E. C 34299
EXPIRES 9-30-91
DATE 6-28-89

FOOTING PLAN
3/16" = 1'

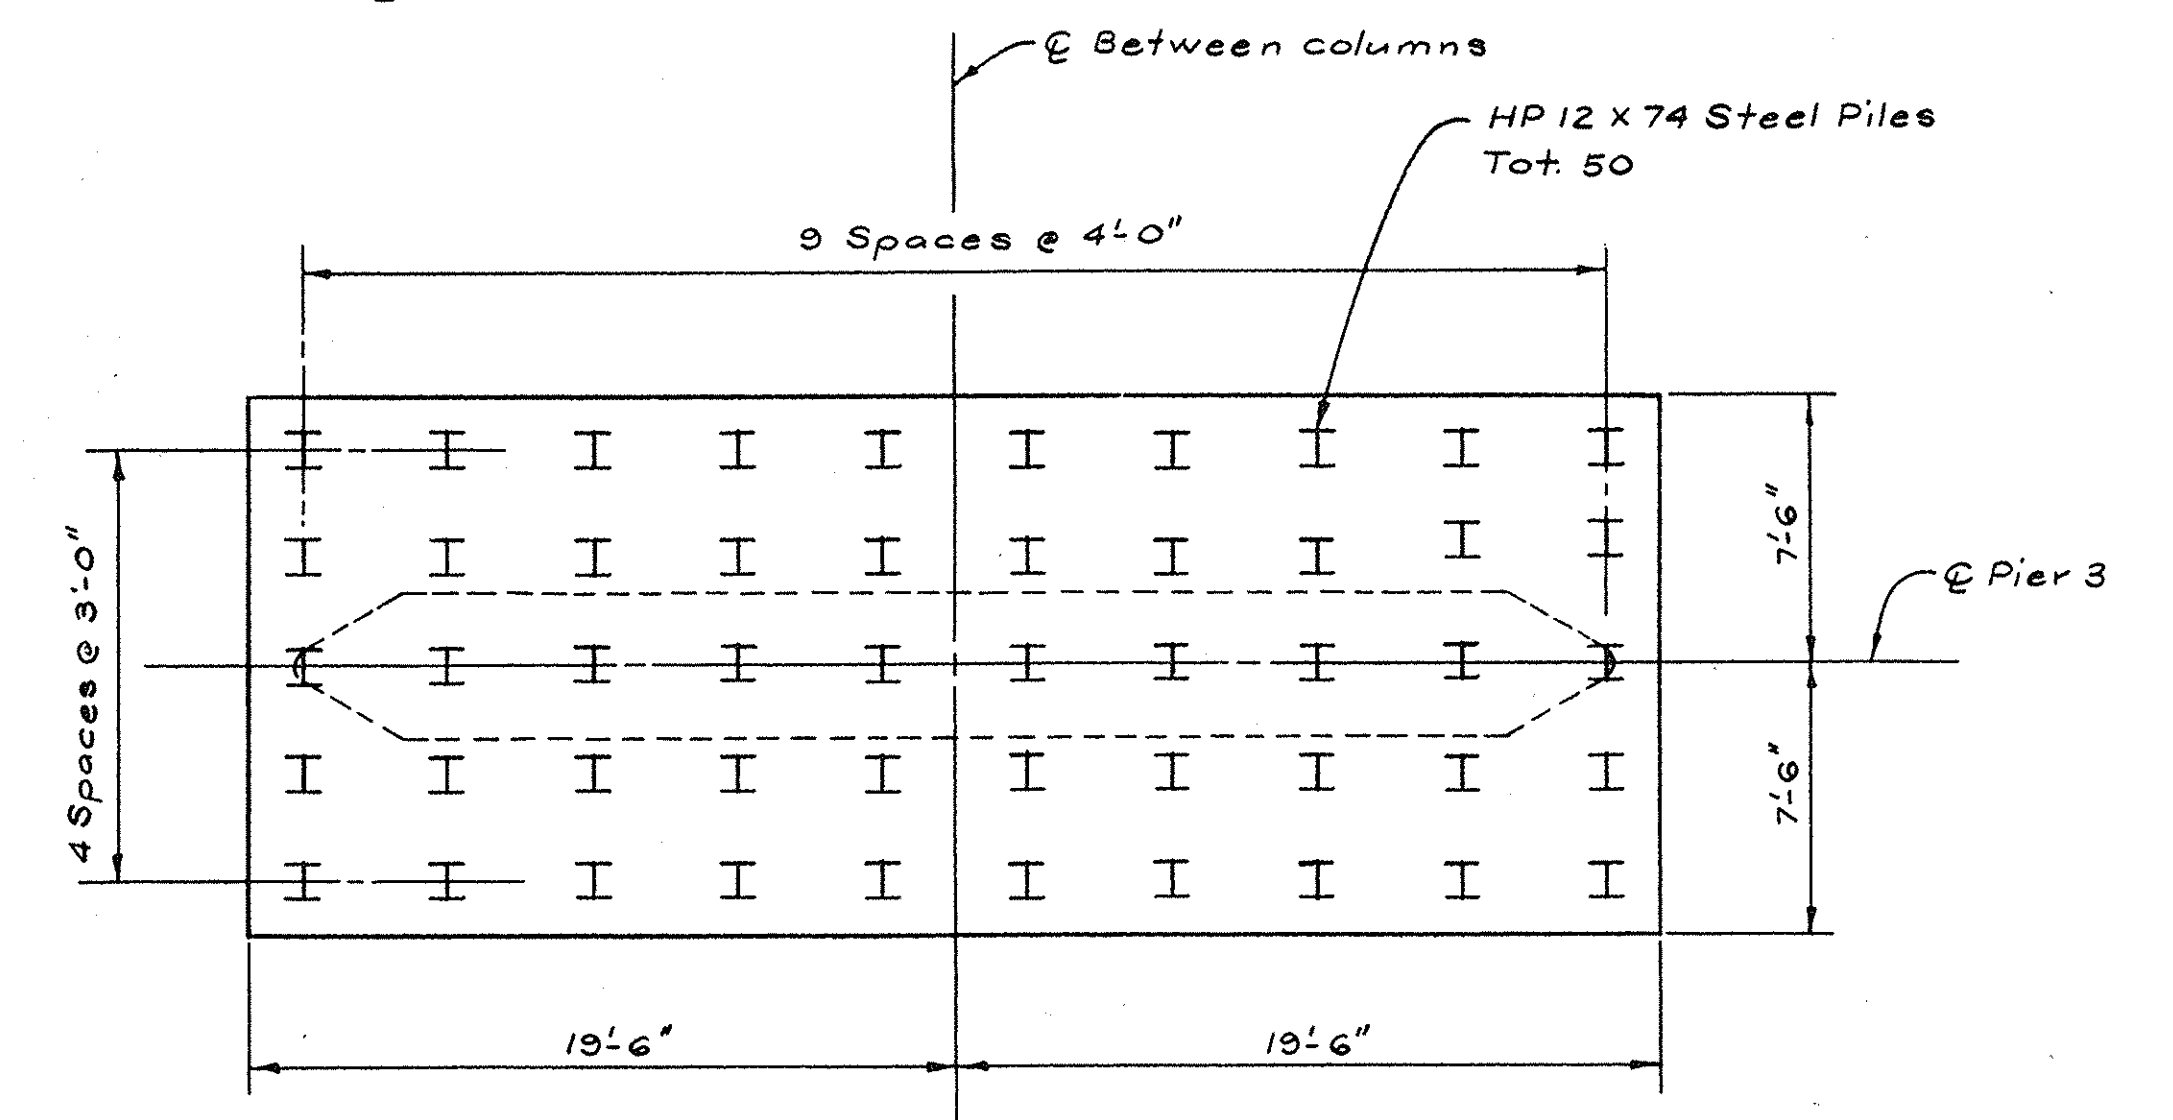

**SANTA MARGARITA PARKWAY BRIDGE
OVER ARROYO TRABUCO - WIDENING**

PIER 3 DETAILS

SHEET
29
OF
57
SHEETS

DR. 19-15700