
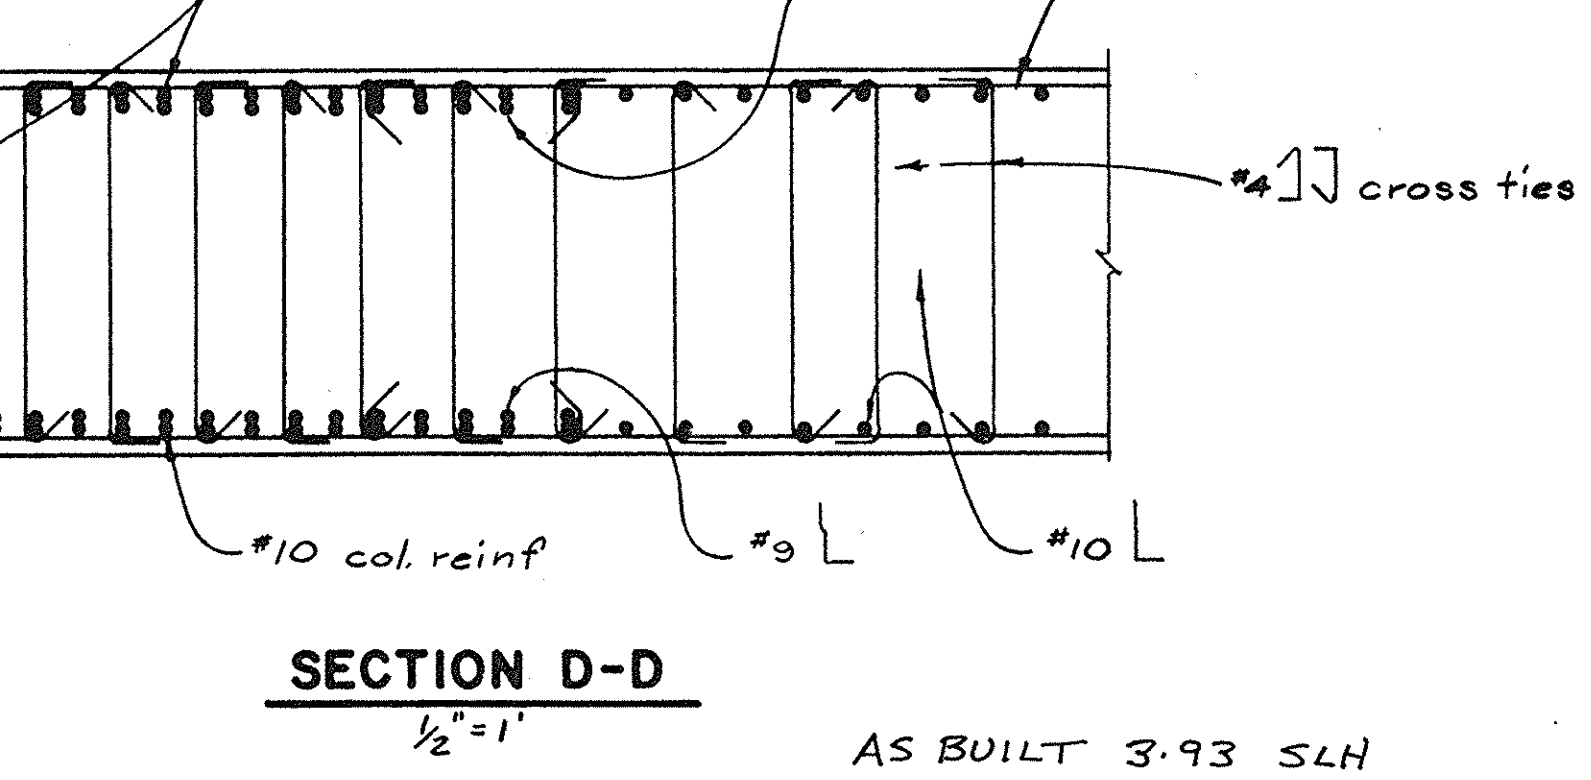
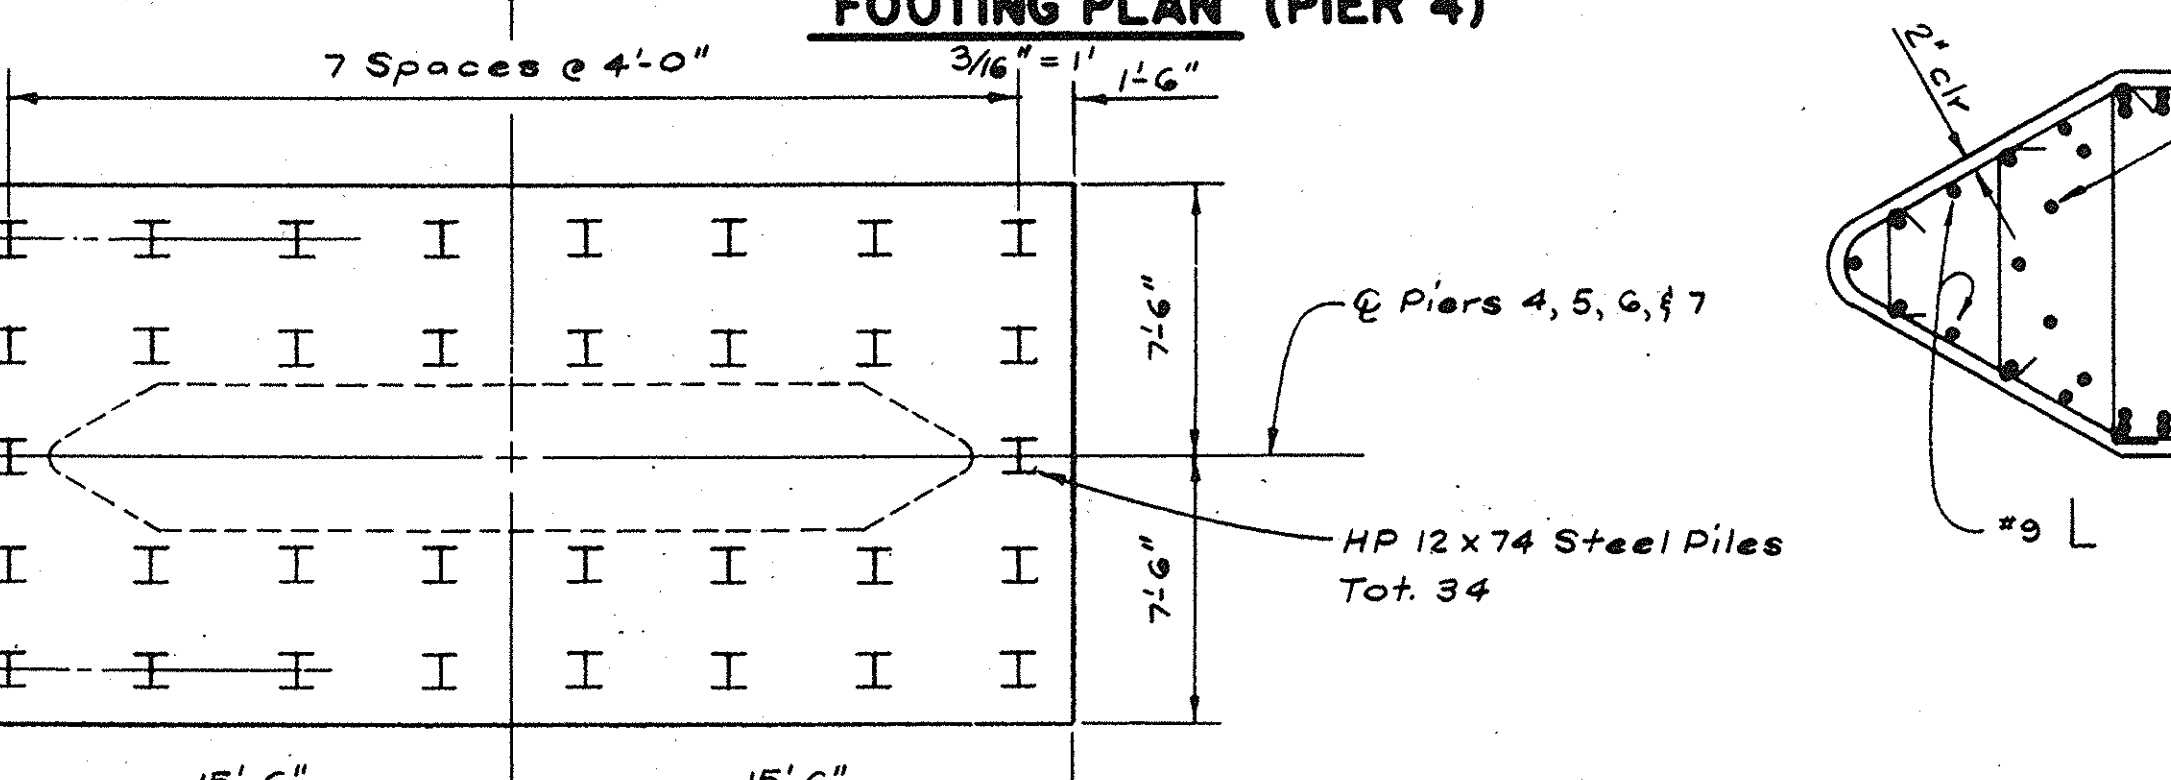
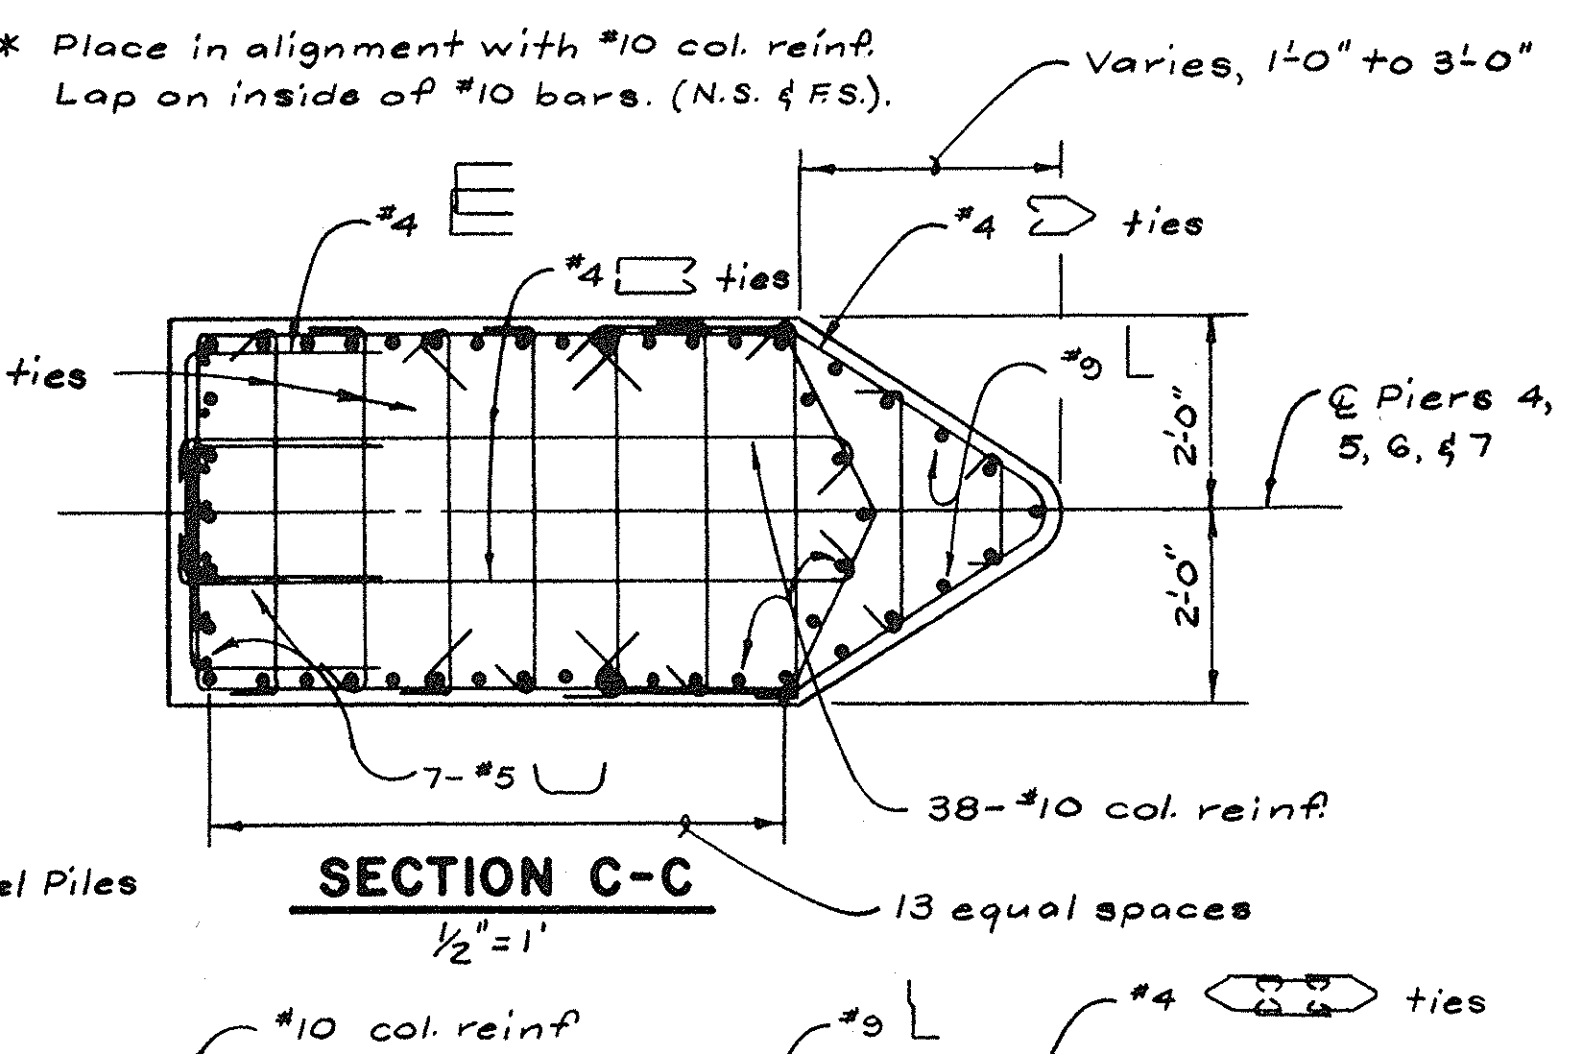
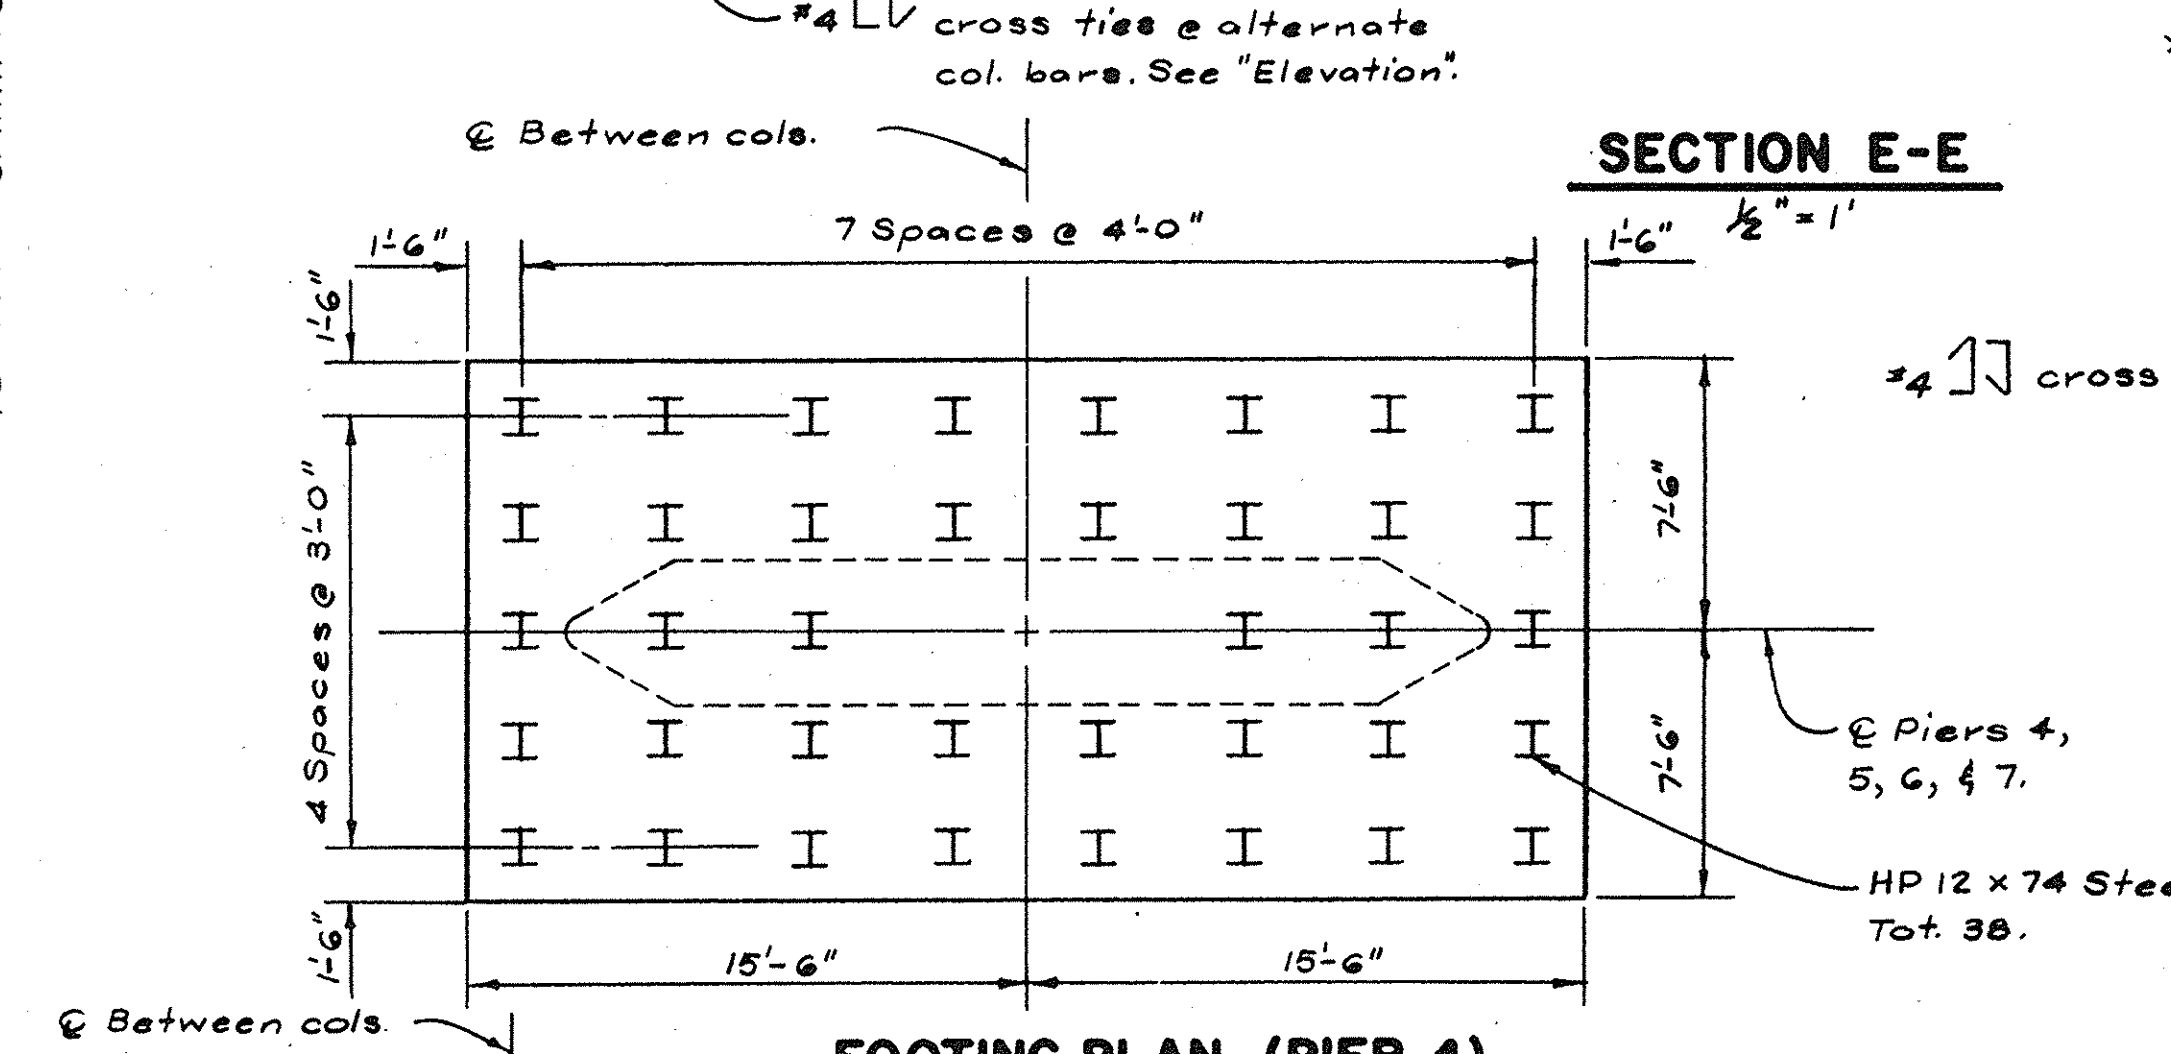
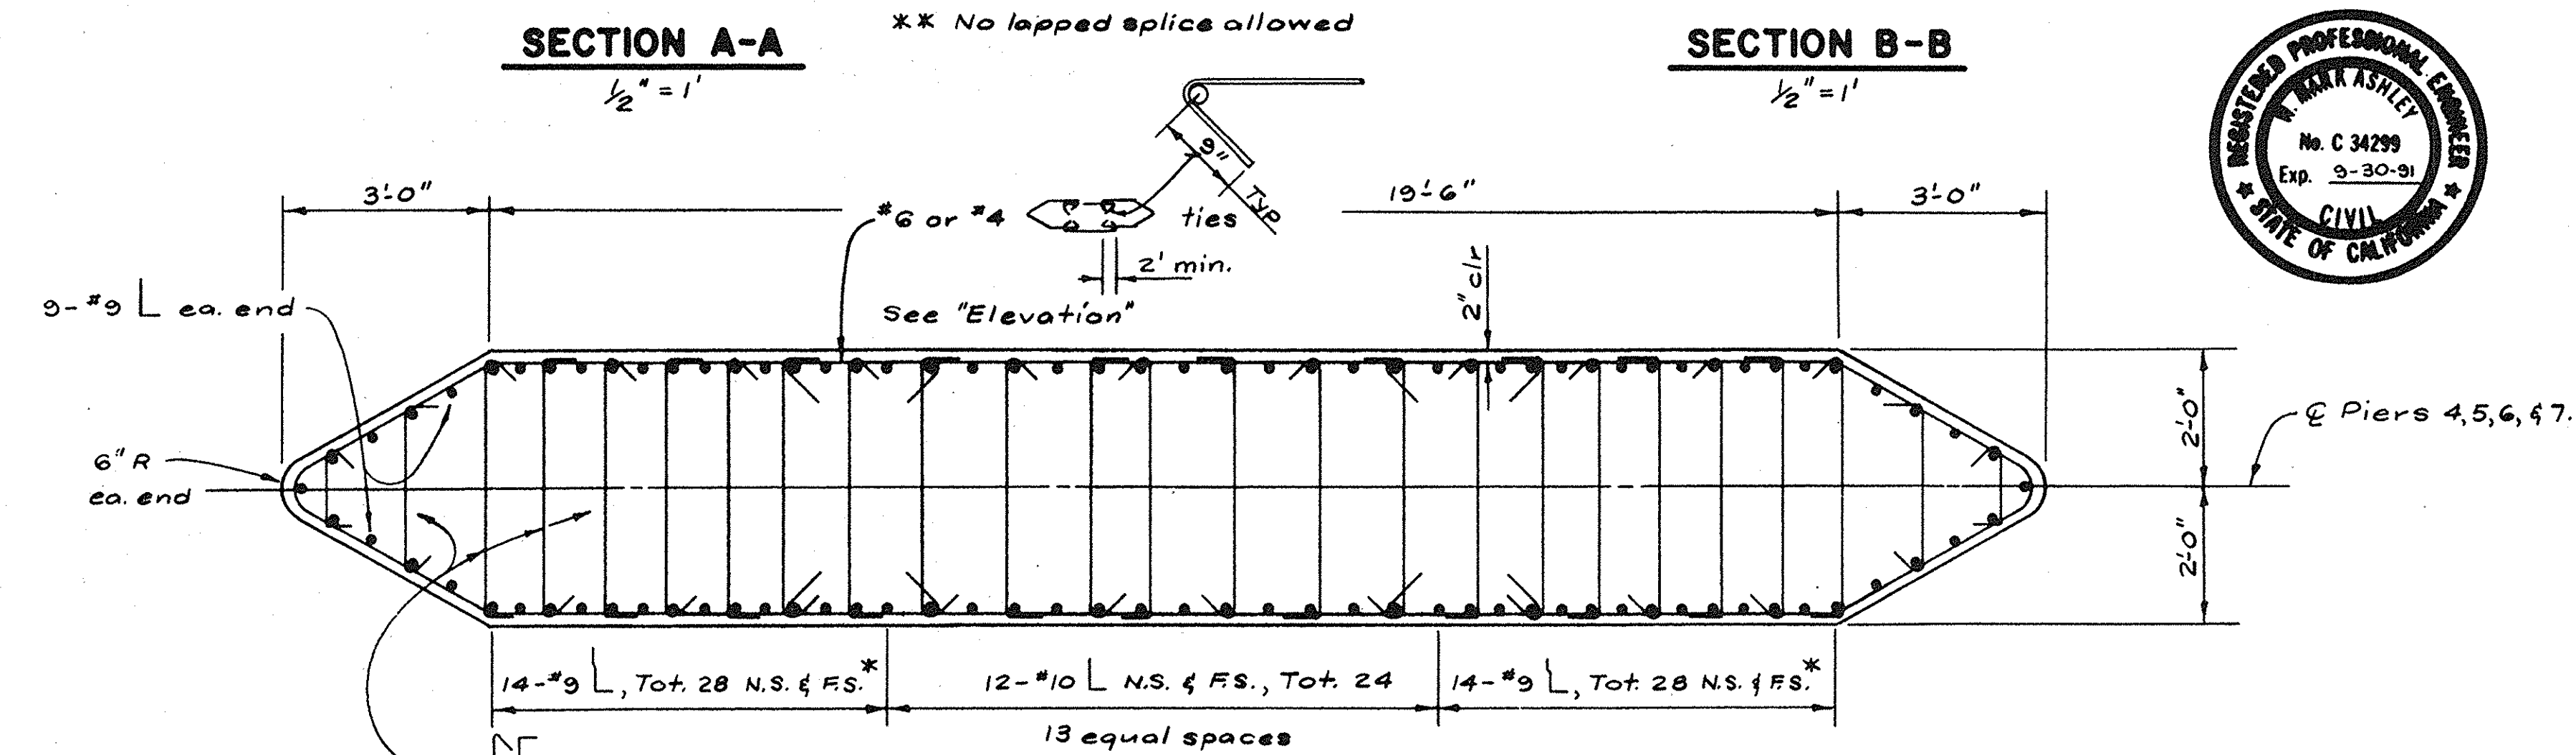
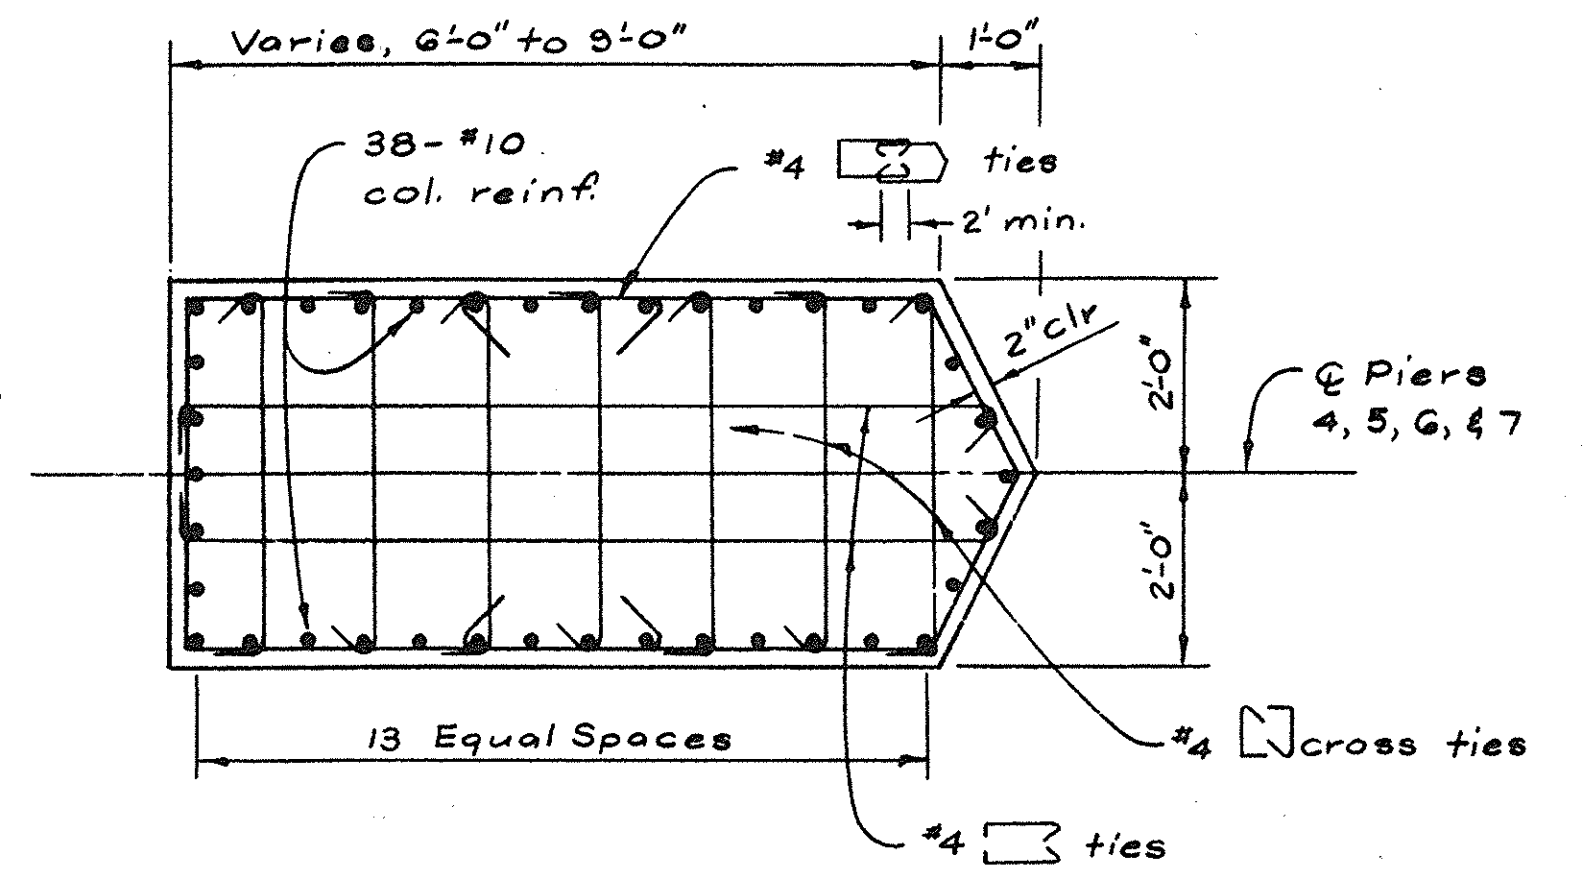
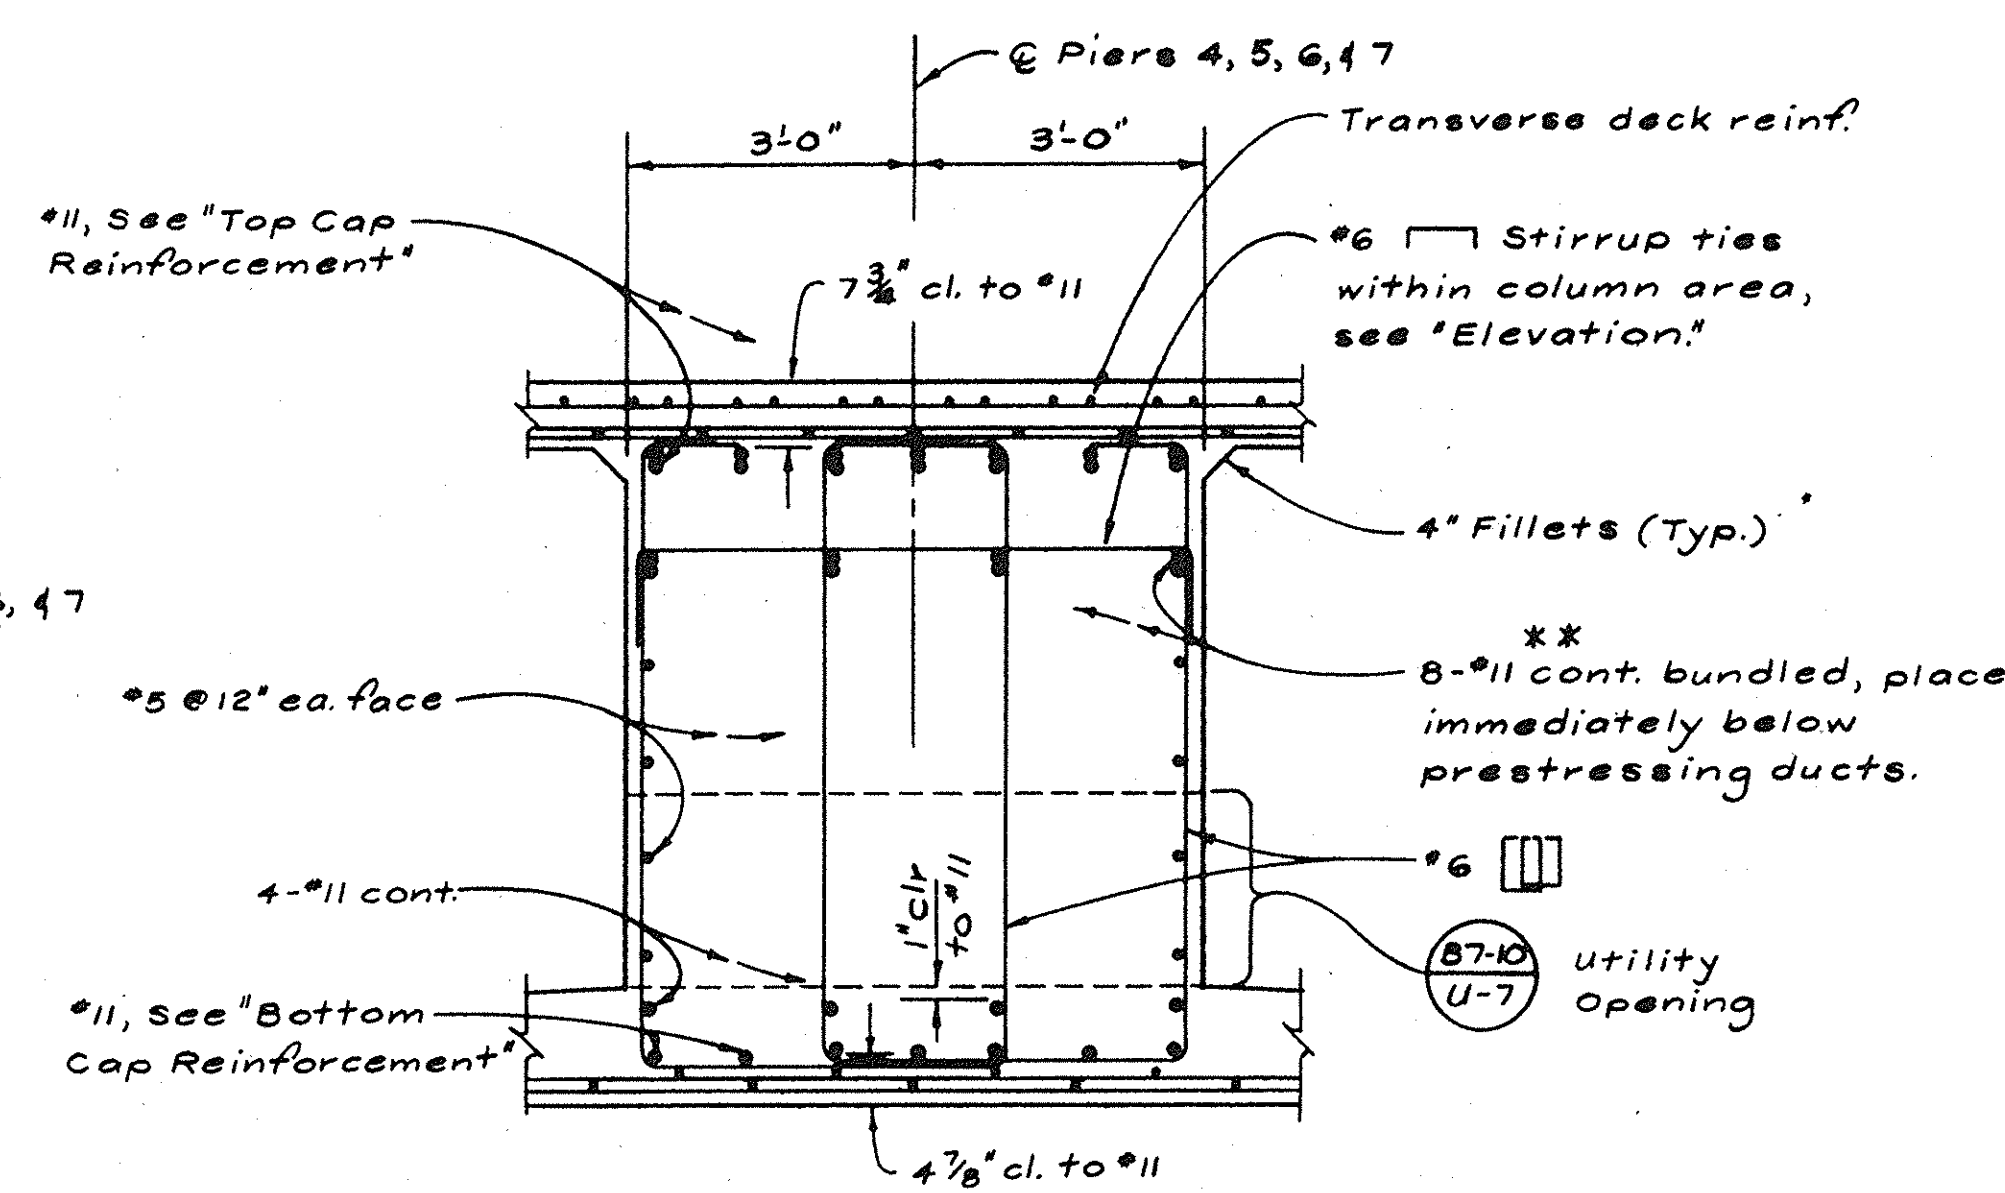
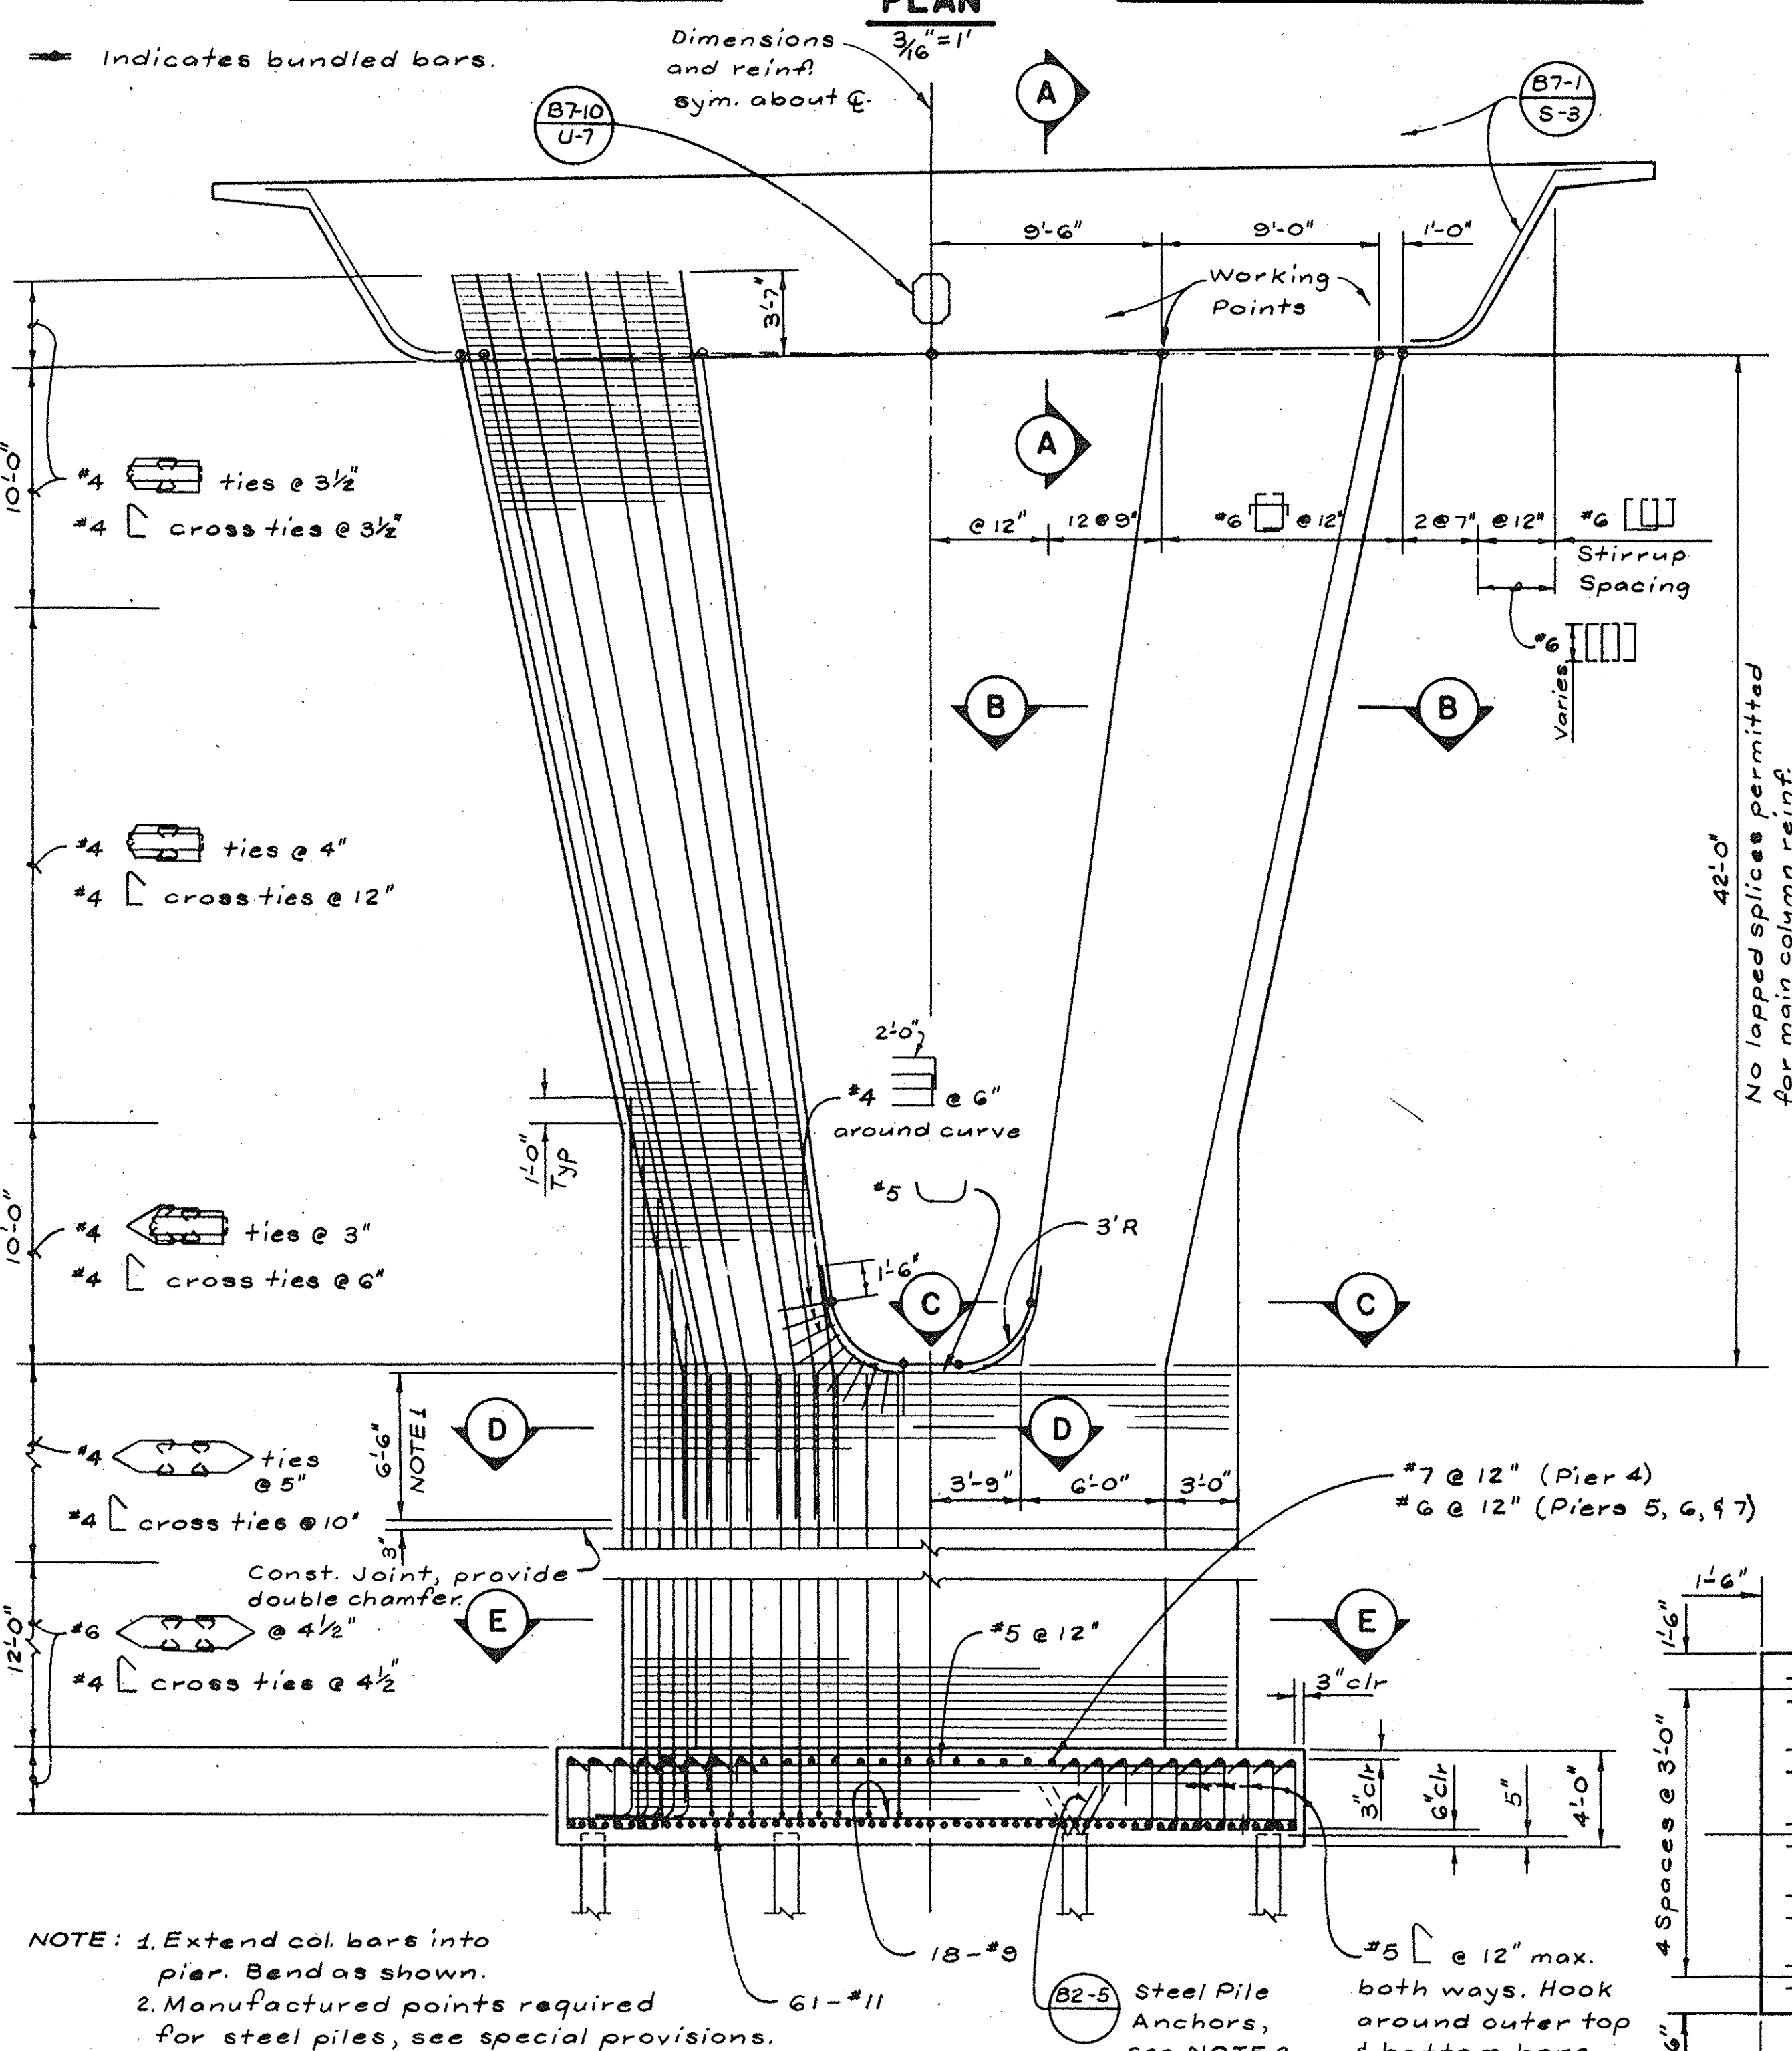


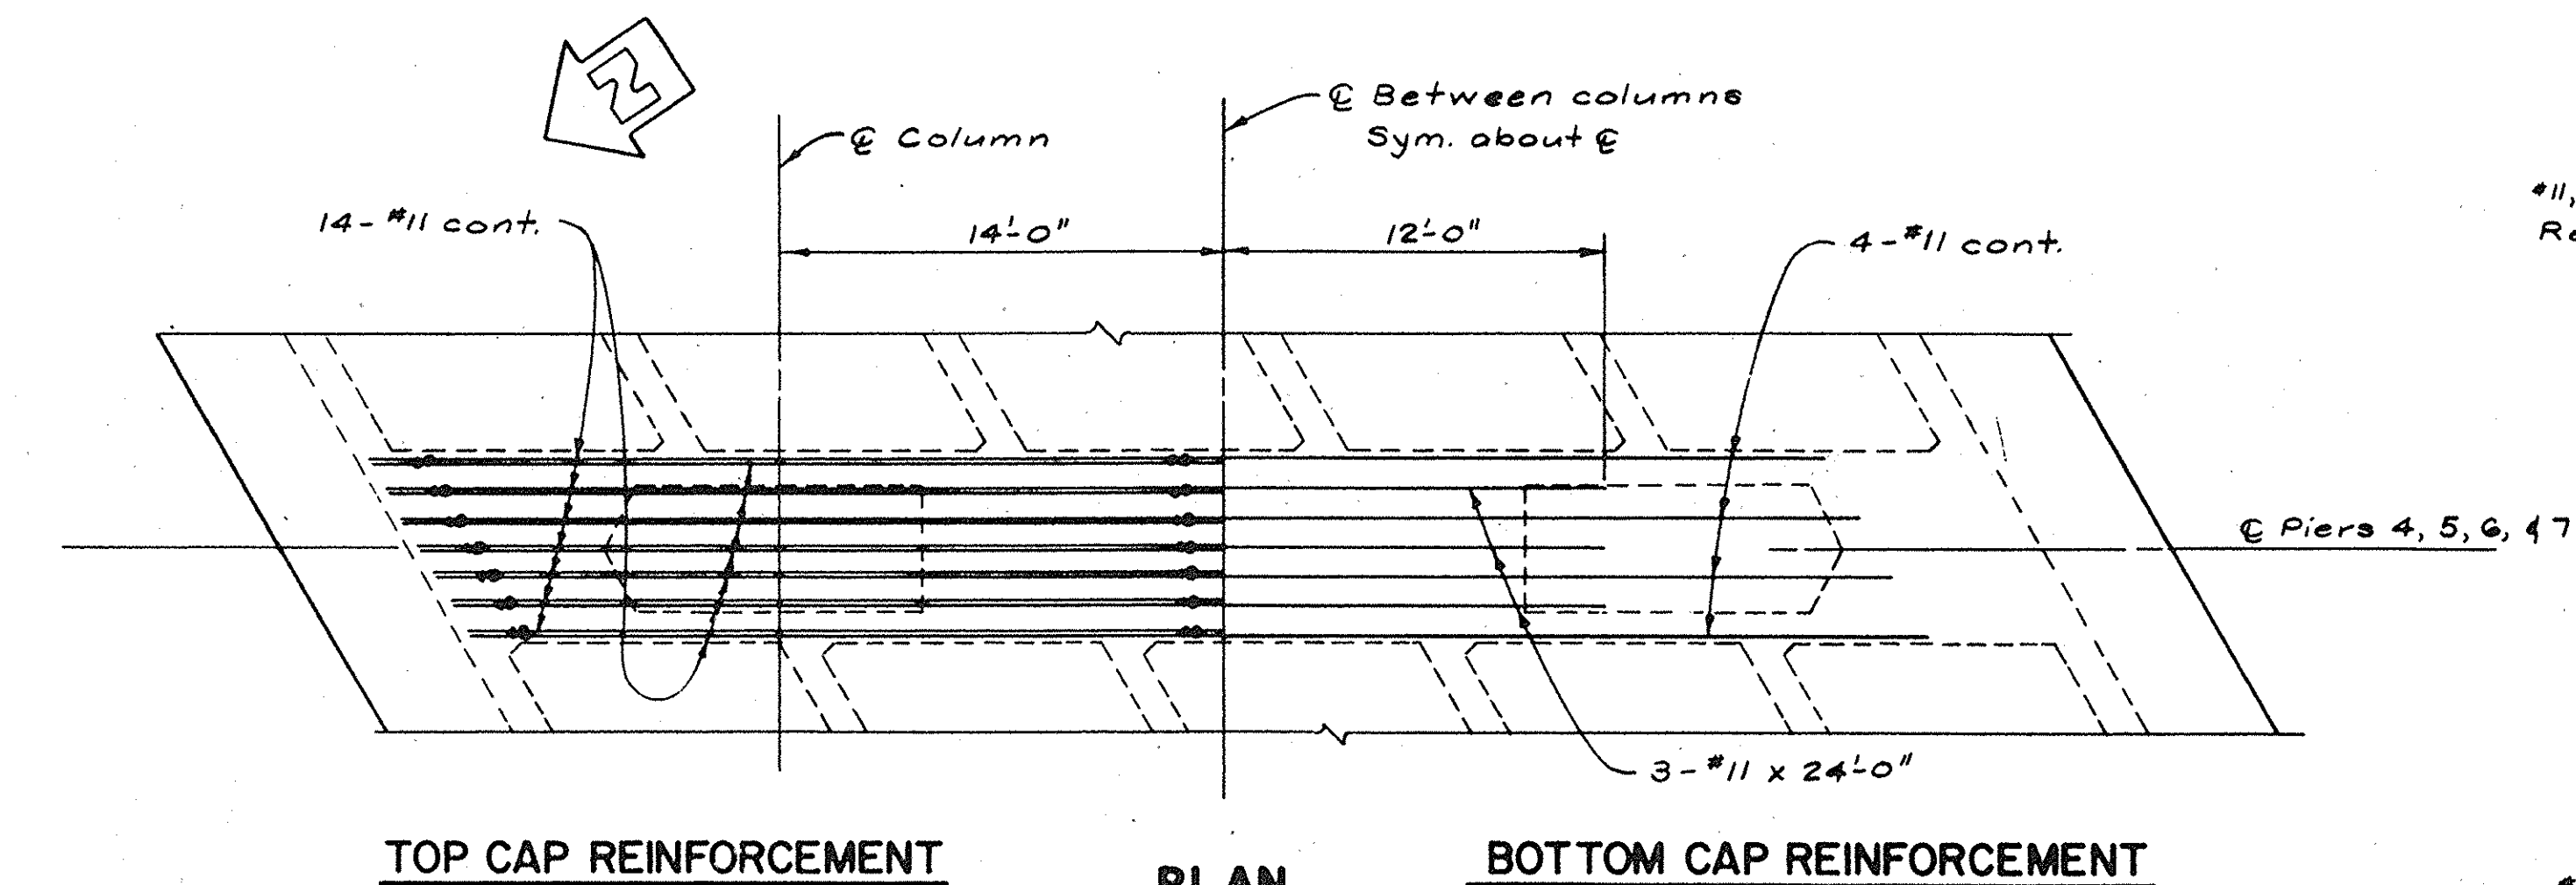

McDANIEL ENGINEERING COMPANY, INC. 2000 OLD TOWN AVE., SUITE 207B, SAN DIEGO, CA 92110 (619) 592-1000				DESIGNED BY W.M.A. DRAWN BY R.L.A. CHECKED BY C.C.C. FIELD BOOK	SANTA MARGARITA PARKWAY BRIDGE OVER ARROYO TRABUCO - WIDENING PIERS 4, 5, 6, & 7 DETAILS	SHEET 30 OF 57 SHEETS JOB NO.
APPROVED BY 	R.C.E. C 34299	EXPIRES 9-30-91	DATE 6-28-91	AS BUILT 3.93 SLH		

DR. 19 15799