

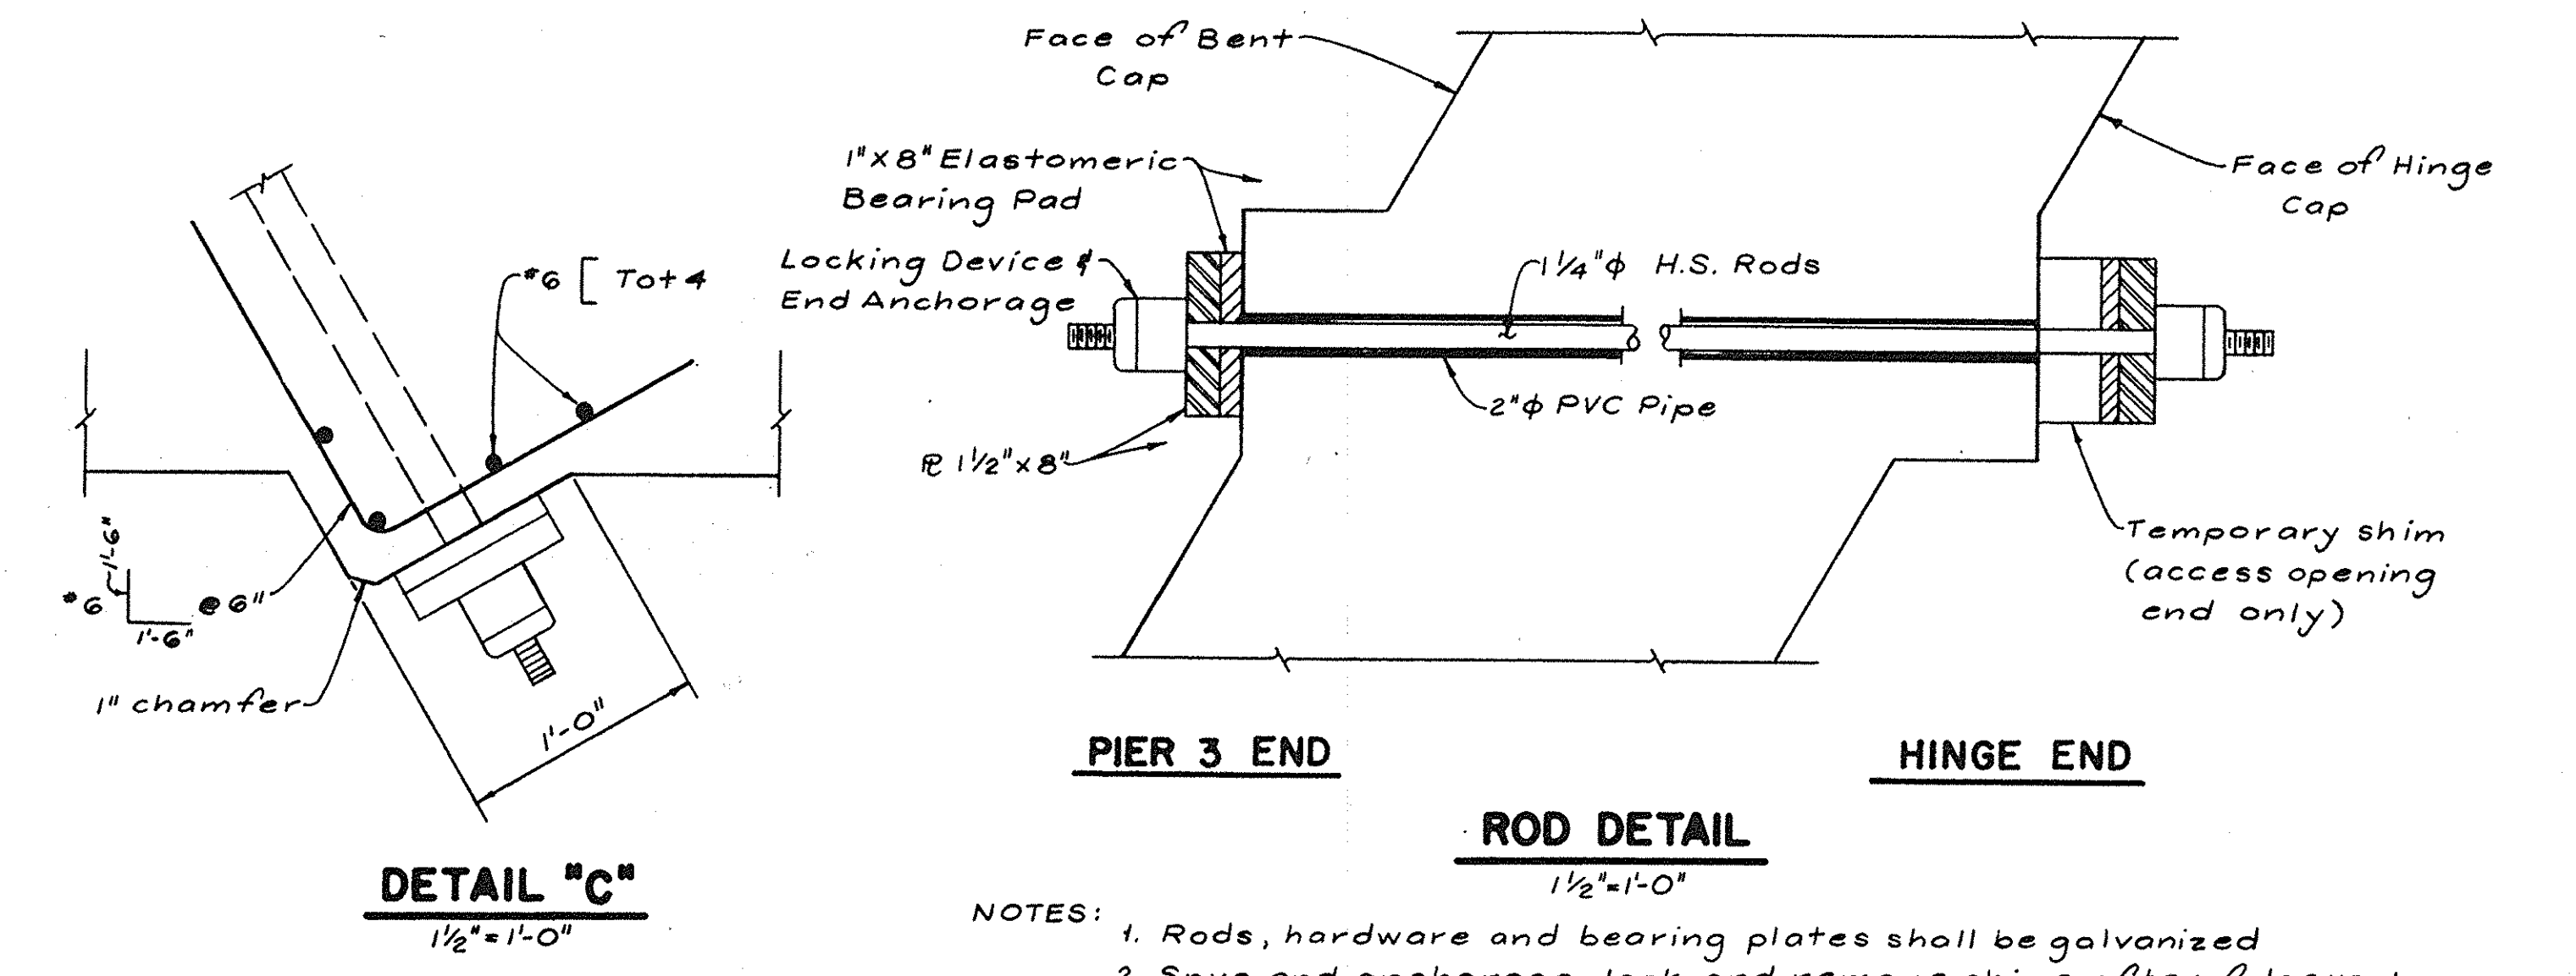
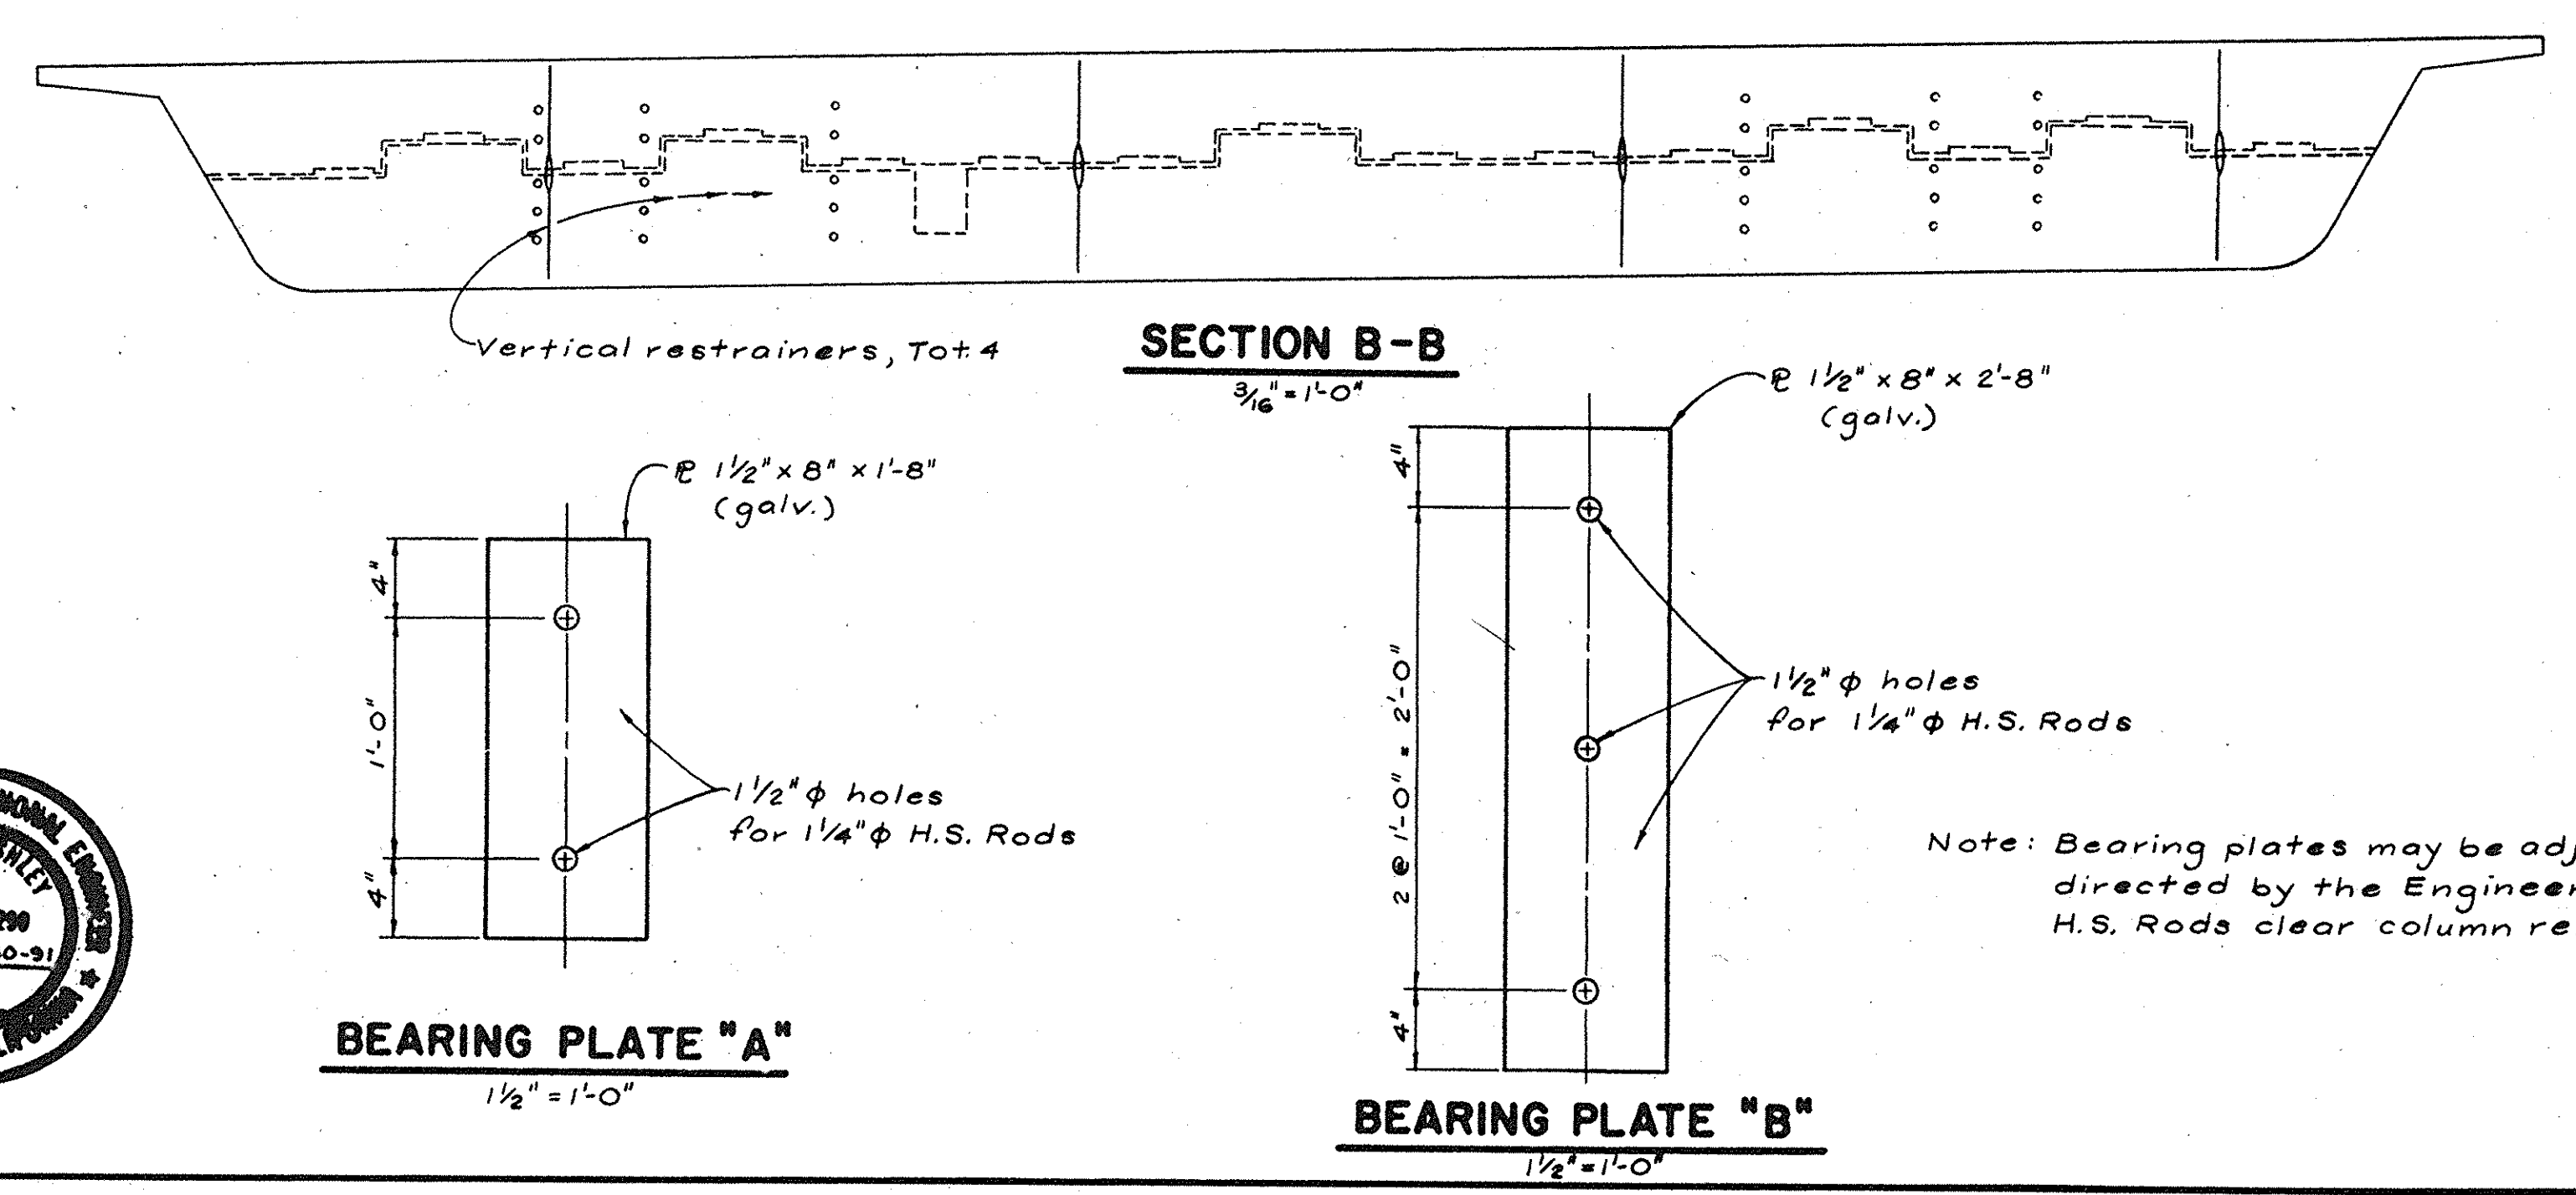
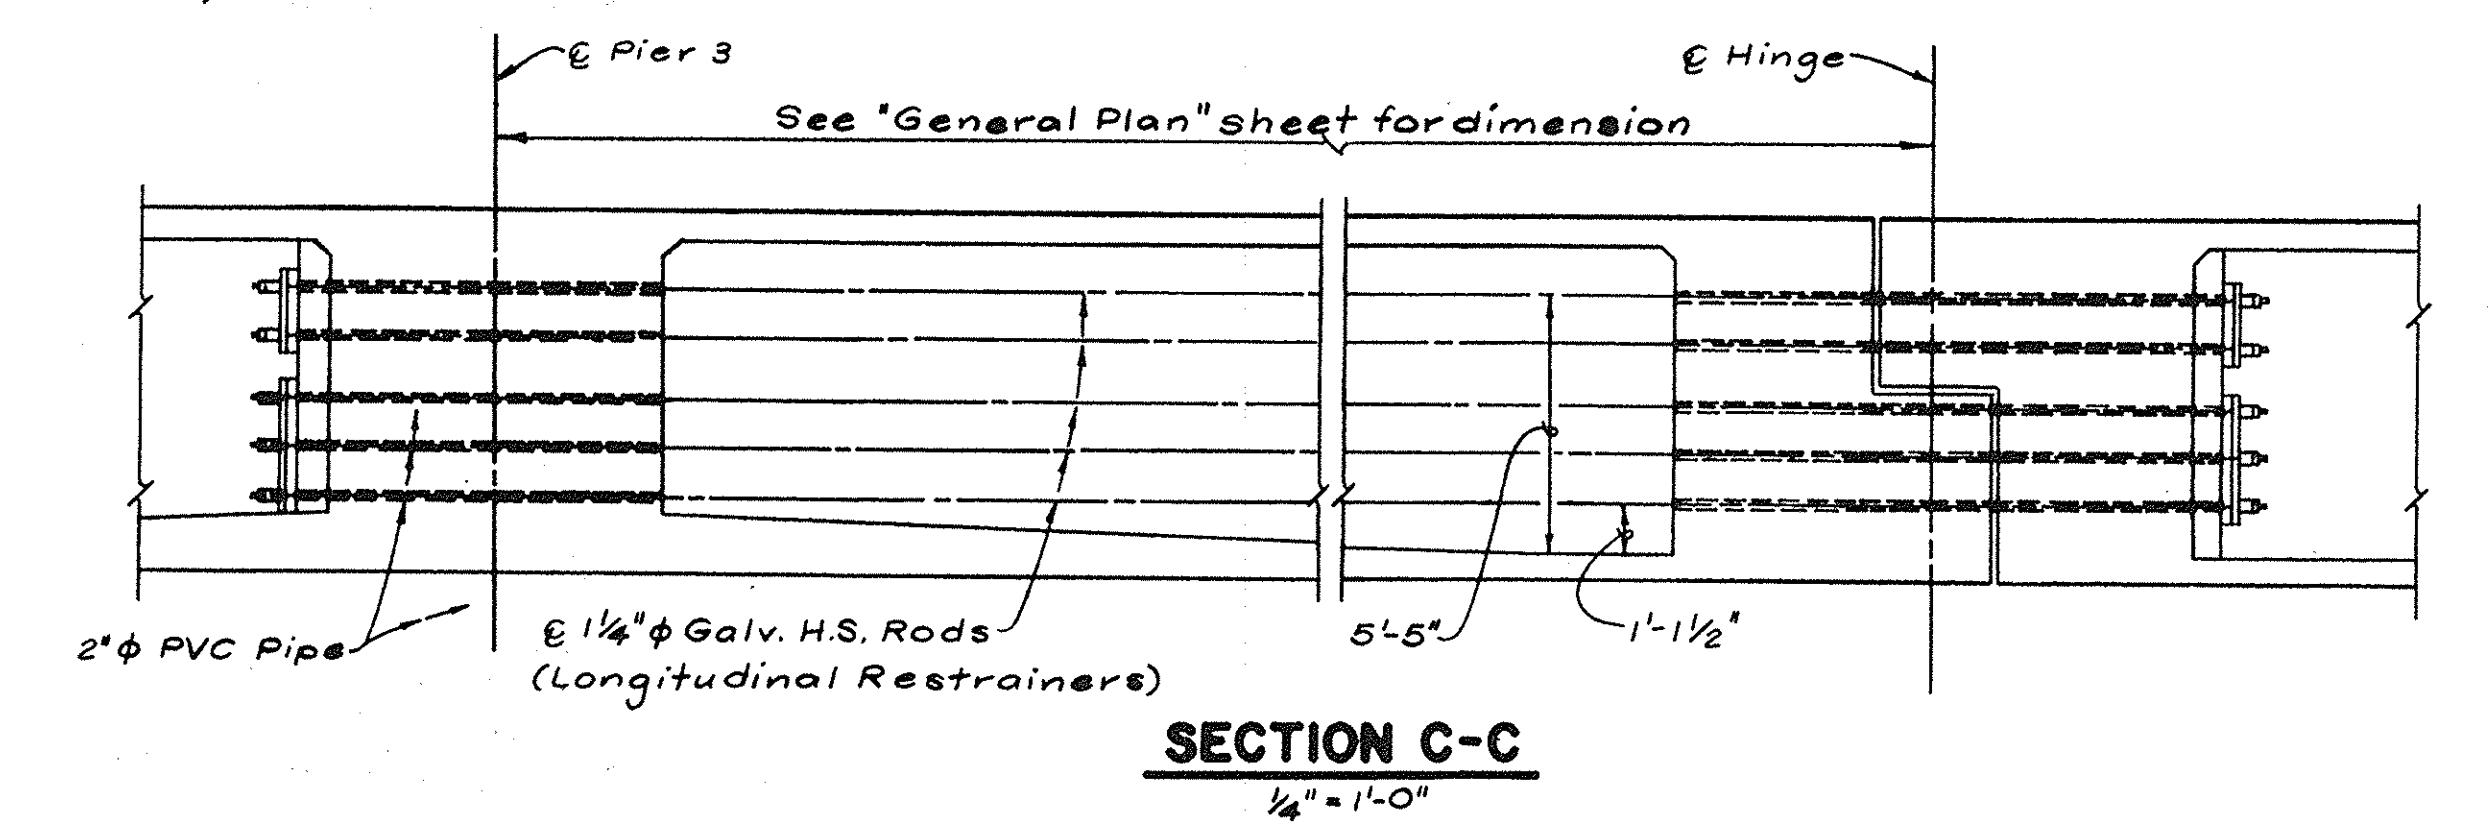
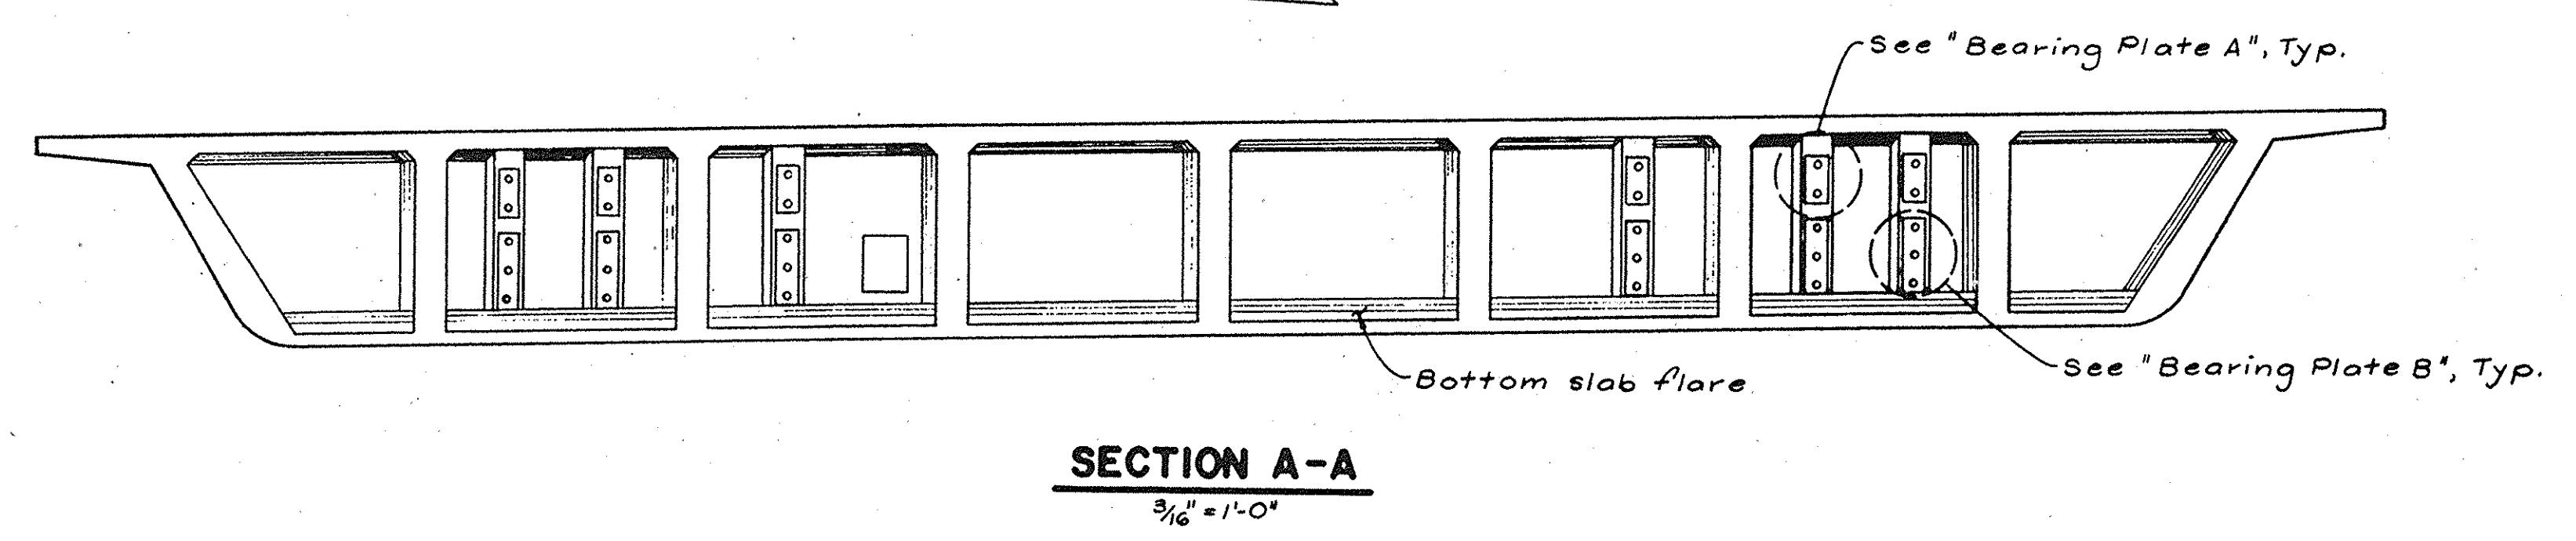


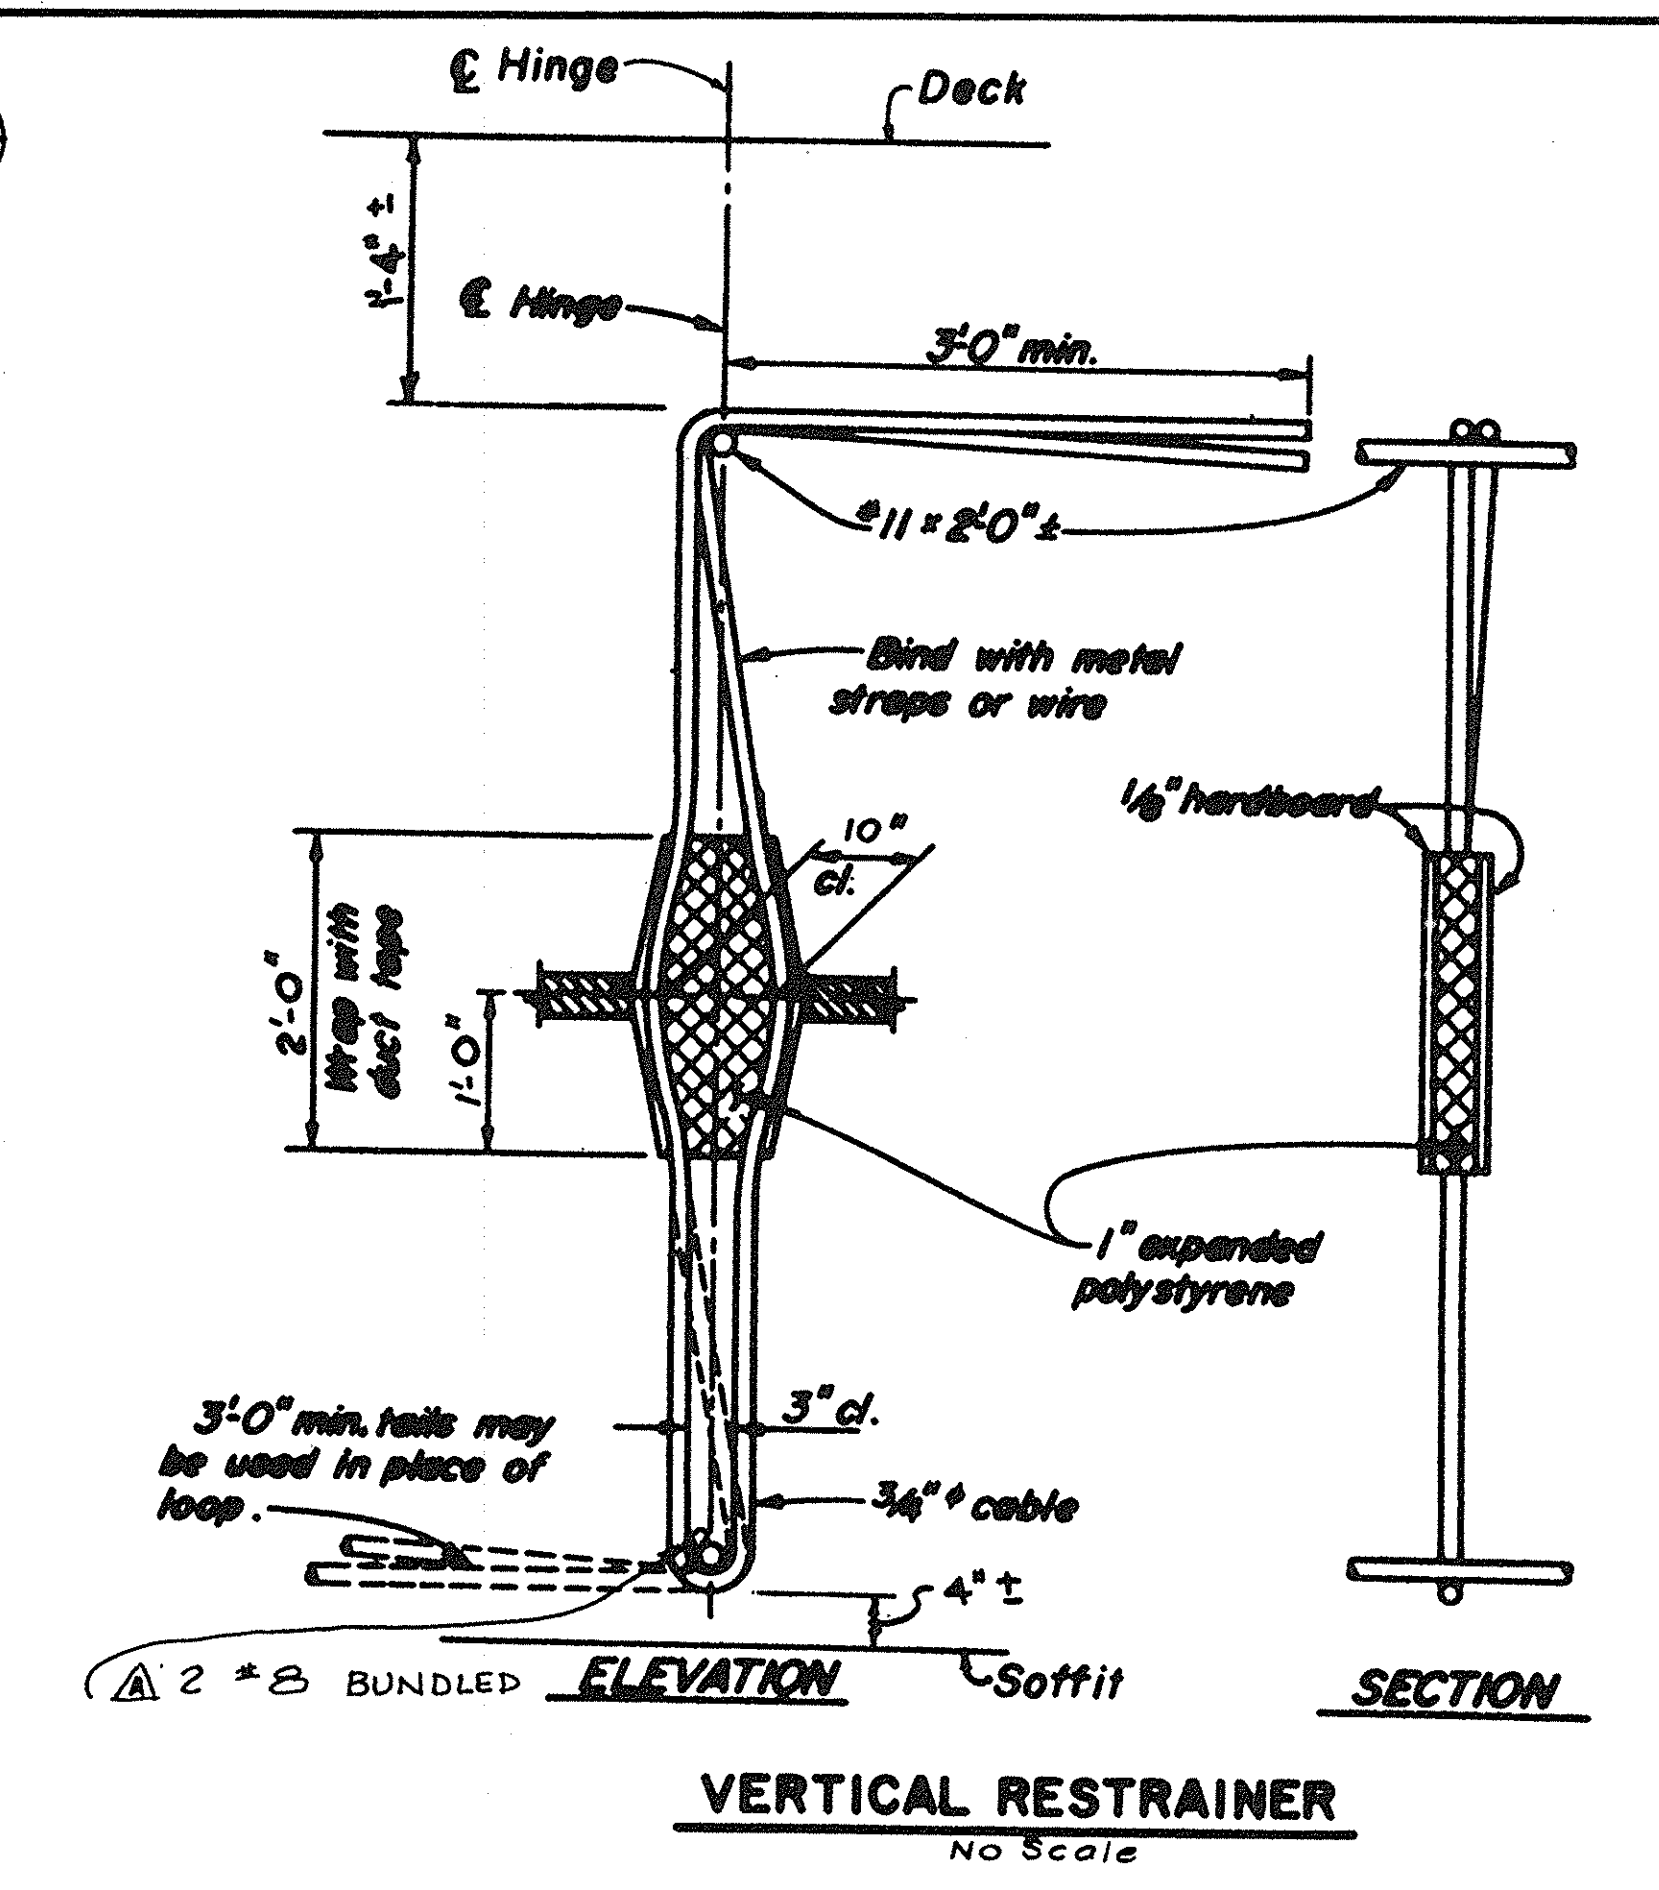

- NOTES:
1. Rods, hardware and bearing plates shall be galvanized
 2. Snug end anchorage, lock and remove shims after falsework is removed.
 3. Shim thickness to be determined by the engineer.

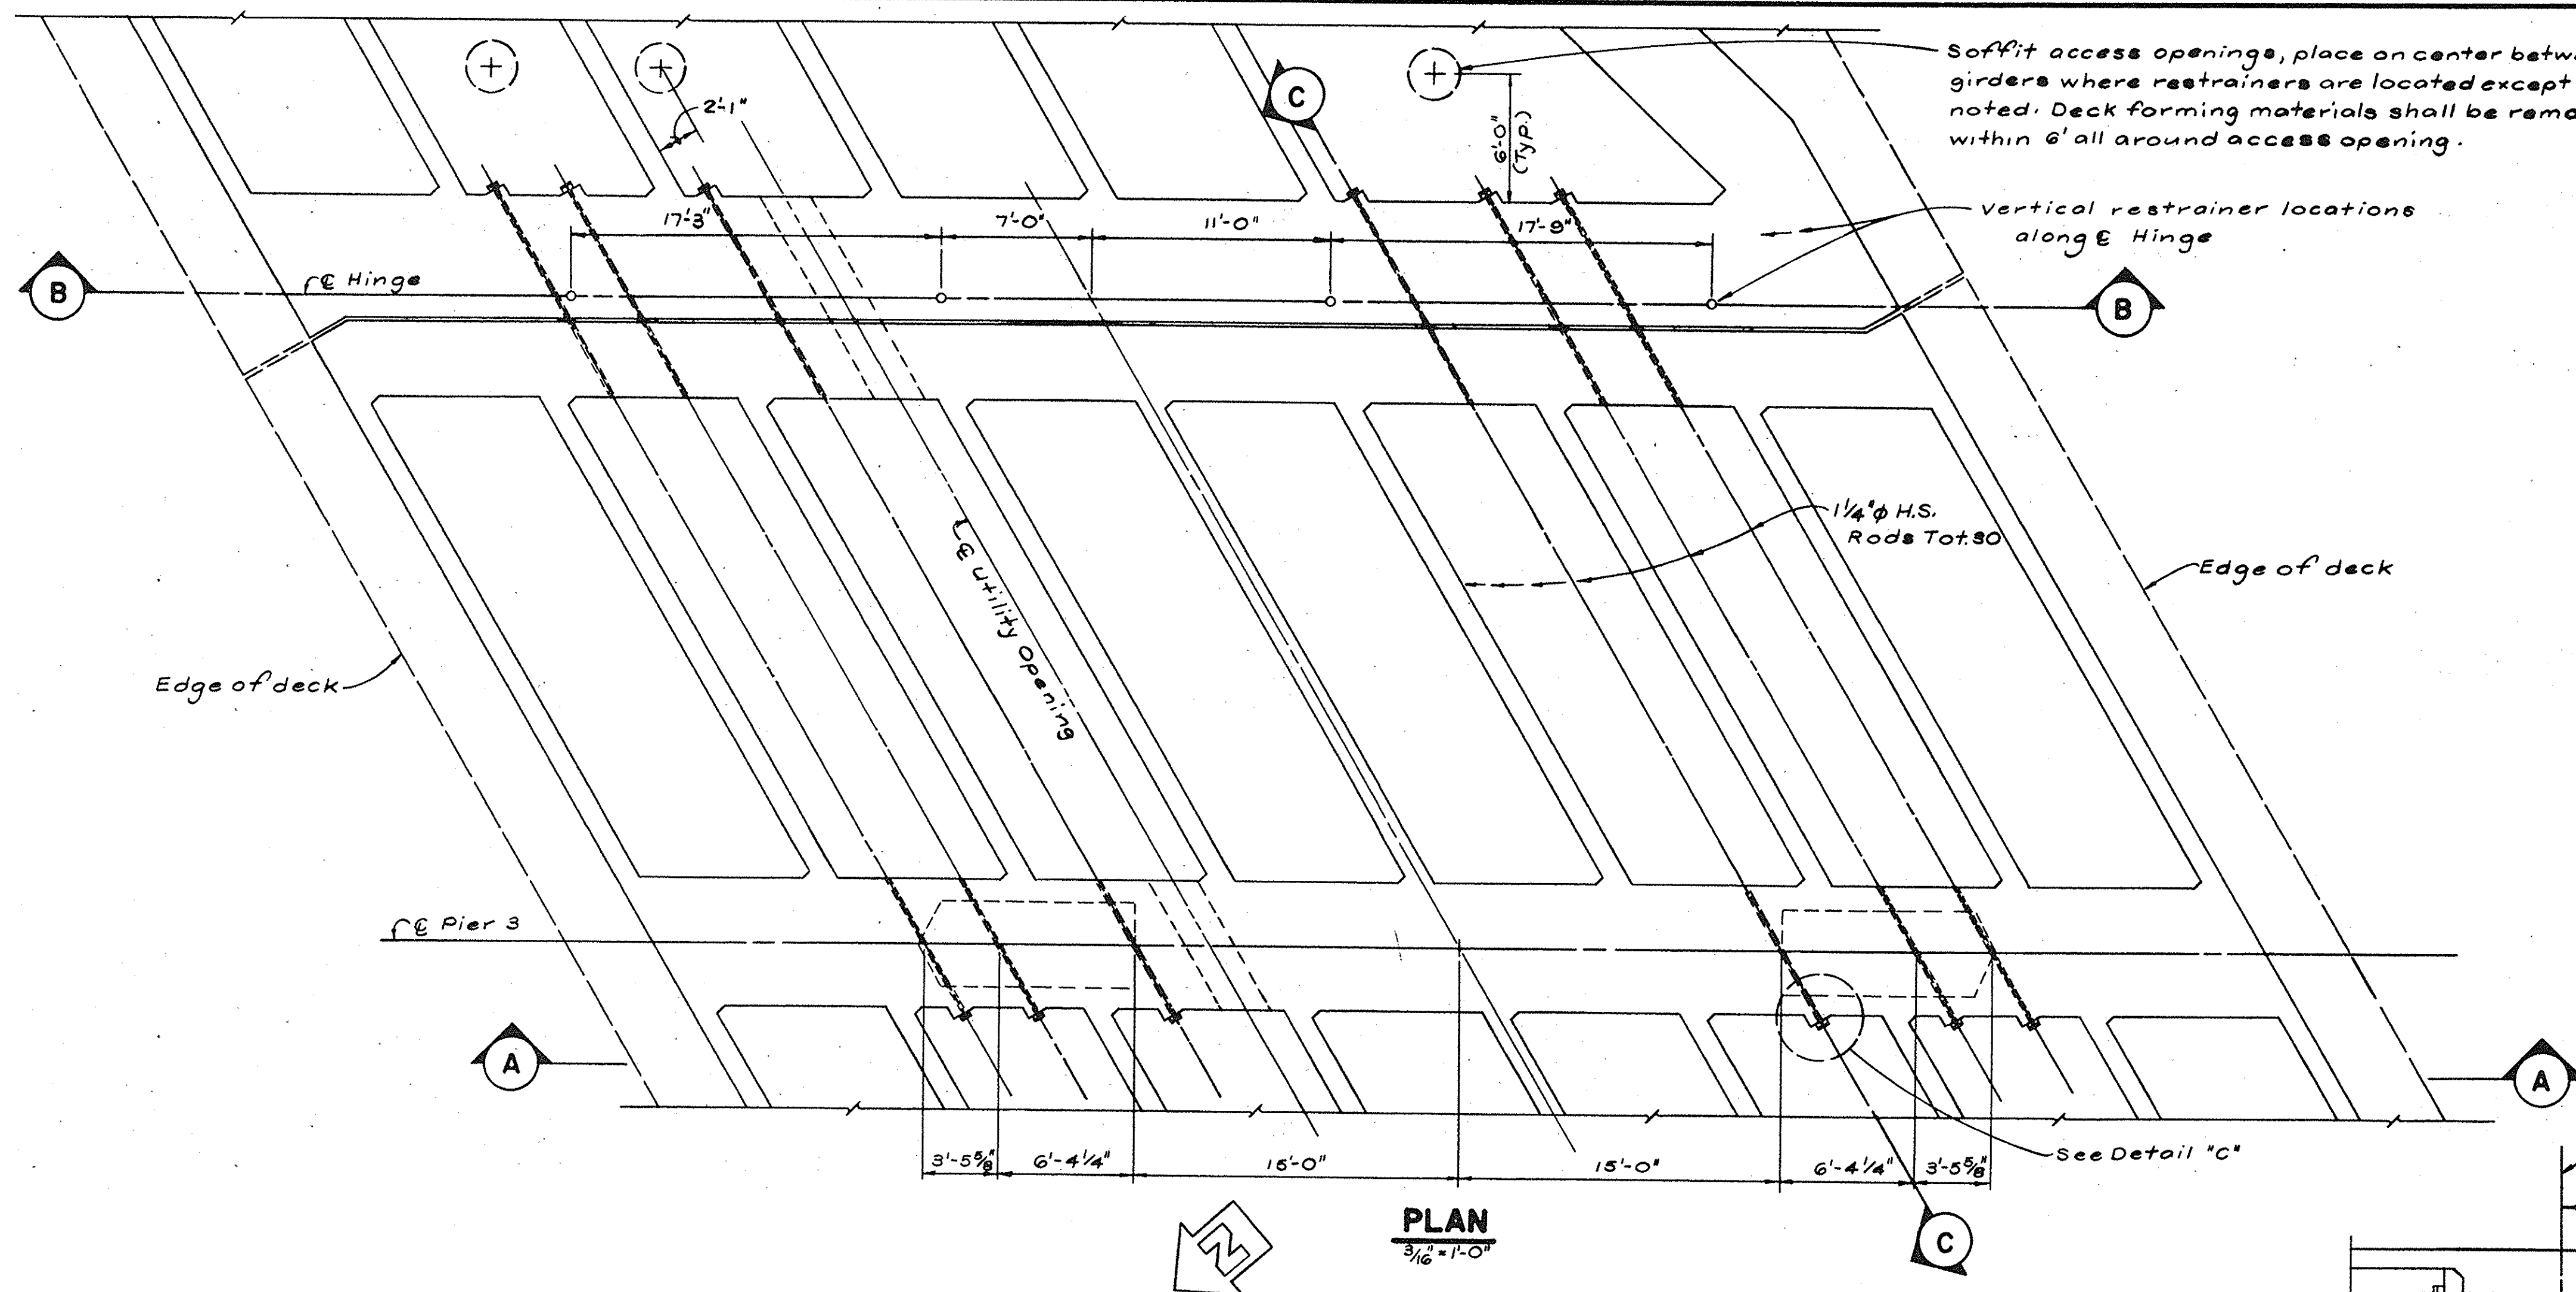

McDANIEL ENGINEERING COMPANY, INC. 3600 OLD TOWN AVE., SUITE 207B, SAN DIEGO, CA 92110 (619) 592-1820				DESIGNED BY WMA DRAWN BY OMC CHECKED BY CCC FIELD BOOK	SANTA MARGARITA PARKWAY BRIDGE OVER ARROYO TRABUCO - WIDENING RESTRAINER DETAILS	SHEET 36 OF 57 SHEETS
APPROVED BY 	R.C.E. C34299	EXPIRES 9-30-91	DATE 6-28-89	AS BUILT 3.93 SLH		

DR 195 US 399