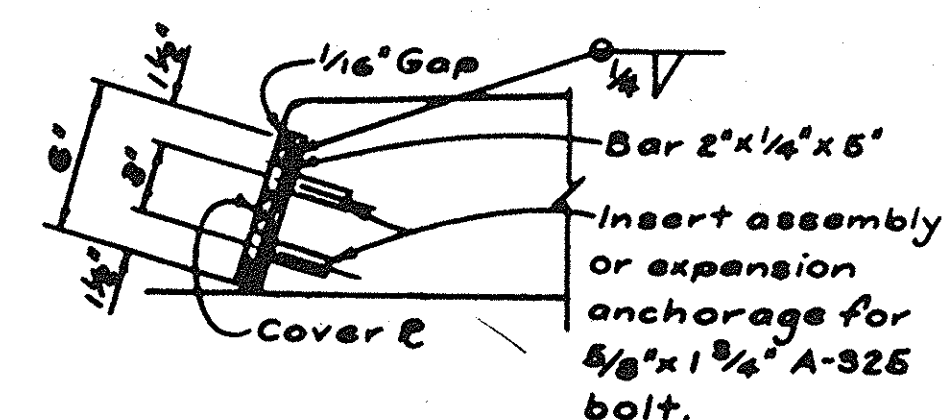
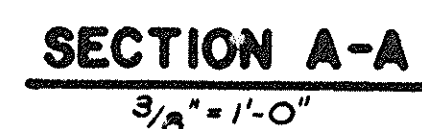


-

RAISED SIDEWALK - EXISTING BRIDGE