




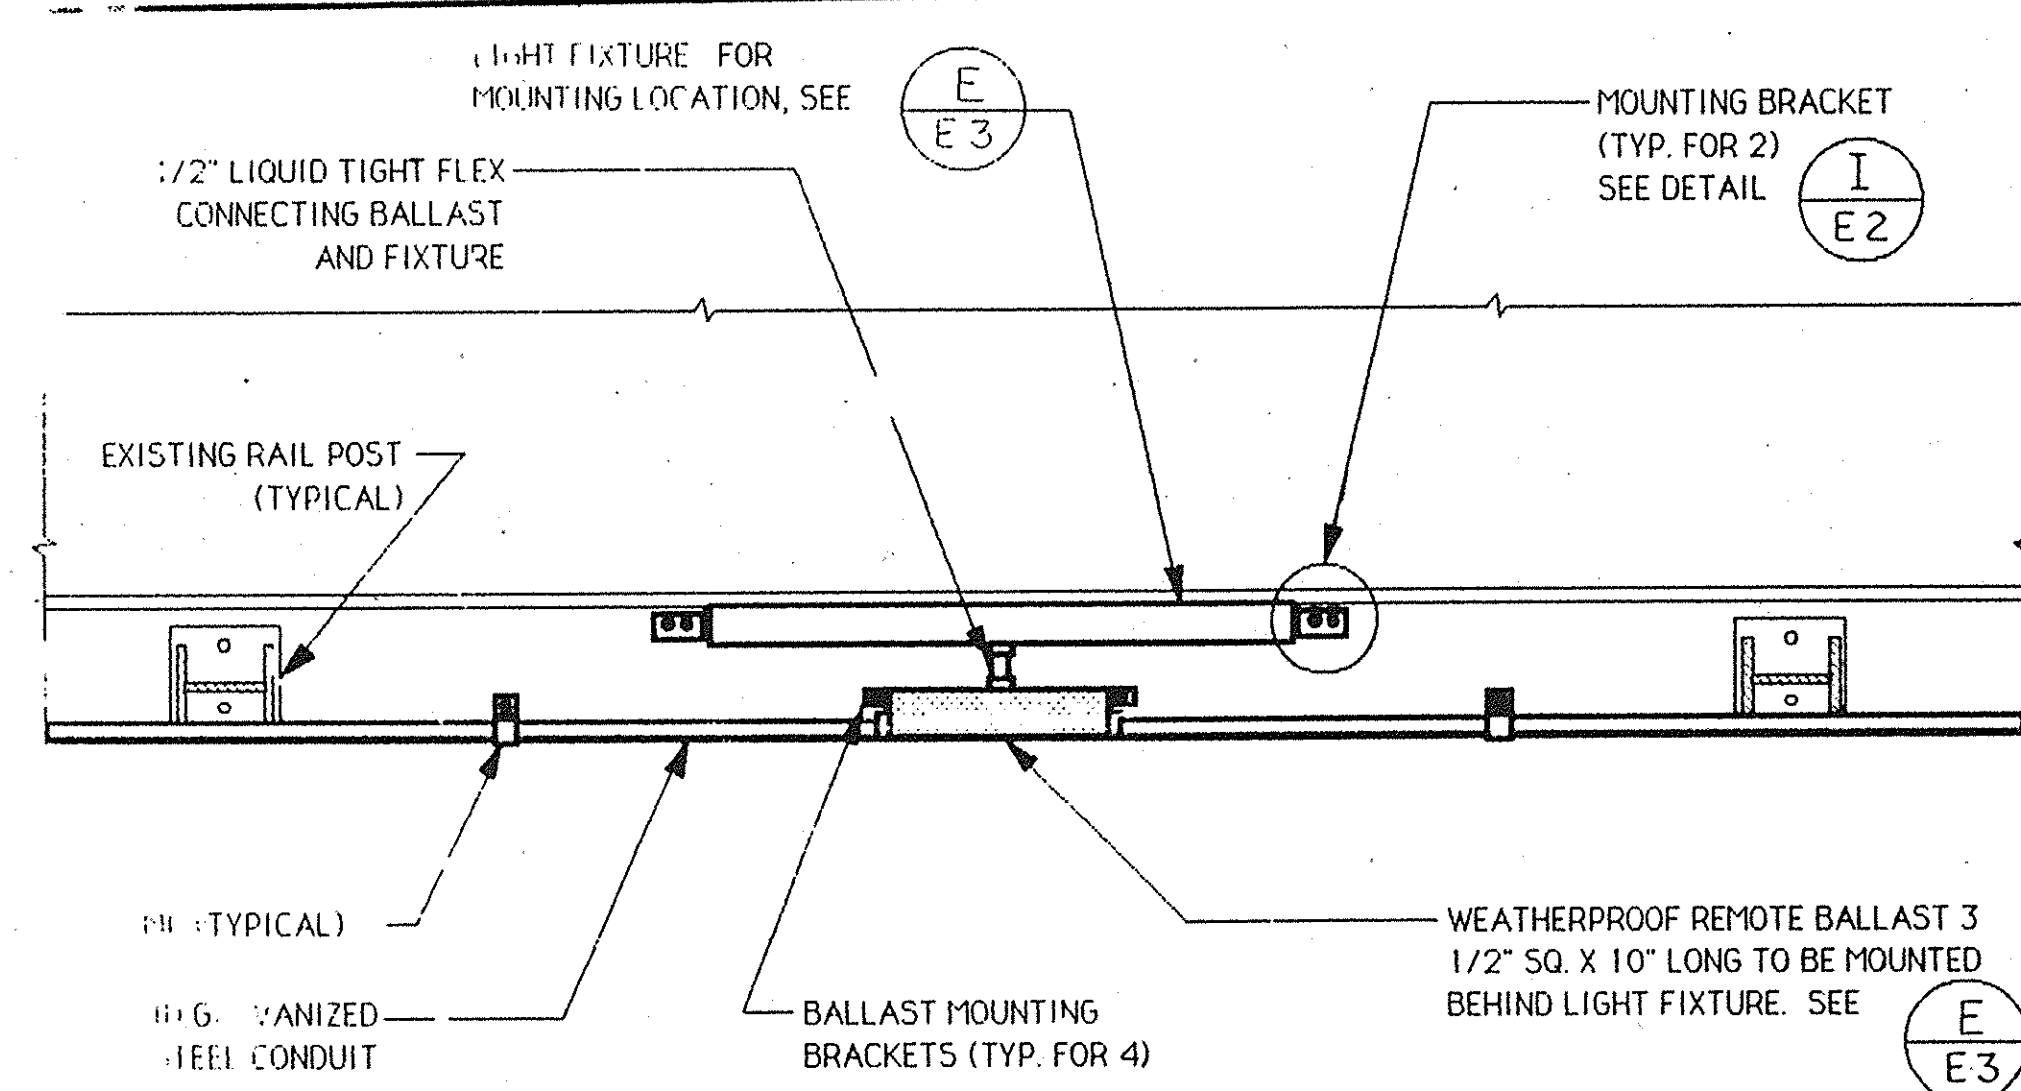


TOP VIEW
FIXTURE MOUNTING & BALLAST DETAIL
 3/4" = 1'-0" FOR EXISTING CONCRETE BARRIER

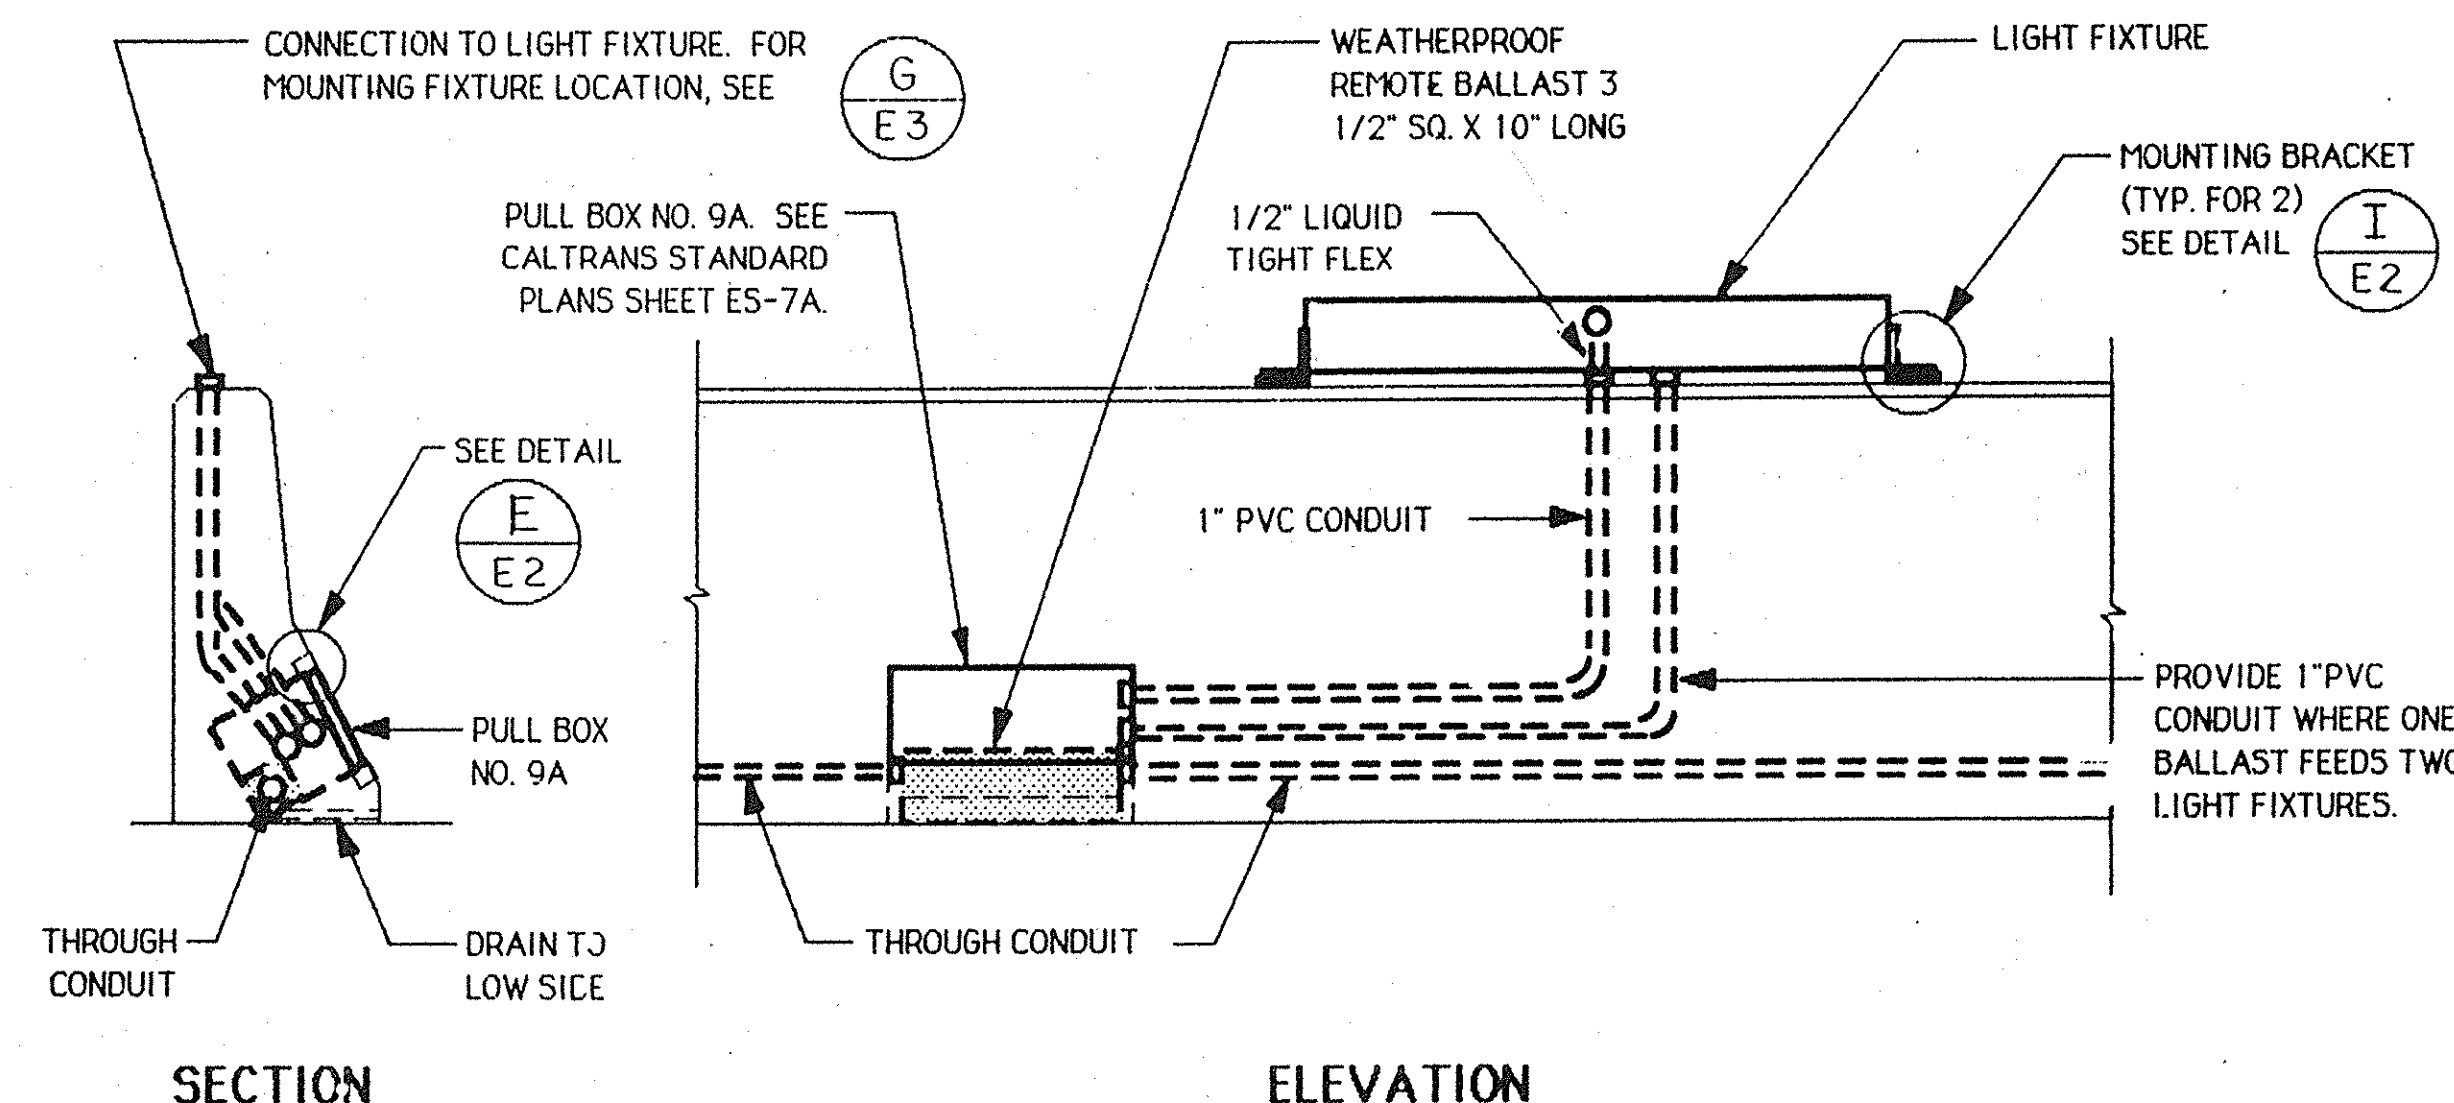


SECTION
ELEVATION
FIXTURE & PULL BOX NO. 6 MOUNTING DETAIL
 3/4" = 1'-0" FOR CONCRETE BARRIER TYPE 27

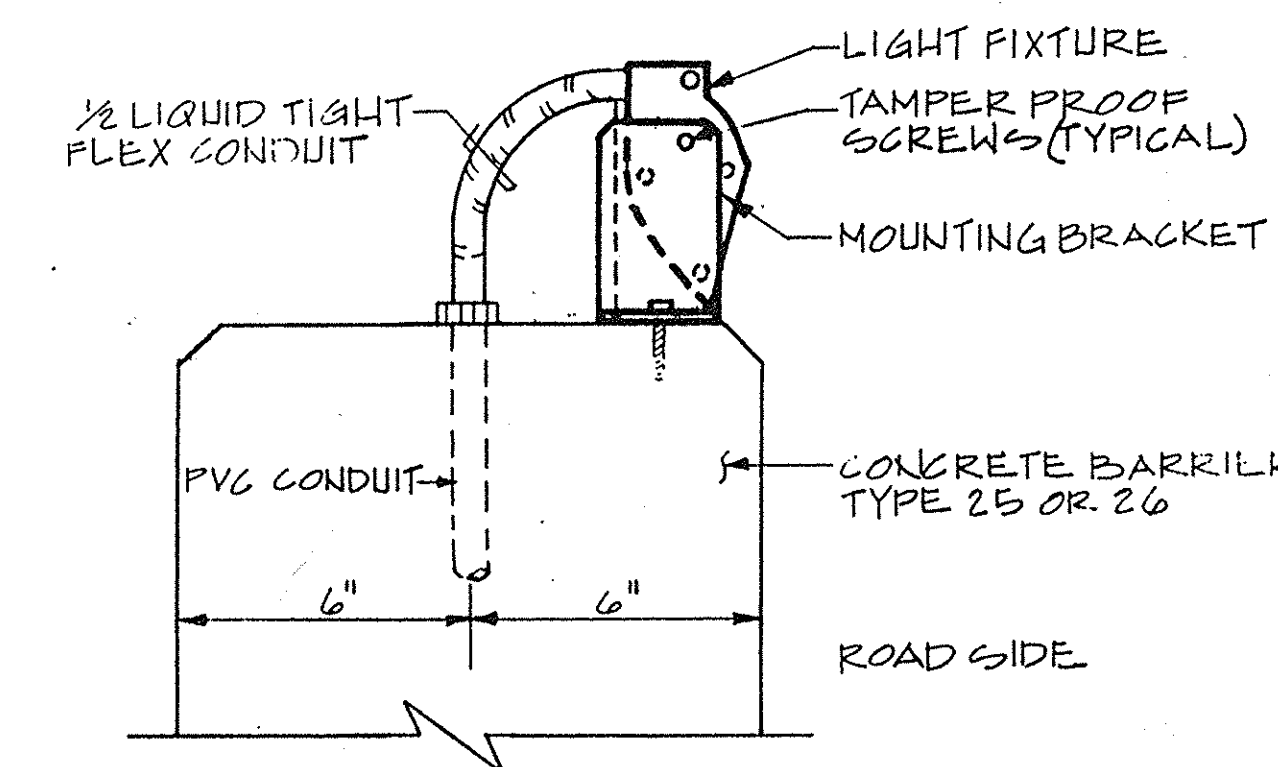


FIXTURE MOUNTING DETAIL
 1/4" = 1'-0"

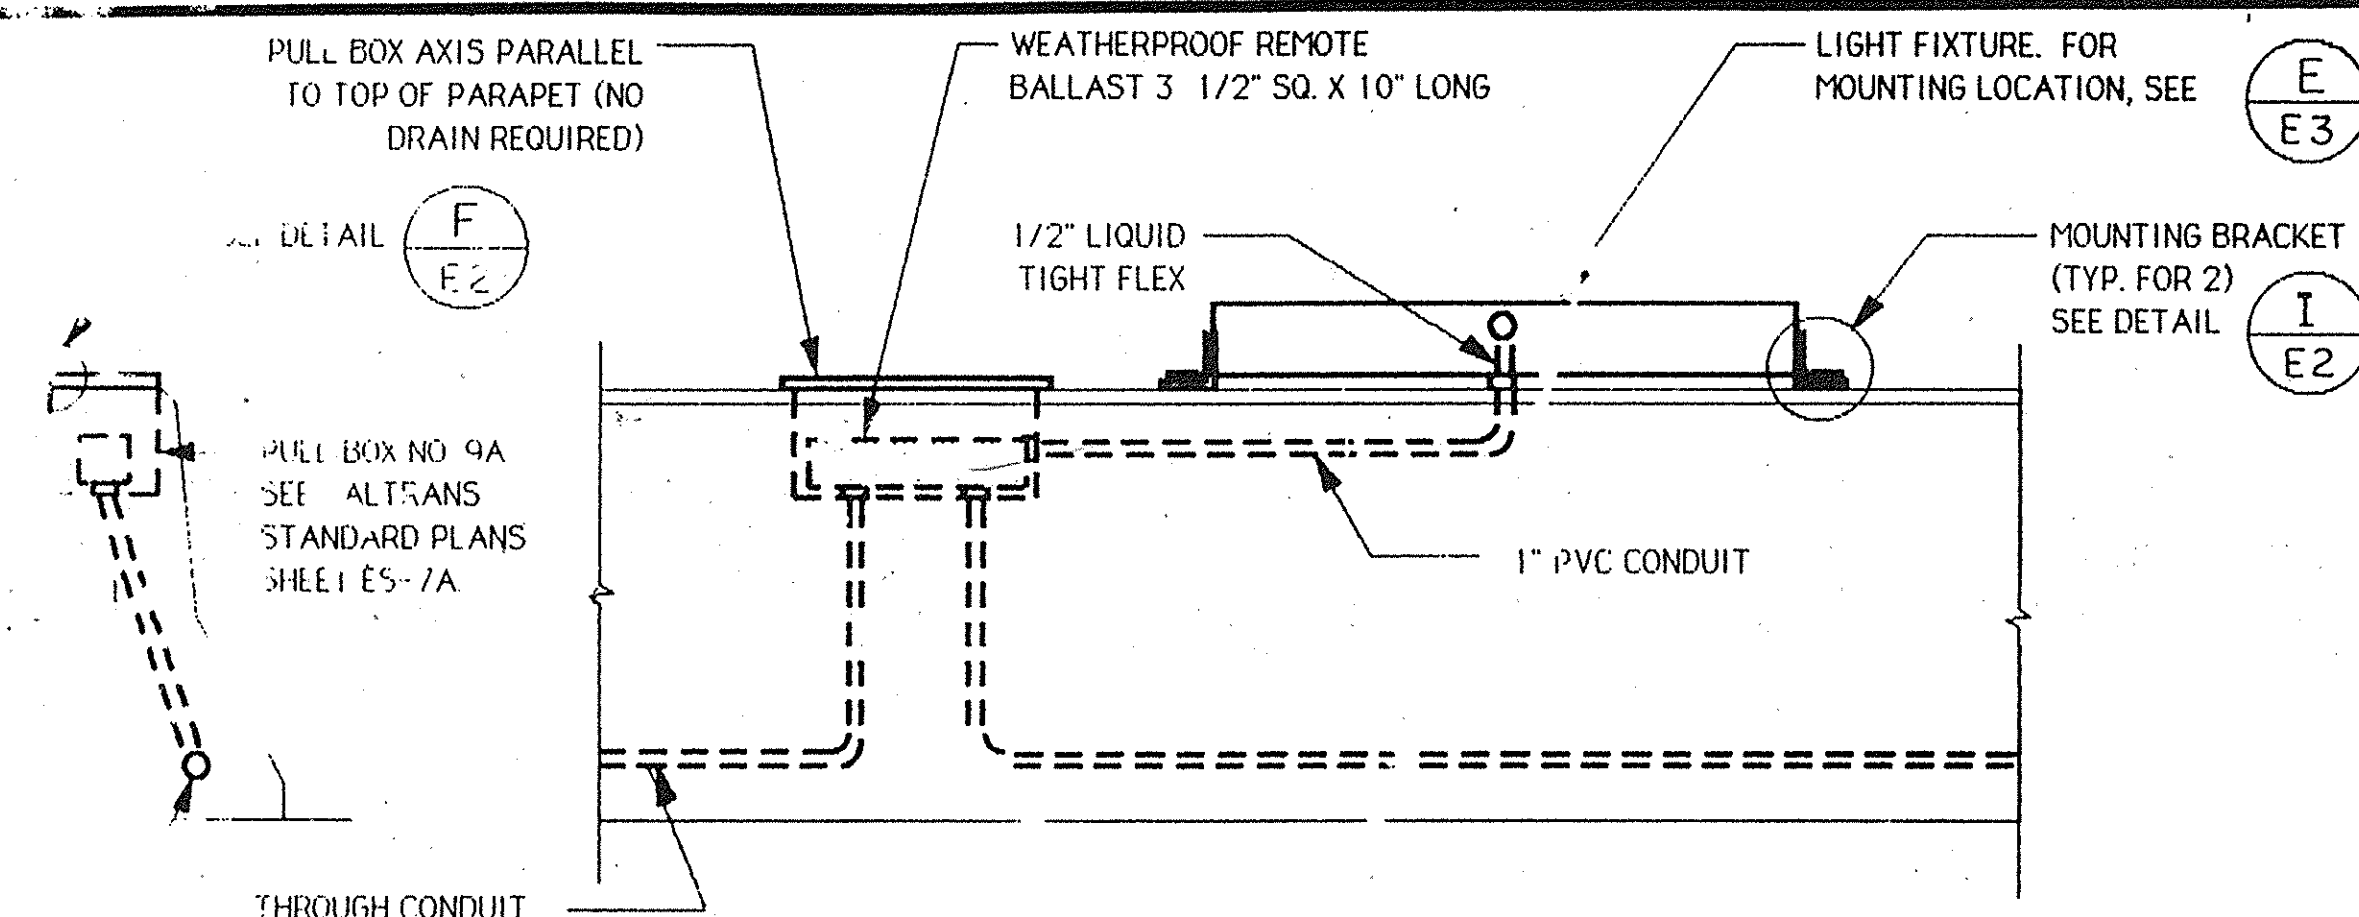


ELEVATION
FIXTURE & PULL BOX NO. 9A MOUNTING DETAIL
 3/4" = 1'-0" FOR CONCRETE BARRIER TYPE 25

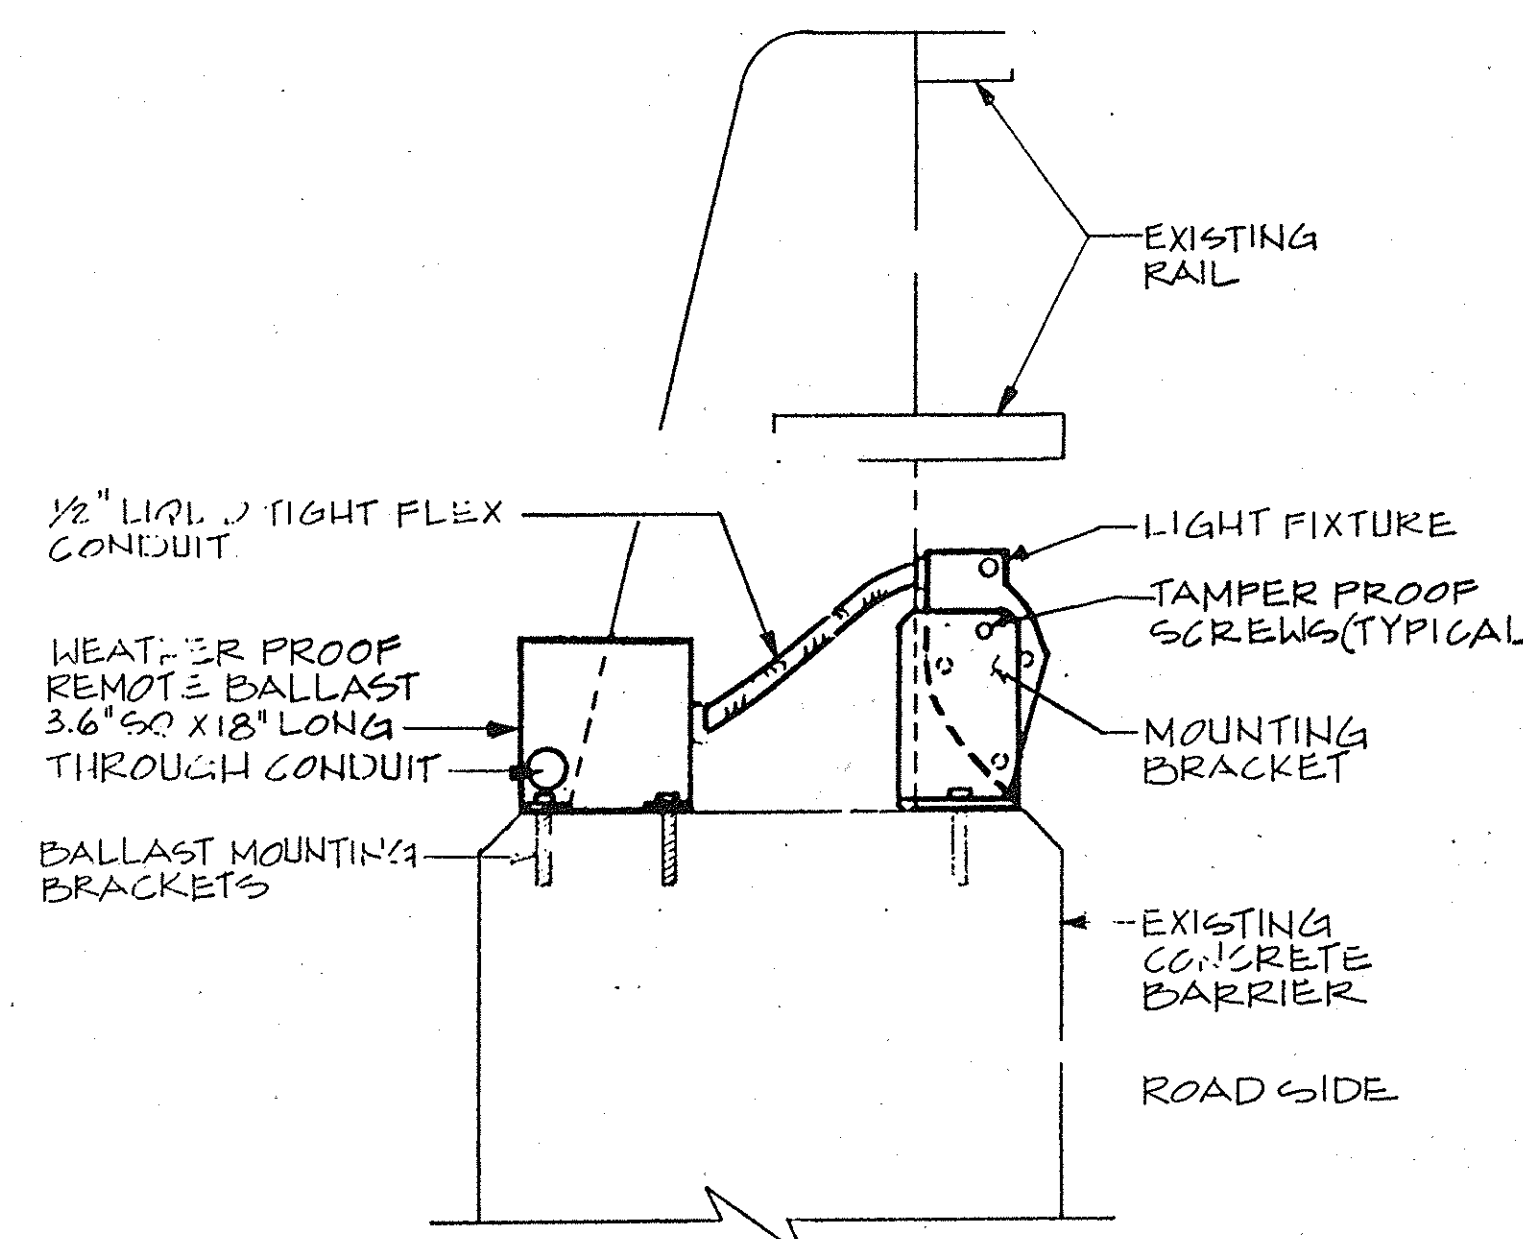

FIXTURE MOUNTING DETAIL
 1/4" = 1'-0"

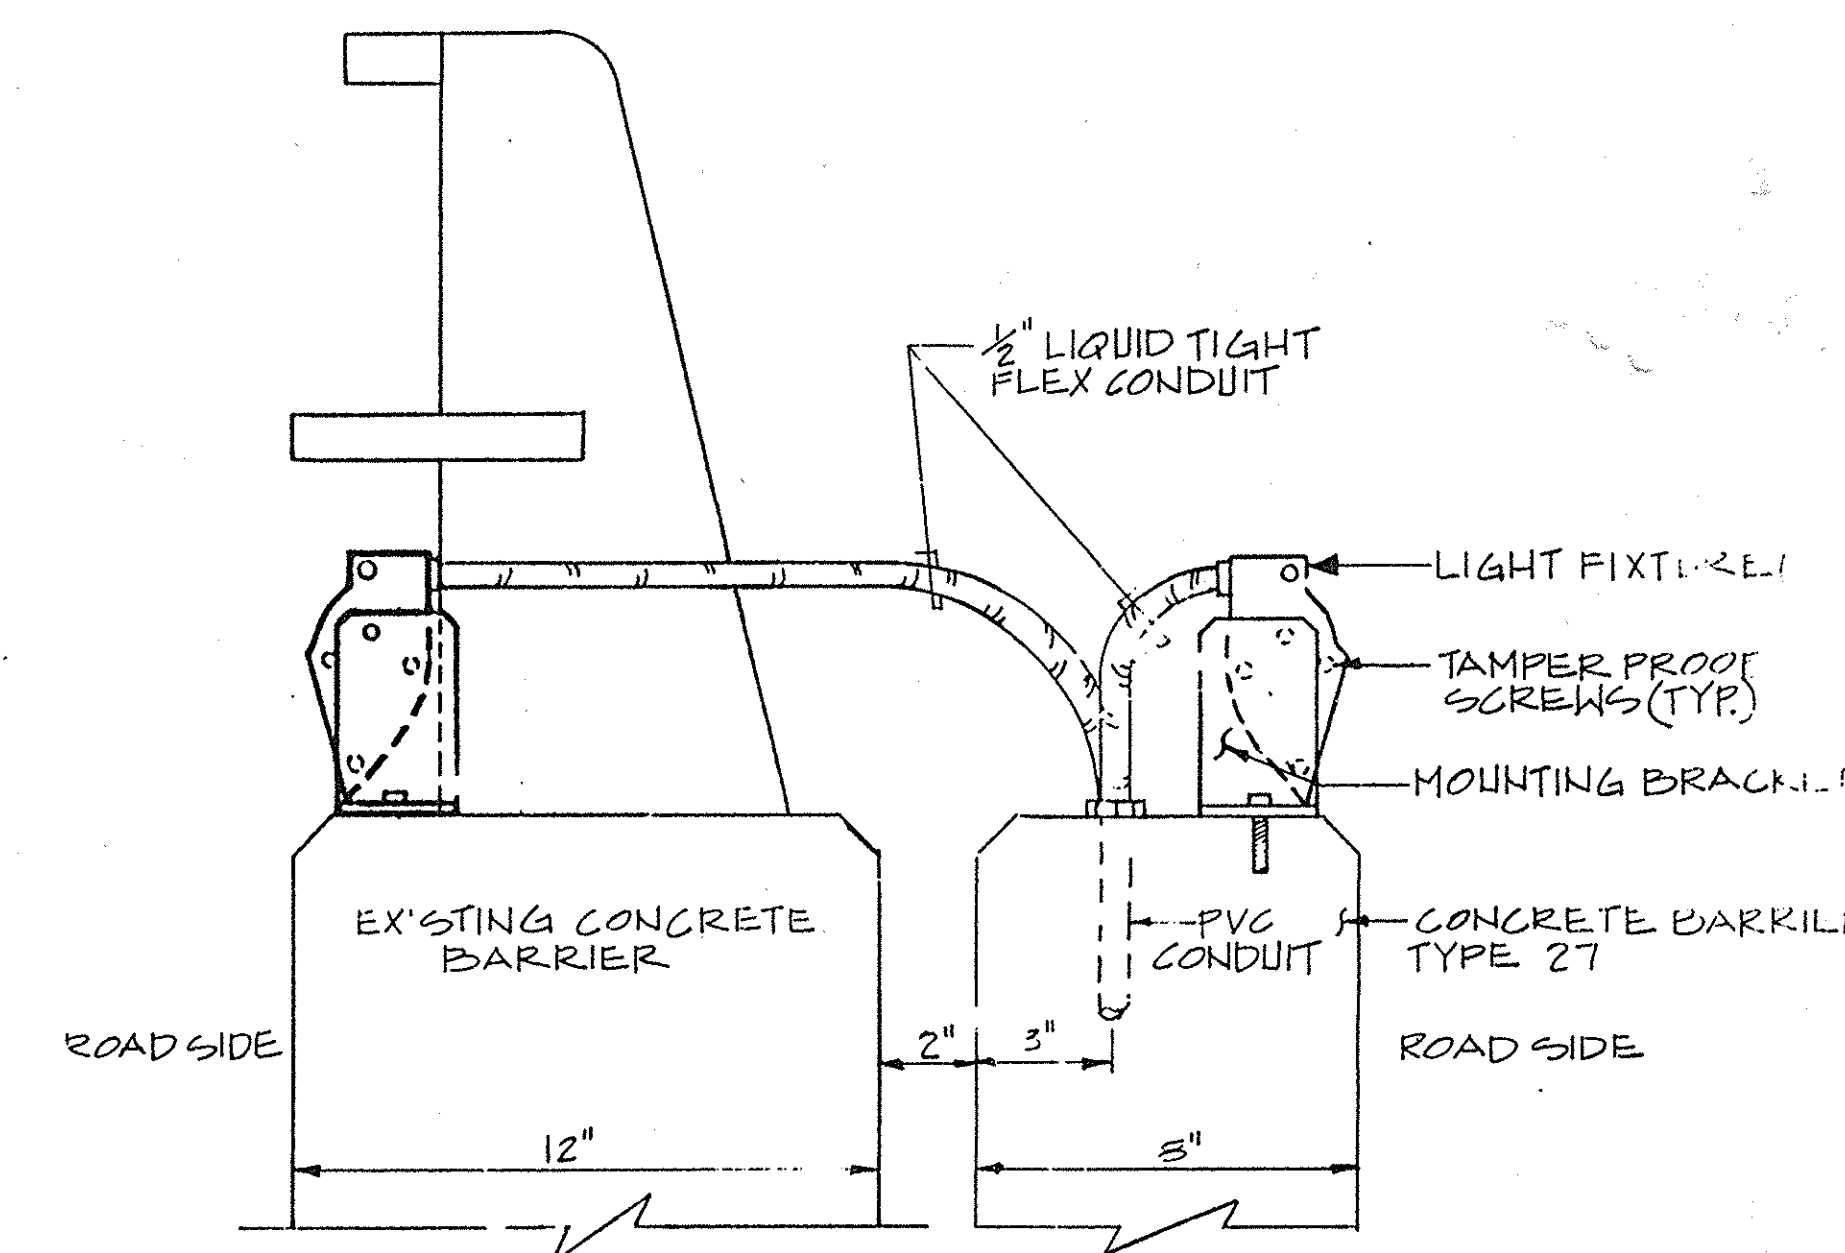

FIXTURE MOUNTING DETAIL
 1/4" = 1'-0"

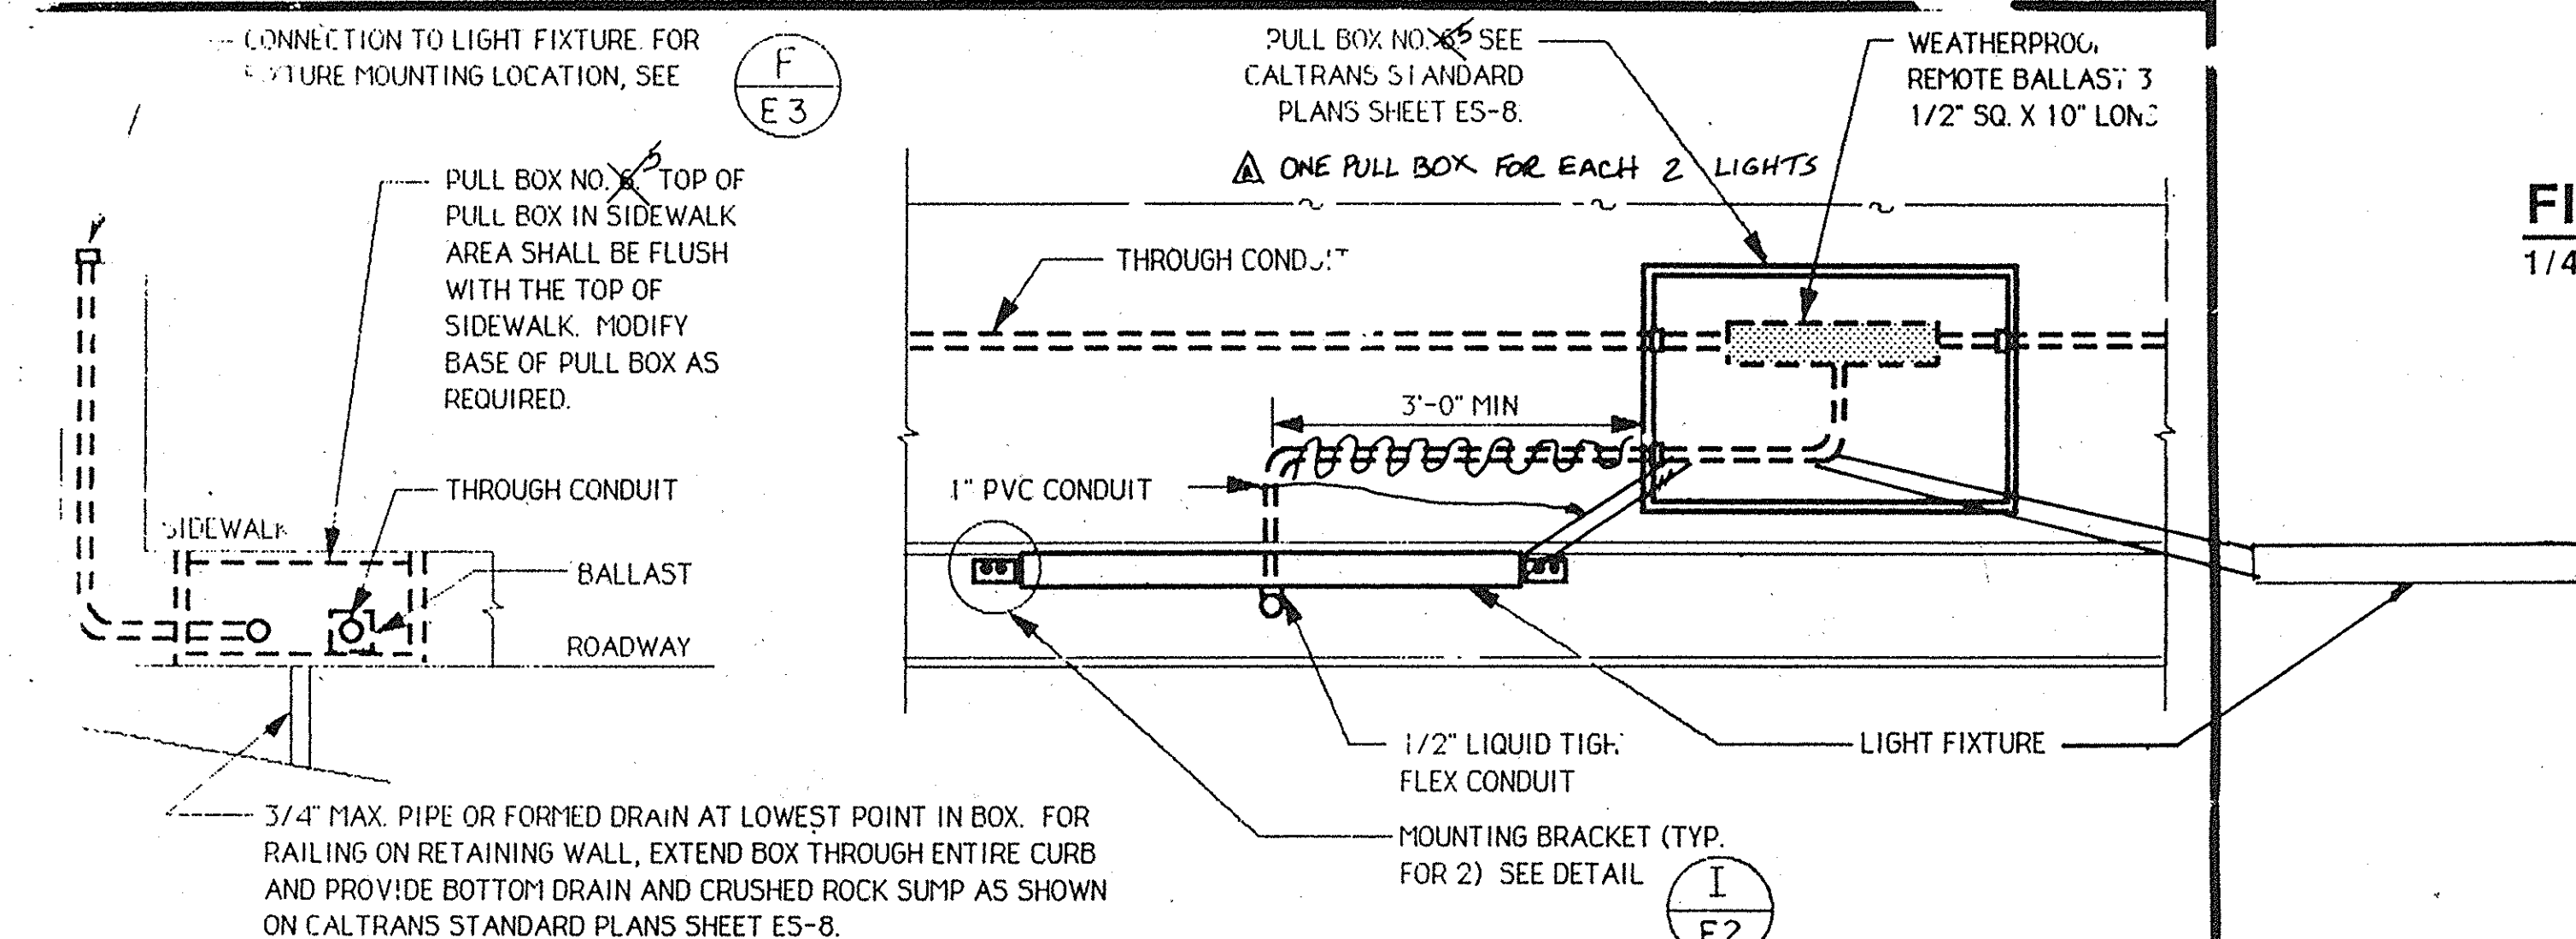

SECTION
TOP VIEW
FIXTURE & PULL BOX NO. 6 MOUNTING DETAIL
 3/4" = 1'-0" FOR CONCRETE BARRIER TYPE 26


SPARVAN INCORPORATED
 ELECTRICAL & CONTROL SYSTEM ENGINEERS
 4140 NORSE WAY
 LONG BEACH, CA 90804
 PHONE (213) 425-1233

DESIGNED BY
 DPL
 DRAWN BY
 DDE
 CHECKED BY
 FIELD NO.

**SANTA MARGARITA PARKWAY BRIDGE
 OVER ARROYO TRABUCO - MIDENING**

BRIDGE LIGHTING DETAILS

SHEET
 48
 OF
 57
 JOB NO.

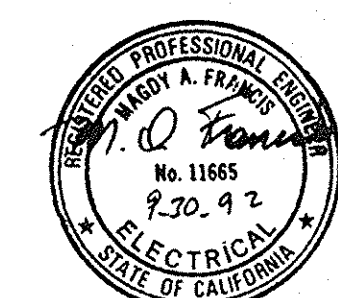

AS BUILT 3.93 544

JUNE 26, 1989

DR 19-15753