

ORANGE COUNTY

ENVIRONMENTAL MANAGEMENT AGENCY

SANTA ANA, CALIFORNIA

M. STORM, DIRECTOR

PLANS FOR CONSTRUCTION OF THAT PORTION OF ALICIA PARKWAY

FROM

3139 FEET S'LY MELINDA ROAD TO PLANO TRABUCO ROAD

AND

PORTOLA PARKWAY

FROM



EL TORO ROAD TO 1307 FEET SOUTH

AND FROM

MELINDA ROAD TO 3139 FEET SOUTH

AND

PORTIONS OF FLOOD CONTROL FACILITIES
L02P24, L02P25, & LIIP03

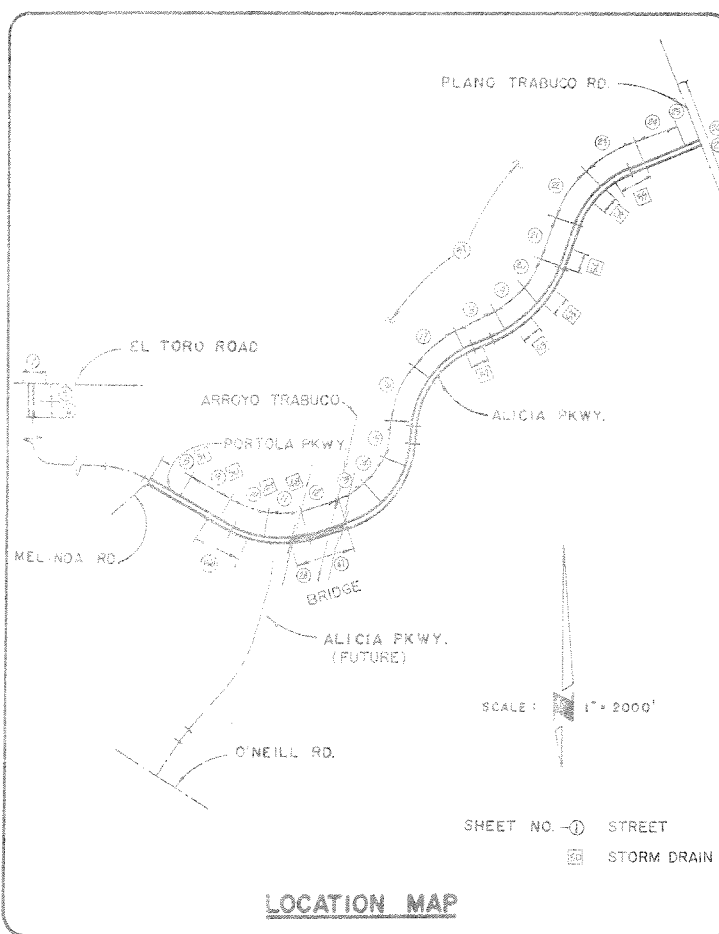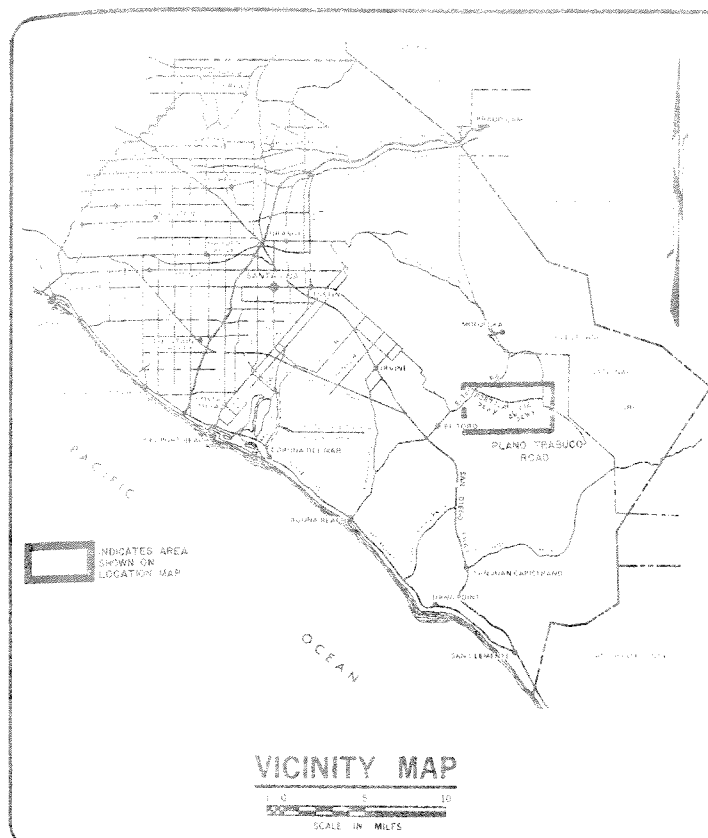

INDEX OF SHEETS

SHEET	DESCRIPTION
1.	TITLE SHEET
2.	TYPICAL SECTIONS AND DETAILS
3-4.	DETAILS
5-6.	PORTOLA PARKWAY-EL TORO ROAD TO 1307 FEET SOUTH
7.	PORTOLA PARKWAY AT EL TORO ROAD, INTERSECTION AND STRIPING DETAIL
8-11.	PORTOLA PARKWAY-MELINDA ROAD TO 3139 FEET SOUTH
11-26.	ALICIA PARKWAY-3139 FEET S'LY MELINDA ROAD TO PLANO TRABUCO ROAD.
27.	ALICIA PARKWAY AT PLANO TRABUCO ROAD INTERSECTION AND STRIPING DETAIL
28-46A.	ALICIA PARKWAY BRIDGE
47.	BRIDGE SOIL BORING LOG
48-51.	PORTOLA PARKWAY STORM DRAIN
52-55.	ALICIA PARKWAY STORM DRAIN
56.	PORTOLA PARKWAY GRADING PLAN
57.	PLANO TRABUCO STOCKPILE SITE
57A.	TEMPORARY ACCESS ROAD

UTILITY PHONE NO.

TIMES MIRROR CABLE TELEVISION (TONY JONES)	498-3490
MISSION VIEJO COMPANY CORPORATE OFFICES	837-6050
PACIFIC TELEPHONE (BILL BADSGARD)	999-5715
SOUTHERN CALIFORNIA EDISON COMPANY (JIM NEUZIL)	973-5491 Ex 54642
SOUTHERN CALIFORNIA GAS COMPANY (DOMINICK SORINO)	495-4430
SANTA MARGARITA WATER DISTRICT (BILL DYE)	586-1973
LAGUNA HILLS WATER COMPANY (BOB HILL)	837-7050

BENCH MARK: EL 802.669 1976
ADJ.
0.8 MI. E. OF MARGUERITE 300' N.
OF O'NEILL RD BY A STEEL TRANS-
MISSION TOWER MARKED 20/4 ON
THE S.W. LEG CONC. POST EXPOSED 1'
ABOVE GROUND, 1' S. OF STEEL
PADDLE BOARD. DES. 3HH-14-77

BASIS OF BEARING

BEARINGS SHOWN HEREON ARE
BASED ON A BEARING OF
S 61°21'35"E BETWEEN TRIANGU-
LATION STATIONS "OSO" AND
"PLANO". (D.C.S. 1-1-75)

FUNDED BY: ROAD FEE PROGRAM FUNDS AND ROAD FUNDS

SEE SHEET 2 FOR INFORMATION ABOUT
AGREEMENTS AFFECTING CONTRACT
ADMINISTRATION

EMA-DEVELOPMENT

SUBMITTED: *William J. Kelly* 7/1/82
SECTION CHIEF RCE 16799
RECOMMENDED: *John A. Kelly*
DIVISION MANAGER RCE 13154
APPROVED: *John A. Kelly* 7/1/82
ASSISTANT DIRECTOR RCE 13142



JHH Consultants

540 N. Golden Circle Dr., Suite 111, Santa Ana, Ca. 92705 (714) 833-3611

Prepared Under the Supervision of:

Lawrence R. Weston Date: 7/1/82
Lawrence R. Weston RCE No. 19395

W. O. NO. R08565
DWG. NO.

SHEET 1 OF 57