



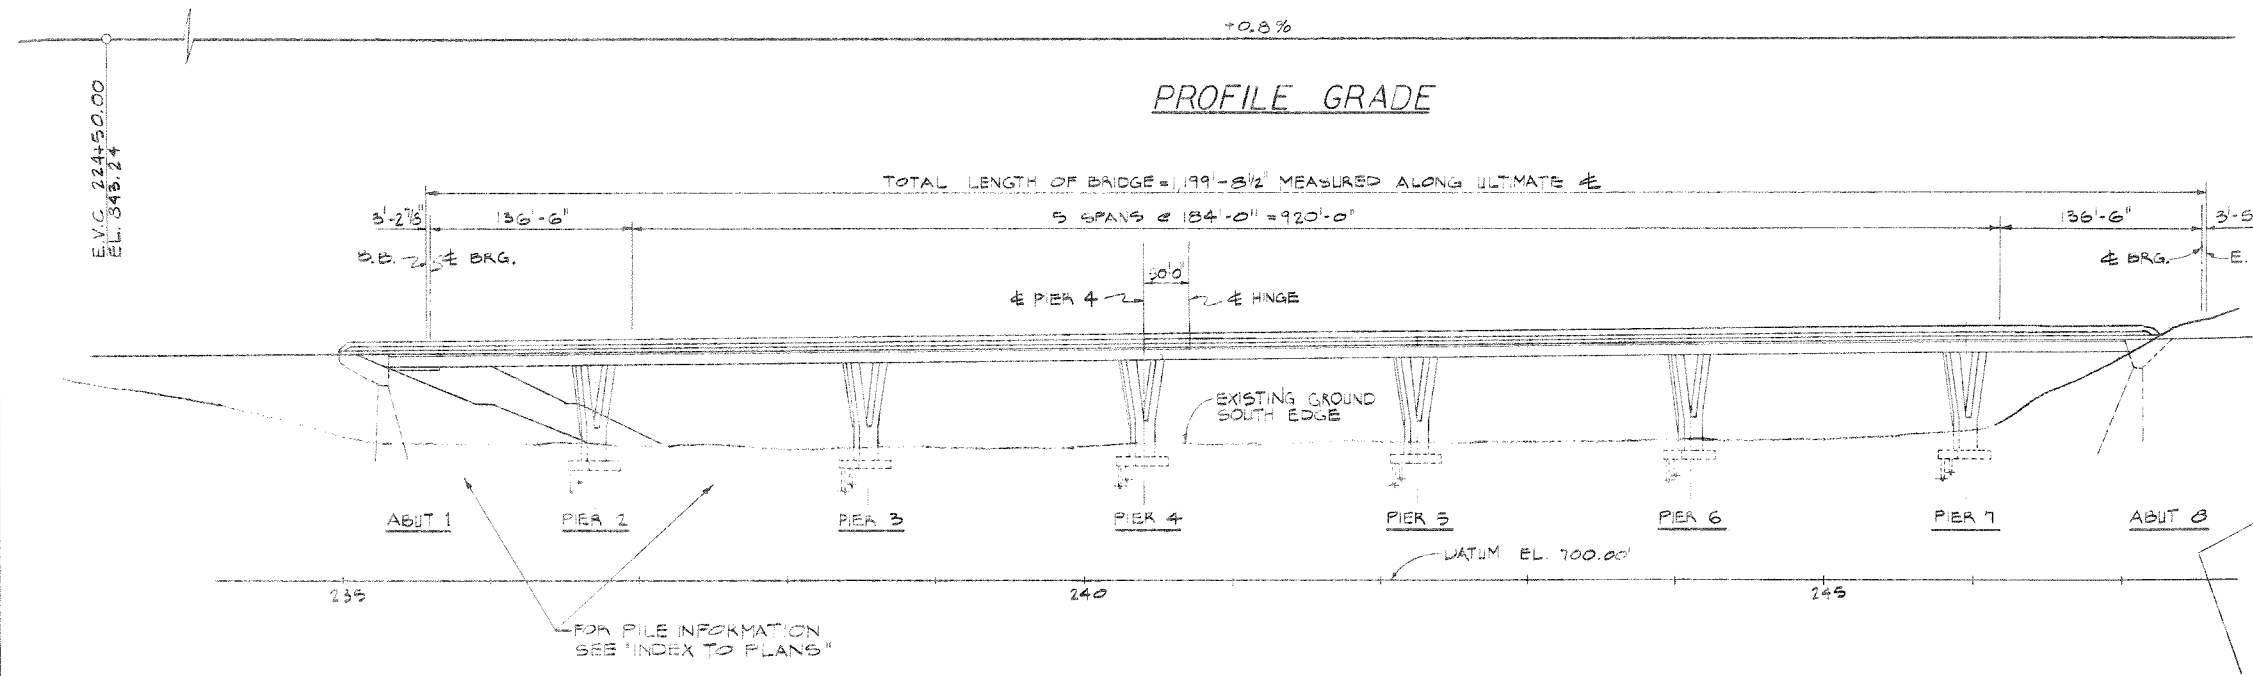


ELEVATION
1" = 60'

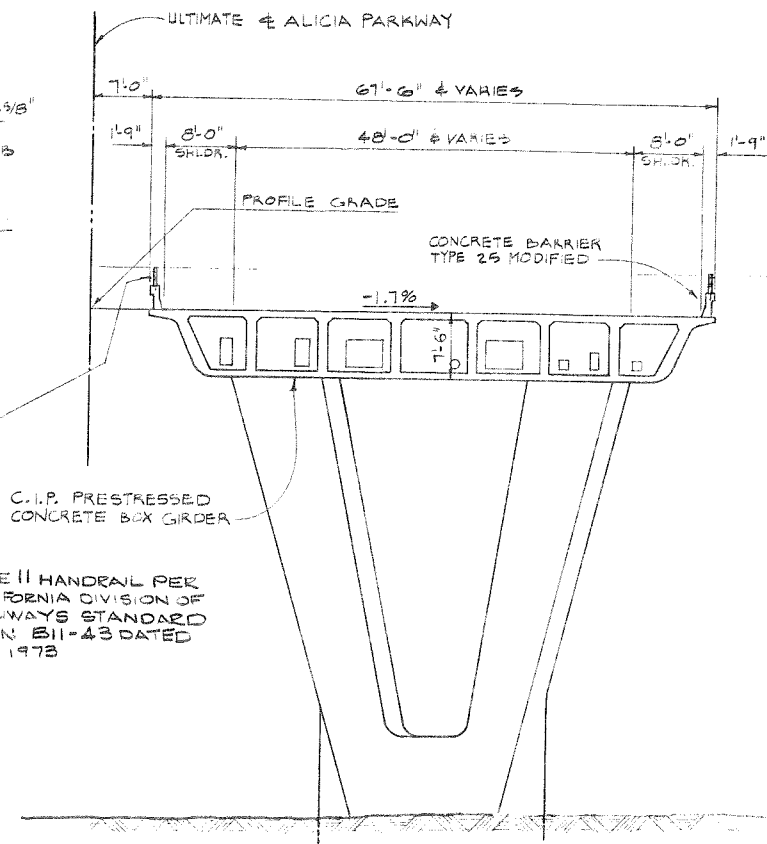

TYPICAL SECTION
3/32" = 1'-0"

ULTIMATE $\pm$ PARKWAY
R = 2,100.00'
 $\Delta = 46^\circ 21' 12''$
L = 1702.60'
T = 901.22'

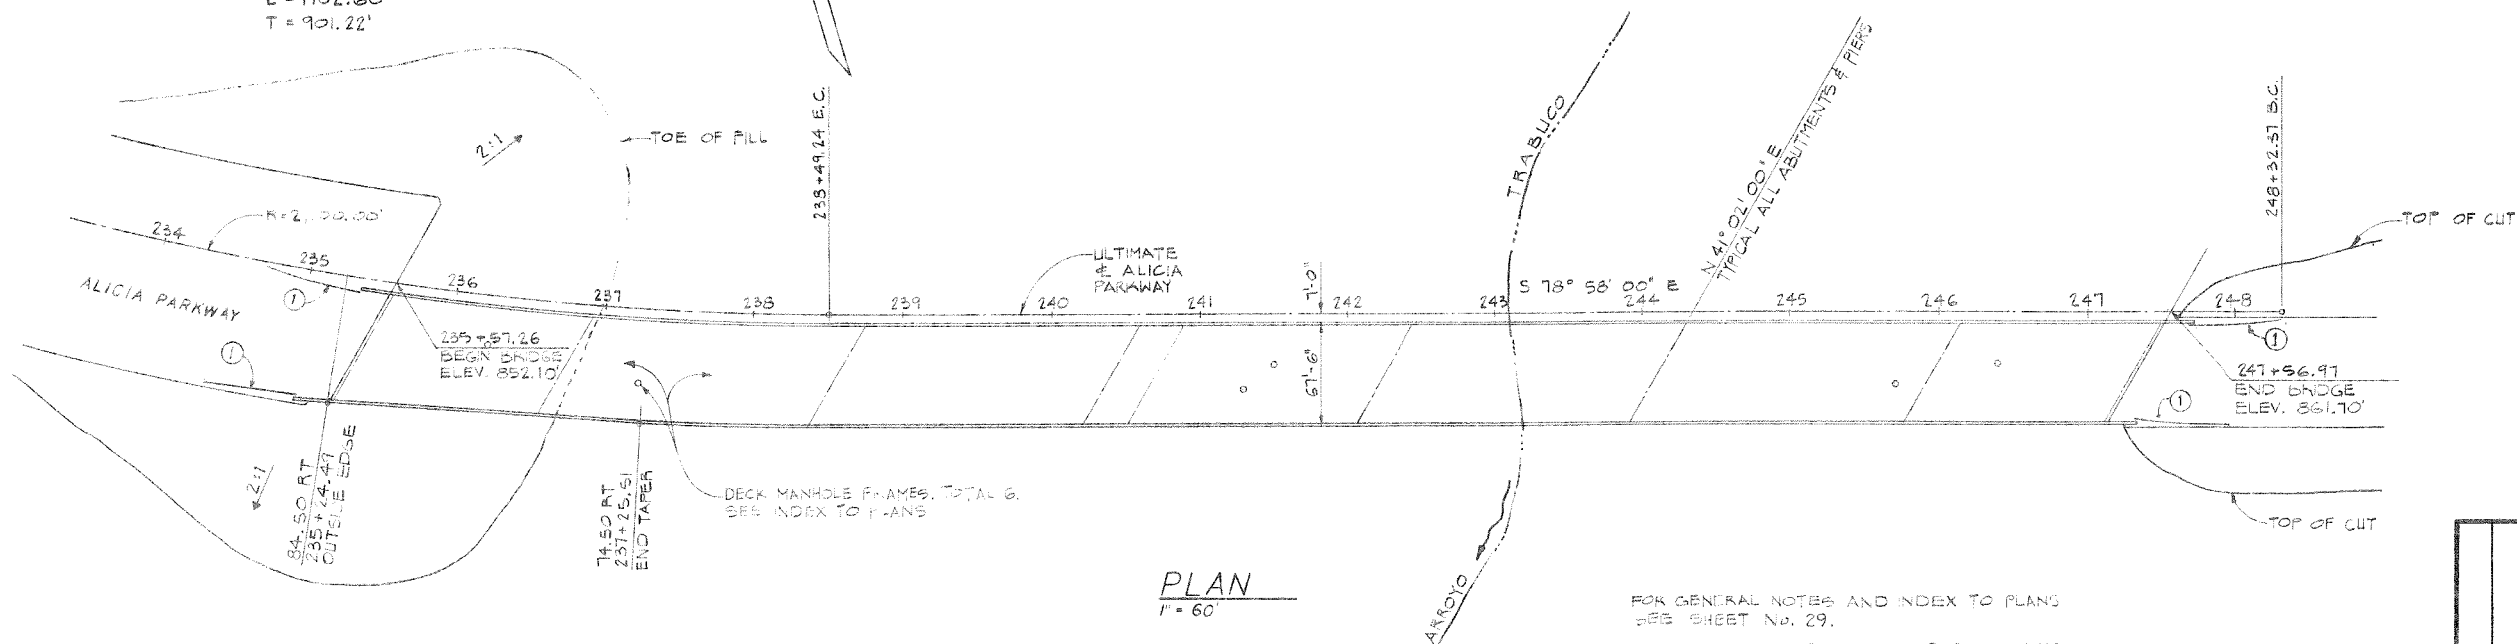

PLAN
1" = 60'

① BRIDGE APPROACH GUARD RAIL
WOOD POSTS, TYPE 1 FLARE, LENGTH = 62'-6"
REFER TO STD. PLAN A-119, A-11-CW & A-11-E

FOR GENERAL NOTES AND INDEX TO PLANS
SEE SHEET No. 29.

LIVE LOADING HS20-44 OR F-13 WHICHEVER
GOVERNS.

WHEELER & GRAY
CONSULTING ENGINEERS
2512 Chambers Road, Suite 205
Tustin, California 92680

George W. Gray
S.E. #767

ORANGE COUNTY
ENVIRONMENTAL MANAGEMENT AGENCY

ALICIA PARKWAY BRIDGE (AR-2)
OVER
ARROYO TRABUCO CREEK (LO-2)

GENERAL PLAN

MARK	DATE	DESCRIPTION	PREPARED UNDER SUPERVISION OF	DATE	SHEET
DESIGNED	W.F. POND				28
DRAWN	E.G.	CHECKED	AS SHOWN	DWG. NO.	57