
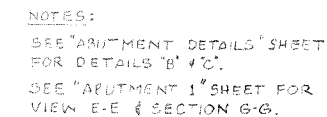
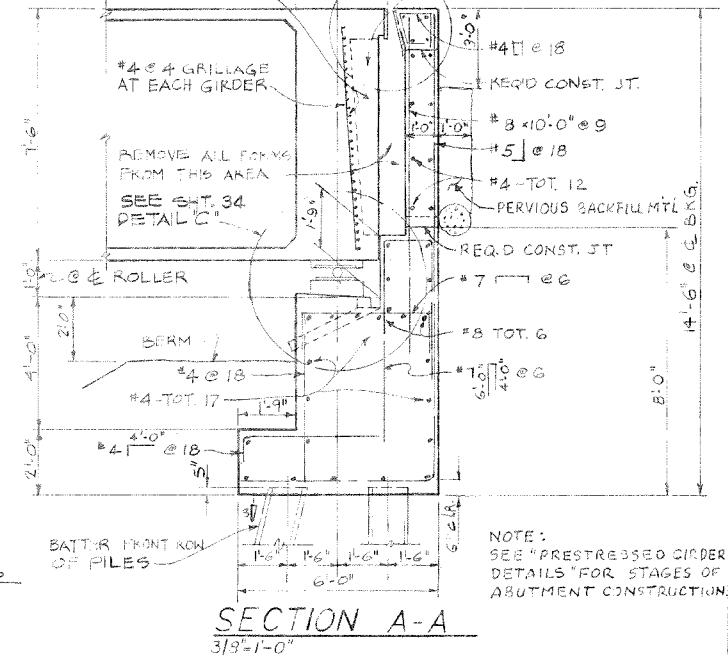


The image contains three structural drawings of a bridge deck:

- SECTION C-C**: A vertical cross-section of the bridge deck. It shows a total width of 318" (1'-0"). The deck is 1'-6" wide at the base and 1'-9" wide at the top. Reinforcement includes #9 bars, #4 U-bars, and #10 bars. A note states: "NOTE: SEE CONCRETE BARRIER TYPE 25 MODIFIED FOR ADDITIONAL REINFORCEMENT IN WINGWALL." The section is labeled "SECTION C-C" with a width of 318"=1'-0".
- SECTION D-D**: A vertical cross-section showing the bridge deck and wingwall. The deck is 24'-0" wide. The wingwall is 1'-6" wide. Reinforcement includes #9 bars, #10 bars, and #4 bars. The section is labeled "SECTION D-D" with a width of 318"=1'-0".
- Plan View**: A top-down view of the bridge deck. The deck is 24'-0" wide. The wingwall is 6'-6" wide. Reinforcement includes #4 U-bars, #10 bars, #4 bars, and #9 bars. The section is labeled "SECTION D-D" with a width of 318"=1'-0".

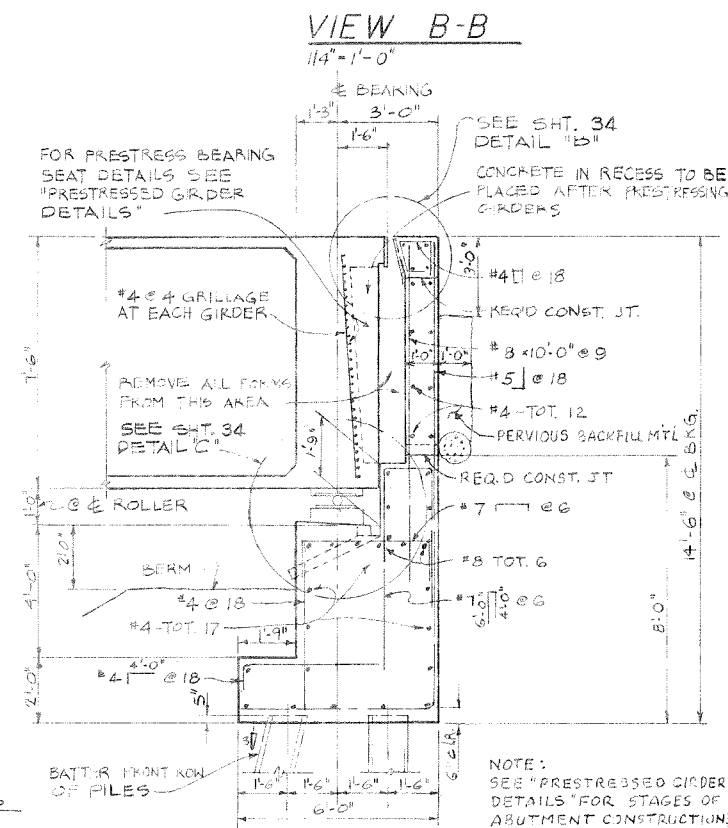

WHEELER & GRAY
CONSULTING ENGINEERS
2512 Chambers Road, Suite 205
Tustin, California 92680

George W. Gray

S.E.# 764

		ORANGE COUNTY ENVIRONMENTAL MANAGEMENT AGENCY	
		ALICIA PARKWAY BRIDGE (AR-2) OVER ARROYO TRABUCO CREEK (LO-2)	
		ABUTMENT 8	
MARK	DATE	DESCRIPTION	PREPARED UNDER SUPERVISION OF
REVISIONS			DATE
DESIGNED	W. F. POND		SCALE
DRAWN	E. G.	CHECKED	AS SHOWN
		DATE	DWG. NO.
		SHEET 33 OF 57	