

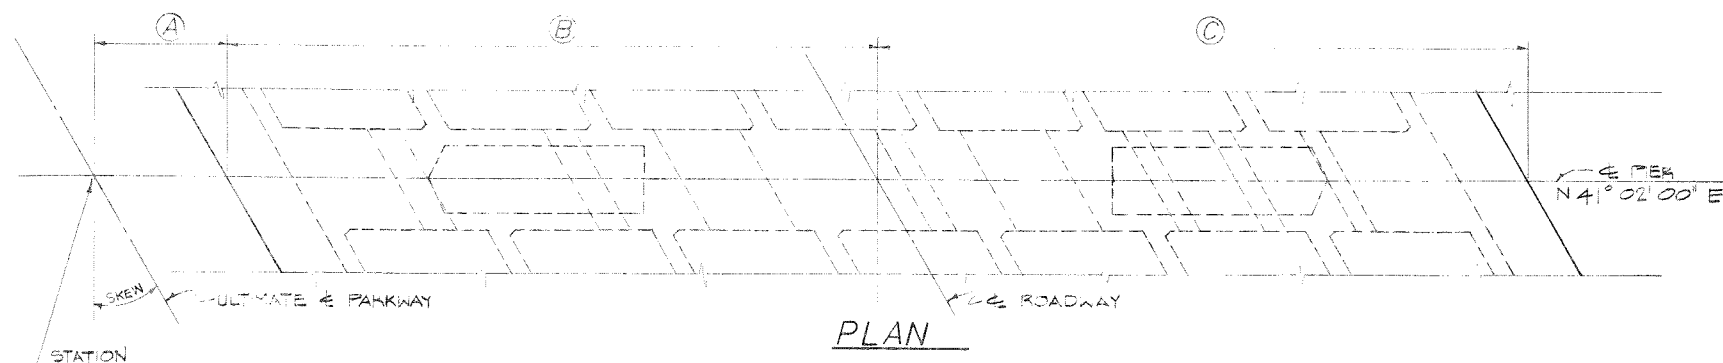
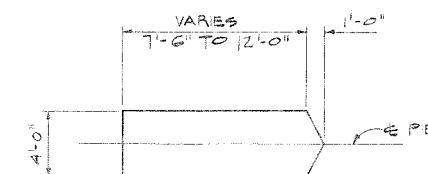


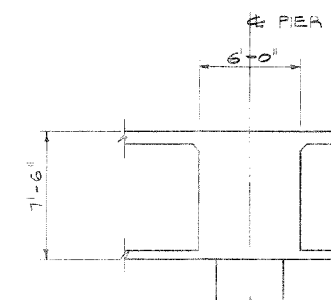


PIER DATA						
PIER No	STATION	A	B	C	ELEV. D	SKW
2	236 + 97	7'-8 1/8"	37'-6 1/8"	35'-4 1/2"	852.37	25°-50'-47"
3	238 + 51	8'-1"	38'-11 5/8"	38'-11 1/4"	853.81	30°
4	240 + 65	8'-1"	38'-11 5/8"	38'-11 5/8"	855.23	30°
5	242 + 49	8'-1"	38'-11 5/8"	38'-11 5/8"	856.75	30°
6	244 + 33	8'-1"	38'-11 5/8"	38'-11 5/8"	858.23	30°
7	246 + 17	8'-1"	38'-11 5/8"	38'-11 5/8"	859.70	30°

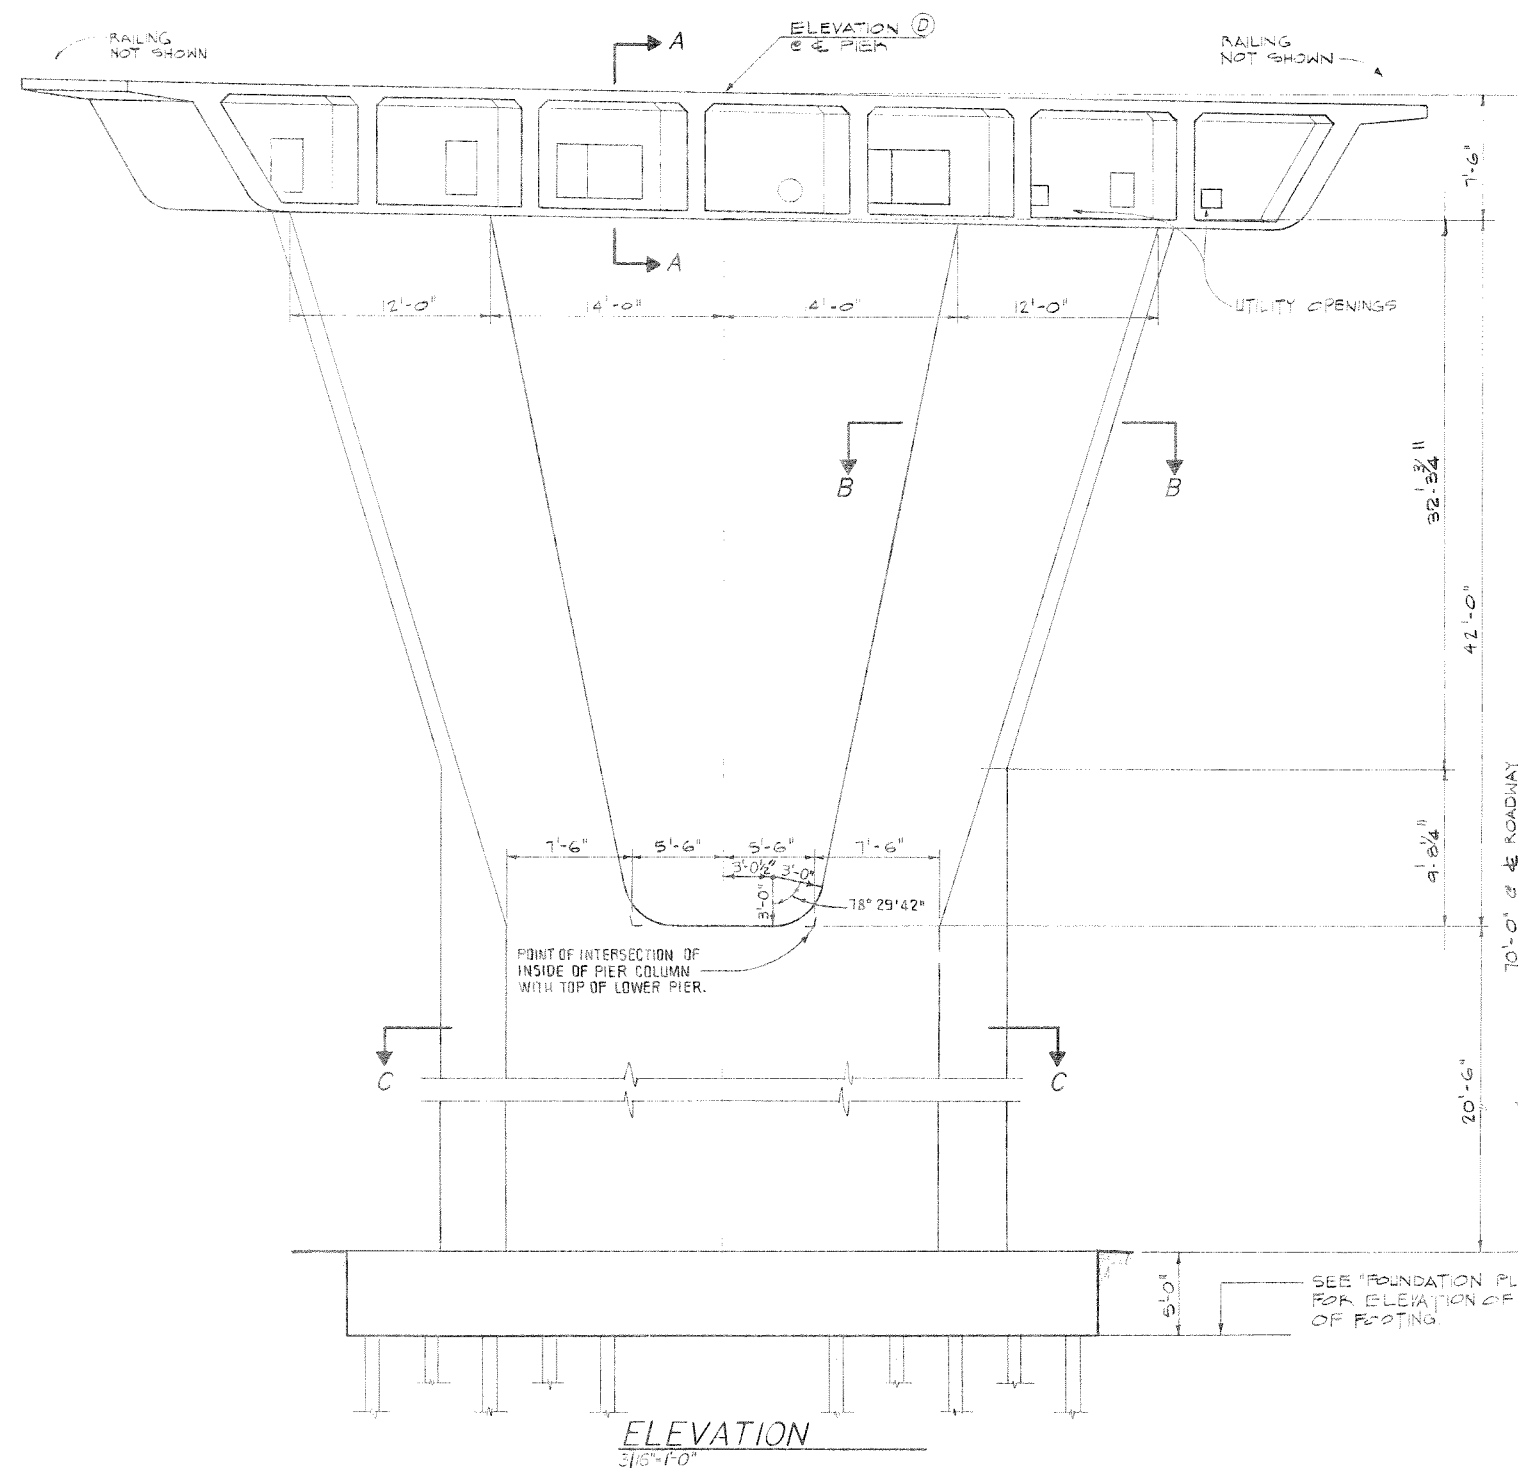


SECTION A-A
3/16" = 1'-0"

SECTION B-B
3/16" = 1'-0"

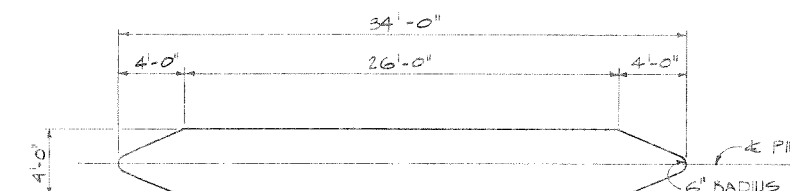

SECTION C-C
3/16" = 1'-0"

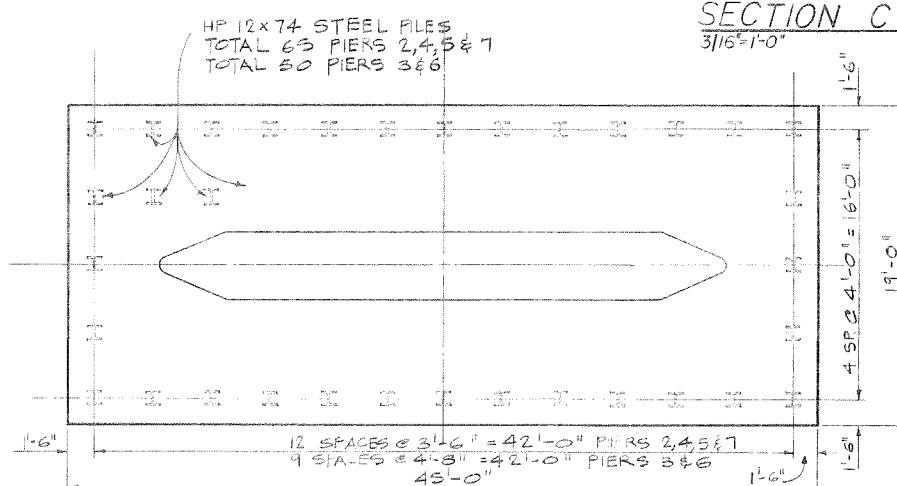

FOOTING PLAN
3/16" = 1'-0"

WHEELER & GRAY
CONSULTING ENGINEERS
2512 Chambers Road, Suite 205
Tustin, California 92680

George W. Gray S.E. # 764

ORANGE COUNTY ENVIRONMENTAL MANAGEMENT AGENCY			
ALICIA PARKWAY BRIDGE (AR-2) OVER ARROYO TRABUCO CREEK (LO-2)			
PIERS			
MARK	DATE	DESCRIPTION	PREPARED UNDER SUPERVISION OF
REVISIONS			
DESIGNED	W. F. POND	SCALE	DATE
DRAWN	E. G.	CHECKED	DWG. NO.
SHEET 35 OF 57			