
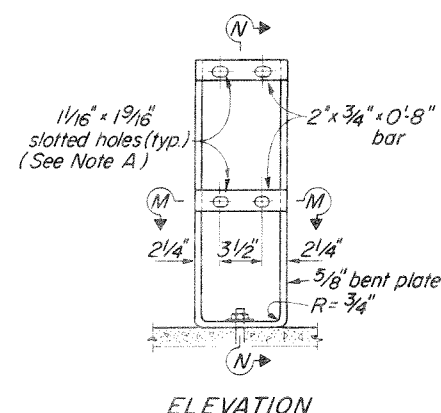
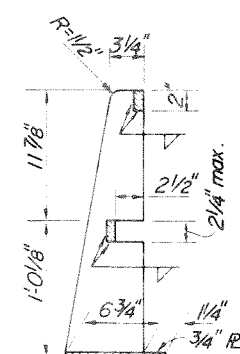
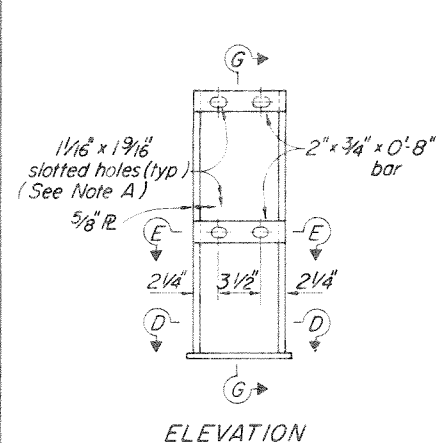
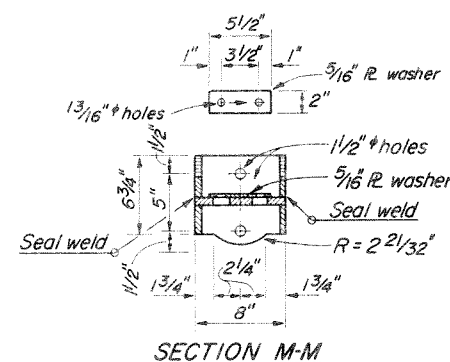
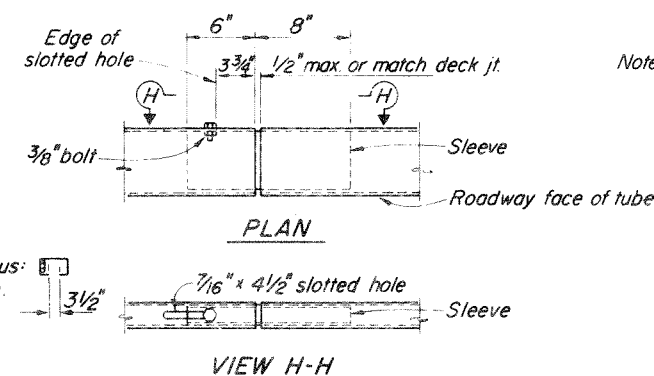
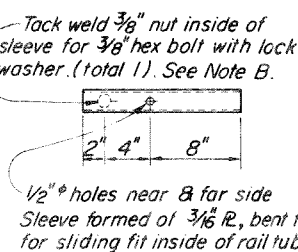
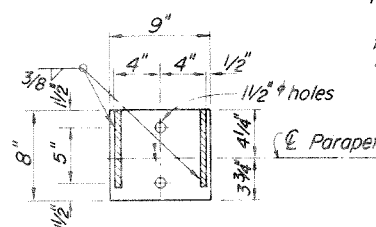
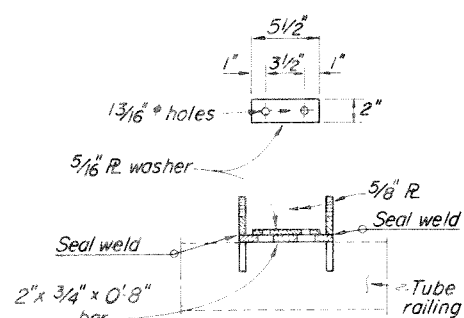
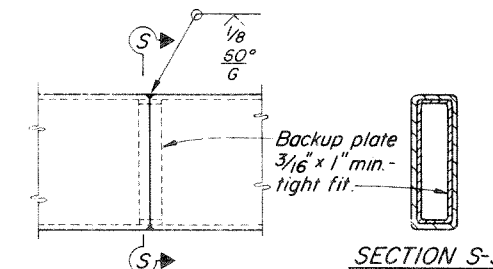
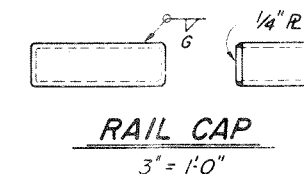
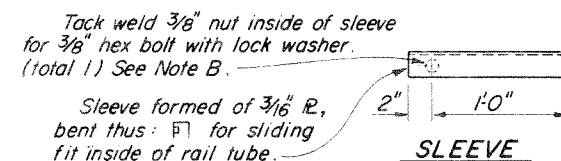
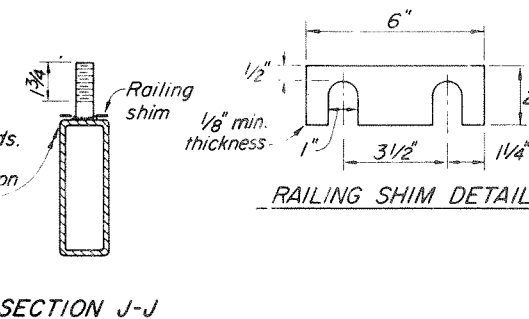
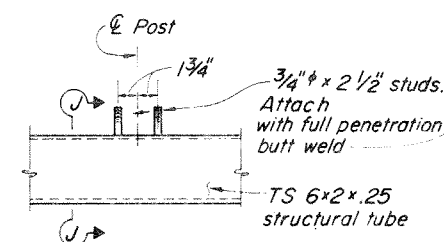
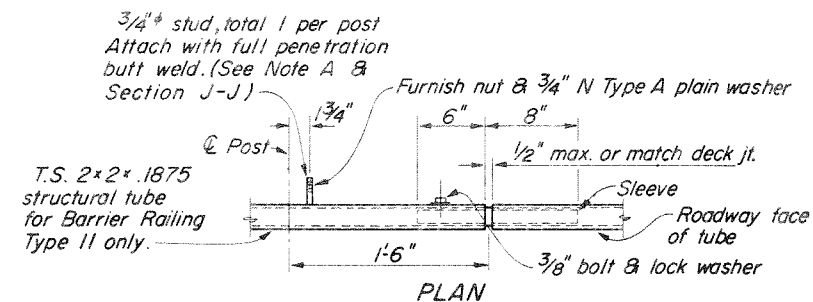


RAIL POST DETAILS TYPE II

*These details apply to
Barrier Railing Types II & 9-II*

ALTERNATIVE RAIL POST DETAILS TYPE II

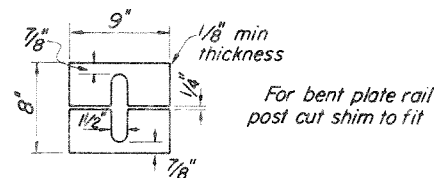

			ORANGE COUNTY ENVIRONMENTAL MANAGEMENT AGENCY		
			ALICIA PARKWAY BRIDGE (AR- OVER ARROYO TRABUCO CREEK (LOCALITY 1))		
			METAL RAILING DETAILS TYPE II		
MARK	DATE	DESCRIPTION	PREPARED UNDER SUPERVISION OF <i>Gene A. Lister</i>	DATE	SHEET 46 OF 5
REVISIONS					
DESIGNED	W.F. POND		SCALE	DATE	DWG. NO.
DRAWN	E.G.	CHECKED W.F.P.	AS SHOWN	JUNE '82	