

ORANGE COUNTY

PUBLIC FACILITIES AND RESOURCES DEPARTMENT

SANTA ANA, CALIFORNIA
VICKI L. WILSON, DIRECTOR



PLANS FOR CONSTRUCTION OF

THE DECK JOINT RETROFIT OF THE SANTA MARGARITA PARKWAY BRIDGE OVER ARROYO TRABUCO

BRIDGE 55C-0520R

SEPTEMBER, 2000

FUNDED BY: COUNTY OF ORANGE
MAINTAINED BY: COUNTY OF ORANGE

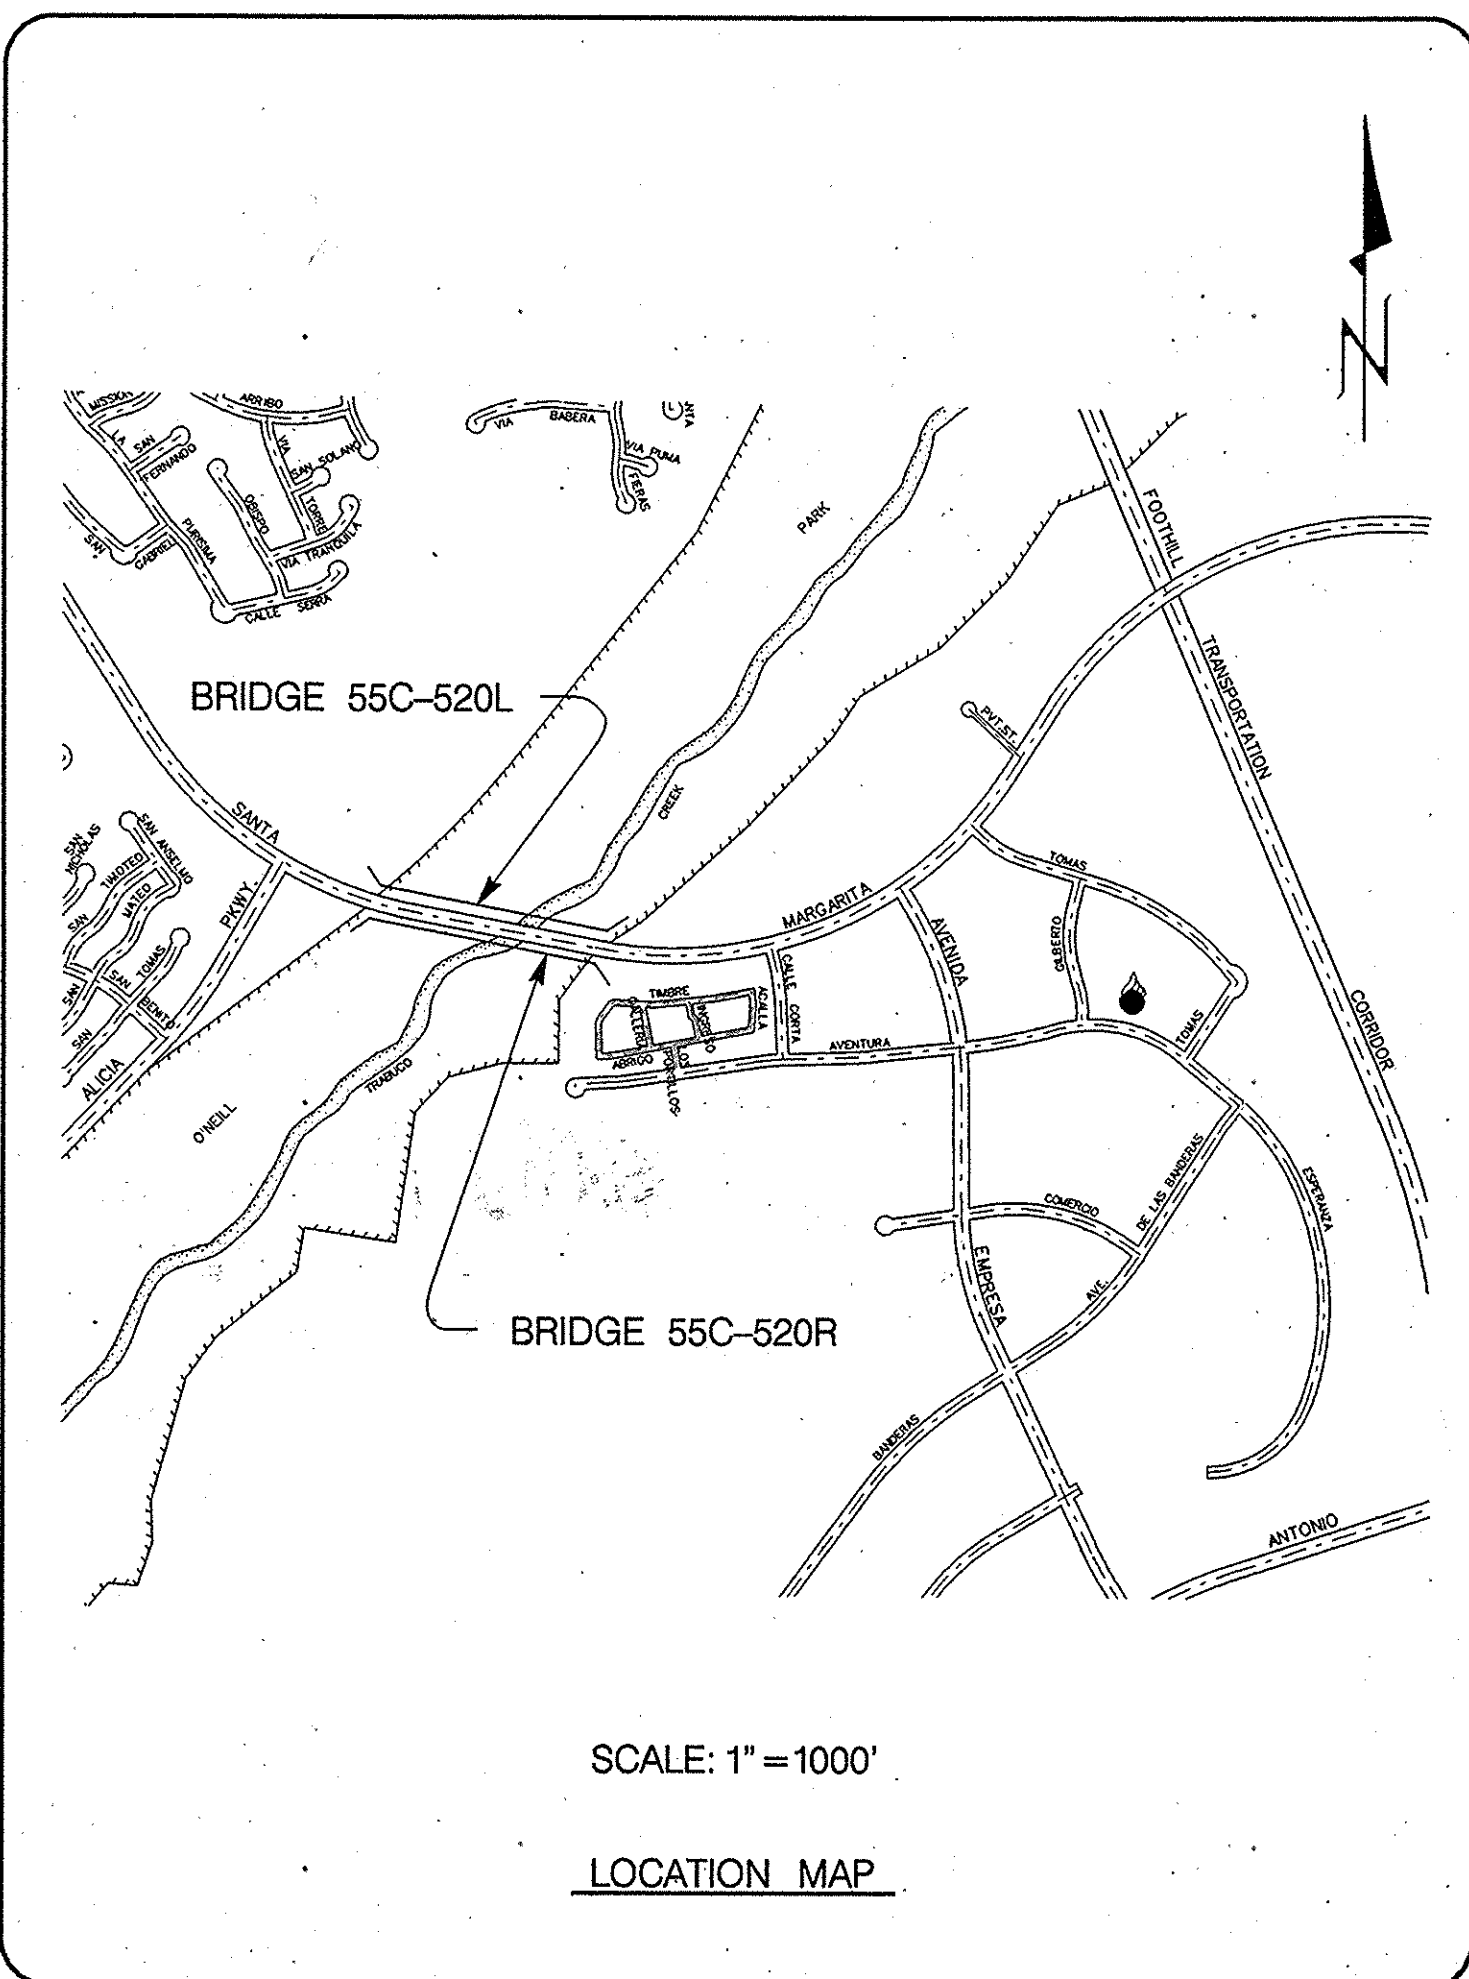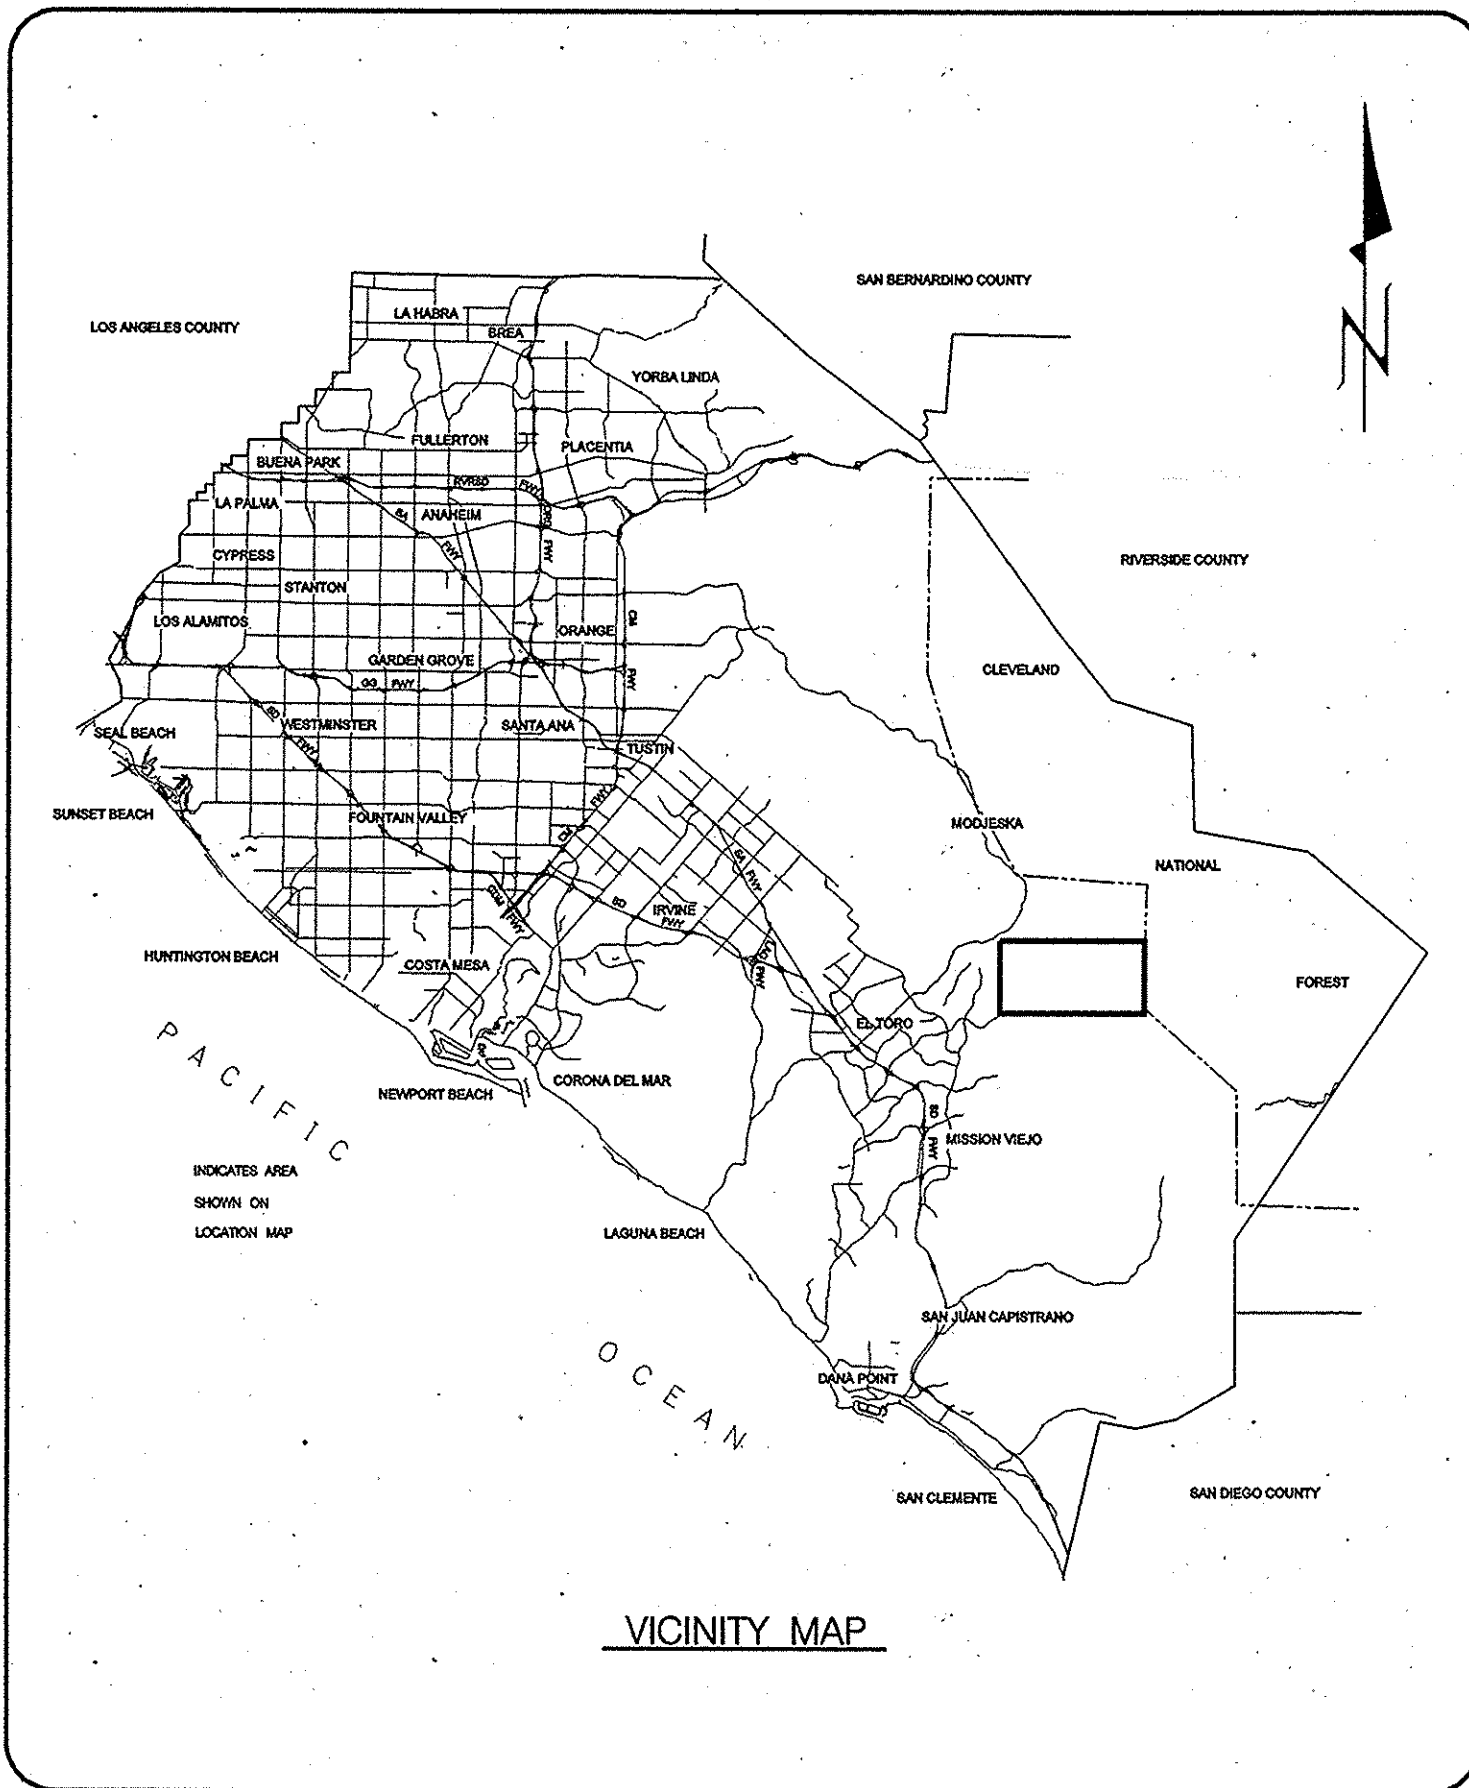

INDEX OF SHEETS


SHEET	DESCRIPTION
1	TITLE SHEET
2	GENERAL PLAN
3	ABUTMENT DETAILS NO. 1
4	ABUTMENT DETAILS NO. 2
5	HINGE DETAILS
6	JOINT SEAL ASSEMBLY DETAILS




CALTRANS STANDARD PLANS DATED JULY 1999

A-10A	ABBREVIATIONS
A-10B	SYMBOLS
B0-13	BRIDGE DETAILS
B7-10	UTILITY OPENING BOX GIRDER

UTILITY OWNER
PACIFIC BELL
SOUTHERN CALIFORNIA EDISON CO.
THE GAS COMPANY
SANTA MARGARITA WATER DISTRICT
COX COMMUNICATIONS

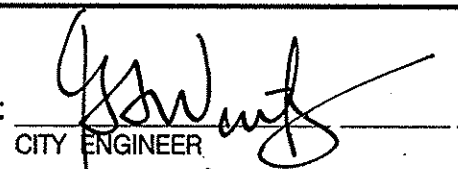PUBLIC FACILITIES & RESOURCES DEPARTMENT

APPROVALS	
APPROVED:  <small>CITY ENGINEER</small> CITY OF RANCHO SANTA MARGARITA	8/7/00 <small>DATE</small>

SUBMITTED:	 <small>ROAD DESIGN CHIEF</small>	7-24-00 <small>DATE</small>
RECOMMENDED:	 <small>DESIGN DIVISION MANAGER</small>	7-24-00 <small>DATE</small>
APPROVED:	 <small>CHIEF ENGINEER</small>	7-24-00 <small>DATE</small>

RECORD DRAWING

NO.	DESCRIPTION	SHT.	APPROVED	DATE

R E V I S I O N S

W. O. NO. ER09335
DWG. NO. _____

SHEET 1 OF 6