



W. J. Elliott
 BRIDGE ENGINEER CIVIL ENGINEER—LICENSE 5588
 APPROVED September 4, 1962


COUNTY ROAD COMMISSIONER
 DATE
 BRIDGE PLANNING ENGINEER
 DATE

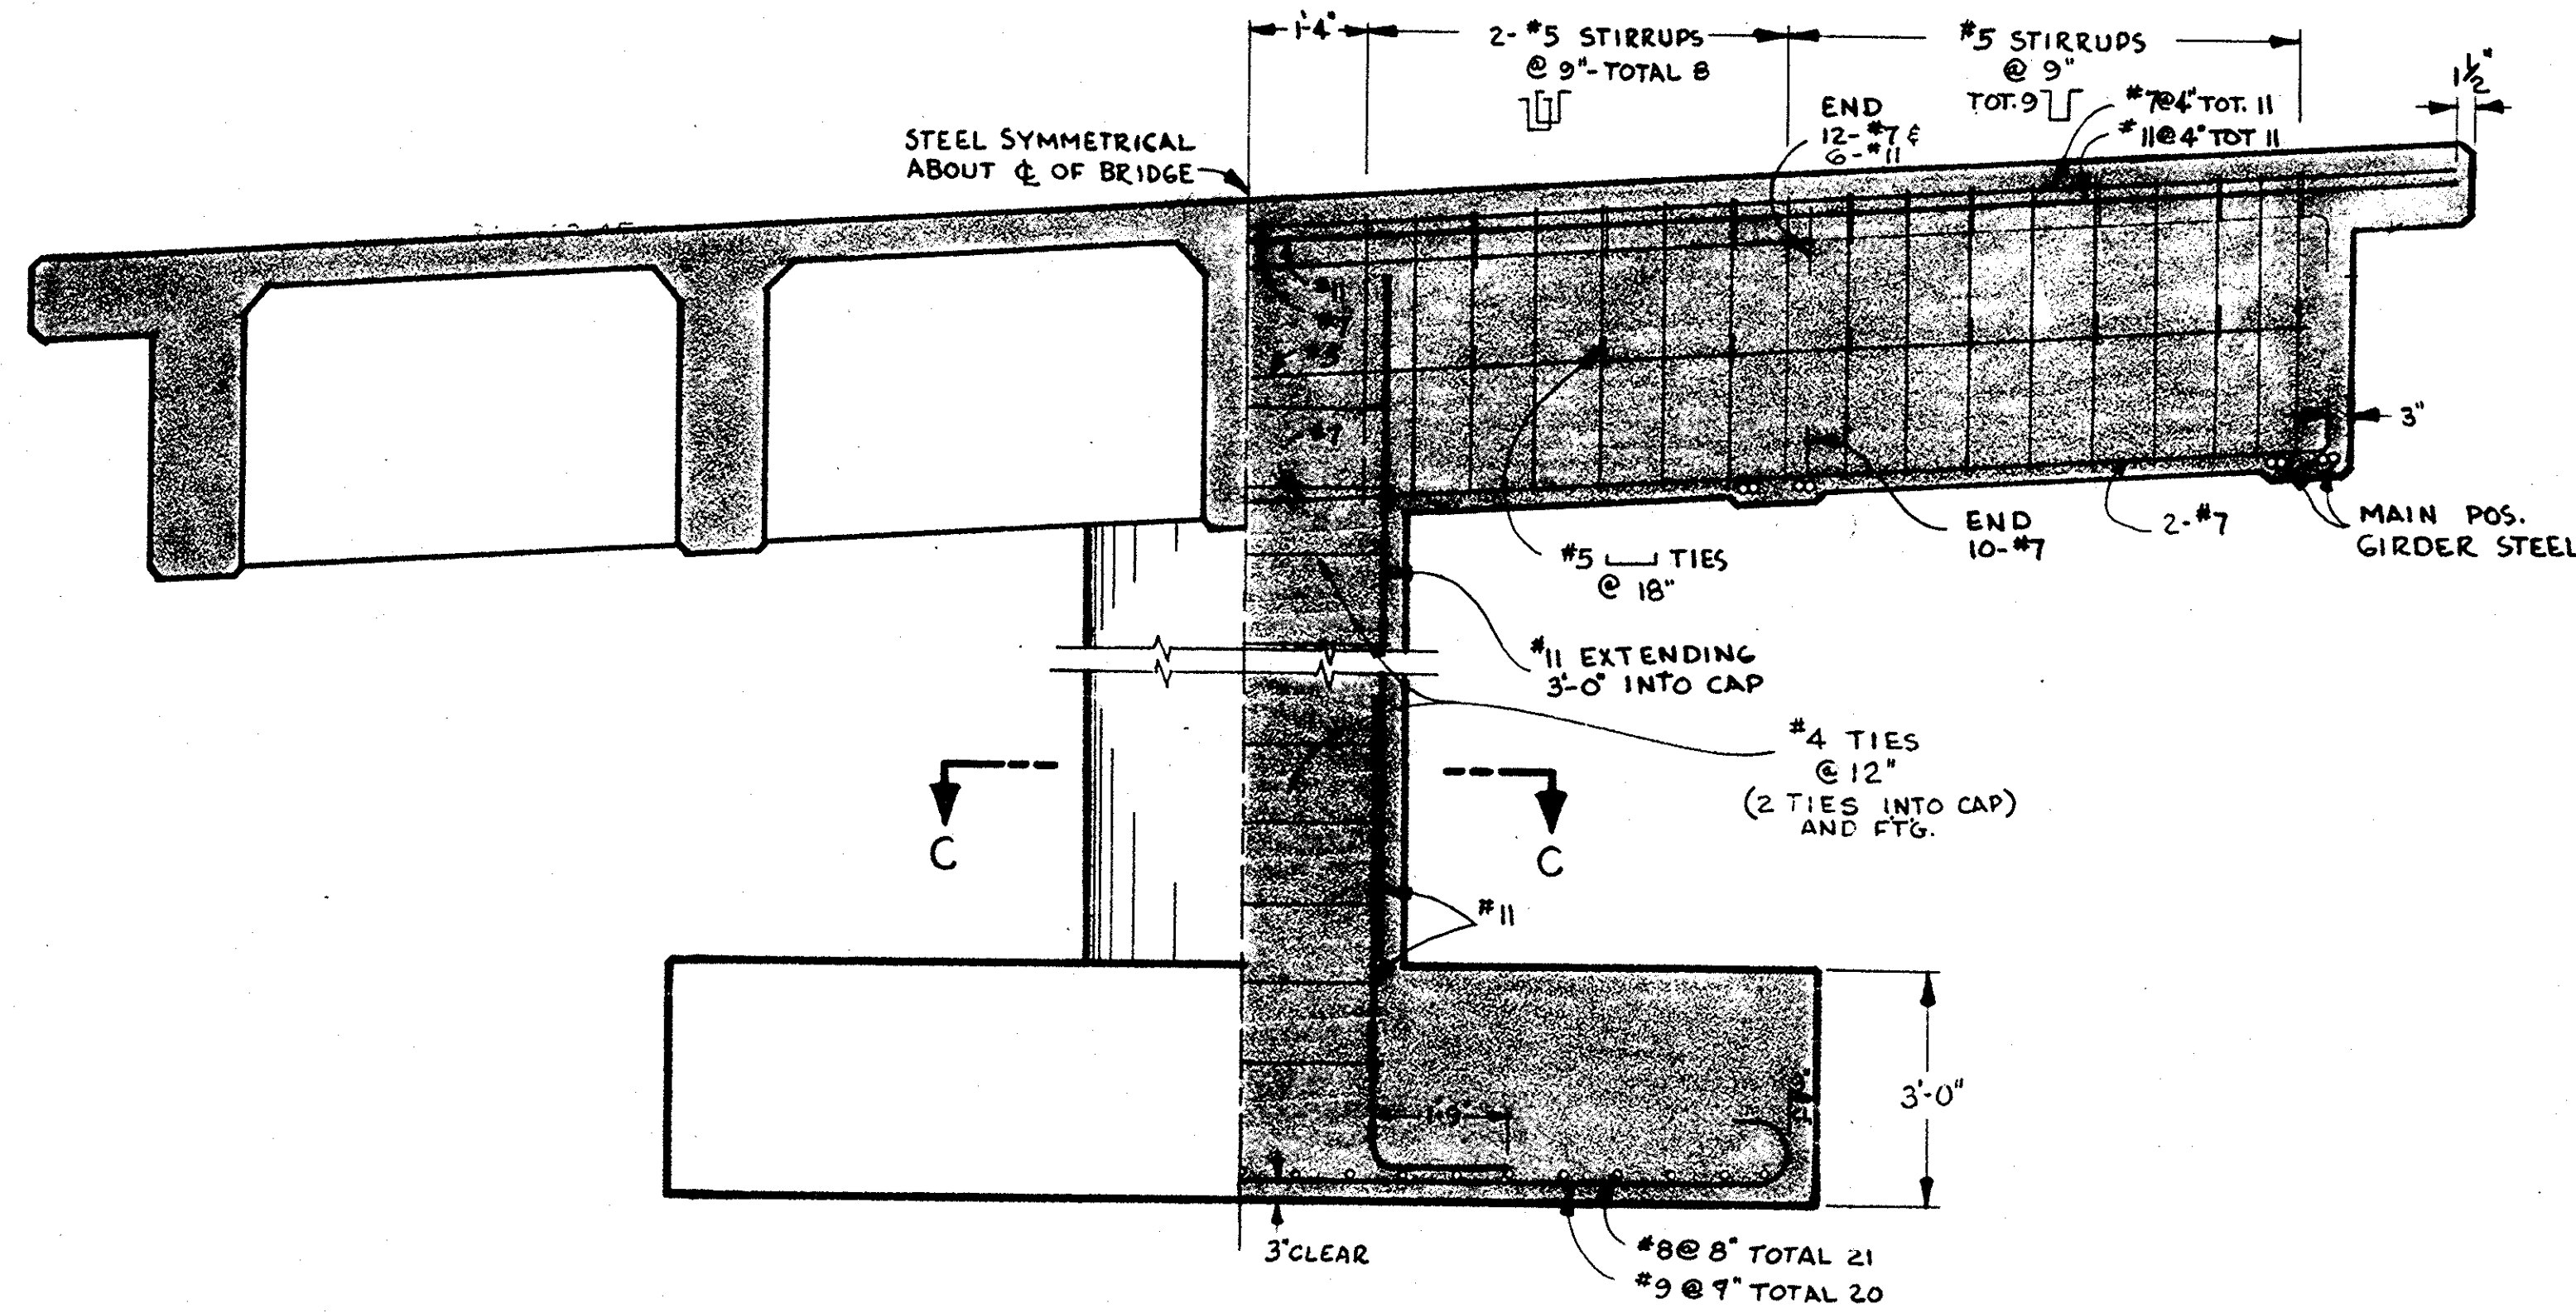


SECTION A-A

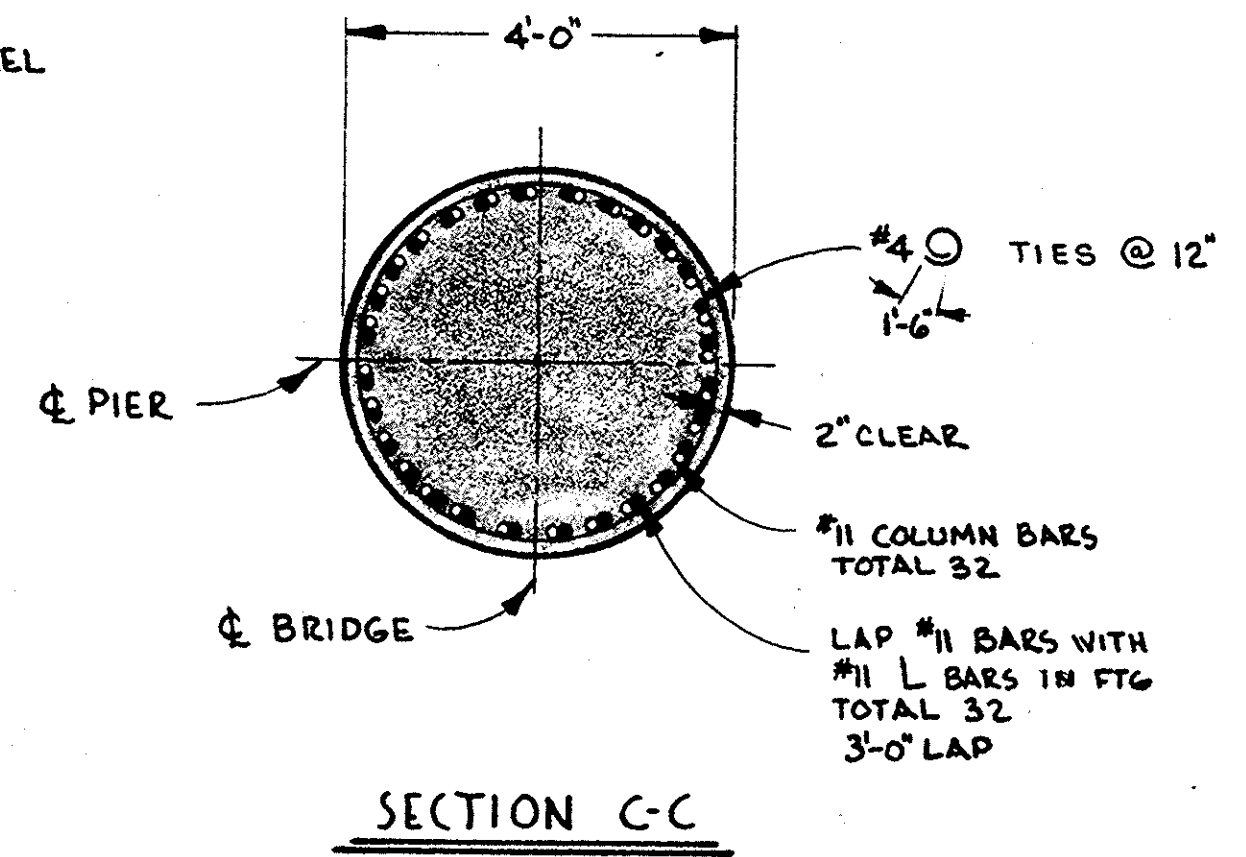


SECTION C-C

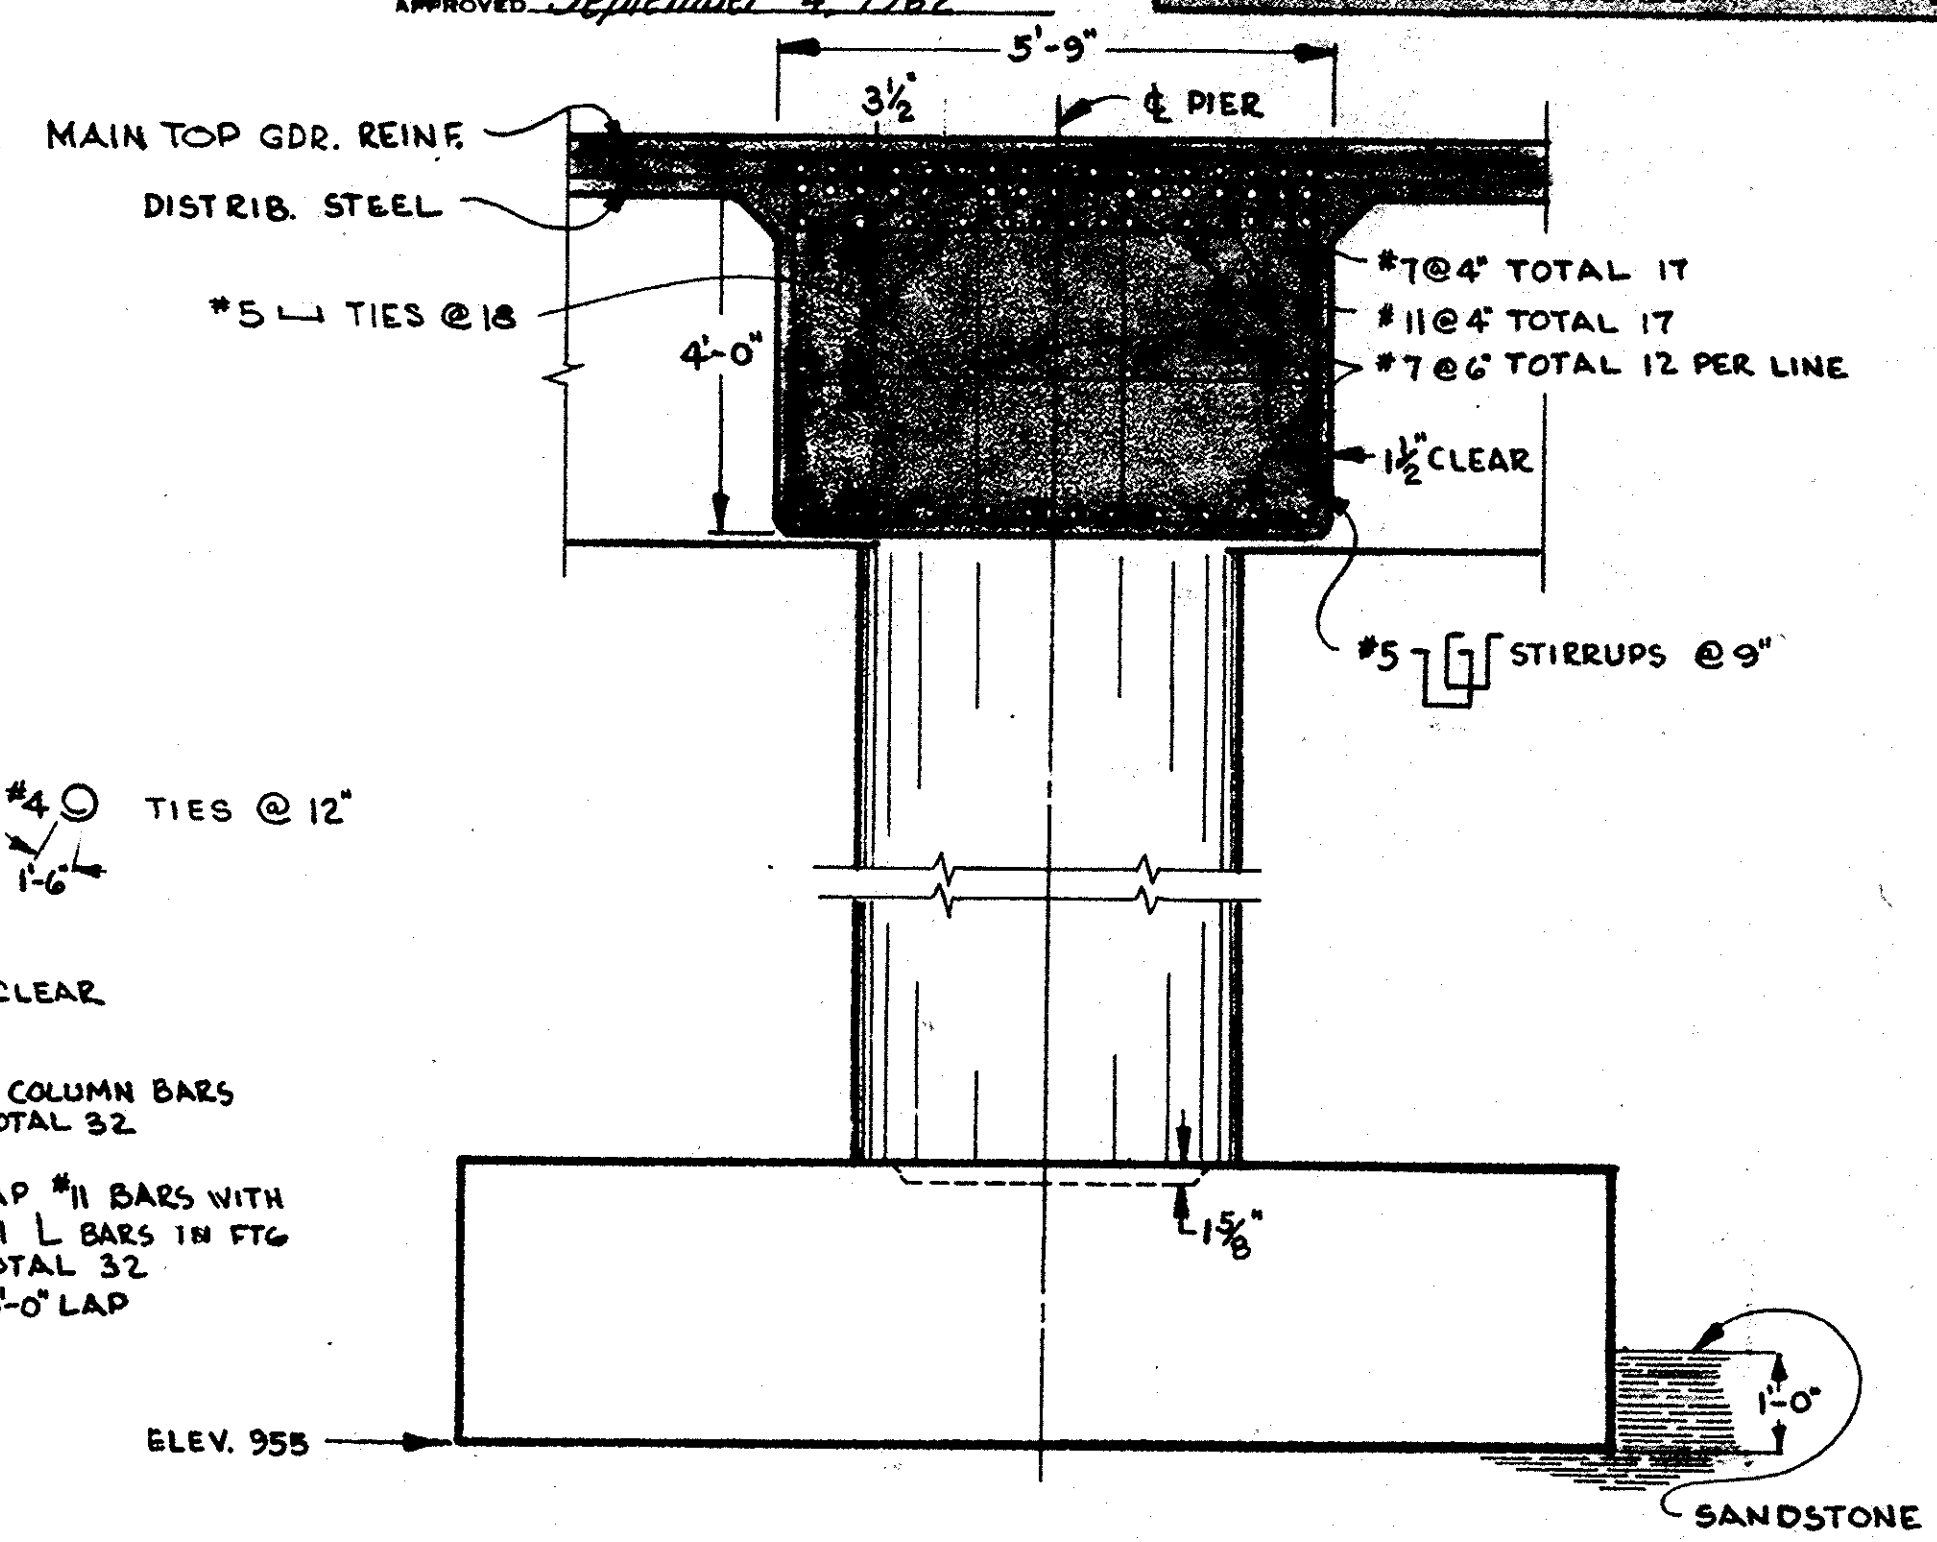

SECTION B-B

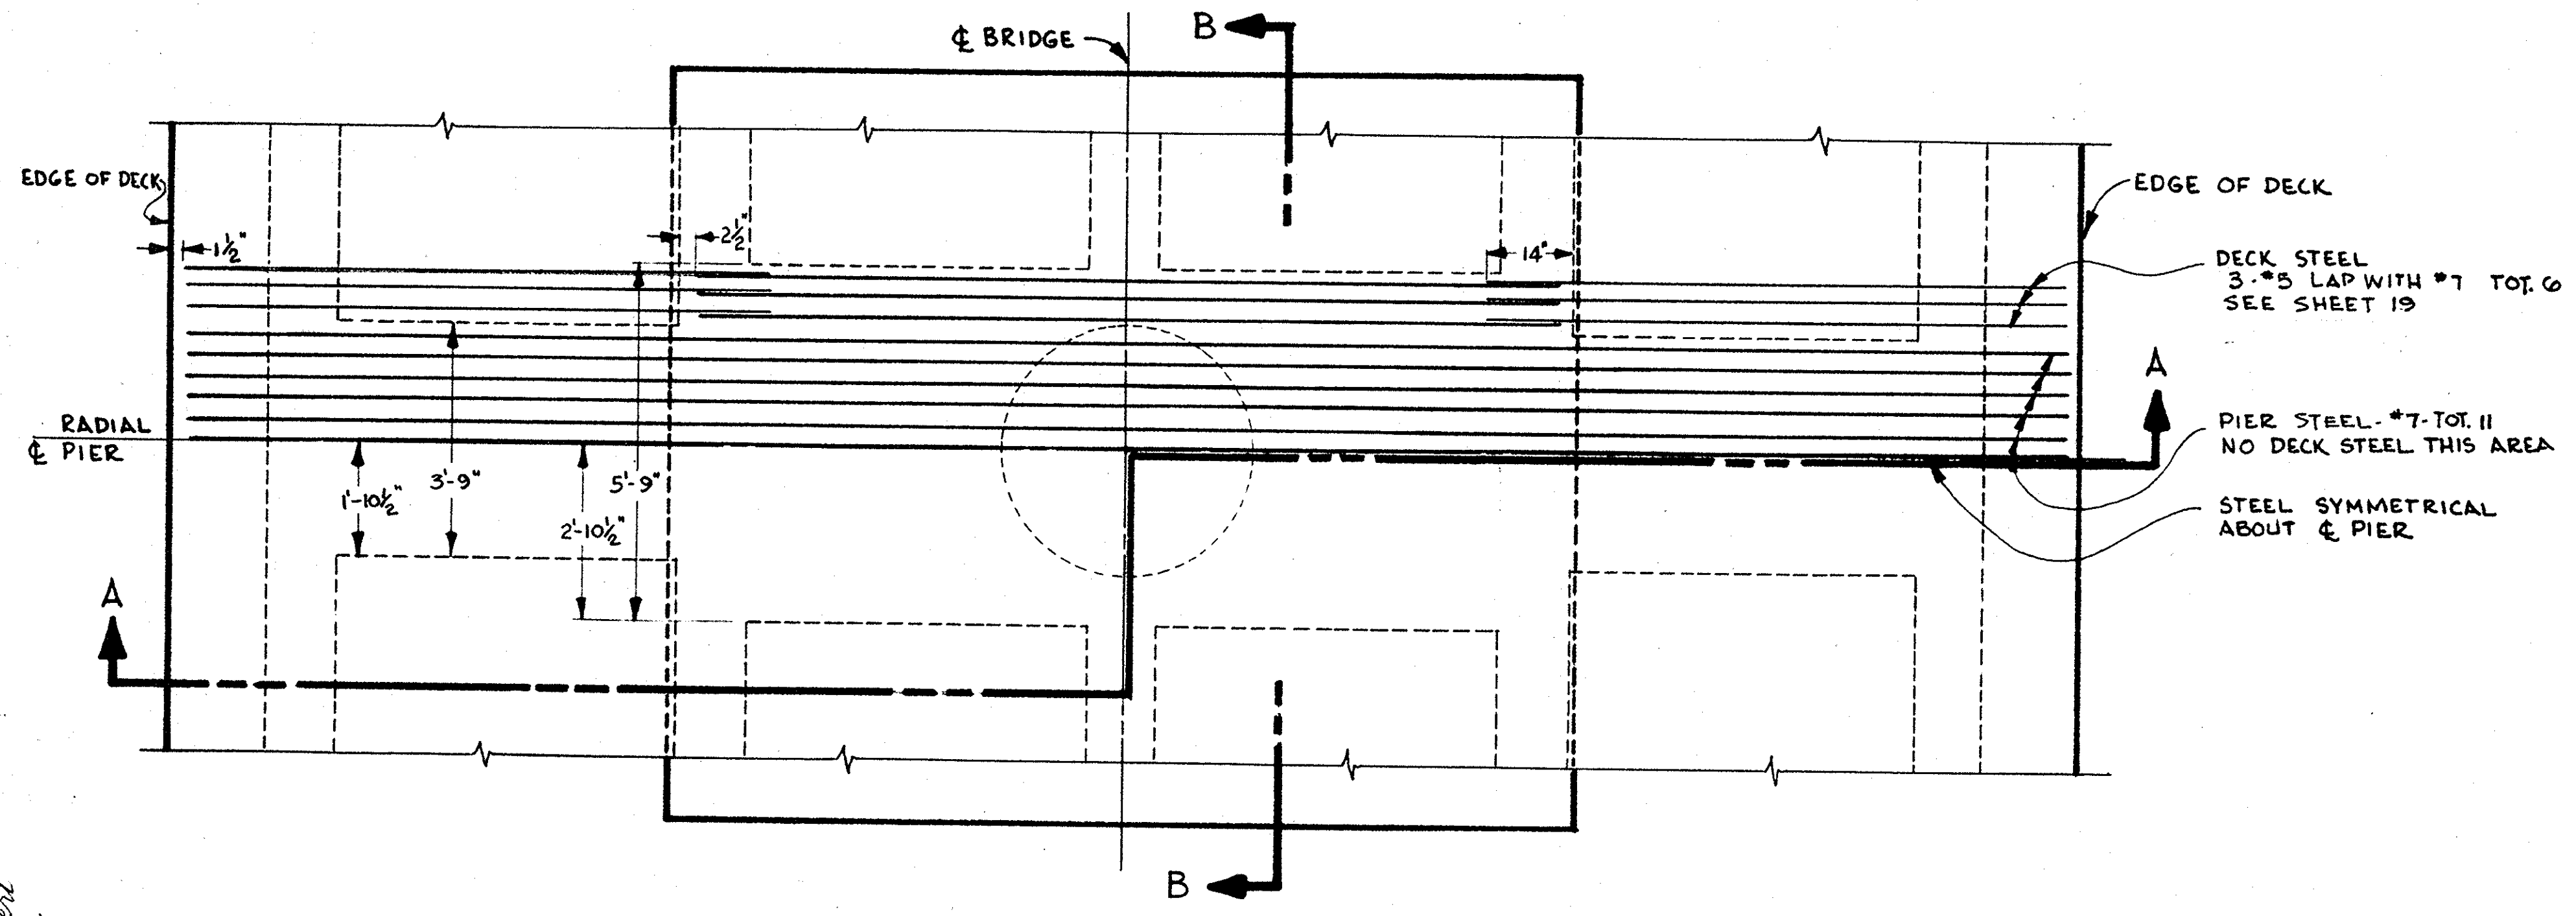

PLAN

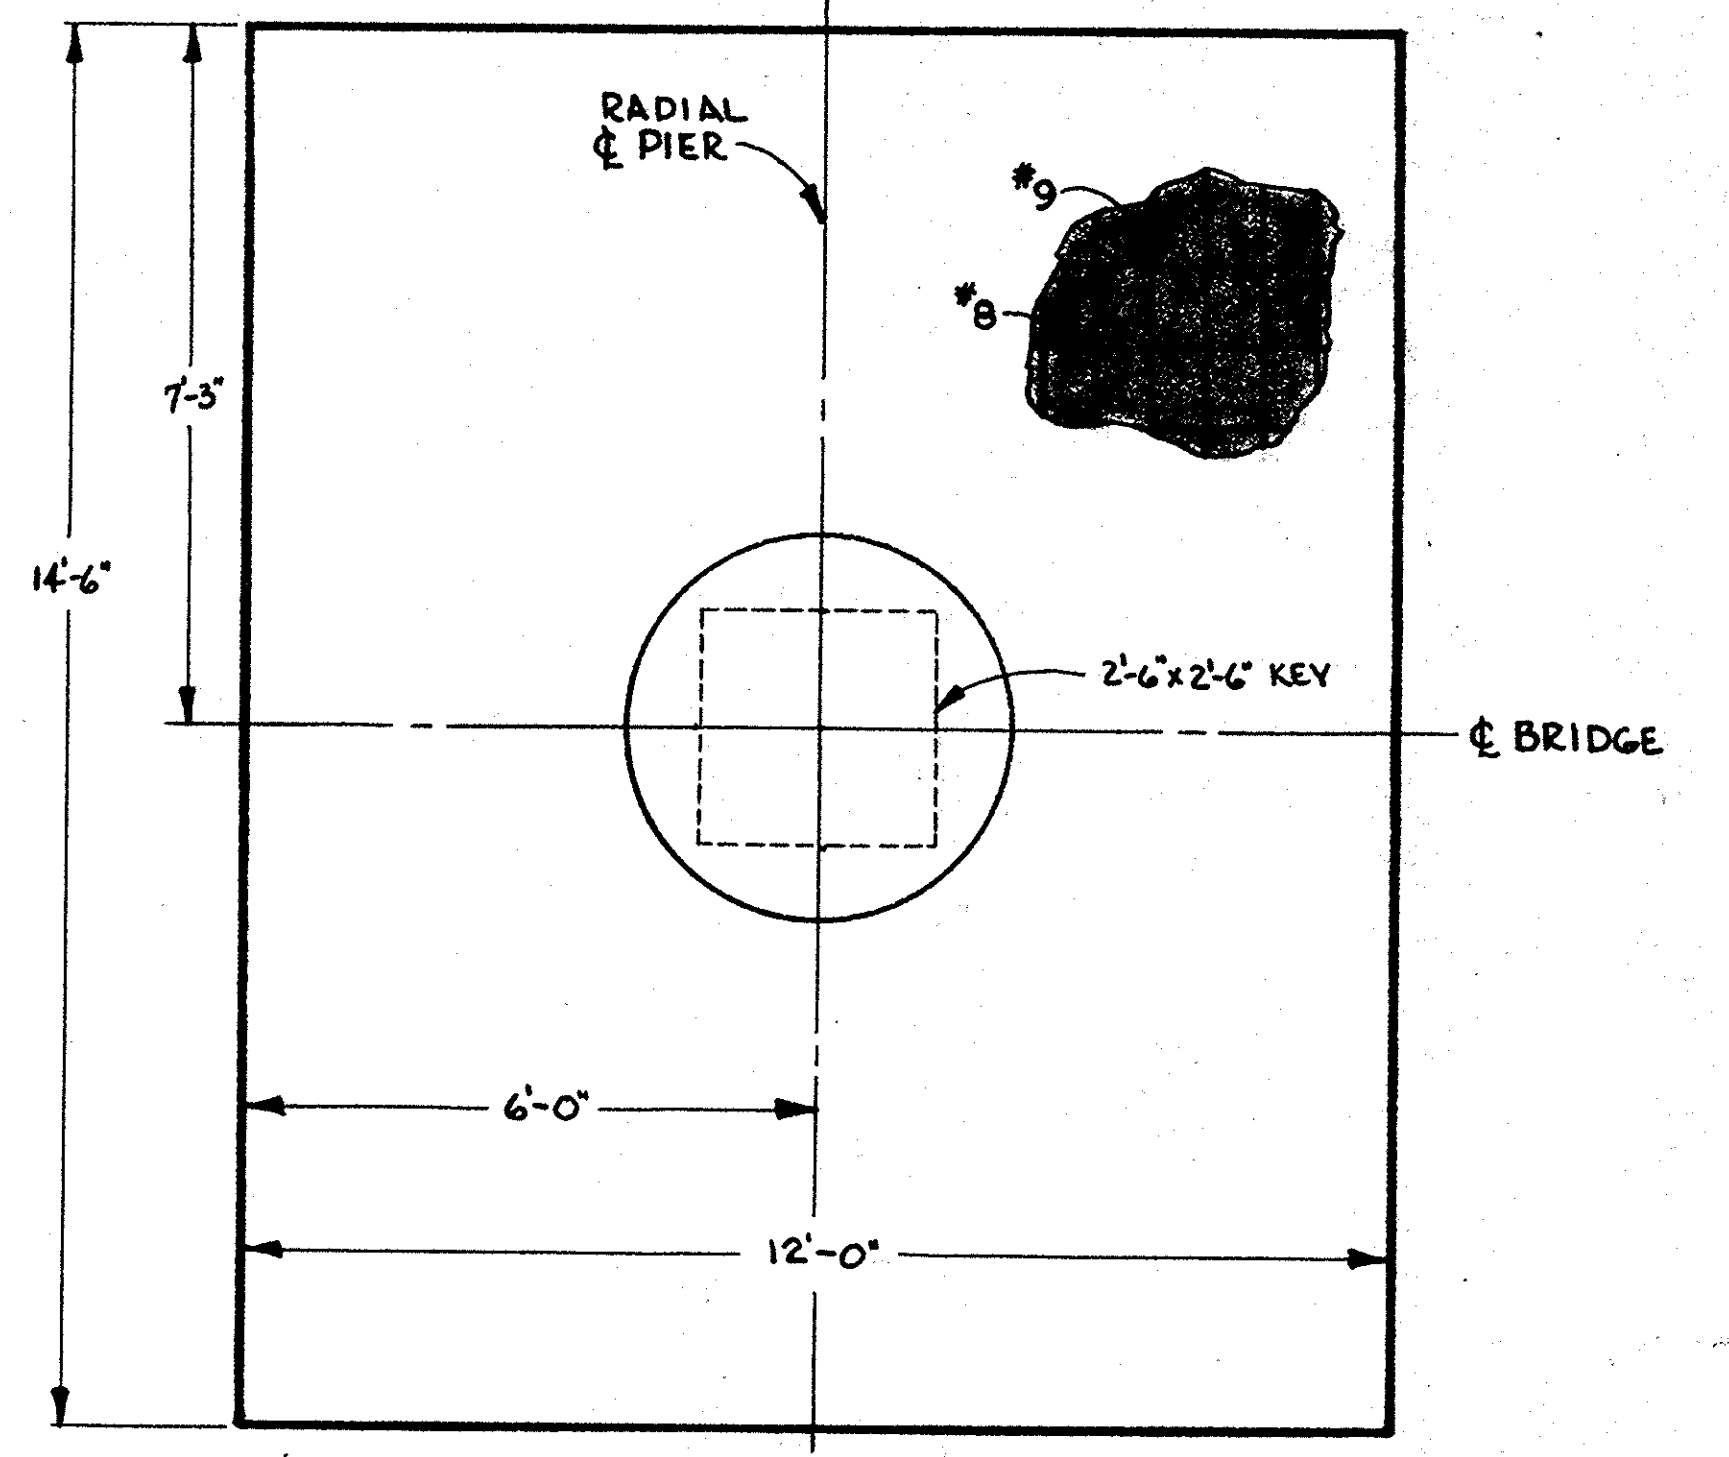

FOOTING PLAN

Structural Details
 Checked By *W. J. Elliott*
 Reviewed By *W. J. Elliott*
 Approval Recommended

AS BUILT
 CONTRACT NO. 63-722AC3-P
 RESIDENT ENGR. D. E. Bourgeois
 DATE 6/21/63

C-55C38-2
 ORANGE COUNTY HIGHWAY DEPARTMENT
SANTIAGO CANYON
BRIDGE SC-9
PIER DETAIL
 SCALE $\frac{1}{2}'' = 1'-0''$
 SHEET 15 OF 29