



BRIDGE ENGINEER CIVIL ENGINEER—LICENSE 8885
 APPROVED September 4, 1962

PUBLIC ROAD		STATE	PROJECT	FISCAL YEAR	SHEET NO.	SHEETS
7		CALIF.	62-63	24	30	


BRIDGE PLANNING ENGINEER DATE

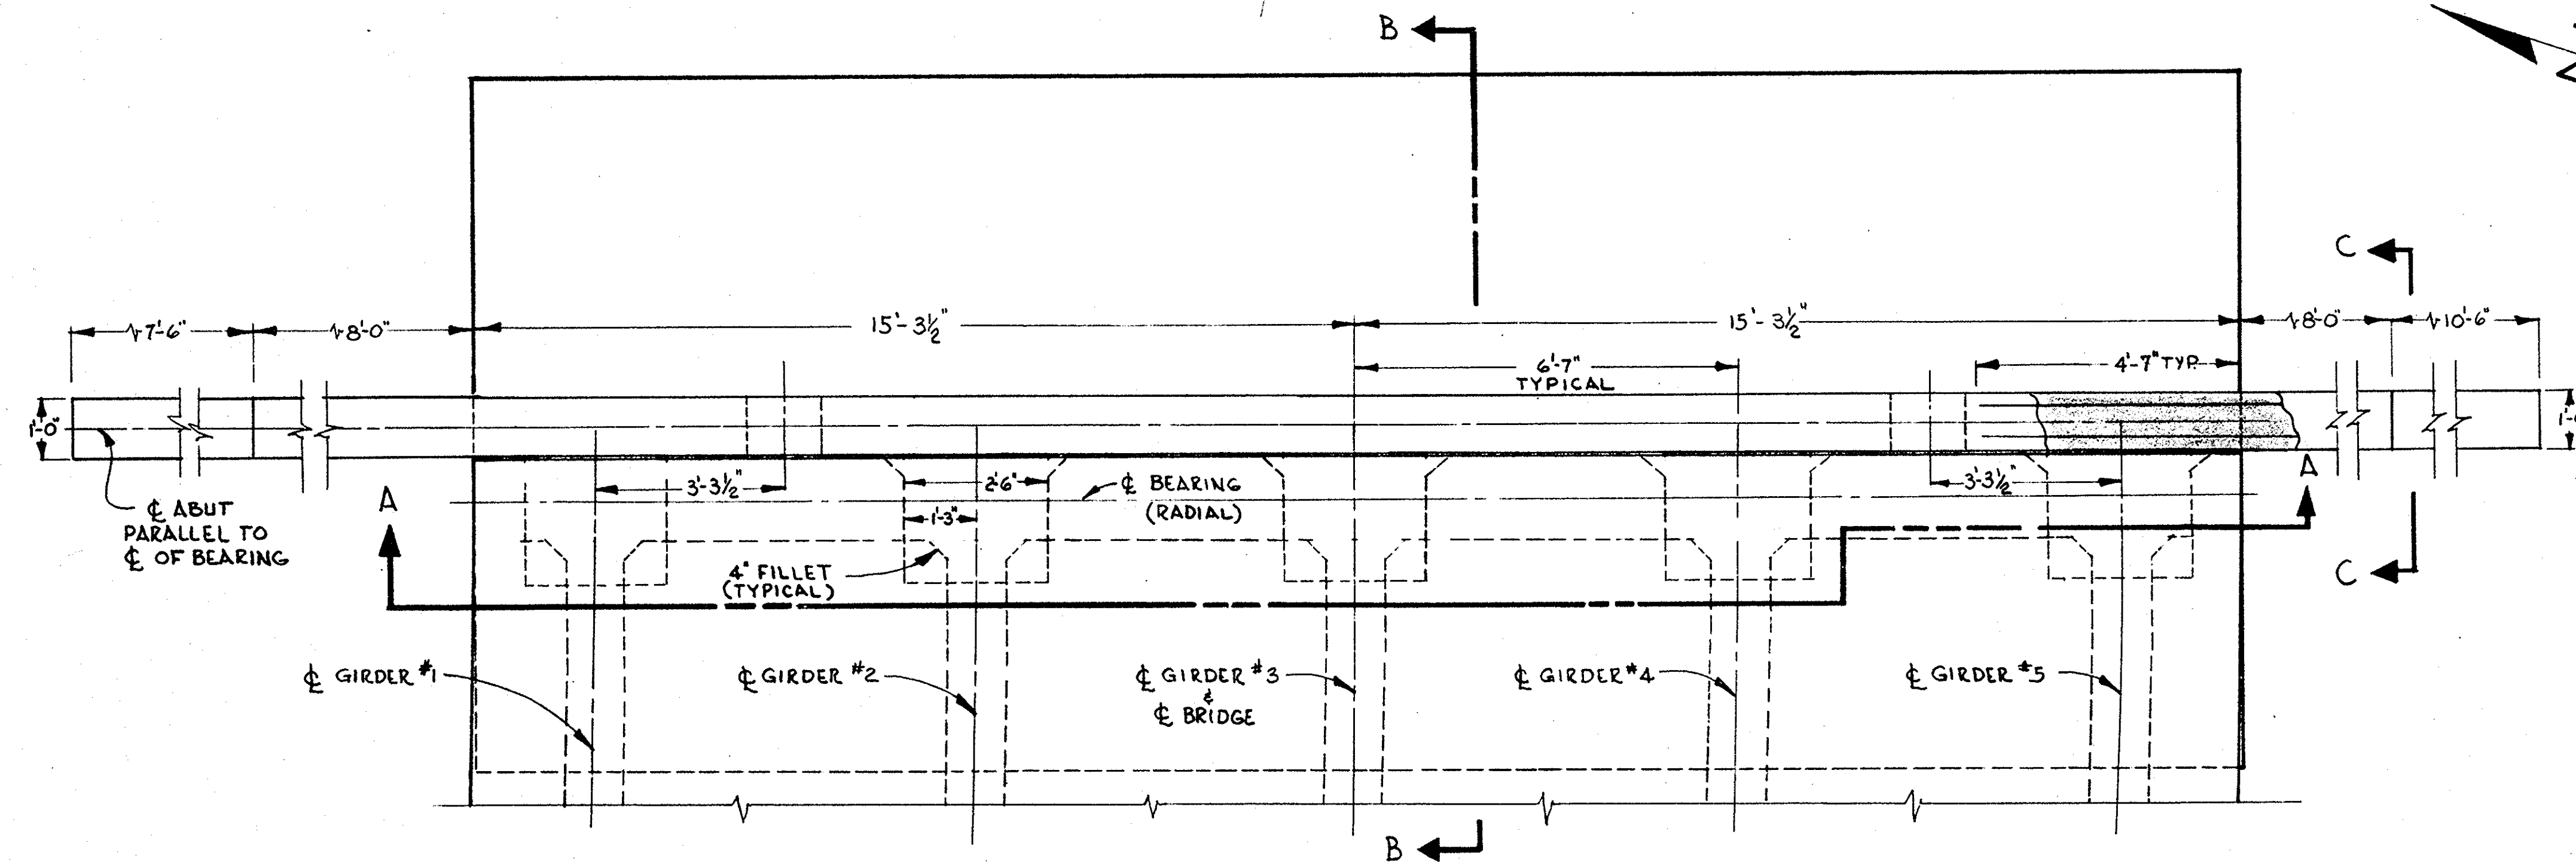


PLAN OF EAST ABUTMENT

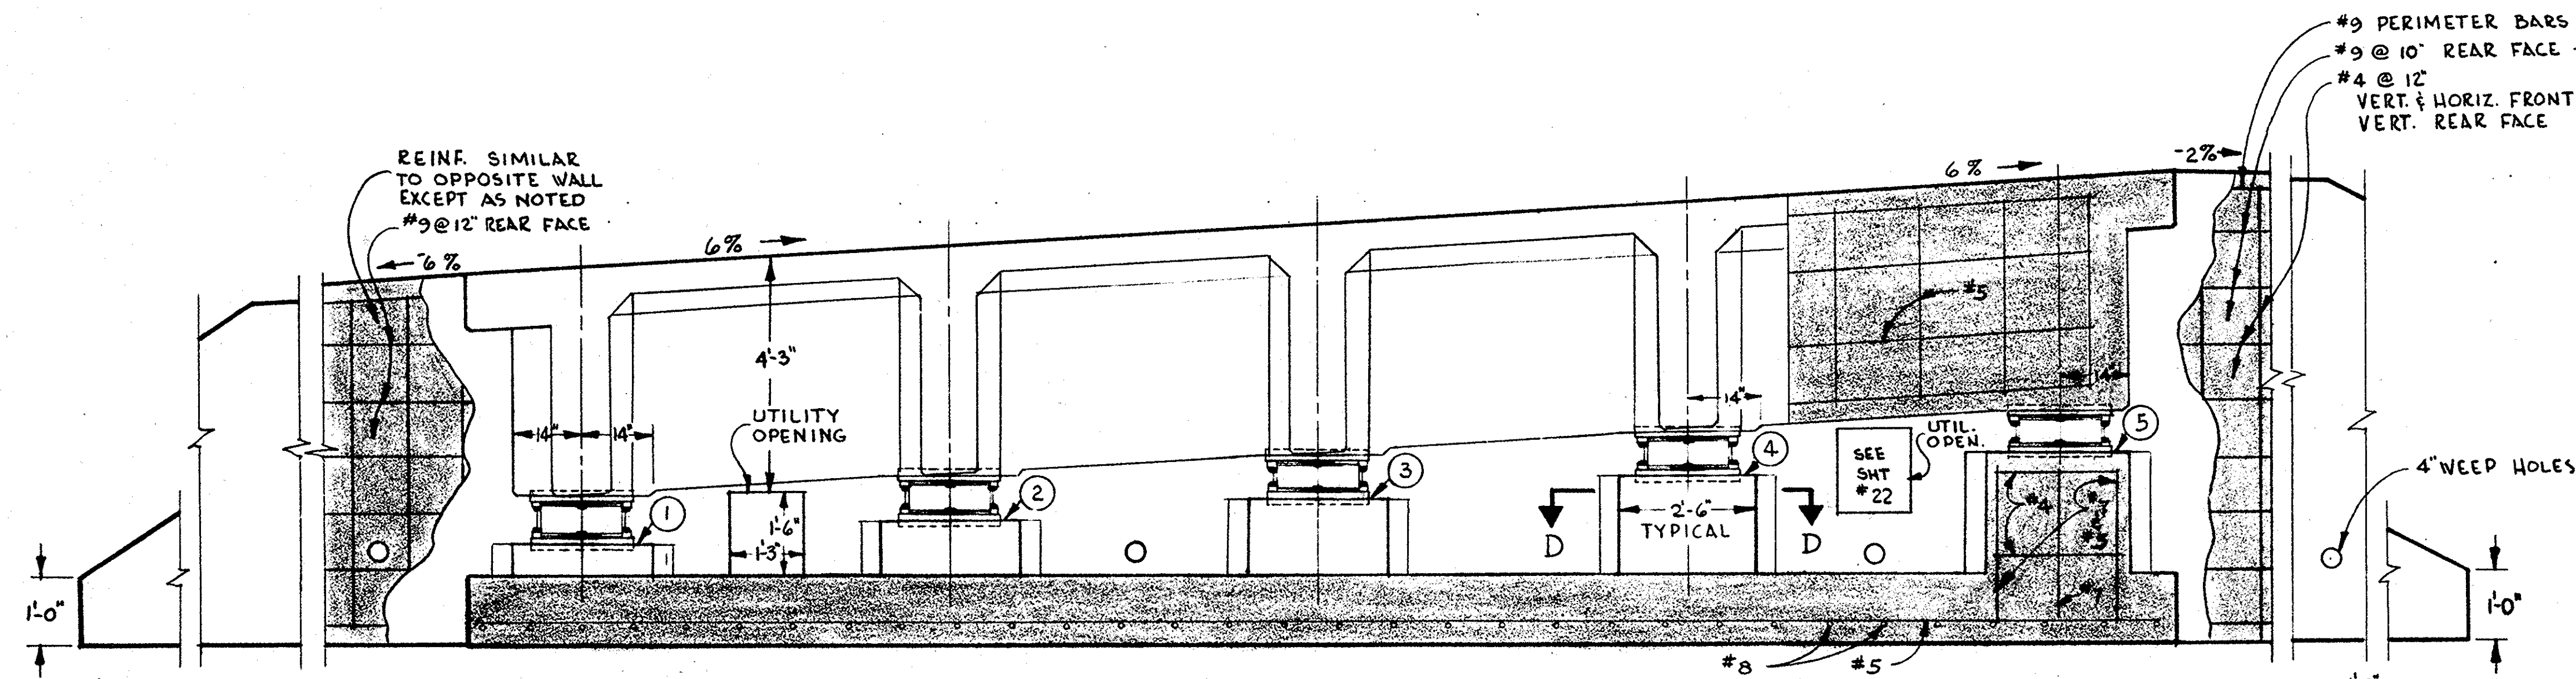


SECTION A-A

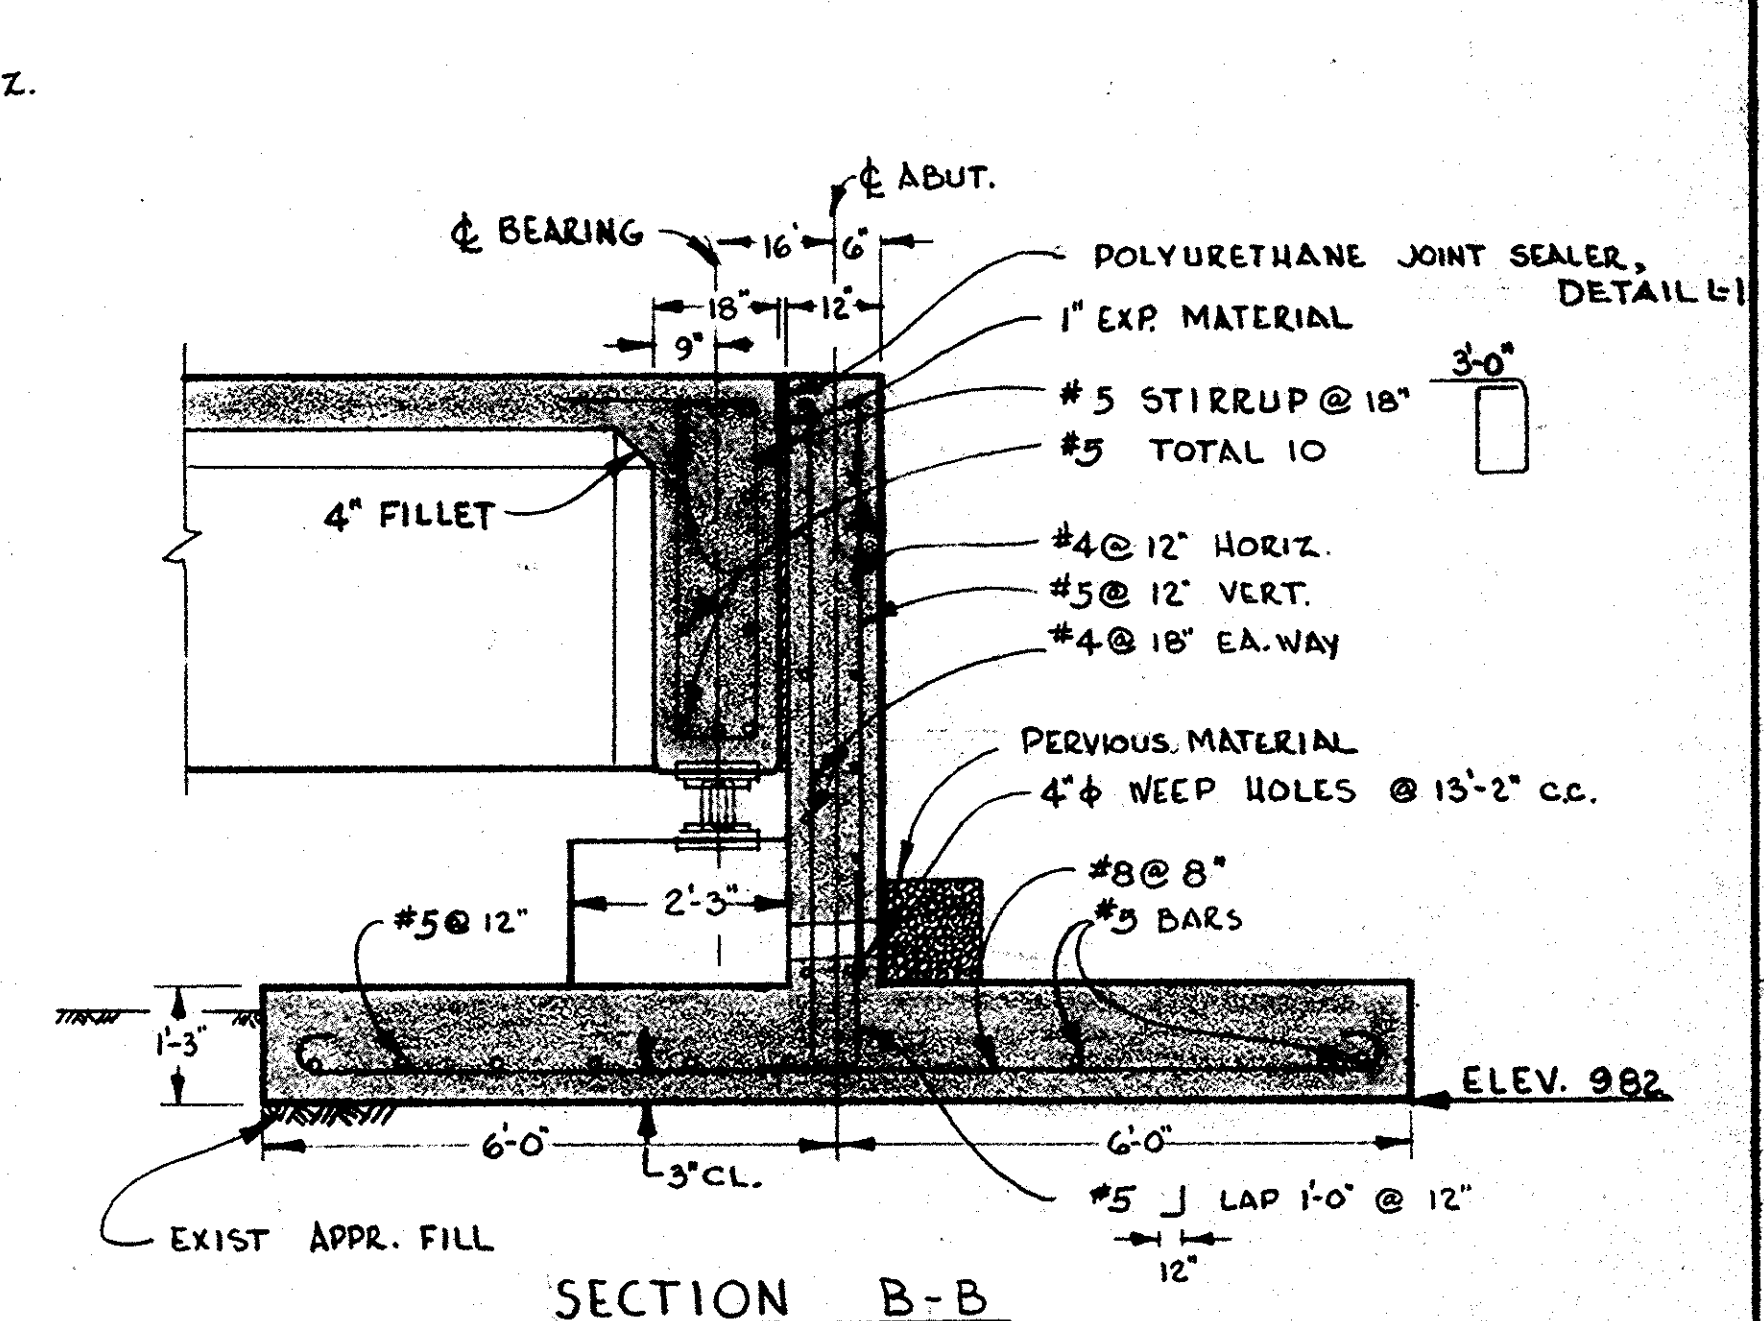

SECTION B-B

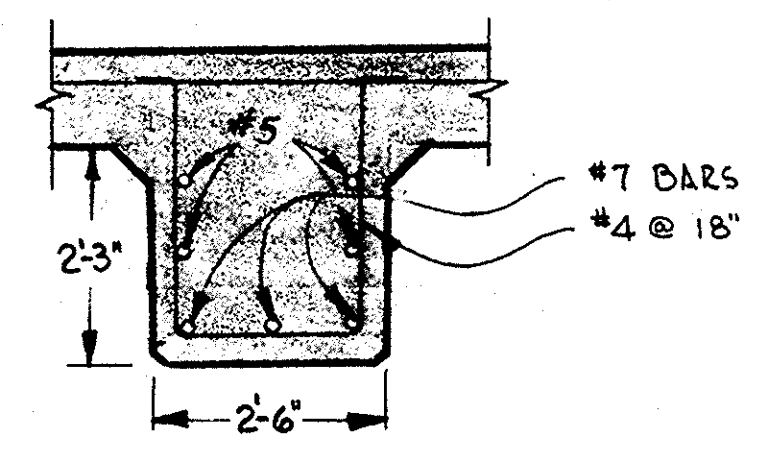

SECTION D-D

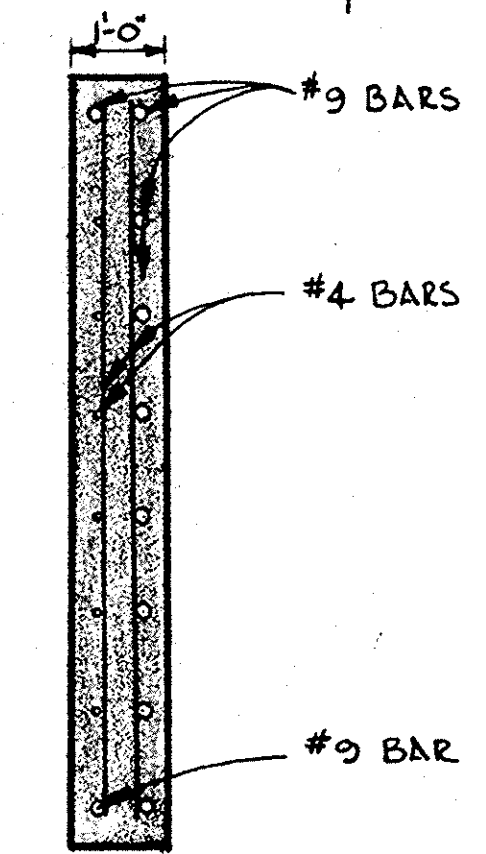

SECTION C-C

TABLE OF ELEVATIONS	
①	984.74
②	985.14
③	985.53
④	985.92
⑤	986.32

Structural Details
 Checked By *[Signature]*
 Revised By *[Signature]*
 Approval Recommended

AS BUILT
 CONTRACT NO. 63-TY24C3-P
 RESIDENT ENGR. *D.E. Bourgeois*
 DATE 6/21/63

ORANGE COUNTY HIGHWAY DEPARTMENT

**SANTIAGO CANYON
 BRIDGE SC-9**

**ABUTMENT
 DETAIL - EAST**

SCALE 1/2" = 1'-0"

SHEET 17 OF 29

24