



BRIDGE ENGINEER CIVIL ENGINEER—LICENSE 5555
APPROVED September 4, 1962


BRIDGE PLANNING ENGINEER DATE

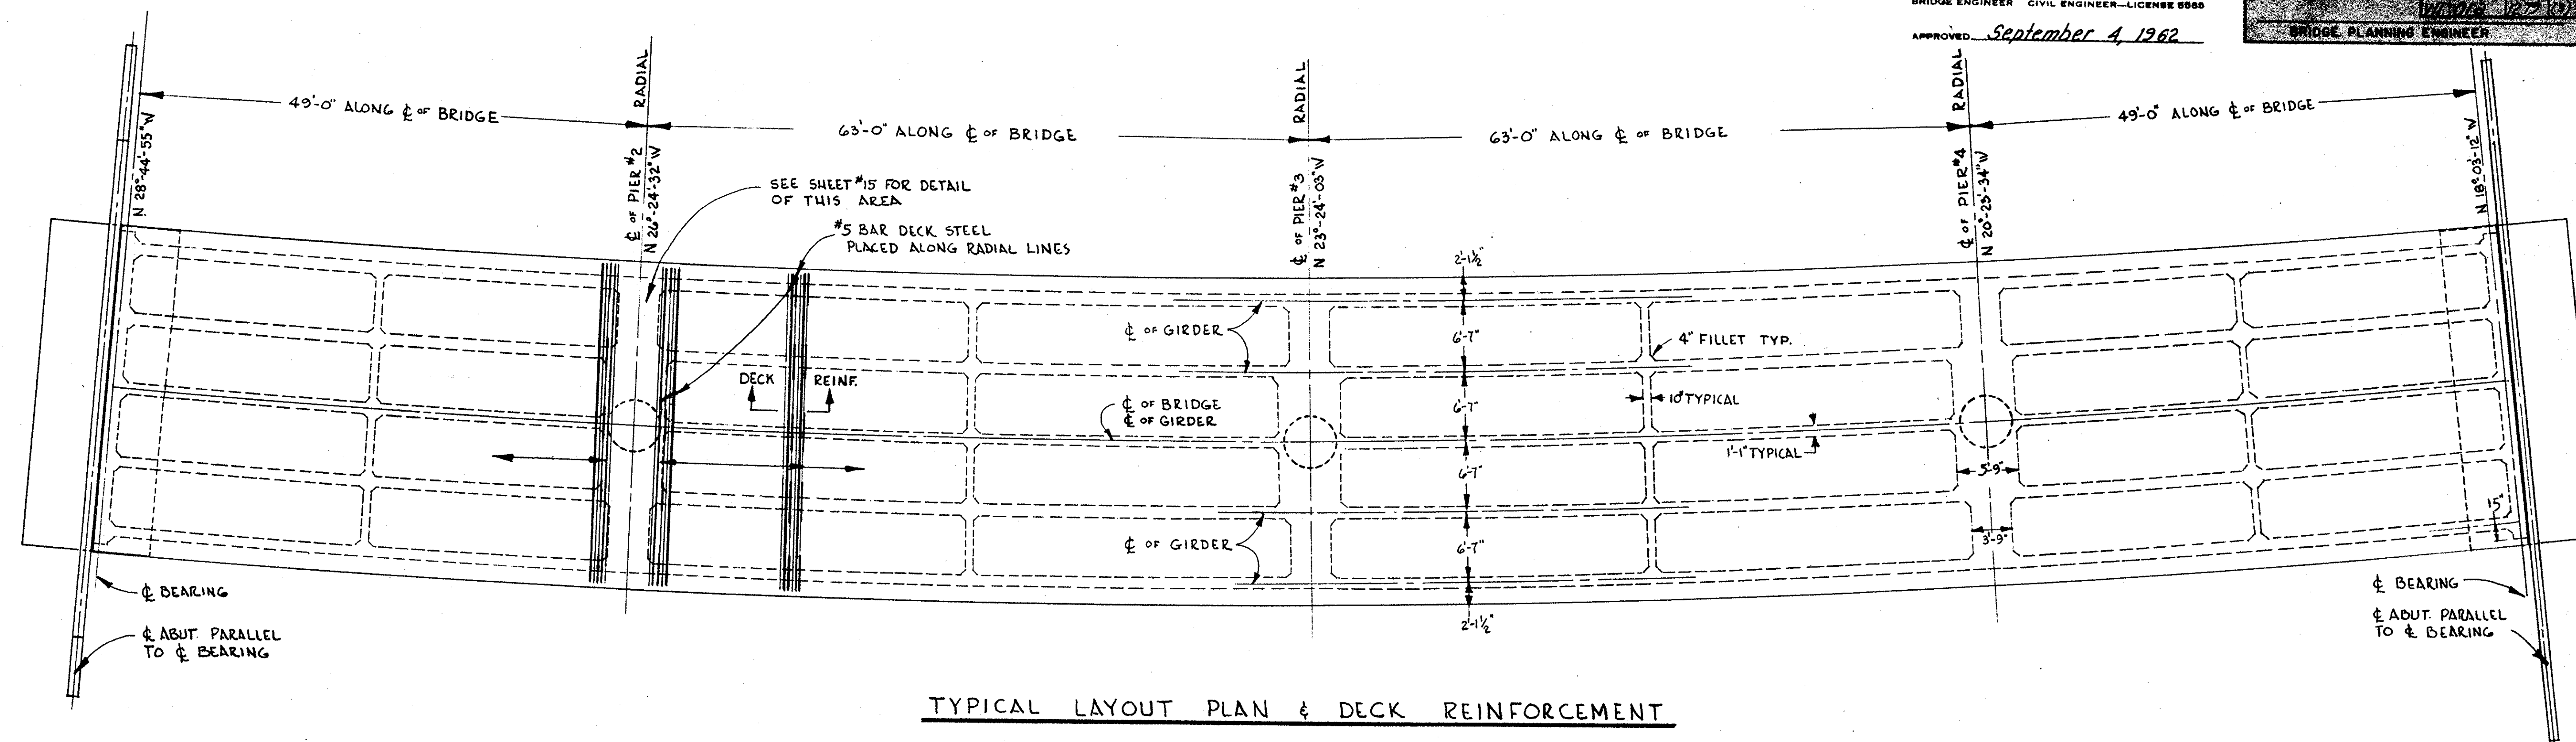

TYPICAL LAYOUT PLAN & DECK REINFORCEMENT

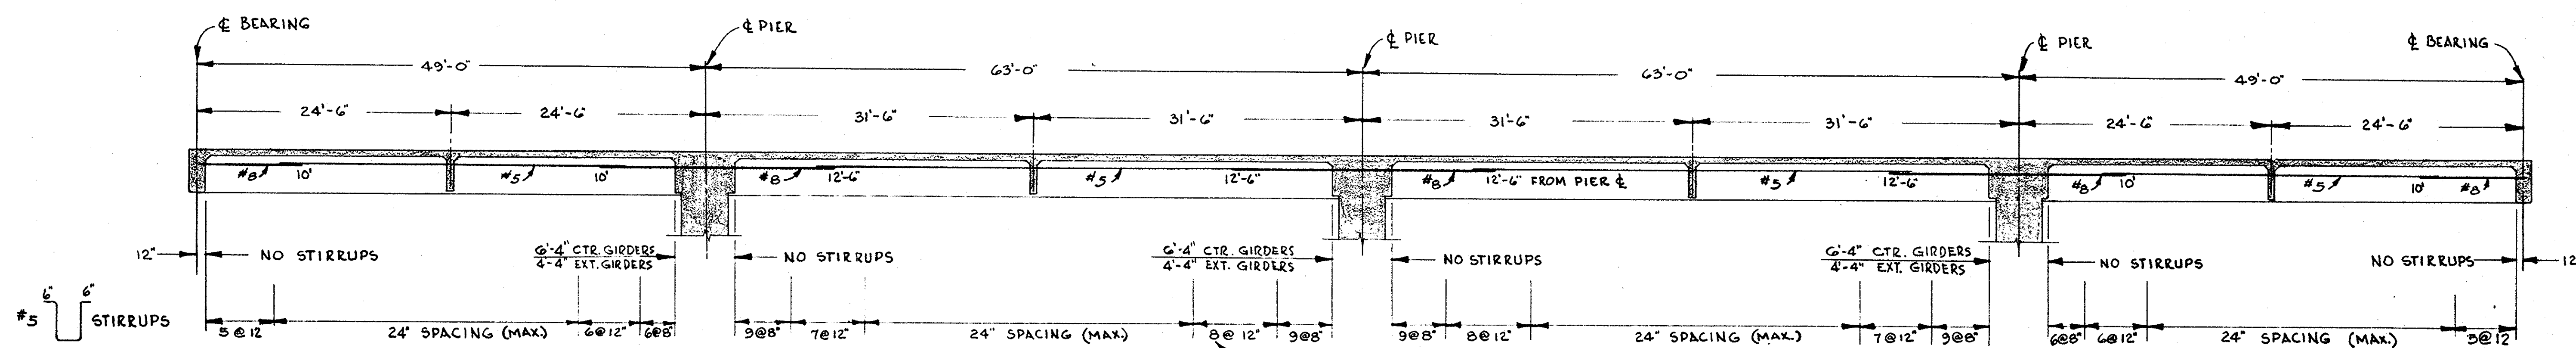

LONGITUDINAL SECTION & STIRRUP SPACING

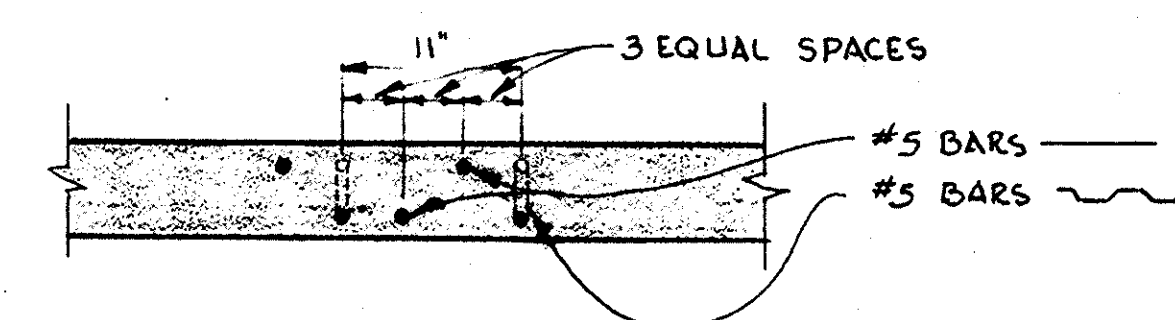

DECK REINFORCEMENT
SCALE 1" = 1'-0"

AS BUILT

CONTRACT NO. 63-724C3-P
RESIDENT ENGR. D.E. Bourgeois
DATE 6/21/63

Structural Details
Checked By H. H. H. H.
Reviewed H. H. H. H.
Approval Recommended

C-55C38-6
ORANGE COUNTY HIGHWAY DEPARTMENT
SANTIAGO CANYON
BRIDGE SC-9
SUPERSTRUCTURE
LAYOUT
SCALE 1/8" = 1'-0"
SHEET 19 OF 29

BRIDGE 55C-38