

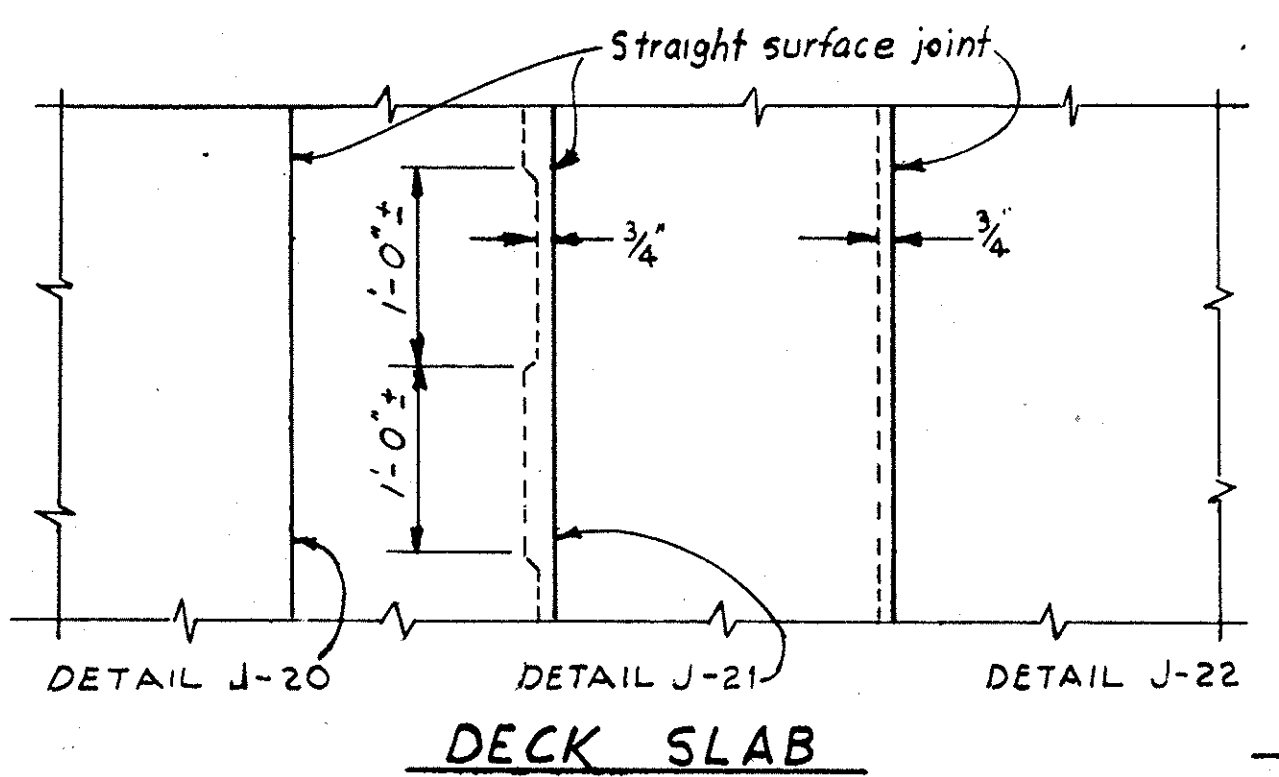
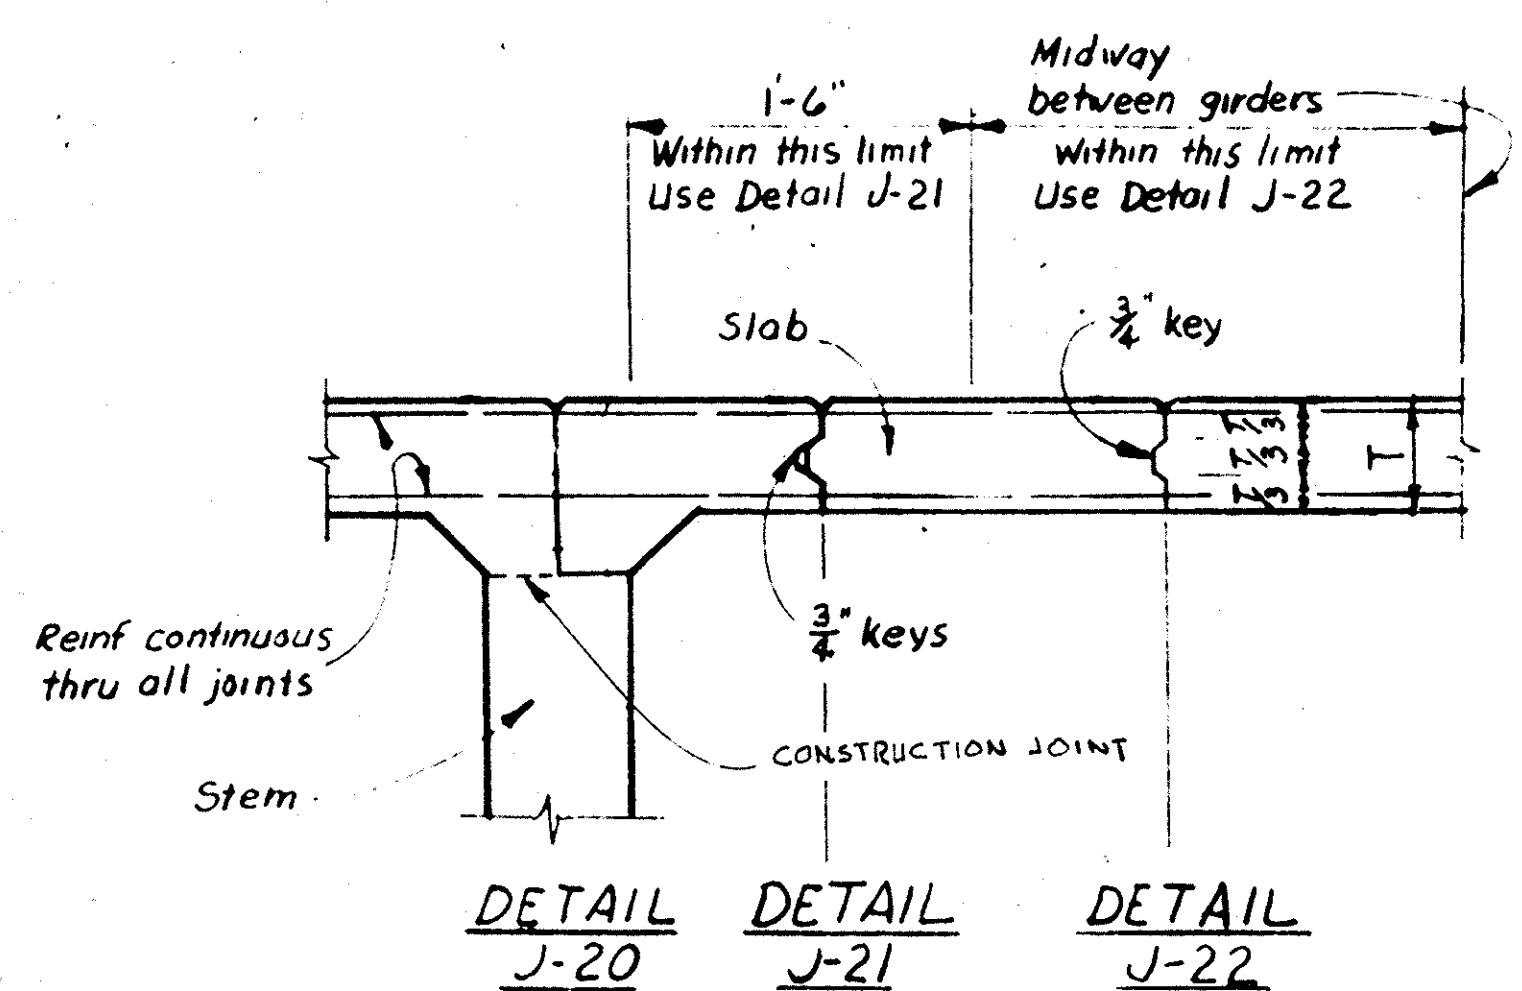
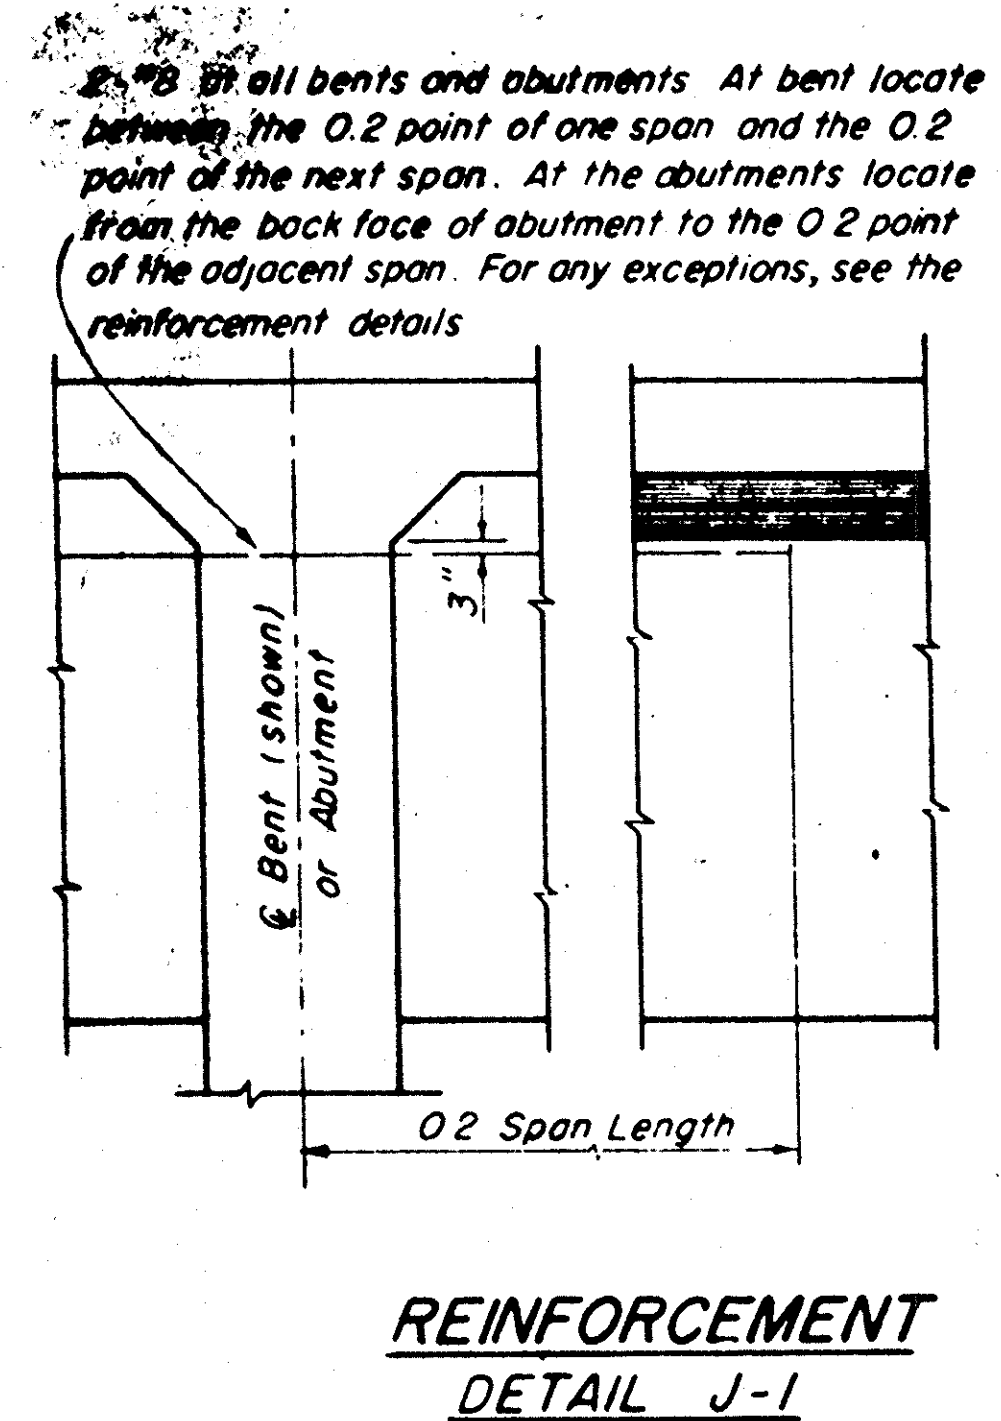
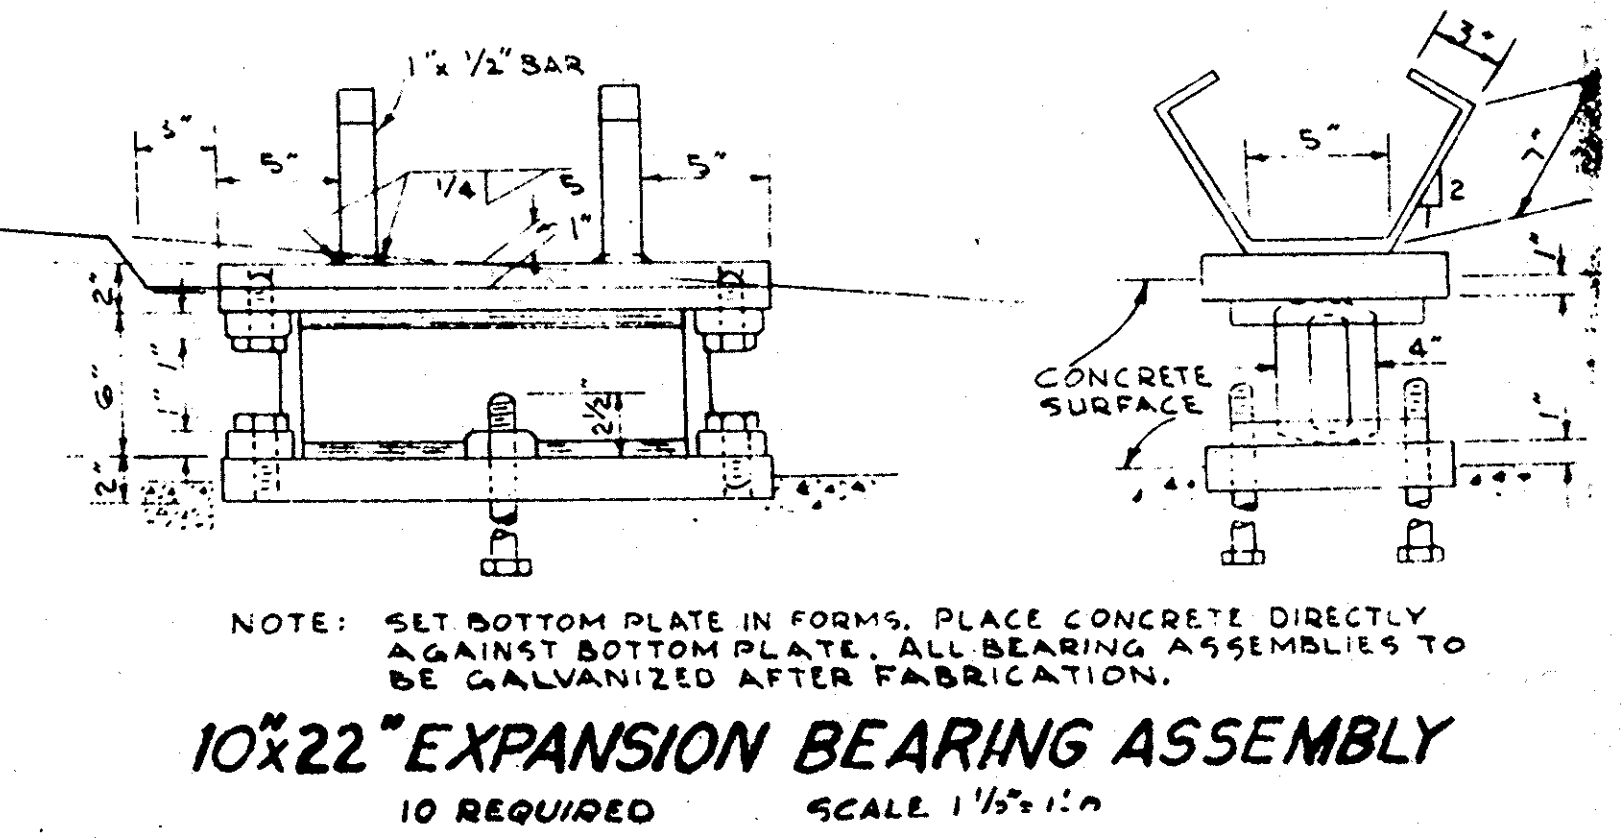
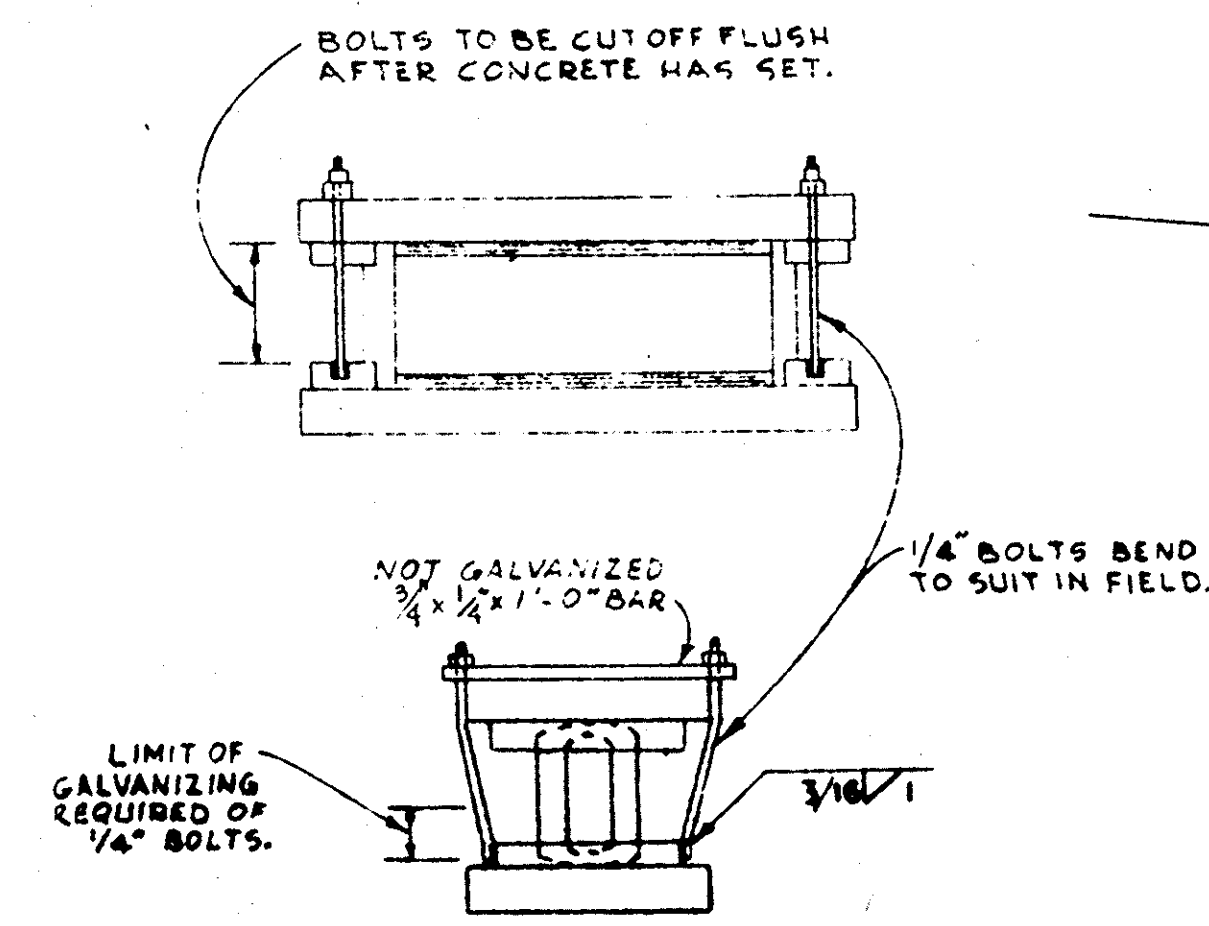
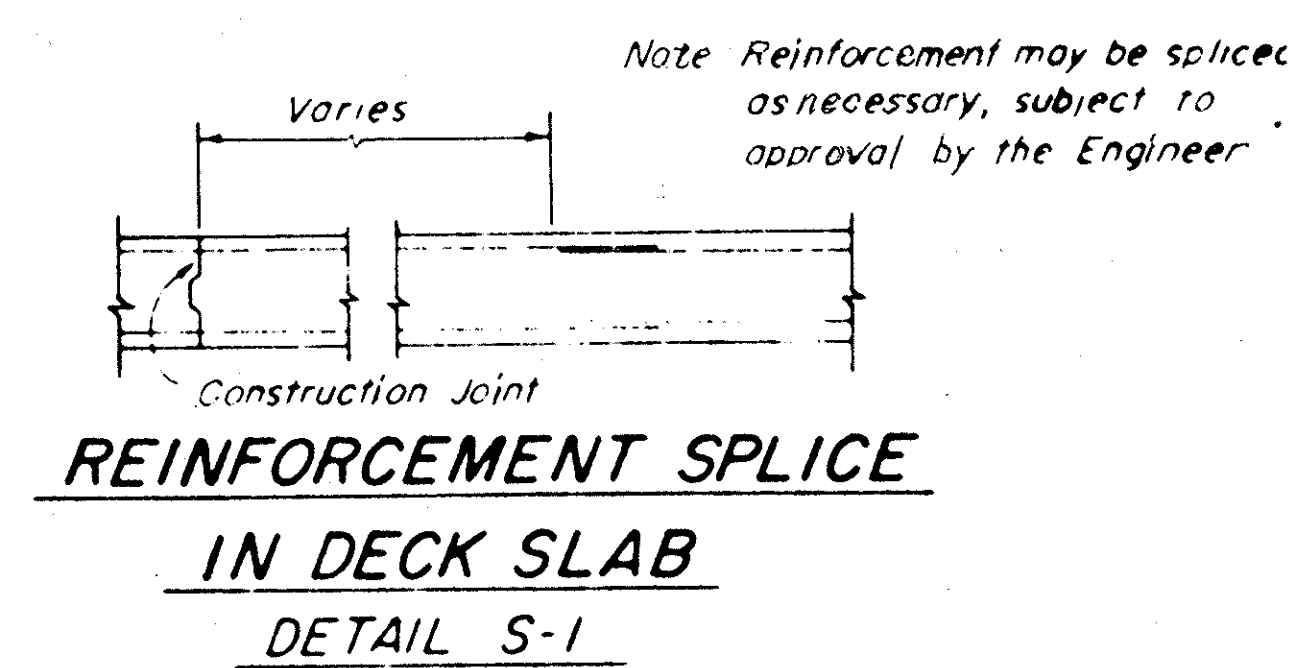
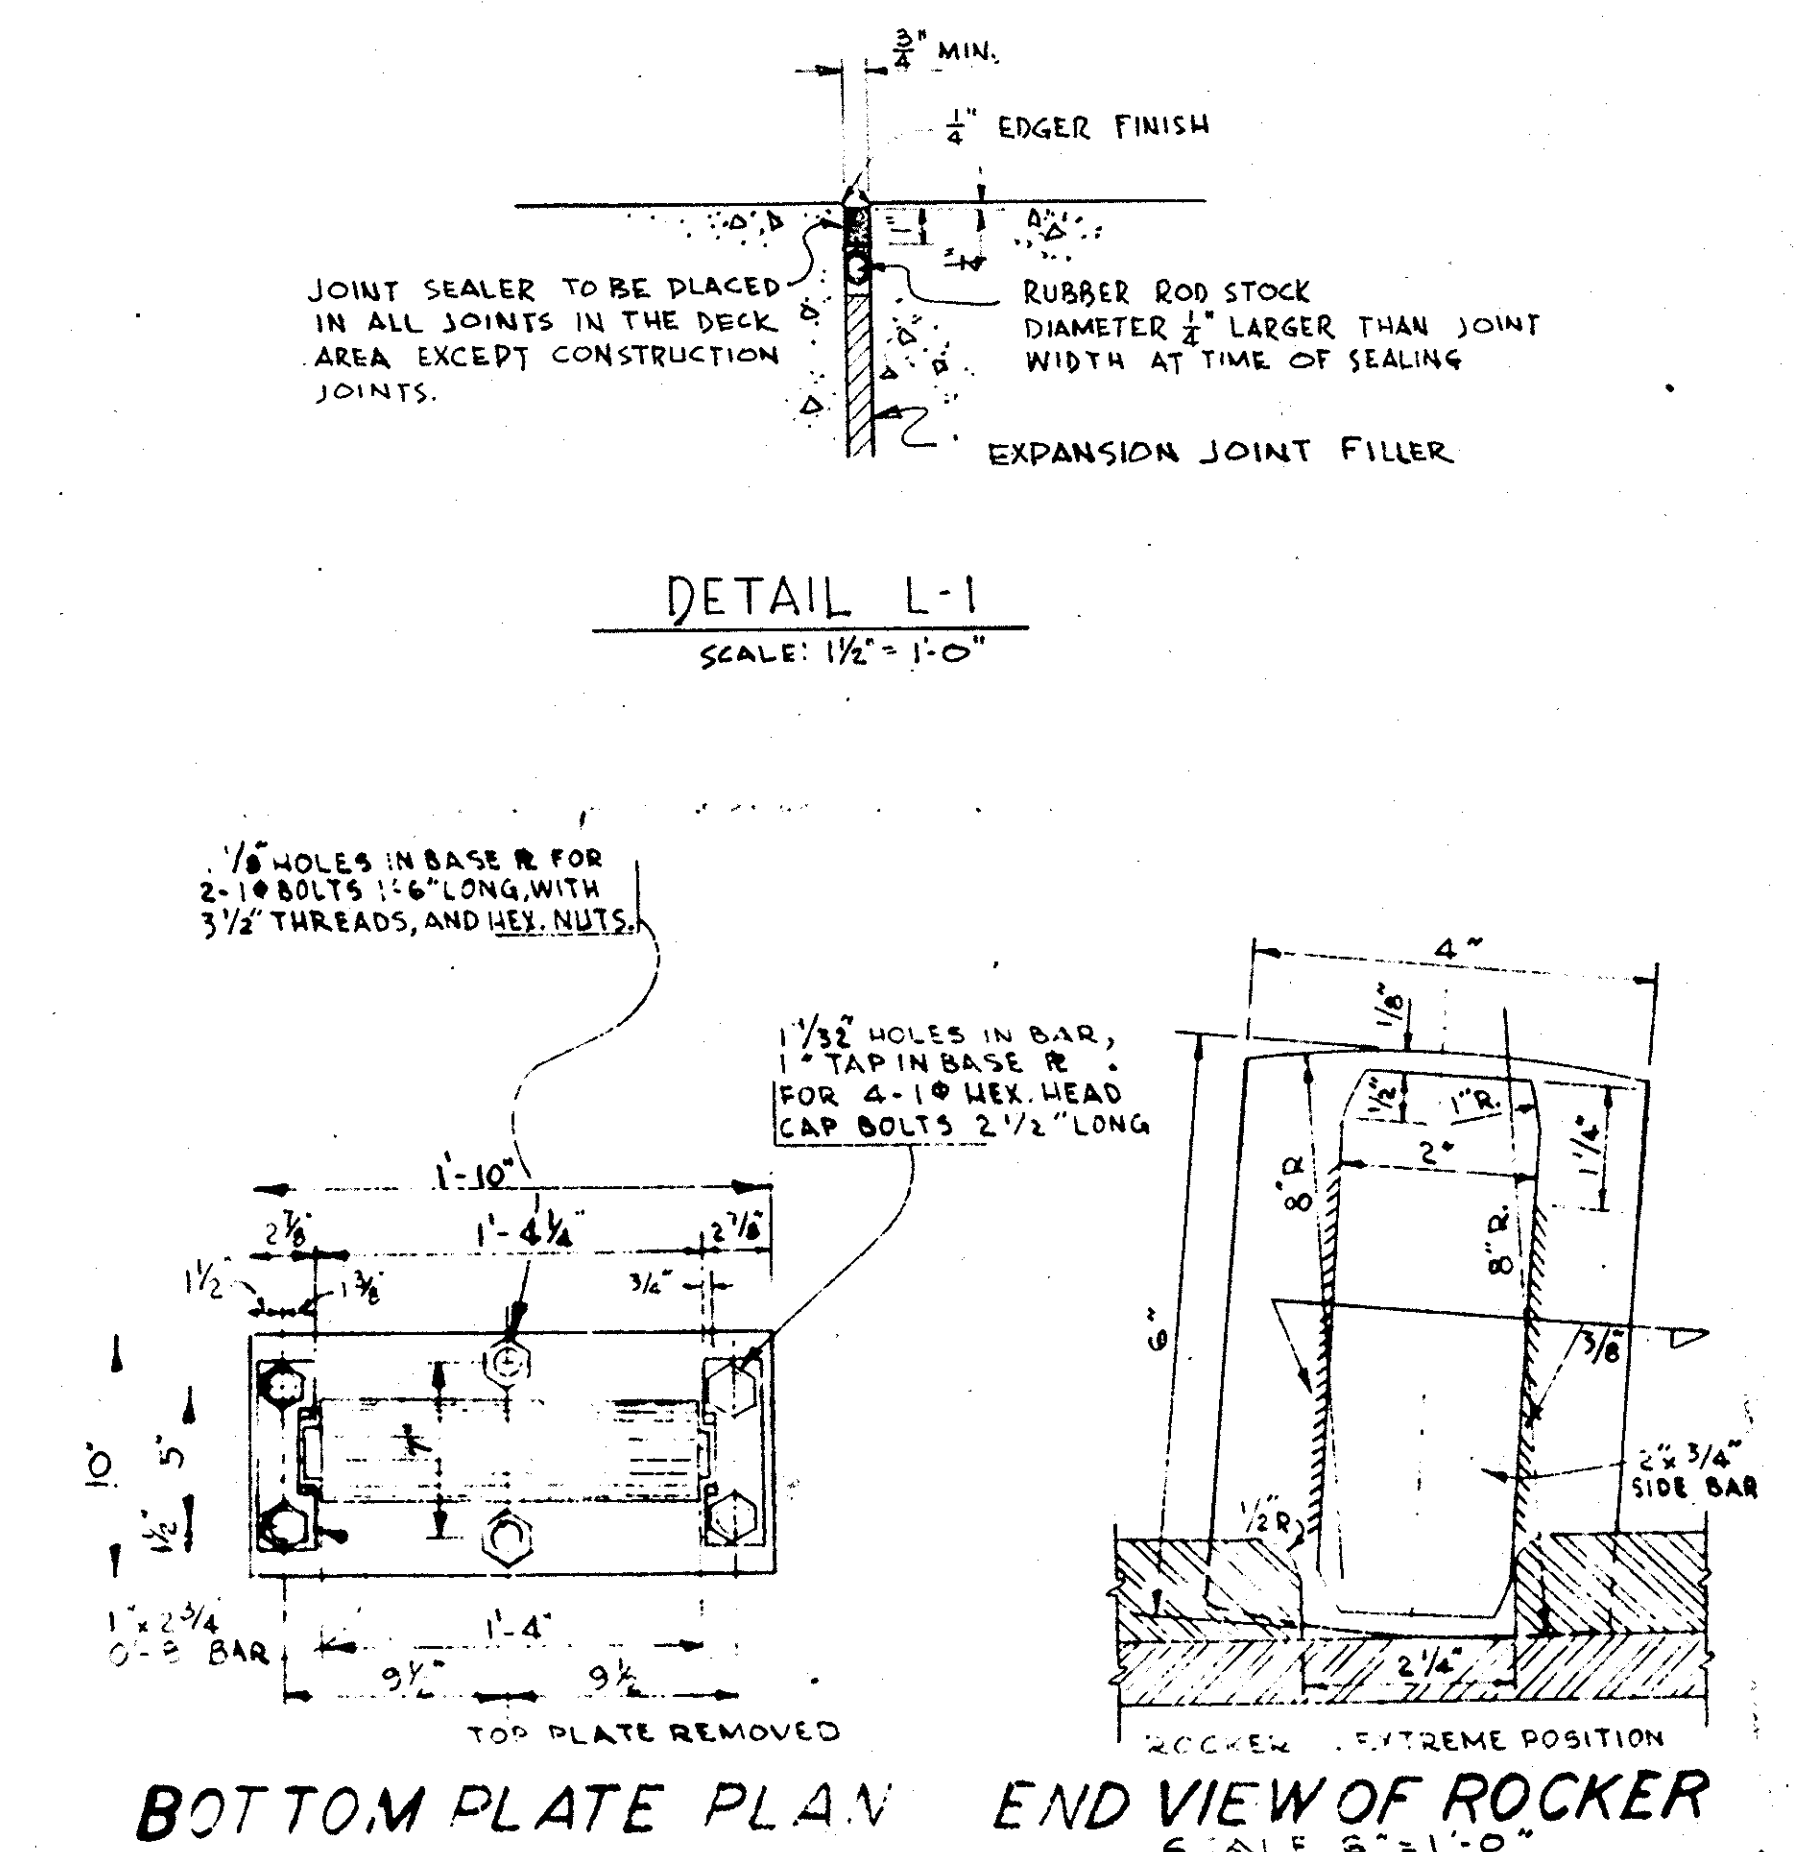


Blum
 BRIDGE ENGINEER CIVIL ENGINEER—LICENSE 8888
 APPROVED September 4, 1962

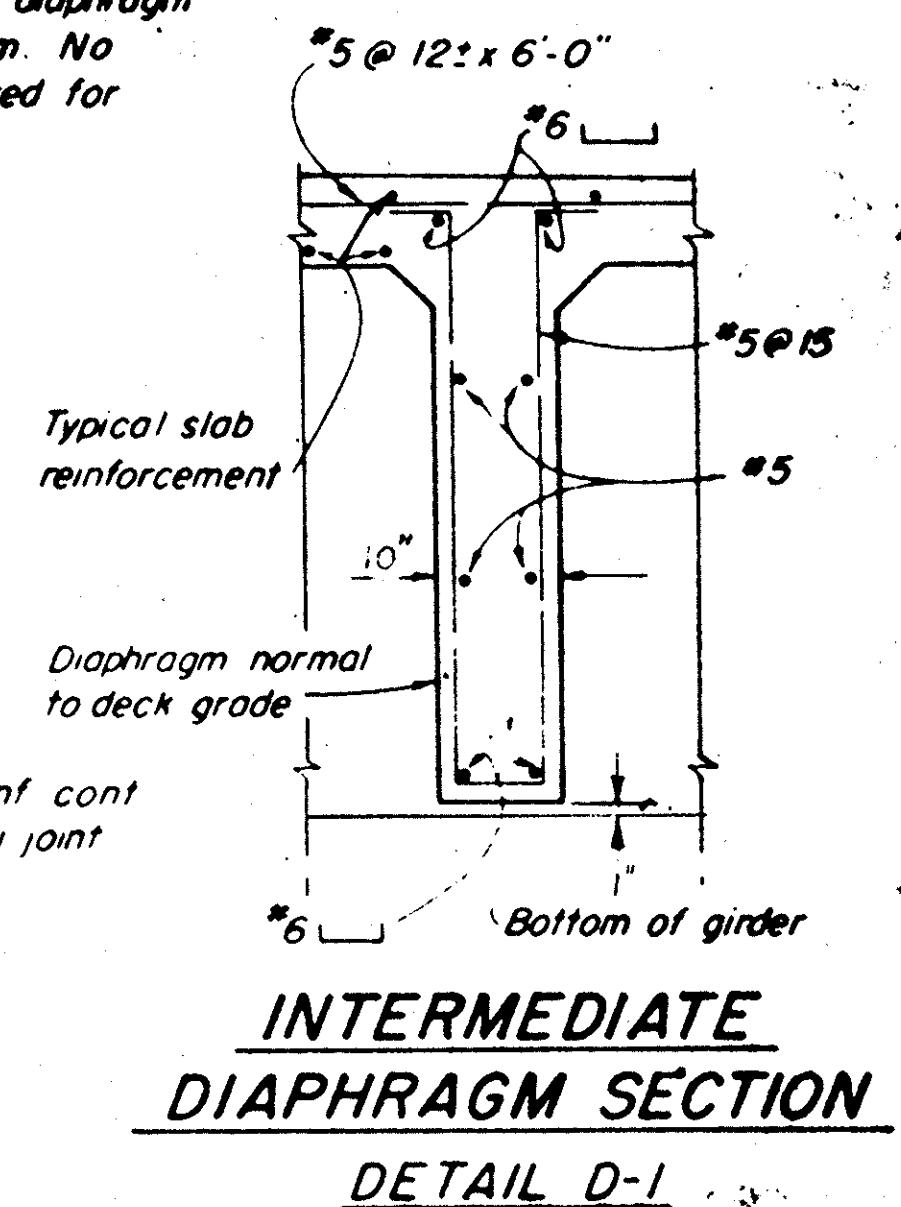

Note: Longitudinal construction joints in slab, if required, are to be located at edge of traffic lanes except as approved by the Engineer.

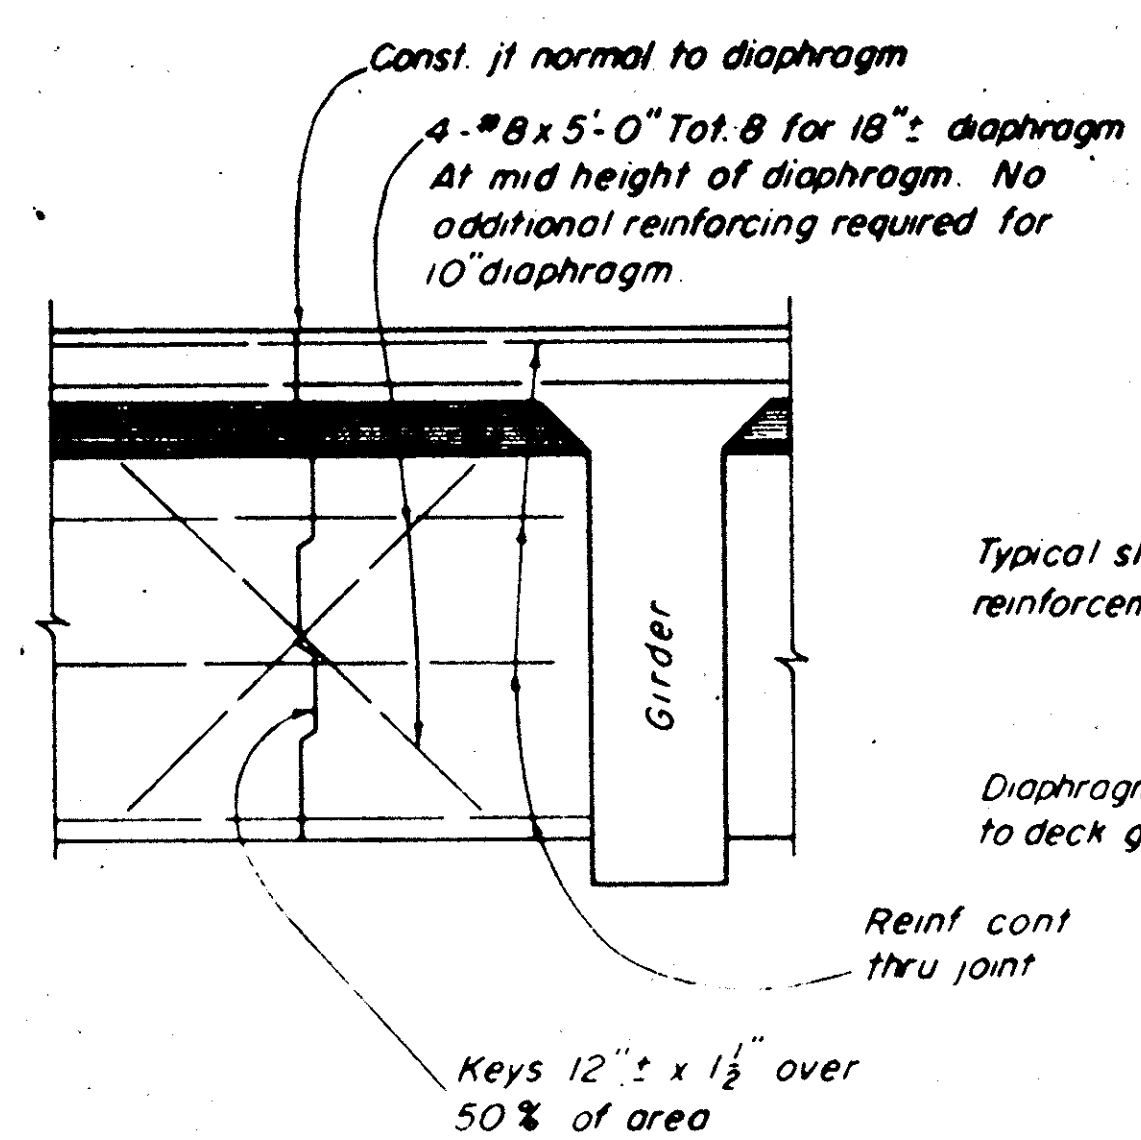

AS BUILT
 CONTRACT NO. 63-7V24C3-P
 RESIDENT ENGR. D.E. Bourgeois
 DATE 6/21/63

C-55C38-8
 ORANGE COUNTY HIGHWAY DEPARTMENT
 SANTIAGO CANYON
 BRIDGE SC-9
 MISCELLANEOUS
 DETAILS
 SCALE: As Noted

Structural Details
 Checked By *[Signature]*
 Reviewed *[Signature]*
 Approval Recommended