

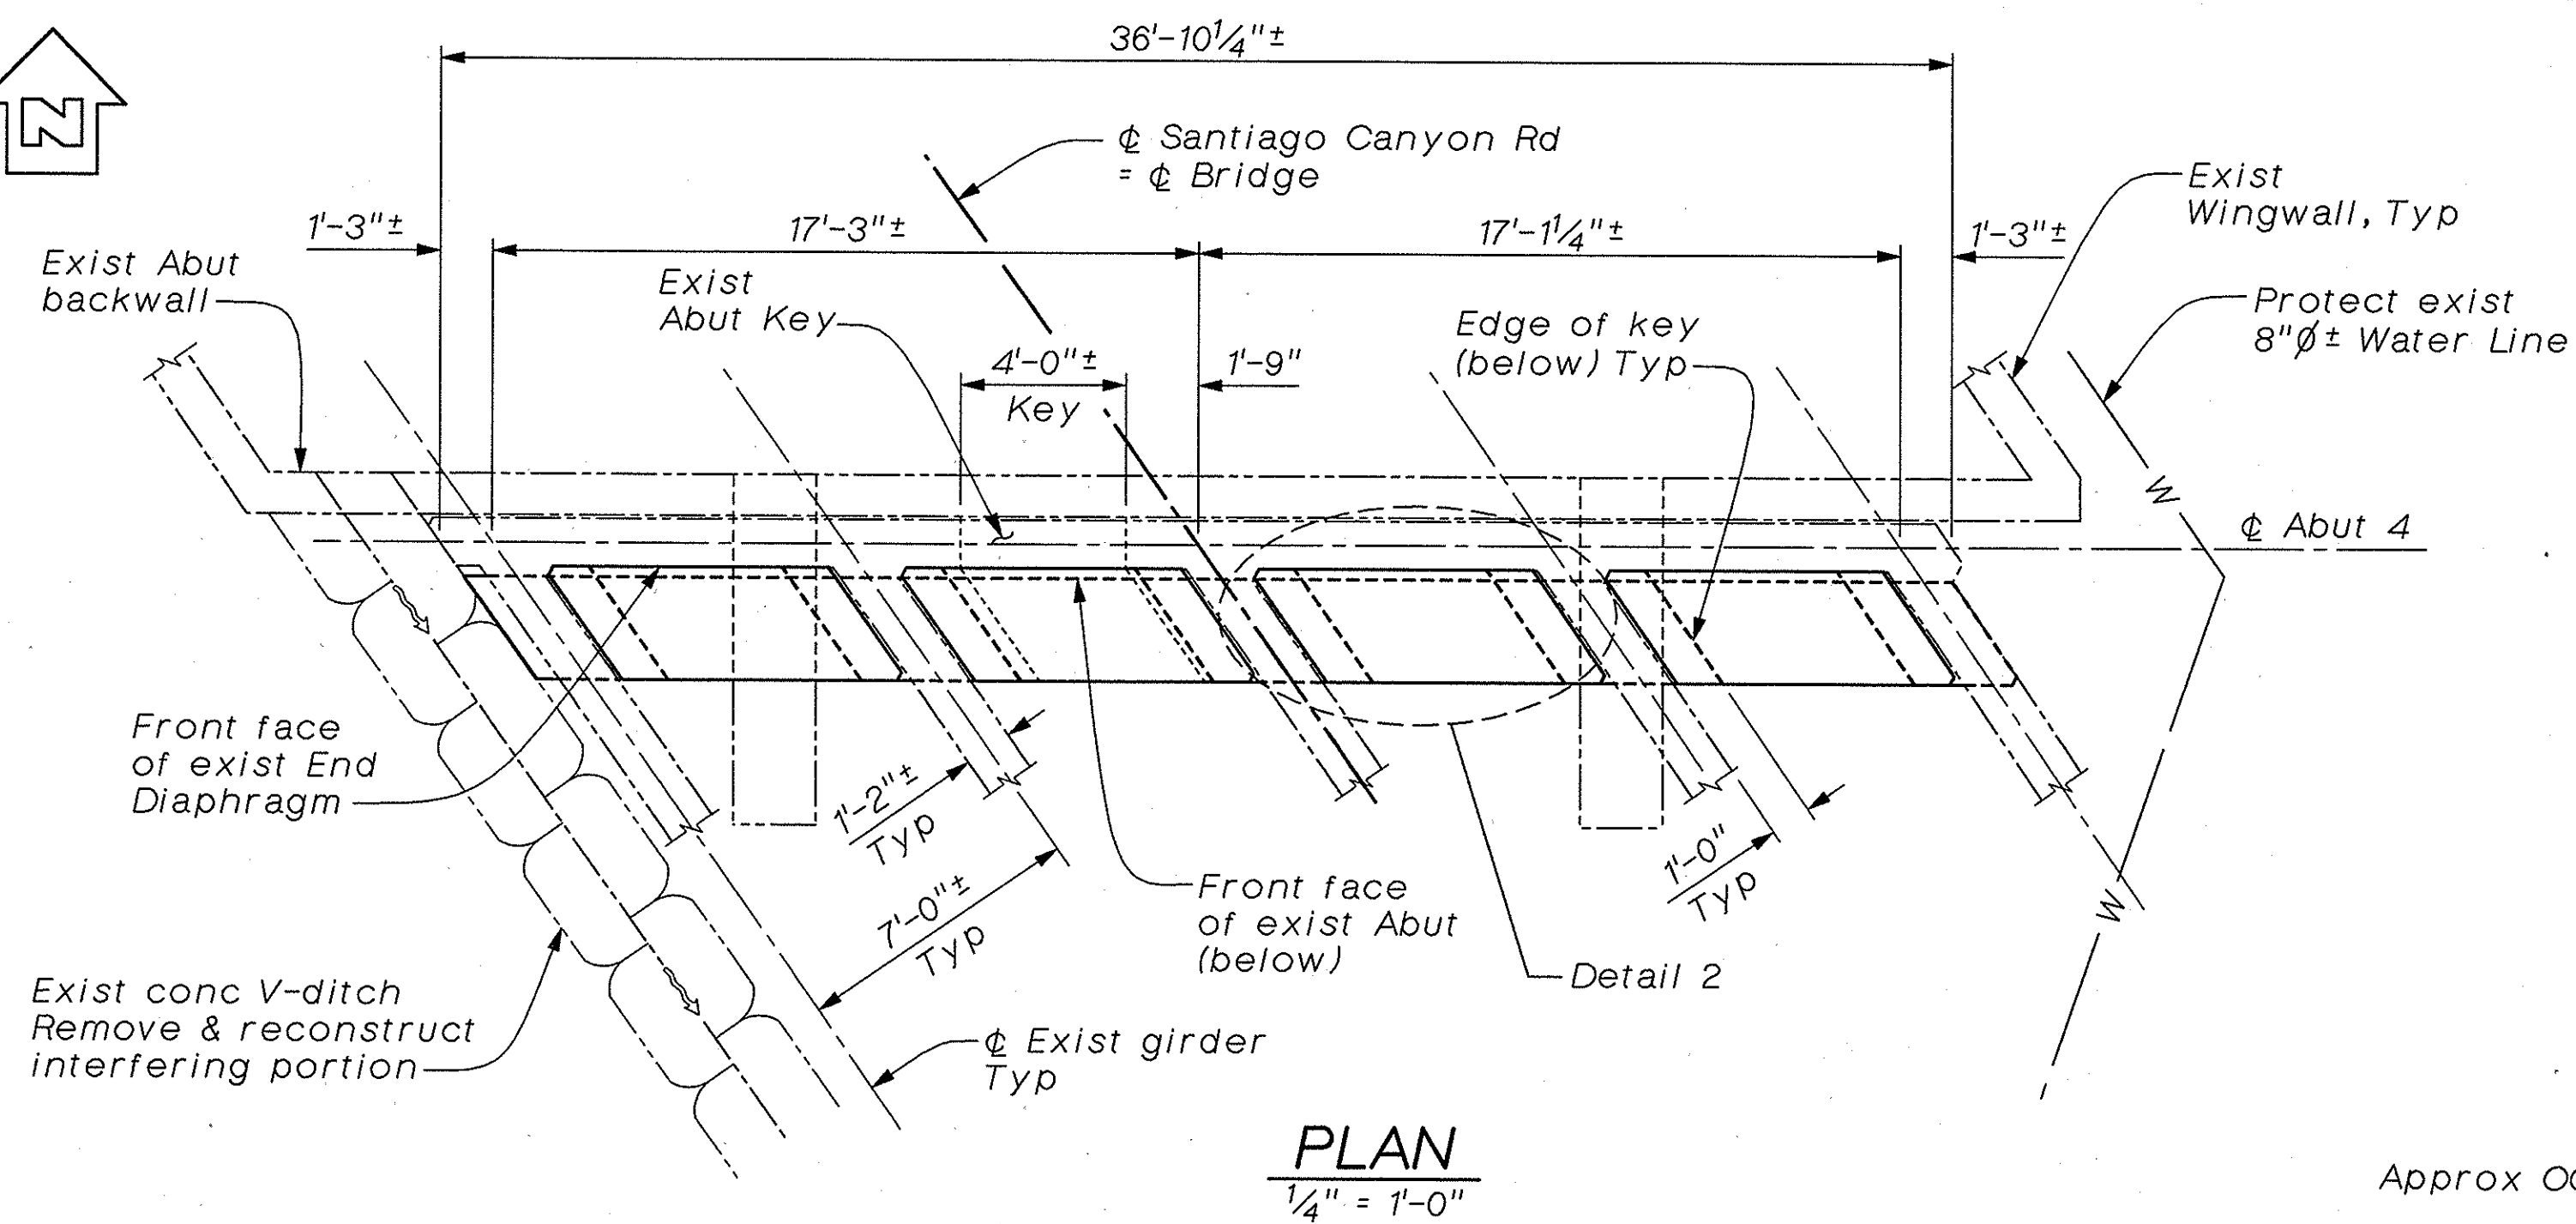


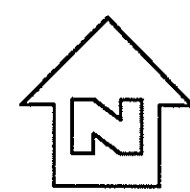

PLAN
1/4" = 1'-0"

Approx OG = FG


* Bottom of conc Seat
Extension to match
exist construction joint

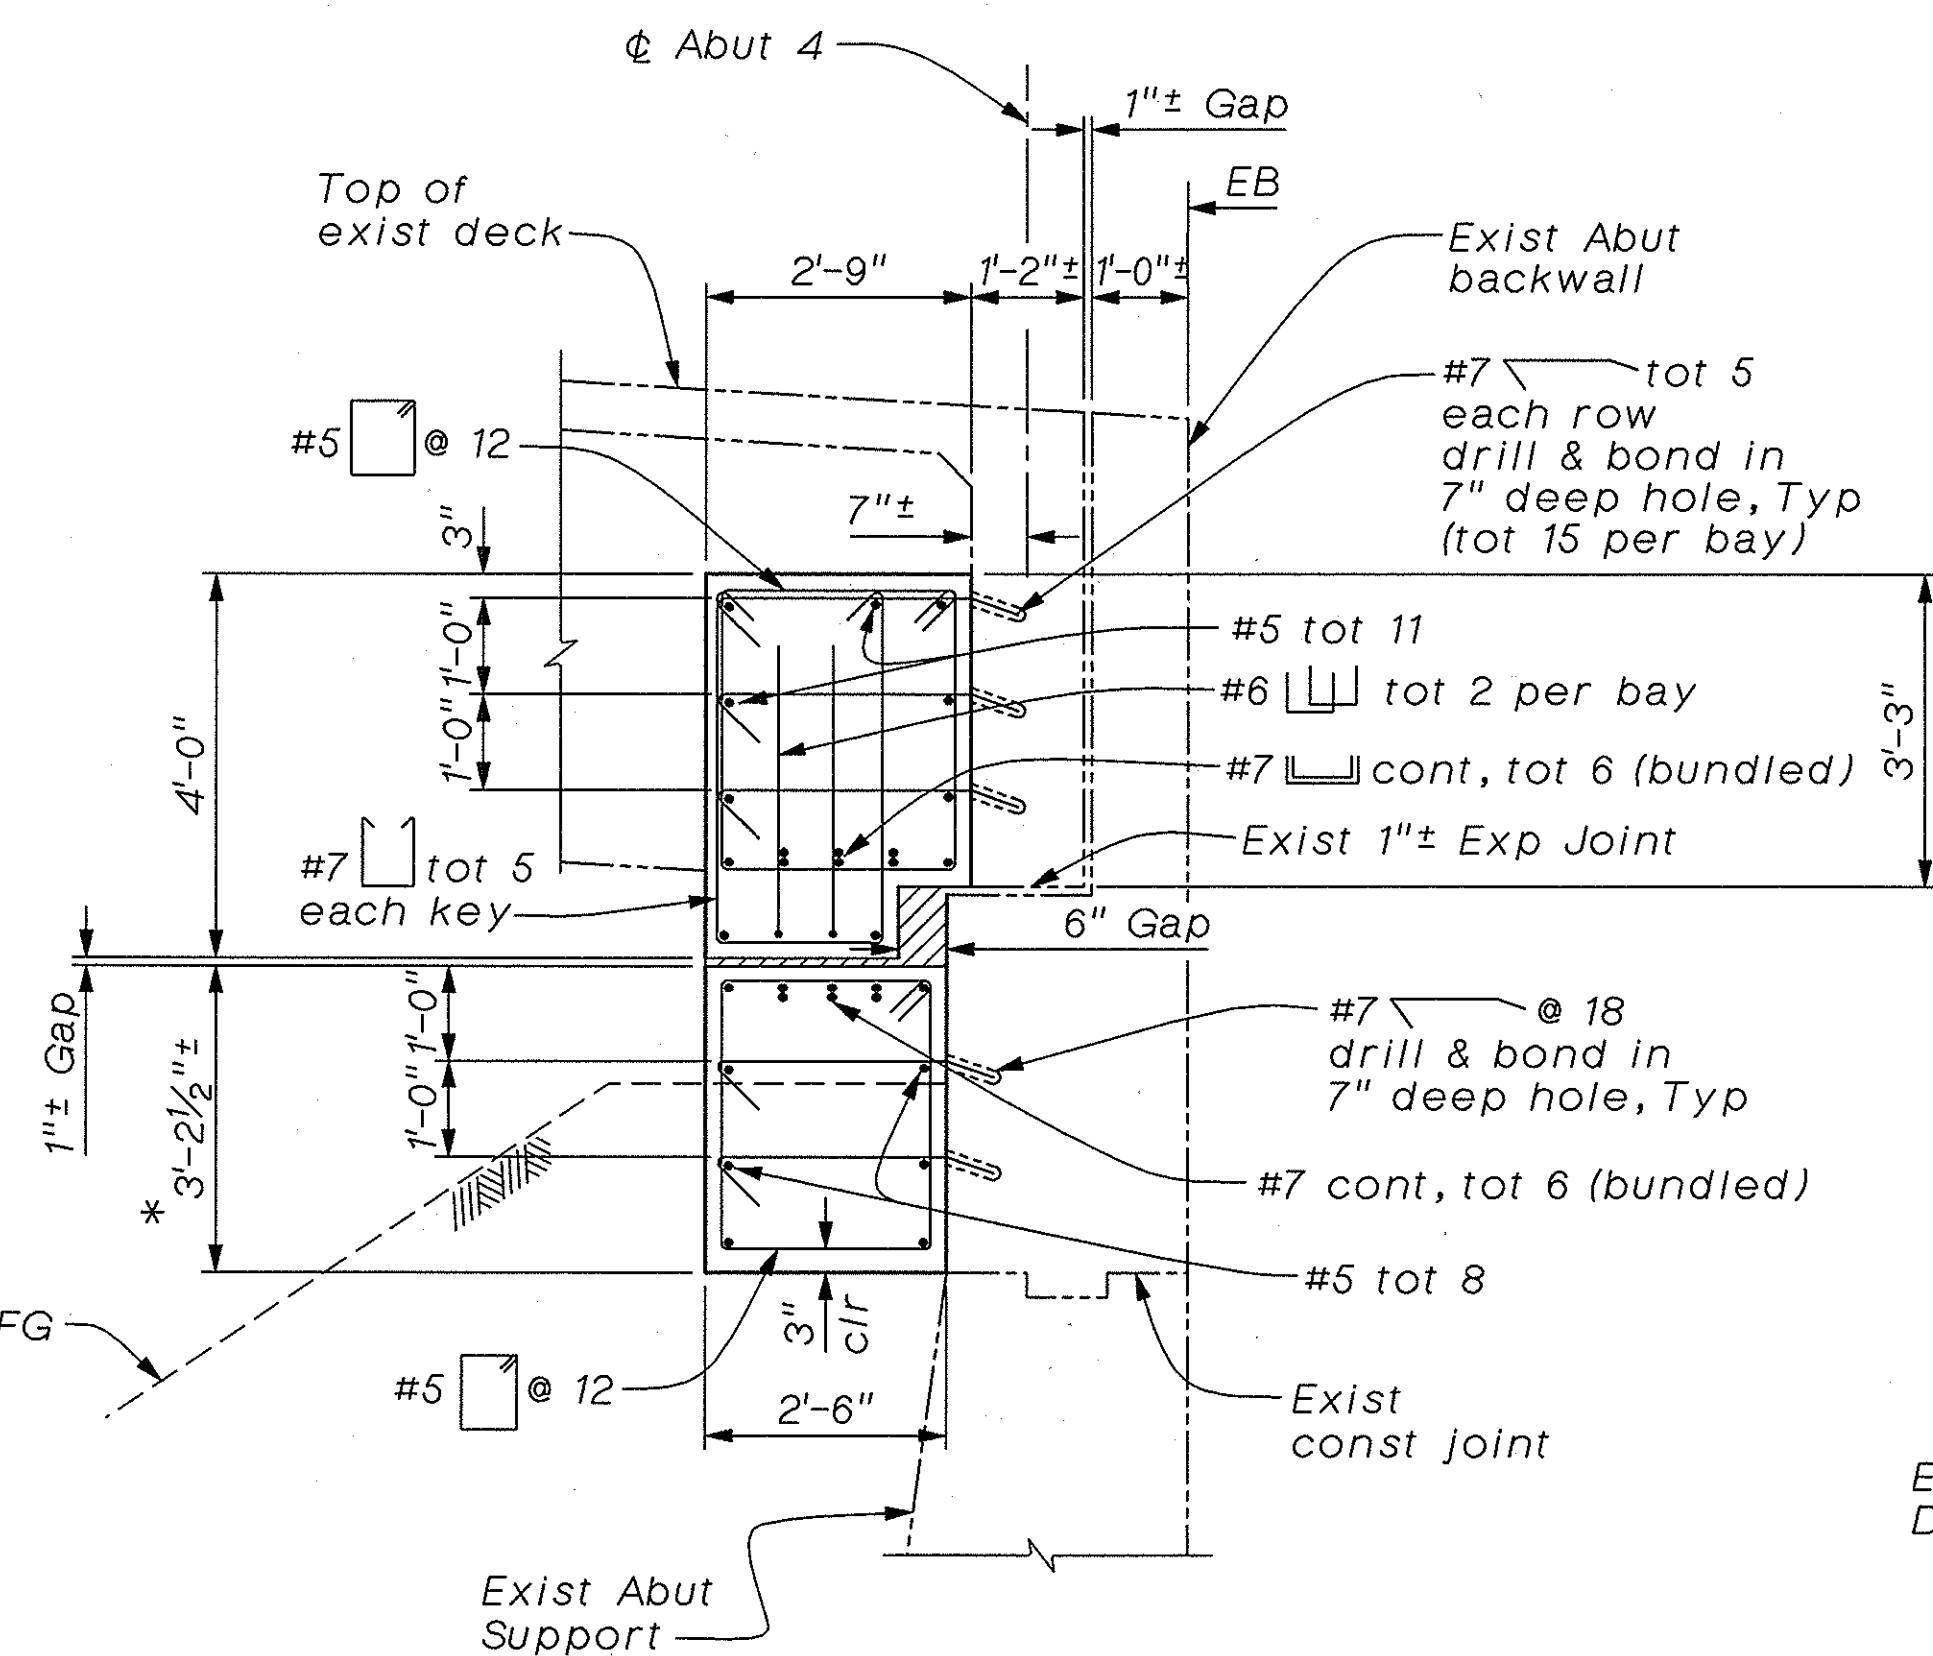

SECTION D-D
1/2" = 1'-0"


LEGEND

- Expanded Polystyrene
- Bundled bars

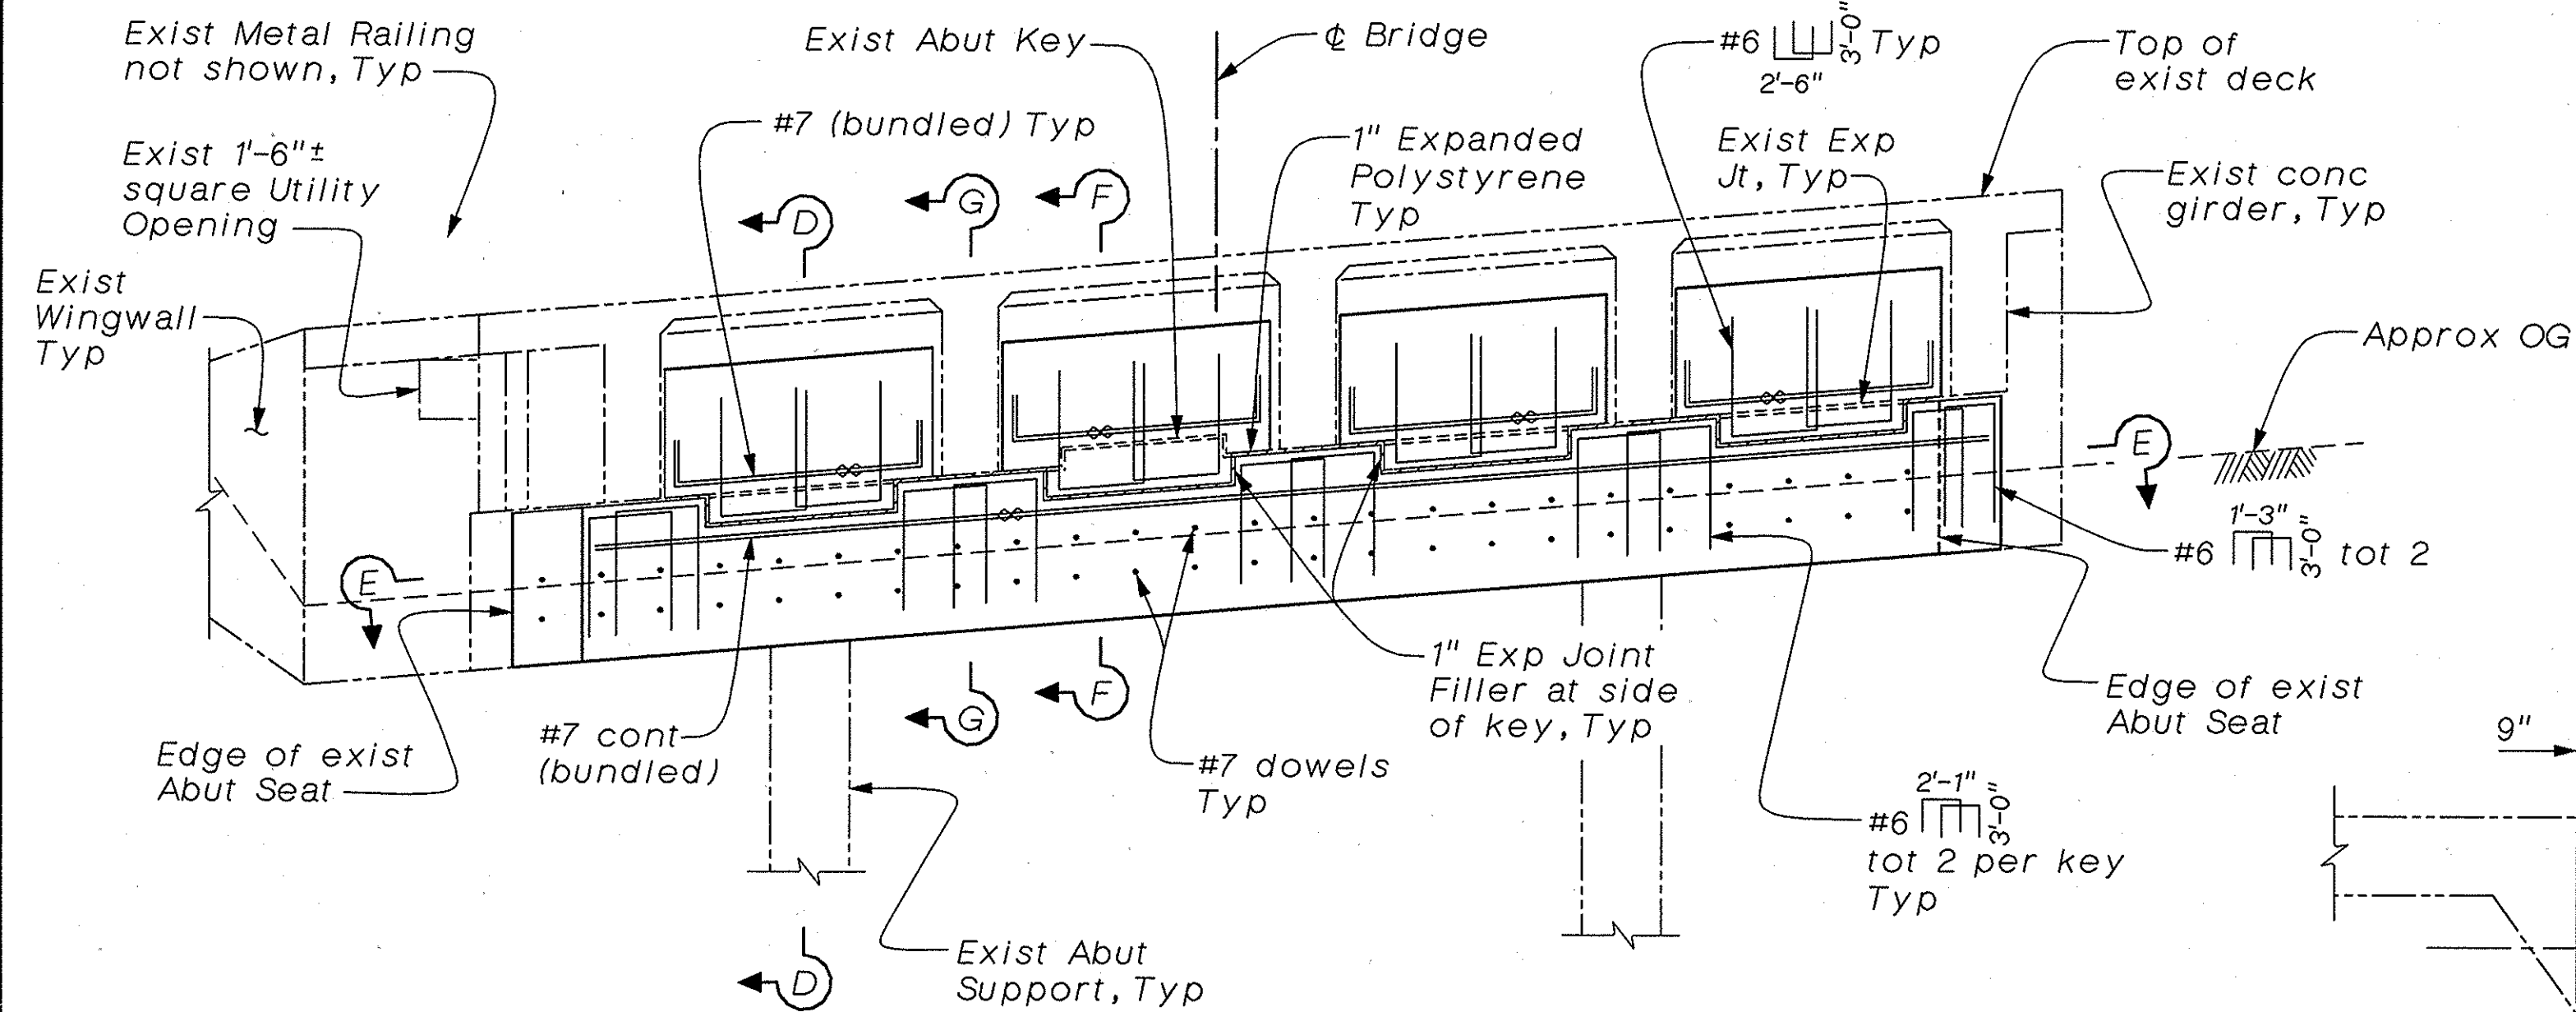

ELEVATION
1/4" = 1'-0"

Note:
The Contractor shall verify all
controlling field dimensions before
ordering or fabricating any material.

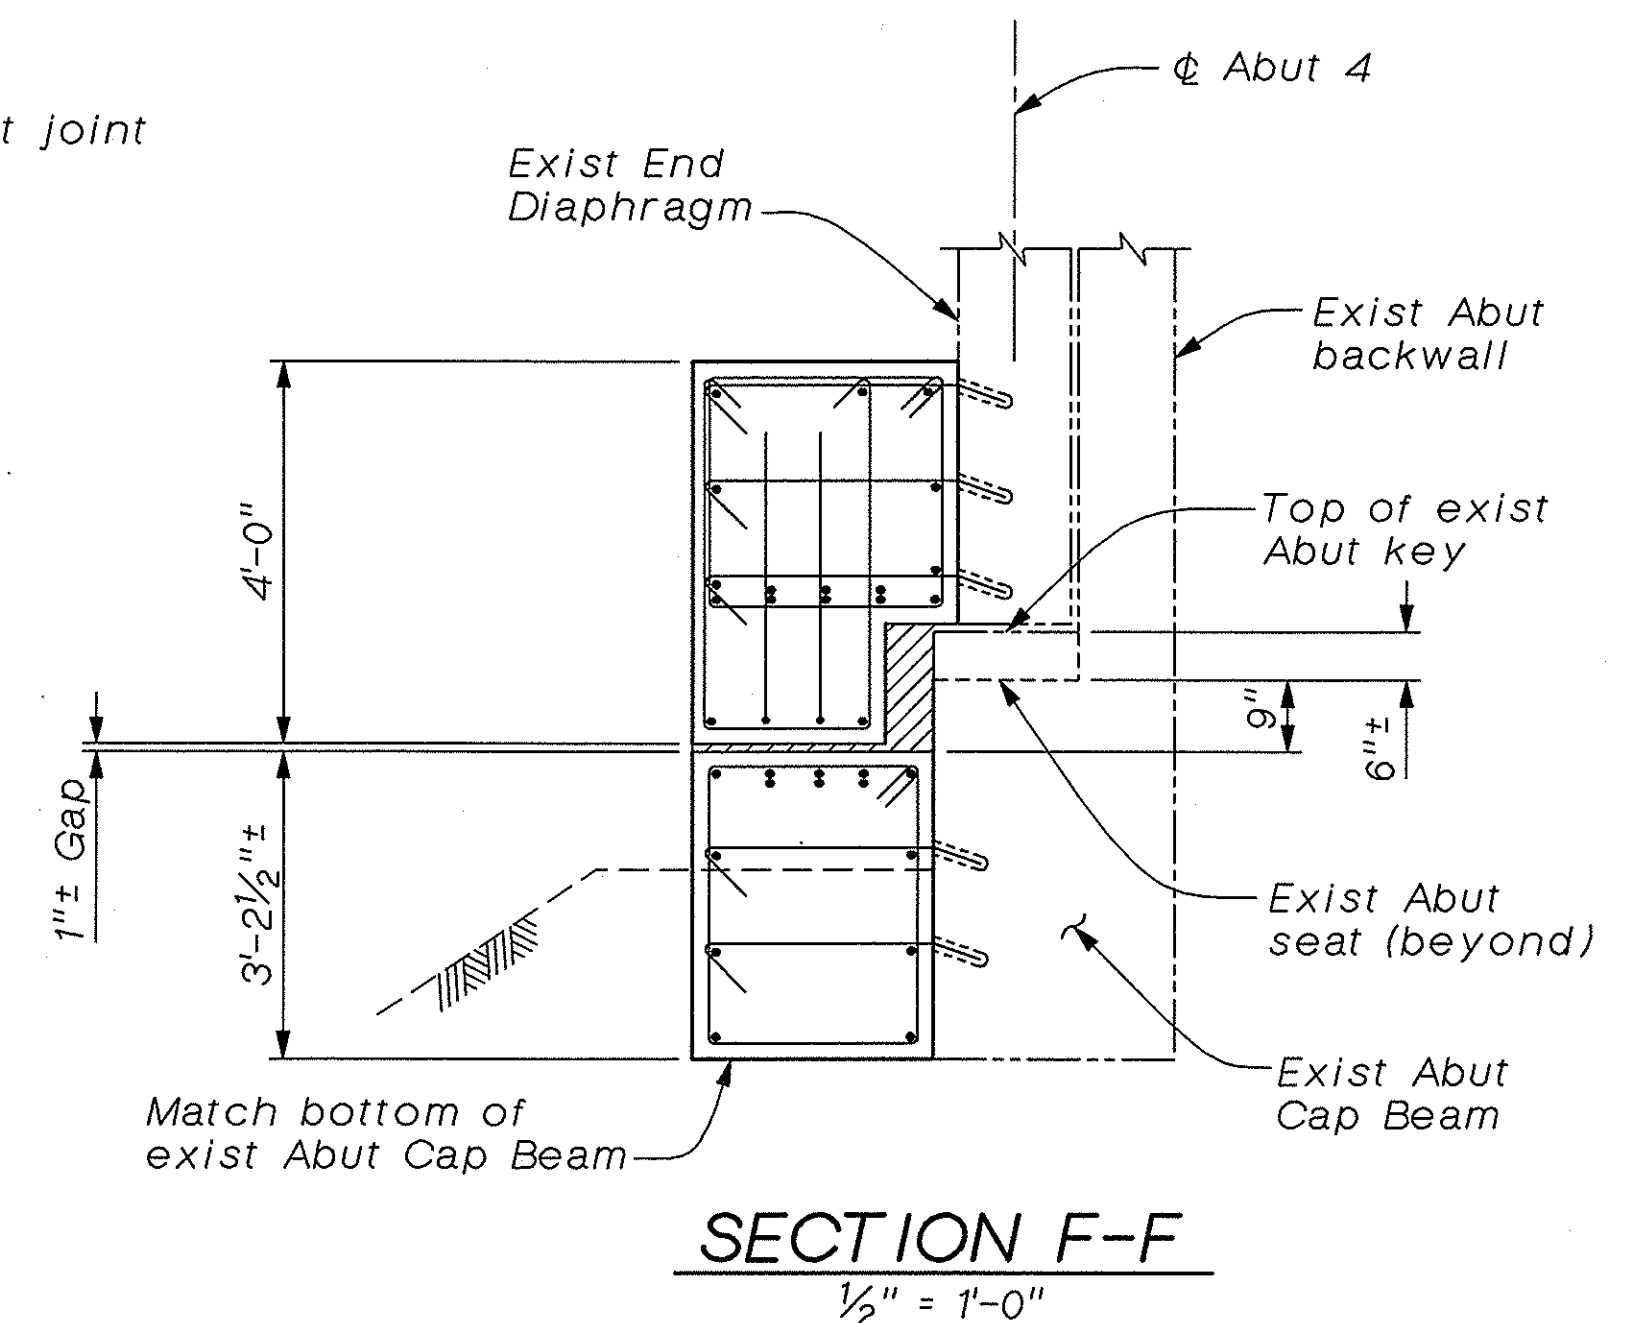

SECTION F-F
1/2" = 1'-0"

Note:
For information not
shown, see "Section D-D"

AS BUILT

CORRECTIONS BY G. ZAUN / RWH
CONTRACT NO. 59Y021
DATE 2-8-02 / 10-24-02

NO AS BUILT CHANGES

Notes:
1. For "Detail 2" and "Section G-G"
details, see "Abutment Retrofit Details"
sheet.

SHAWN SUN *Shawn Sun*
DESIGN OVERSIGHT
12/29/97
SIGN OFF DATE

DESIGN	BY M. ZAHEDI/A. HOU	CHECKED S. XIE/A. TRUONG
DETAILS	BY R. ANDRASEK	CHECKED J. LU
QUANTITIES	BY H. LAM	CHECKED M. ZAHEDI

PREPARED FOR THE
COUNTY OF
ORANGE

G.J. NASCIMENTO
PROJECT ENGINEER

BRIDGE NO.
55C-0049
POST MILE

EARTHQUAKE RETROFIT
SANTIAGO CREEK BRIDGE
ABUTMENT 4 RETROFIT DETAILS

ORIGINAL SCALE IN INCHES
FOR REDUCED PLANS

CU 12 152
EA L02106

DISREGARD PRINTS BEARING
EARLIER REVISION DATES

REVISION DATES (PRELIMINARY STAGE ONLY)
SHEET 3 OF 6