

DIST	COUNTY	ROUTE	POST MILES TOTAL PROJECT	SHEET NO.	TOTAL SHEETS
12					

G.J. Nascimento
REGISTERED CIVIL ENGINEER

PLANS APPROVAL DATE
LIM & NASCIMENTO ENGINEERING
1971 East Fourth Street, Suite 200
Santa Ana, California 92705

PROFESSIONAL ENGINEER


G.J. NASCIMENTO

No. **44871**


Exp. **3/31/98**

CIVIL

STATE OF CALIFORNIA

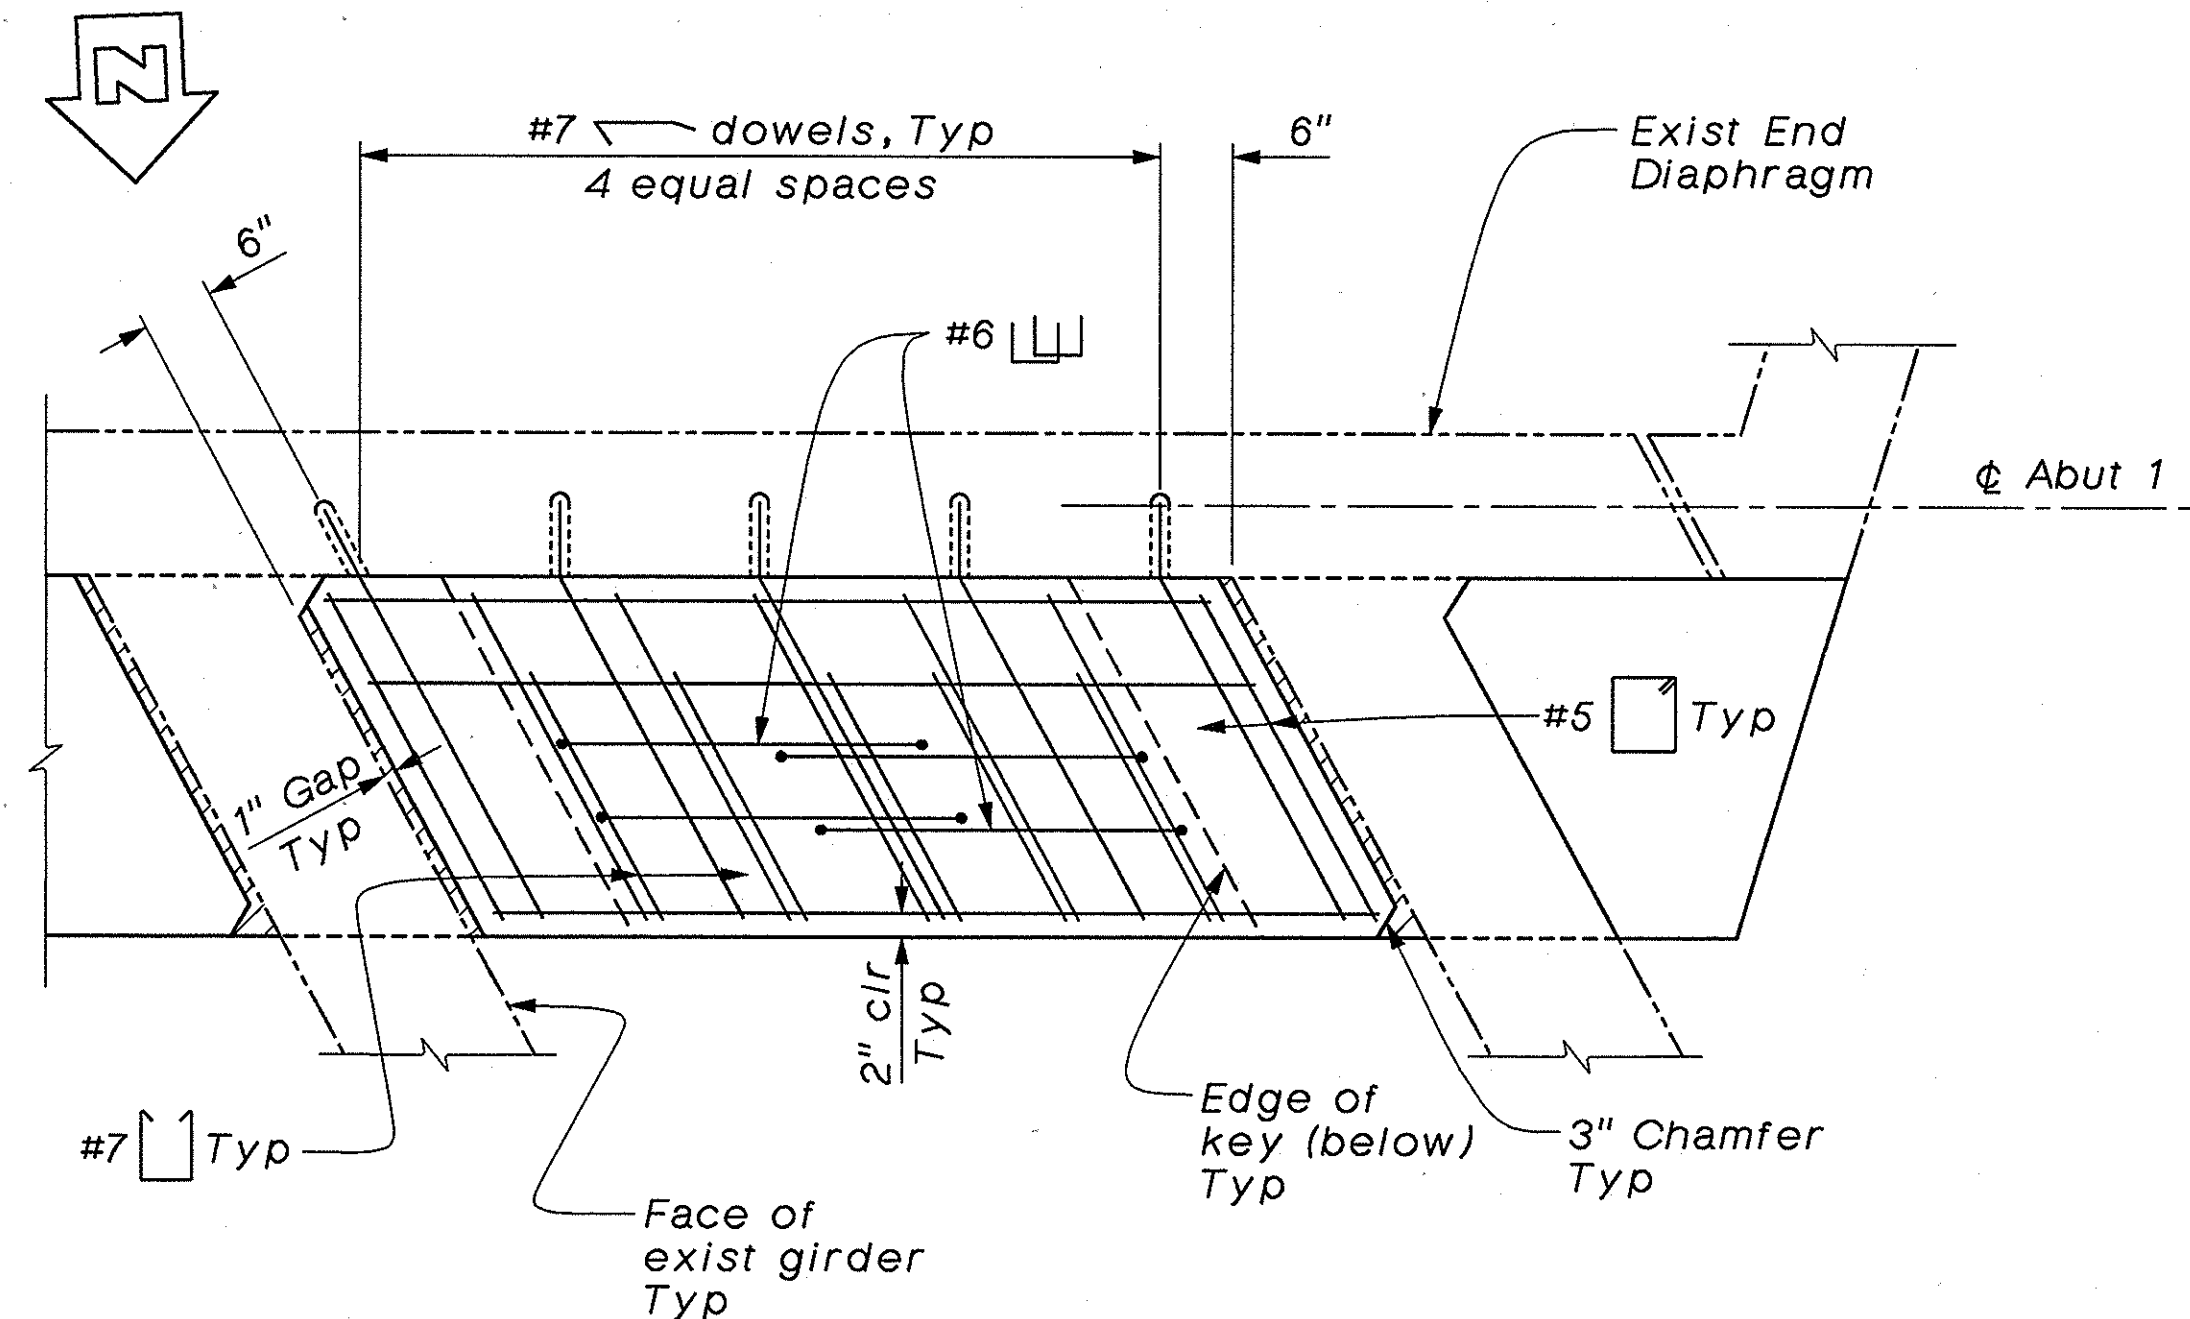

DETAIL 1
3/4" = 1'-0"

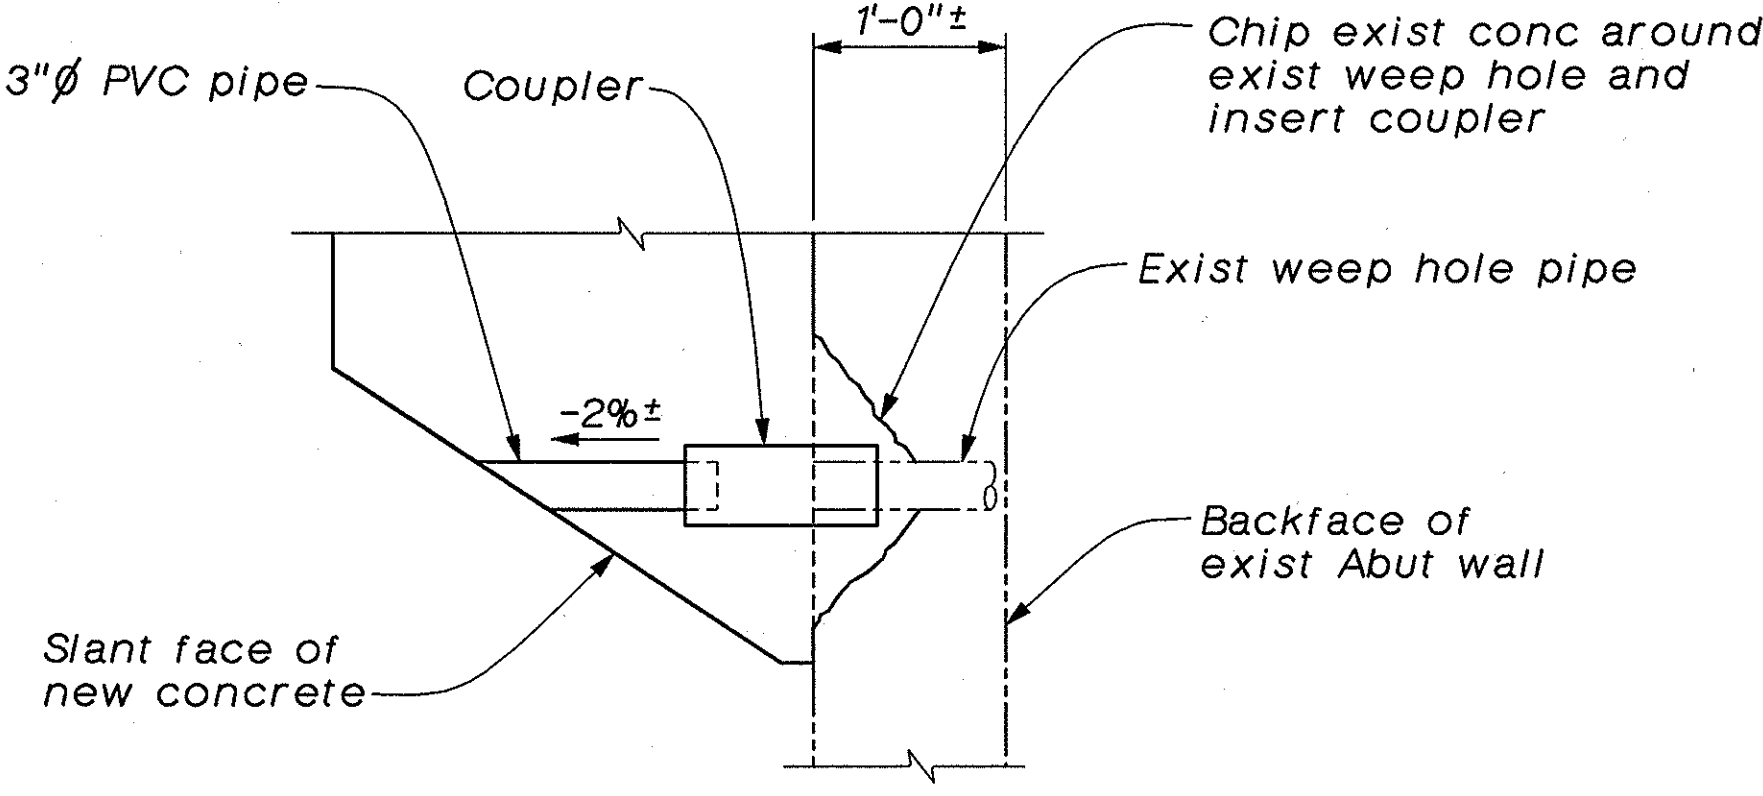


WEEP HOLE EXTENSION DETAIL
No Scale

LEGEND
Expanded Polystyrene


AS BUILT

CORRECTIONS BY G. ZAUN / RWH
CONTRACT NO. 59Y021
DATE 2-8-02 / 10-24-02


NO AS BUILT CHANGES

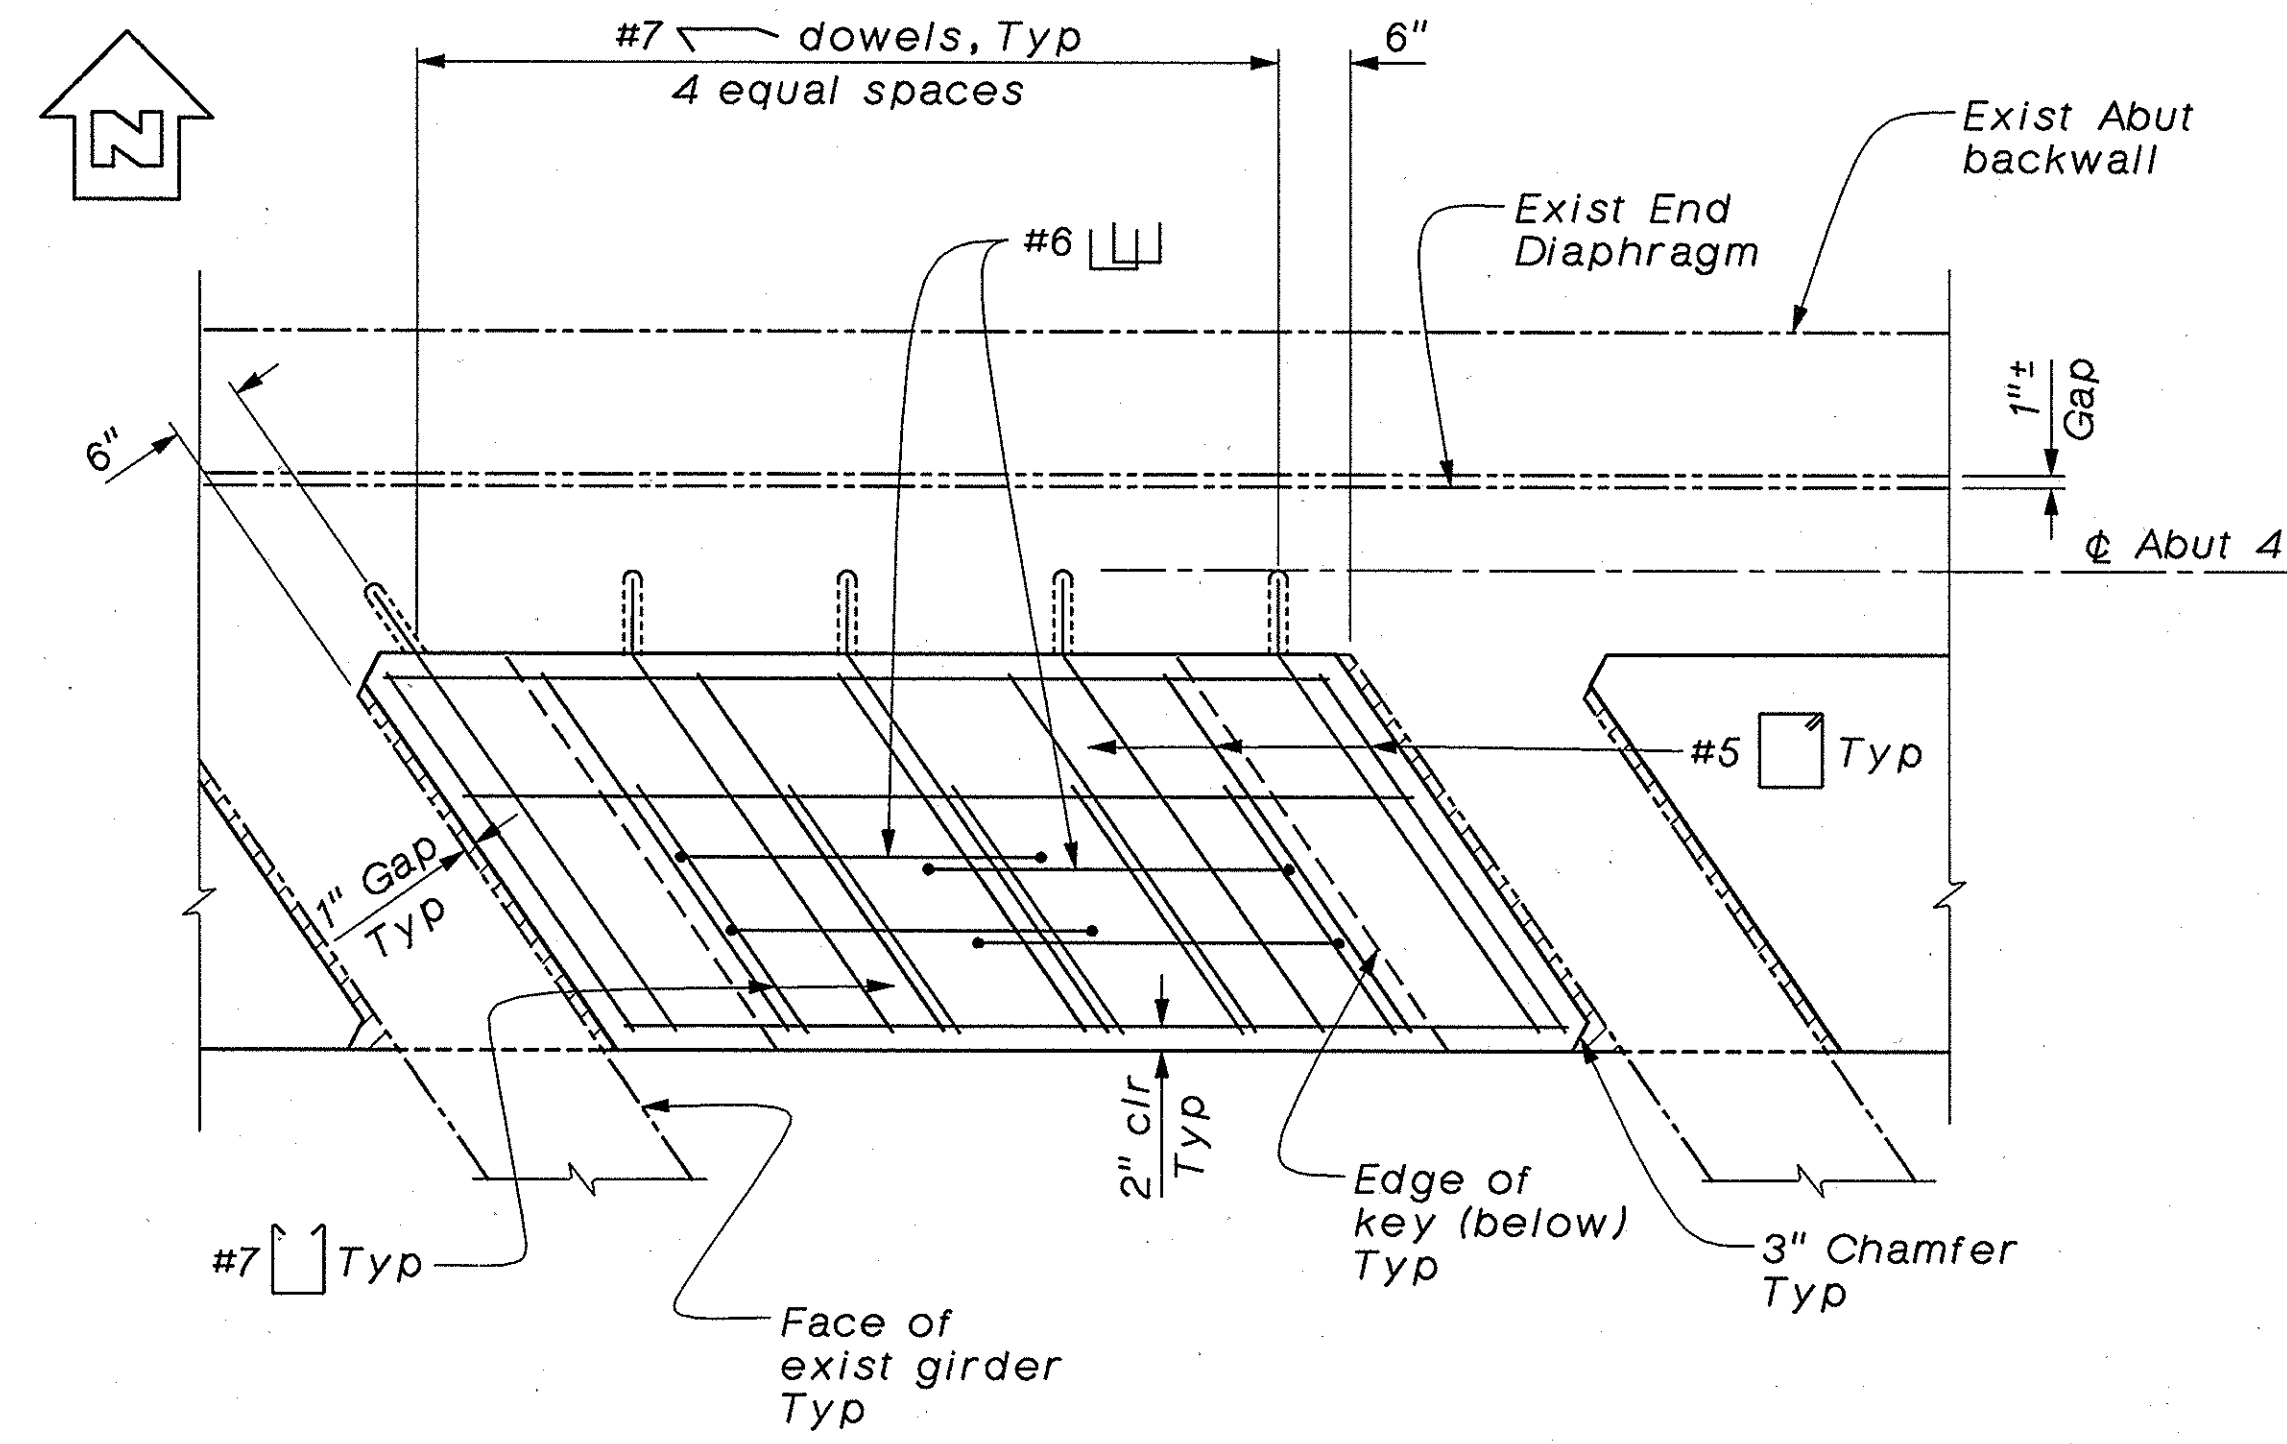

DETAIL 2
3/4" = 1'-0"

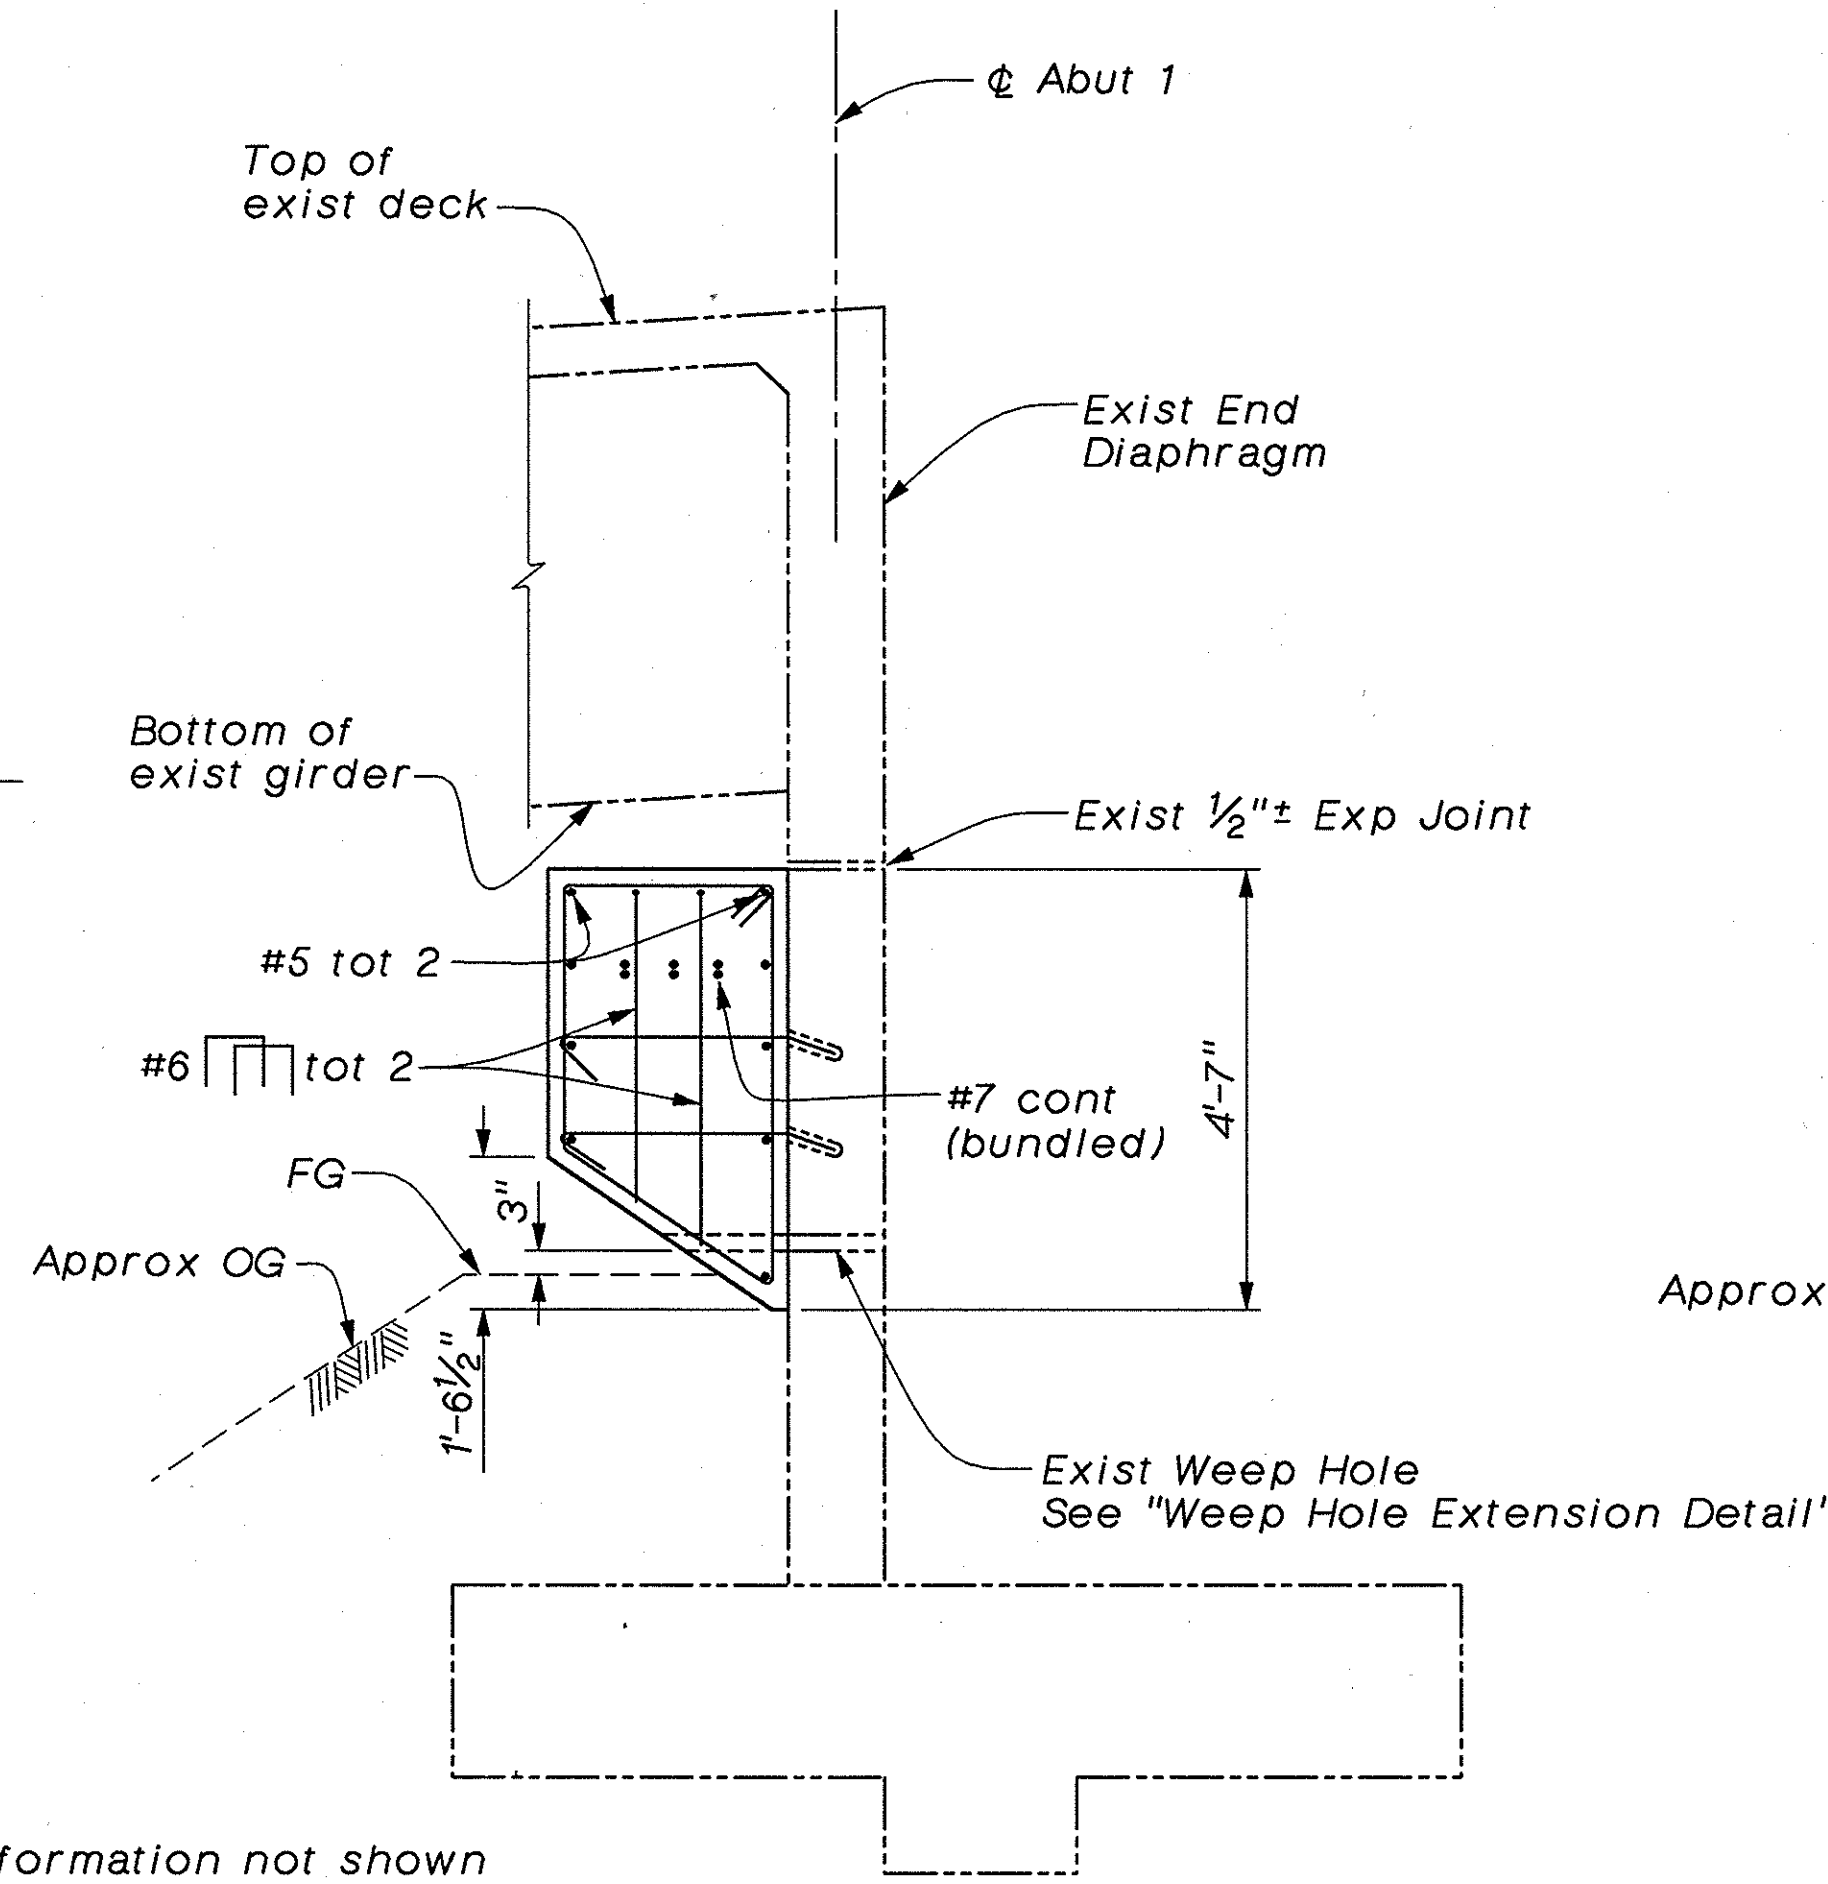

SECTION C-C
1/2" = 1'-0"

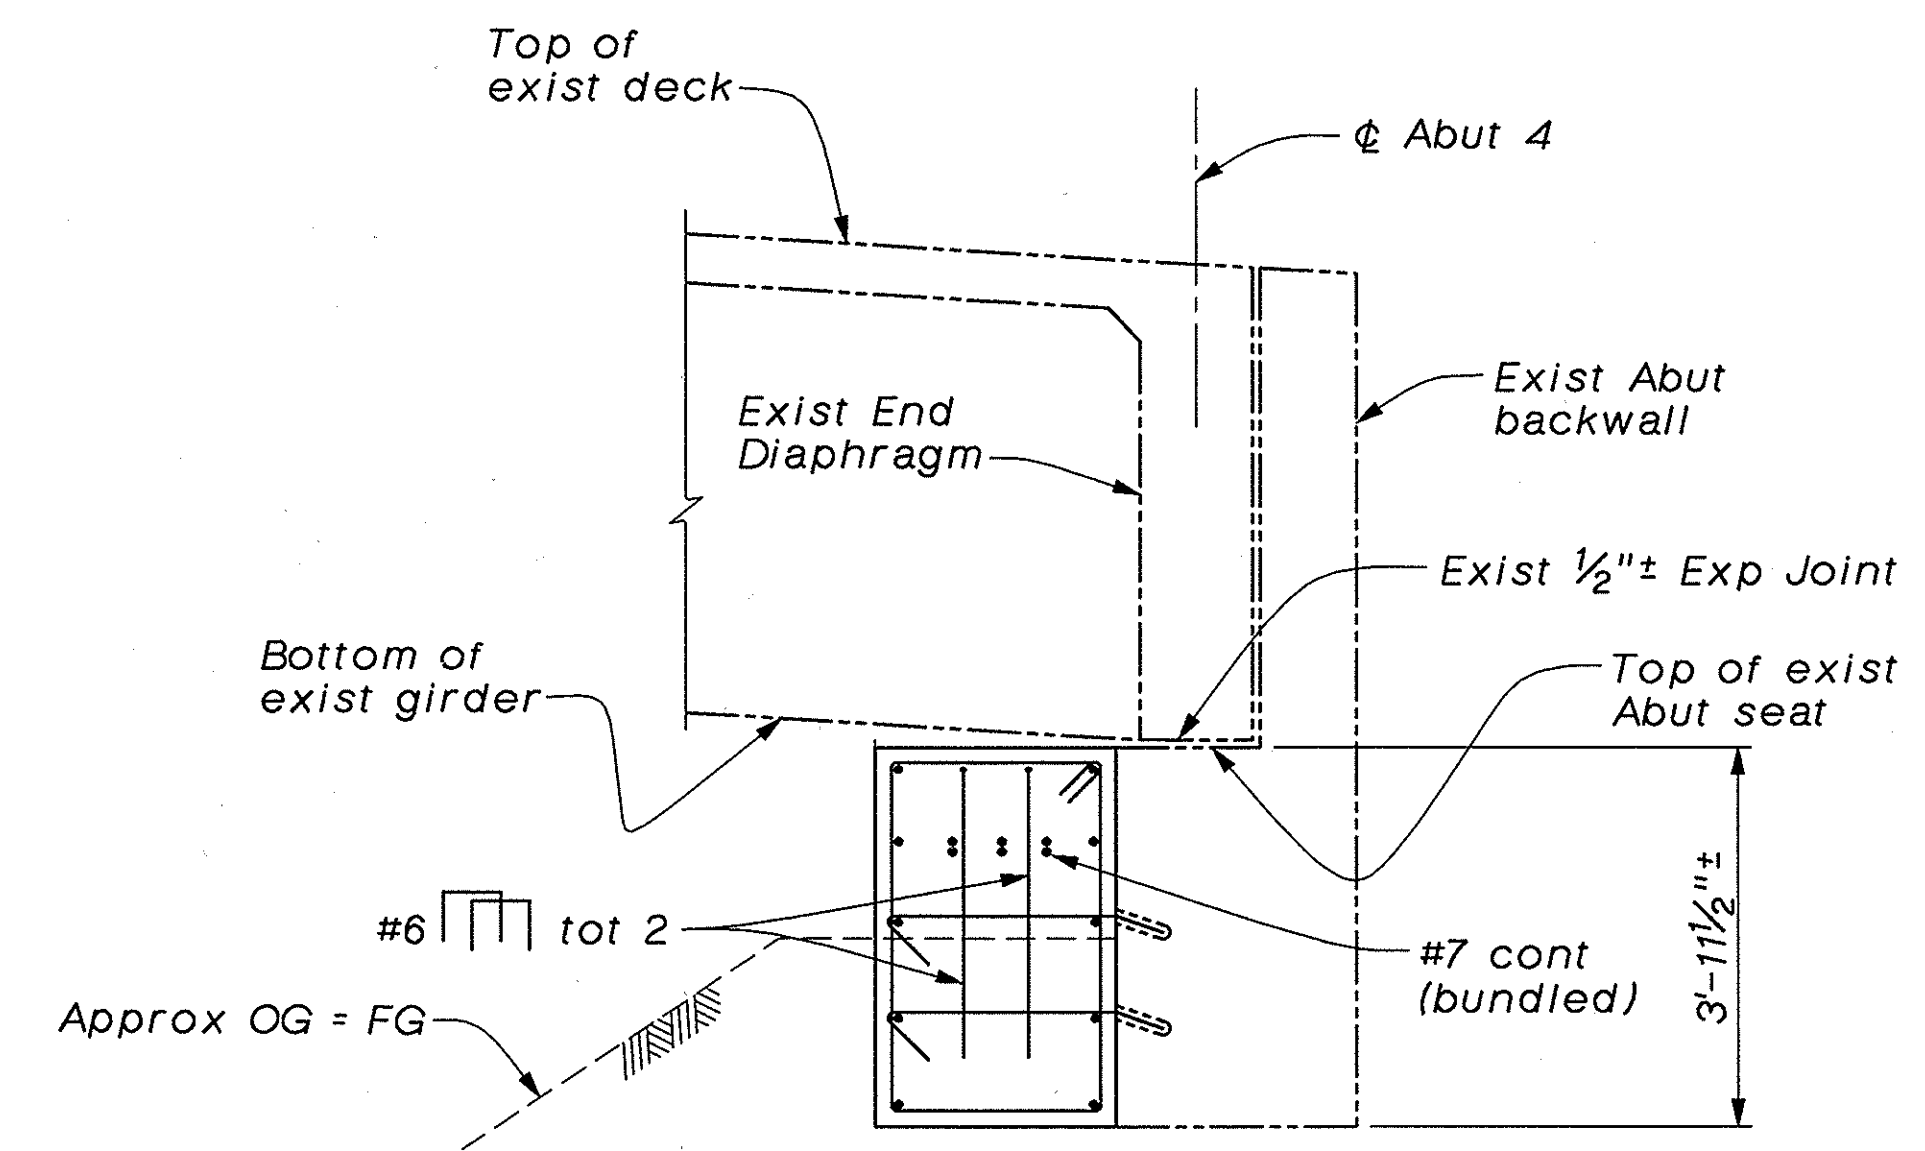

SECTION G-G
1/2" = 1'-0"

Note:
For information not shown see "Section D-D" on "Abutment 4 Retrofit Details" sheet.

Note:
The Contractor shall verify all controlling field dimensions before ordering or fabricating any material.

Note:
For information not shown see "Section A-A" on "Abutment 1 Retrofit Details" sheet

SHAWN SUN <i>Shawn Sun</i> DESIGN OVERSIGHT 12/24/97 SIGN OFF DATE	DESIGN	BY M. ZAHEDI/A. HOU	CHECKED S. XIE/A. TRUONG	PREPARED FOR THE COUNTY OF ORANGE	G.J. NASCIMENTO PROJECT ENGINEER	BRIDGE NO.	EARTHQUAKE RETROFIT														
	DETAILS	BY R. ANDRASEK	CHECKED J. LU			55C-0049	SANTIAGO CREEK BRIDGE														
	QUANTITIES	BY H. LAM	CHECKED M. ZAHEDI			POST MILE	ABUTMENT RETROFIT DETAILS														
				ORIGINAL SCALE IN INCHES FOR REDUCED PLANS		CU 12 152 EA L02106		DISREGARD PRINTS BEARING EARLIER REVISION DATES →		REVISION DATES (PRELIMINARY STAGE ONLY)										SHEET	OF
				0 1 2 3																4	6