

REGISTERED CIVIL ENGINEER

LINO C. CHEANG

No. C41401

Exp. 9/30/99

CIVIL

STATE OF CALIFORNIA

PLANS APPROVAL DATE

EARTH MECHANICS, INC.

17660 Newhope Street, Suite E

Fountain Valley, California 92708

The As-Built Log of Test Boring sheets were used to prepare the Geotechnical Report

AS BUILT

CORRECTIONS BY G. ZAUN / RWH

CONTRACT NO. 59Y021

DATE 2-8-02 / 10-24-02





NO AS BUILT CHANGES

REDUCED PLAN

USE SCALE BELOW

0 1 2 3

1/8" = 3' INCHES ON ORIGINAL PLAN

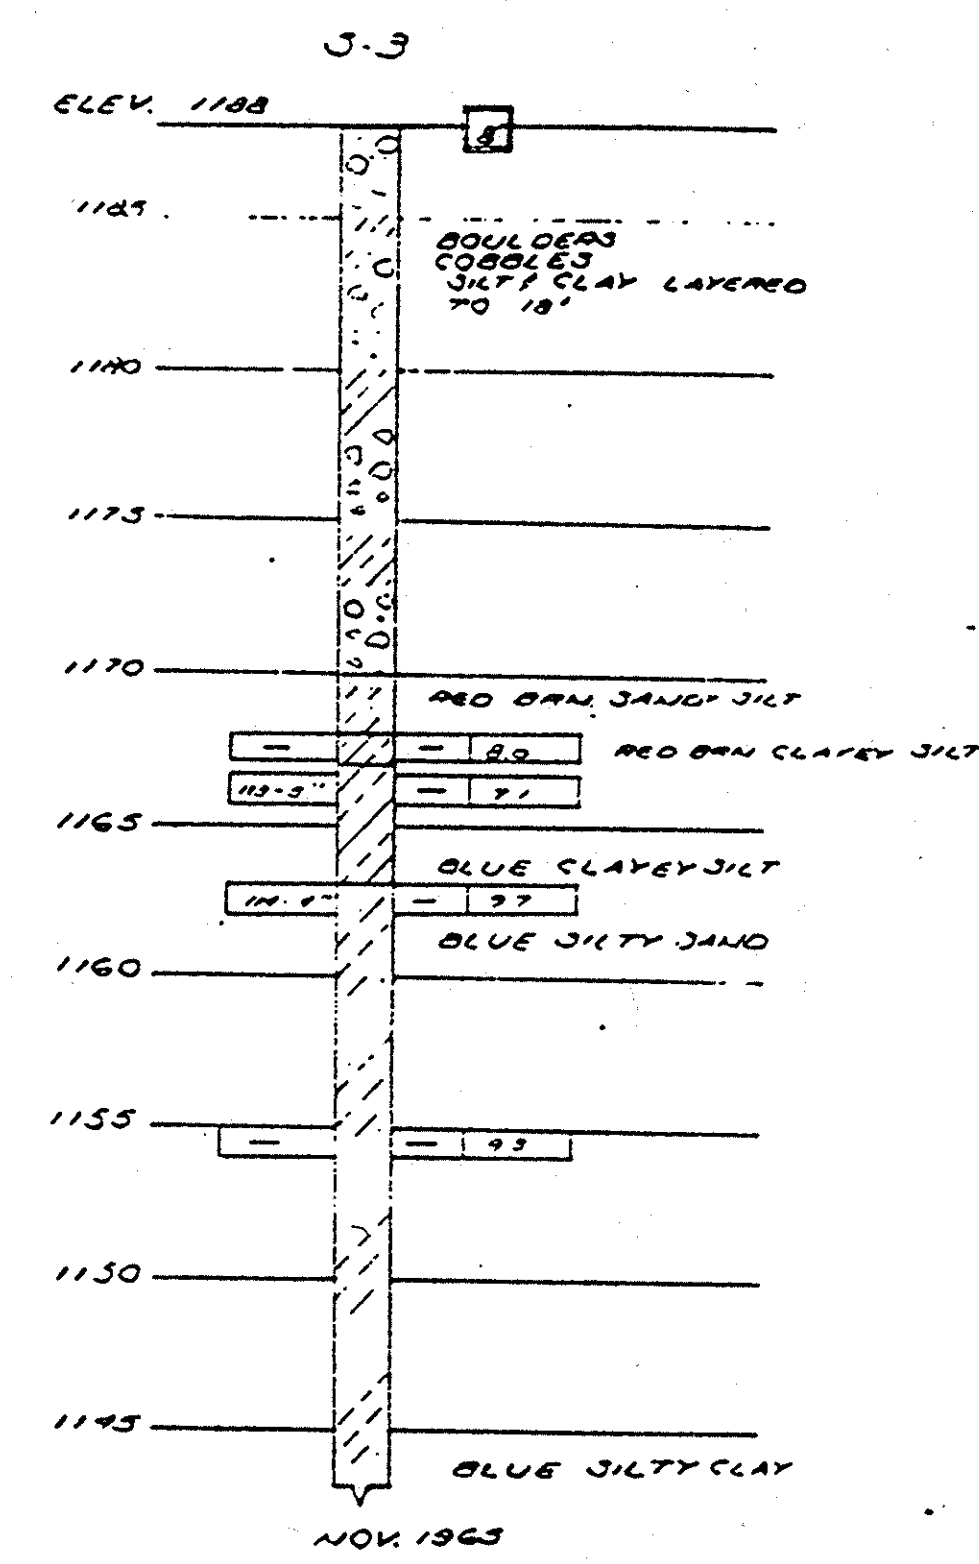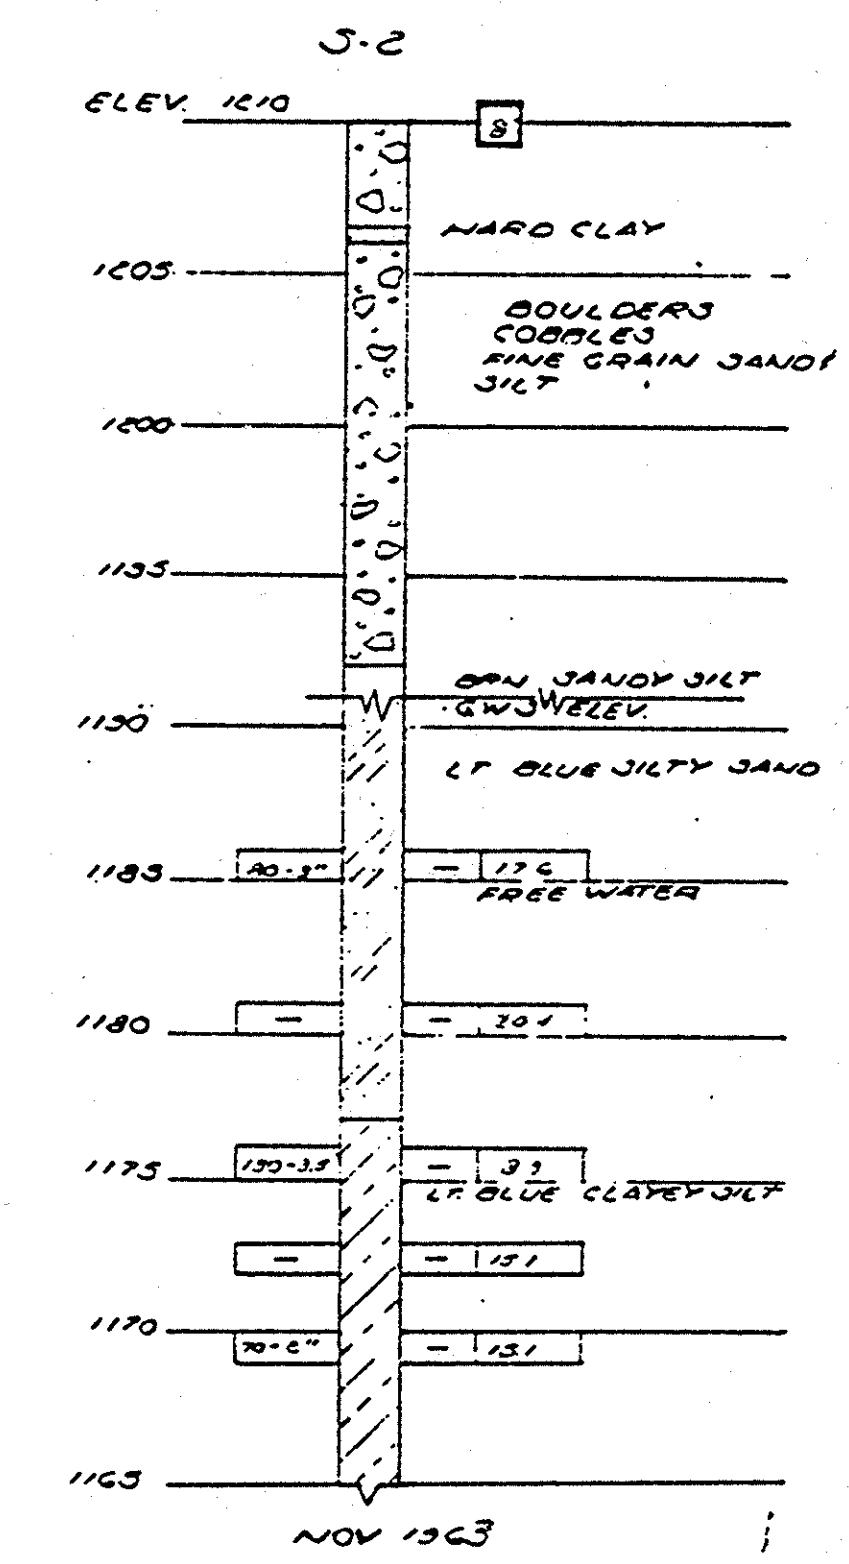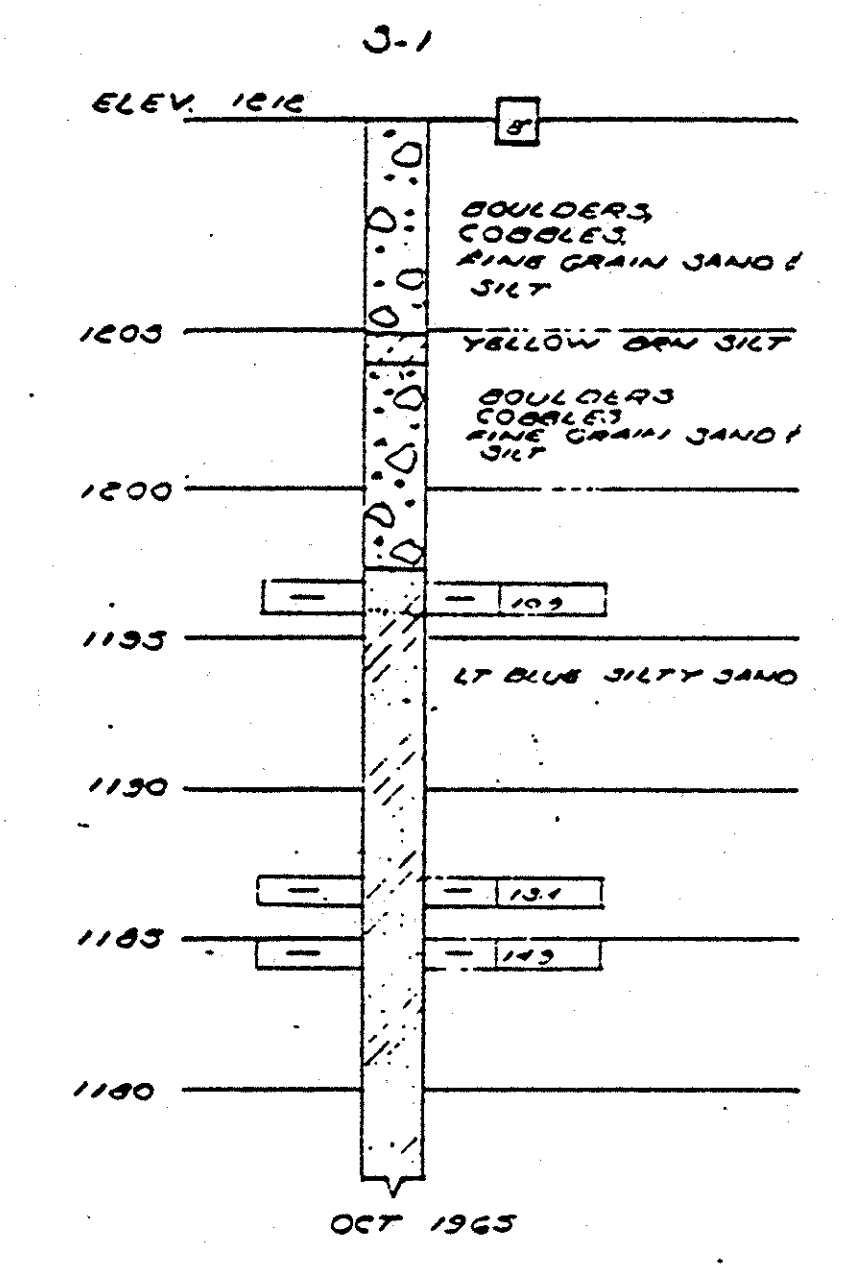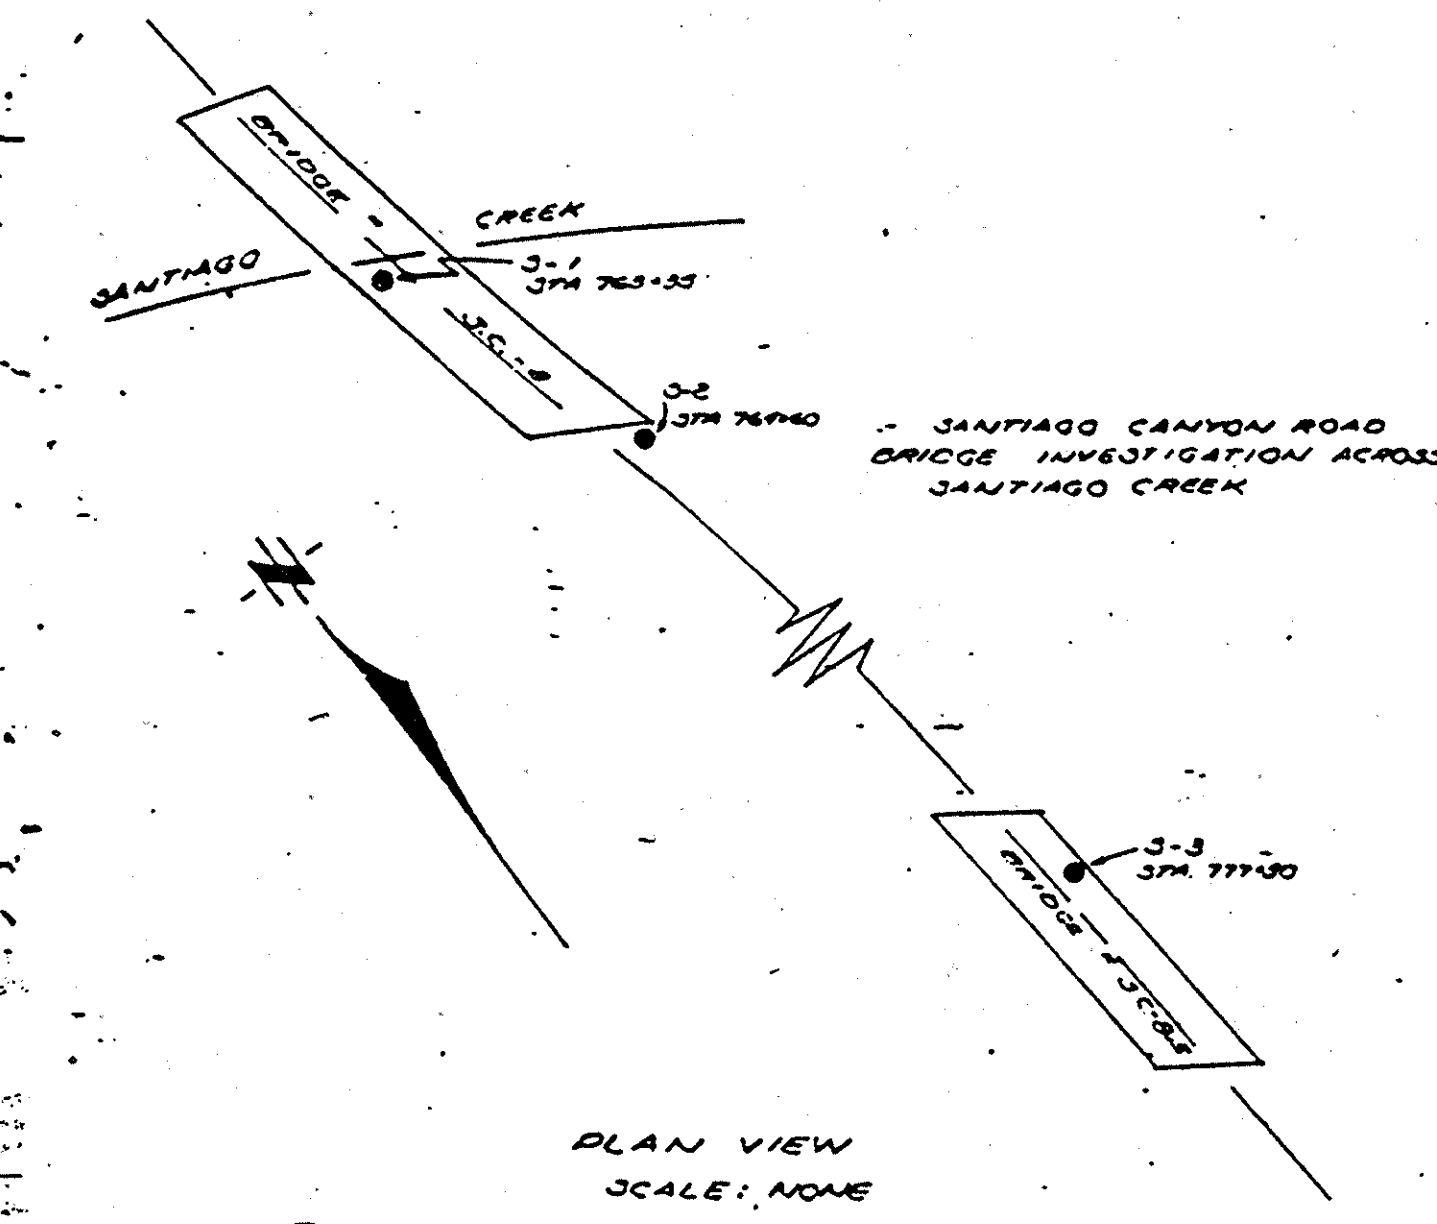

General Details

Drawn by TELLY 7/64

Checked by APB 7/66

Approved by [Signature]

LEGEND OF EARTH MATERIALS

GRAVEL, SAND, SILT, CLAY, SANDY CLAY OR CLAYEY SAND, SANDY SILT OR SILTY SAND, SILTY CLAY OR CLAYEY SILT, PEAT OR/OR ORGANIC MATTER, FILL MATERIAL, IGNEOUS ROCK, SEDIMENTARY ROCK, METAMORPHIC ROCK

LEGEND OF BORING OPERATIONS

PLAN OF ANY BORING, PENETROMETER, 2 1/2" CONE PENETROMETER, SAMPLER BORING (DRY), SAMPLER BORING (WET), AUGER BORING (DRY), JET BORING, CORE BORING, TEST PIT

NOTES

The contractor's attention is directed to Section 2... of the Standard Specifications and to the Special Provisions accompanying this set of plans.

Classification of earth material as shown on this sheet is based upon field inspection and is not to be construed to imply mechanical analysis.

ORANGE COUNTY ROAD DEPARTMENT

PROPOSED SANTIAGO CANYON ROAD BRIDGES

SC-8 & SC-8.5

ACROSS SANTIAGO CREEK

IN THE COUNTY OF ORANGE

LOG OF TEST BORINGS

SCALE 1" = 5'

BRIDGE FILE DRAWING 3 OF 13

SHAWN SUN <i>Shawn Sun</i>		DESIGN BY M. ZAHEDI/A. HOU		CHECKED S. XIE/A. TRUONG		PREPARED FOR THE COUNTY OF ORANGE		BRIDGE NO. 55C-0049		EARTHQUAKE RETROFIT	
DESIGN OVERSIGHT 12/29/97		DETAILS BY R. ANDRASEK		CHECKED J. LU		G.J. NASCIMENTO PROJECT ENGINEER		POST MILE		SANTIAGO CREEK BRIDGE	
SIGN OFF DATE		QUANTITIES BY H. LAM		CHECKED M. ZAHEDI		CU 12 152 E. L02106		DISREGARD PRINTS BEARING EARLIER REVISION DATES		AS-BUILT LOG OF TEST BORINGS	
ORIGINAL SCALE IN INCHES FOR REDUCED PLANS		0 1 2 3		0 1 2 3		REVISION DATES (PRELIMINARY STAGE ONLY)		SHEET 6 OF 6			