


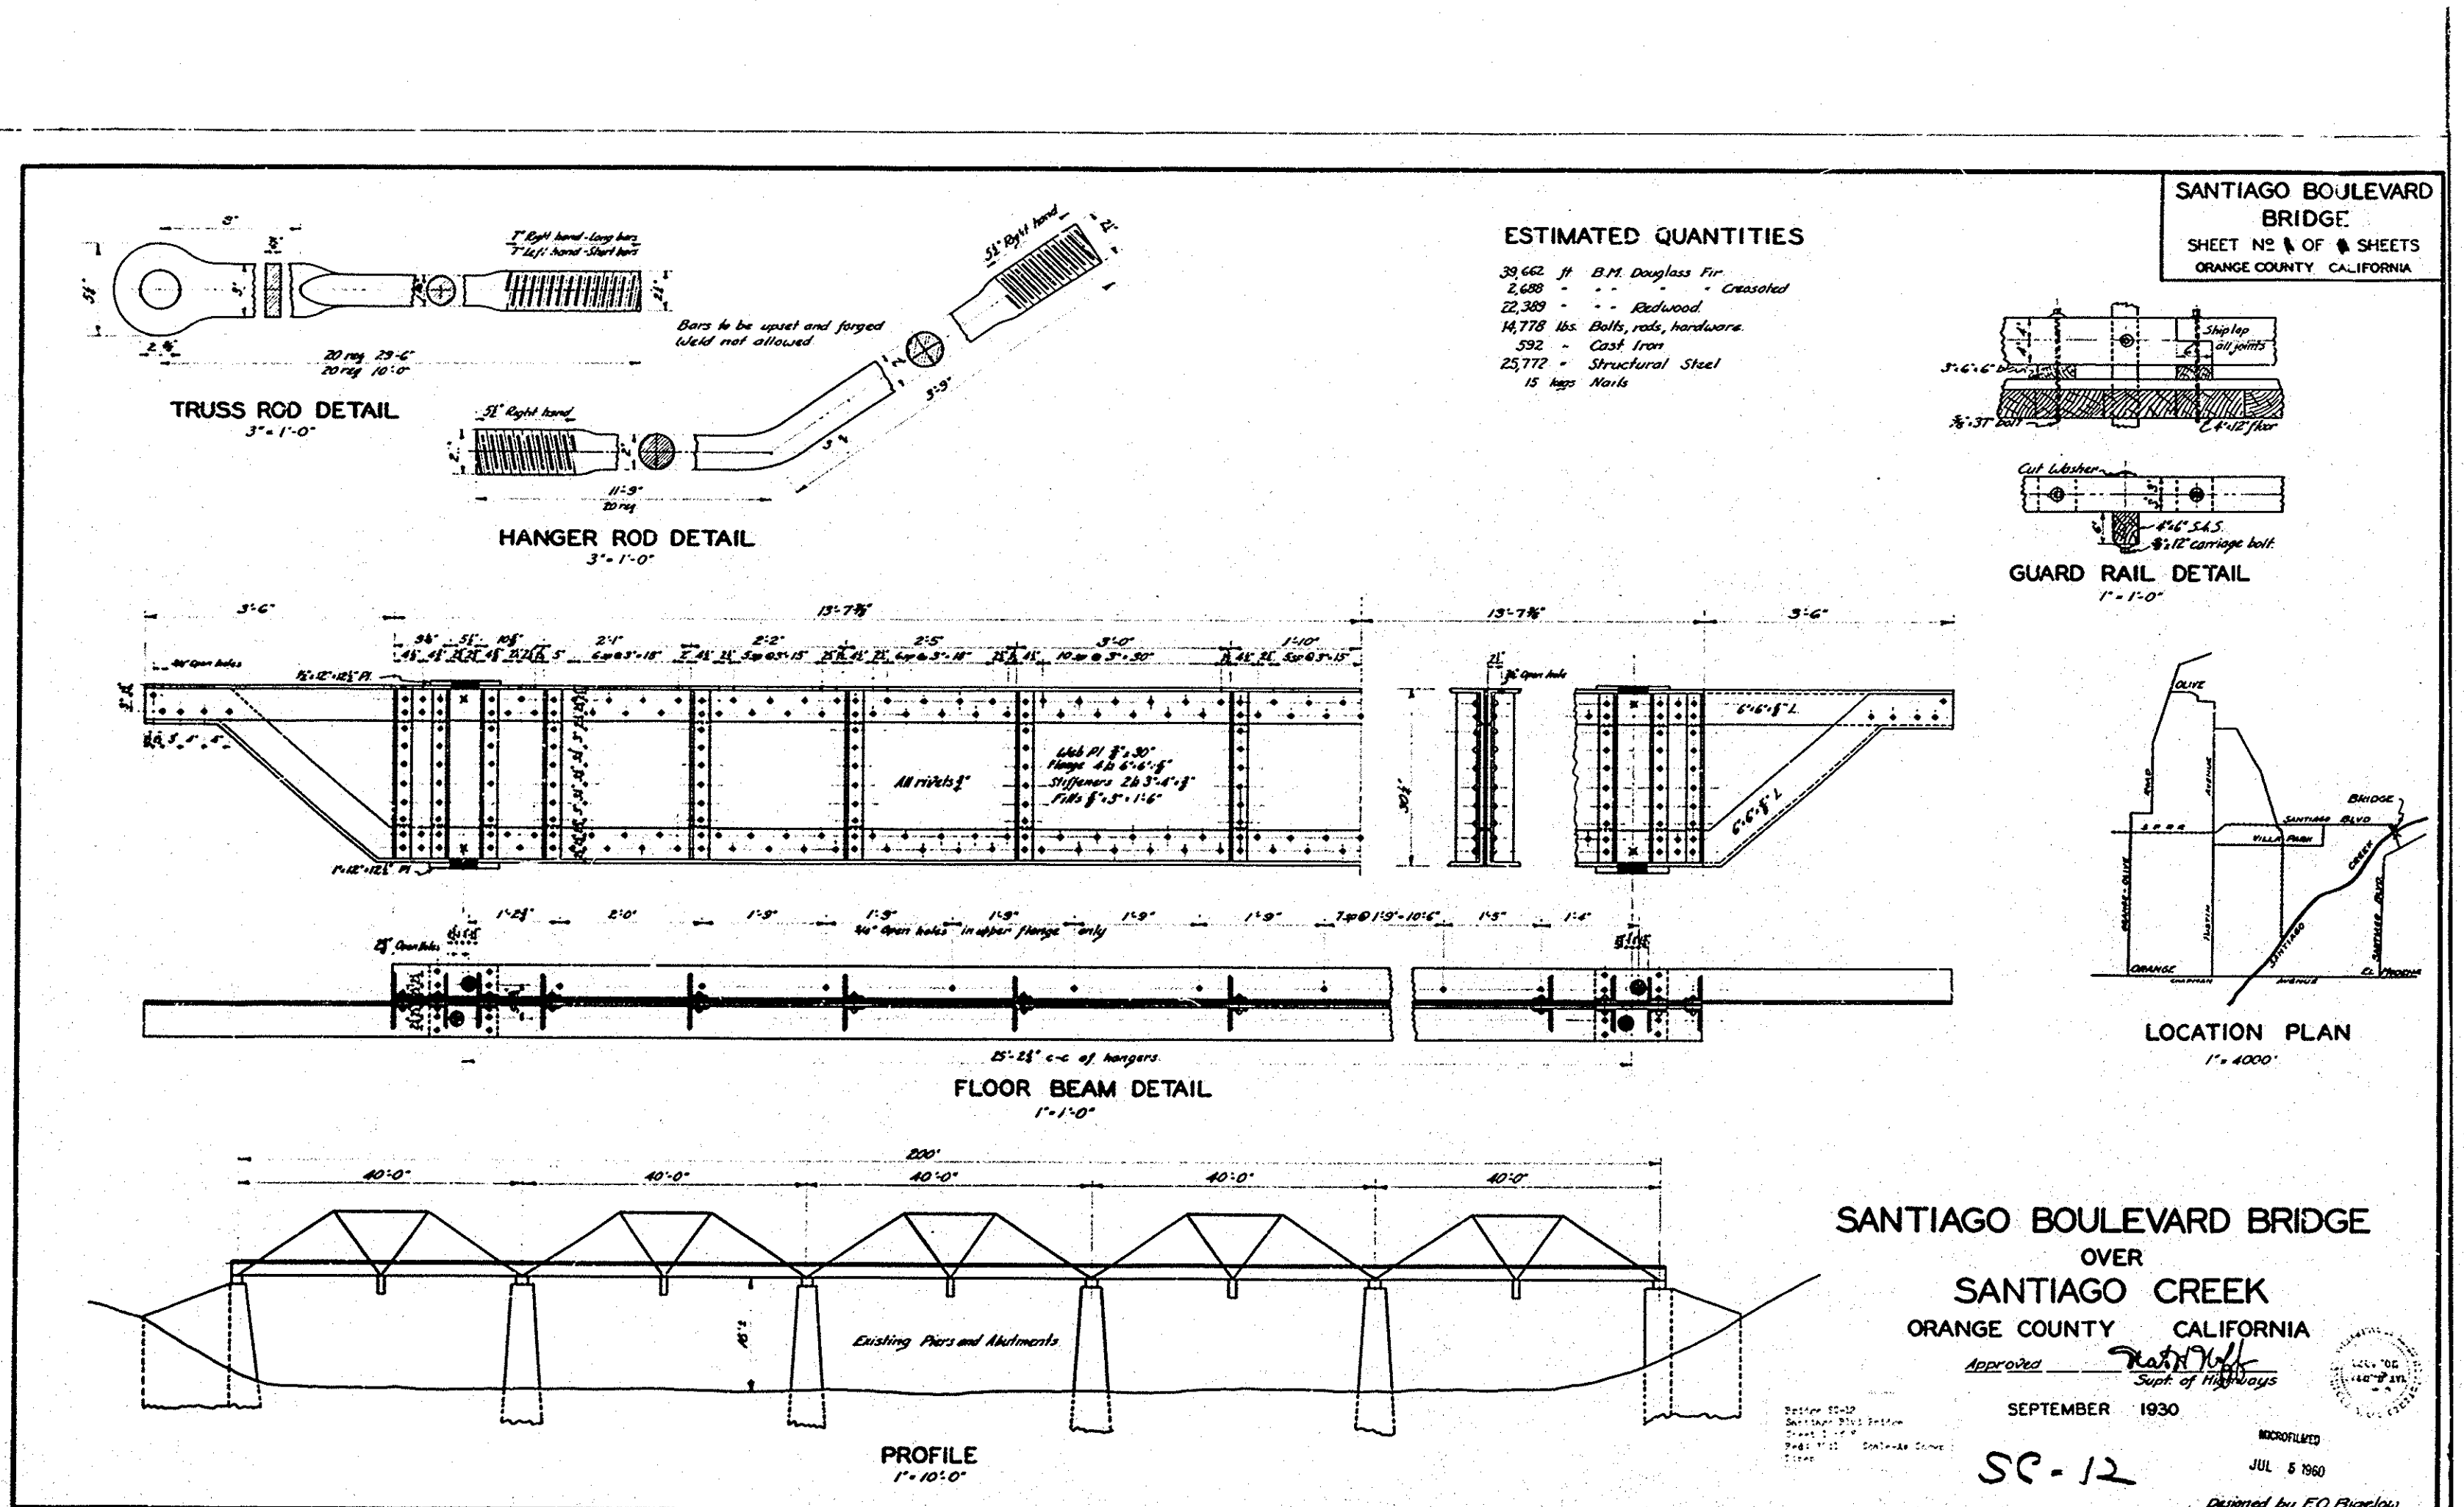

Sheet 1068
#14651 1930
SC-12
SANTIAGO BRIDGE BR.
Th. 800-D1