
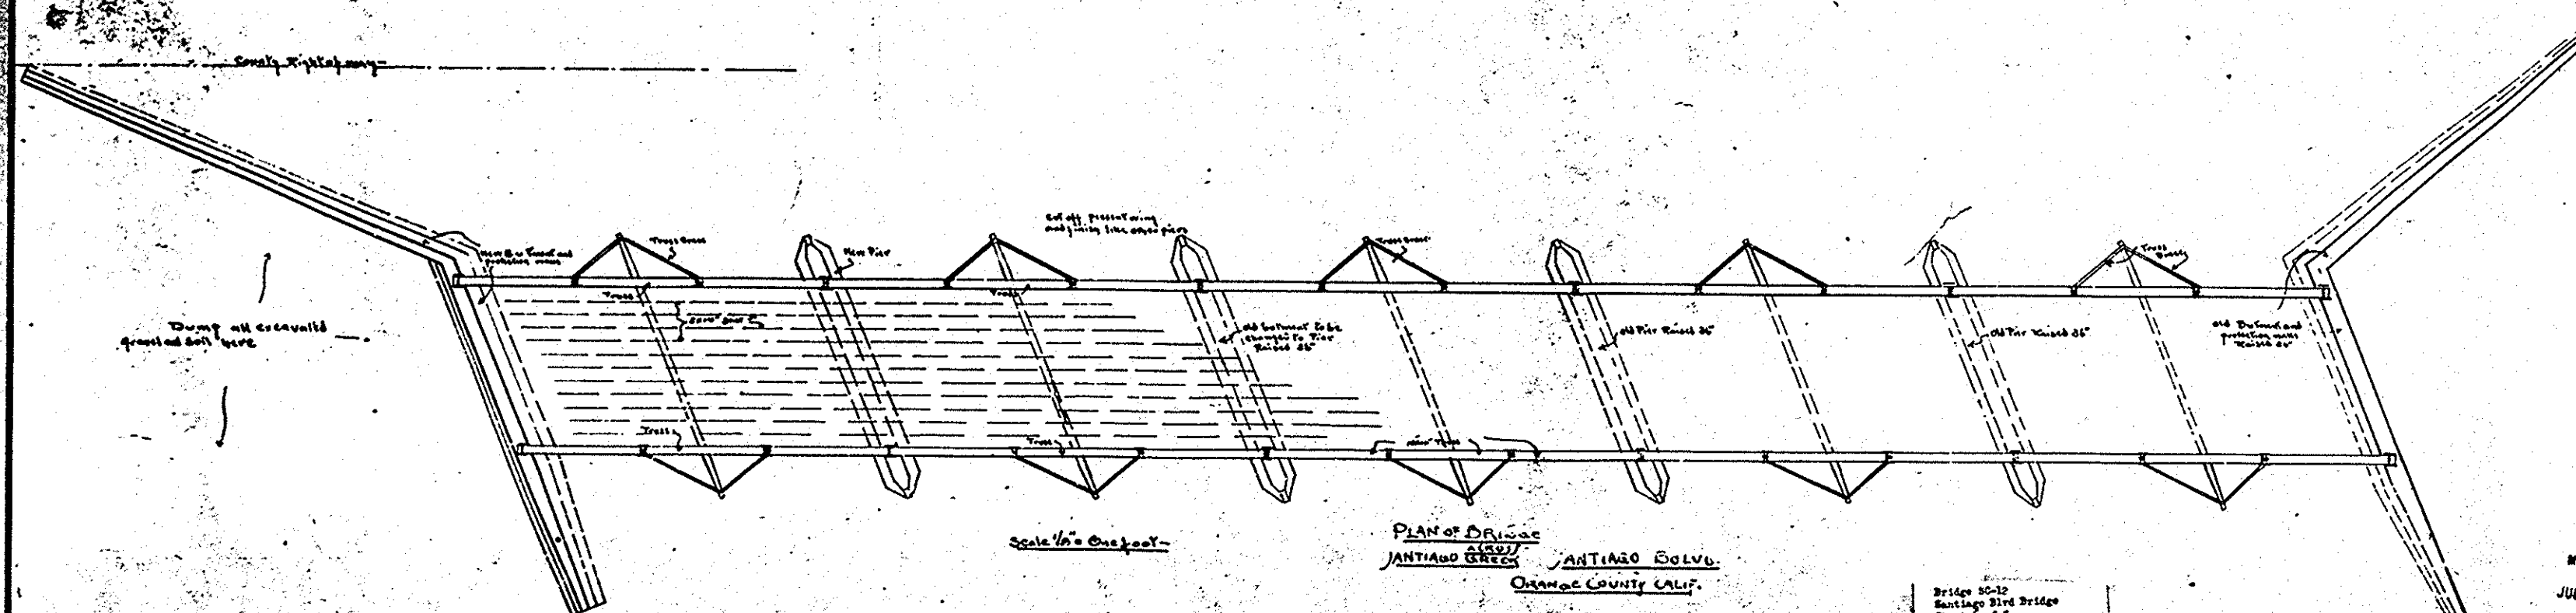


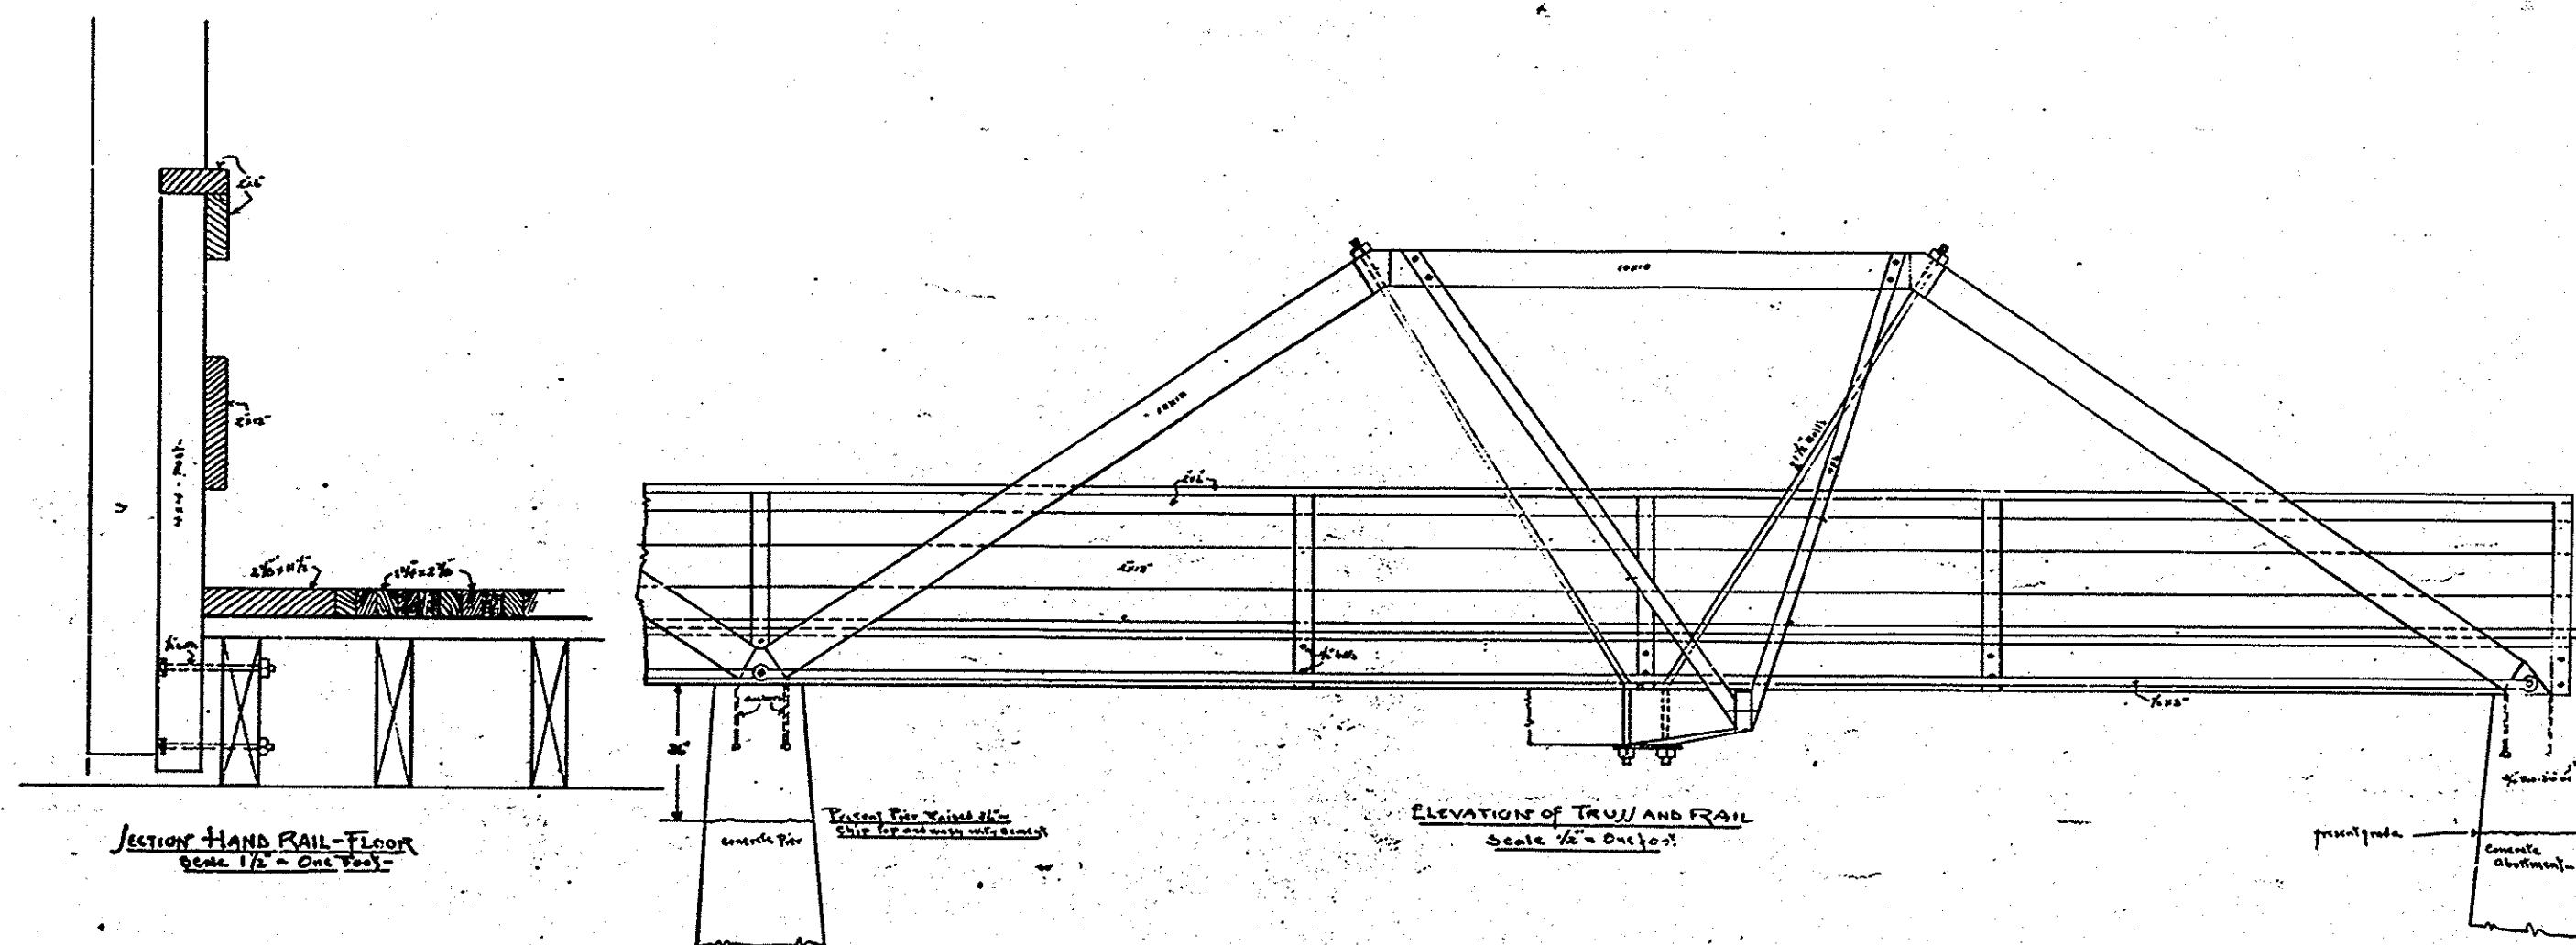

Bridge 3C-12  
Santiago Blvd Bridge  
Sheet 6 of 8  
Ead: 30:1 Scale-as Shown  
Blue-line Print

MICROFILMED  
 JUL 5 1960

Sheet 6 of 8