

Cut 495 cu yds
Fill 324

Cut 682 cu yds
Fill 4173

250

255

260

CROSS SECTION OF BOX
Scale 1/4" = 1'

LONGITUDINAL SECTION
THRU
END WALL
Scale 1/4" = 1'






CROSS SECTION OF
WINGWALL
Scale 1/4" = 1'

PLAN
Scale 1/4" = 1'

DETAILS
OF
RE-INFORCED CONCRETE
BOX CULVERT

Estimated Quantities
Steel 9157 lbs.
Concrete 1073 cu yds.

Note: All reinforcing to be deformed round bars.

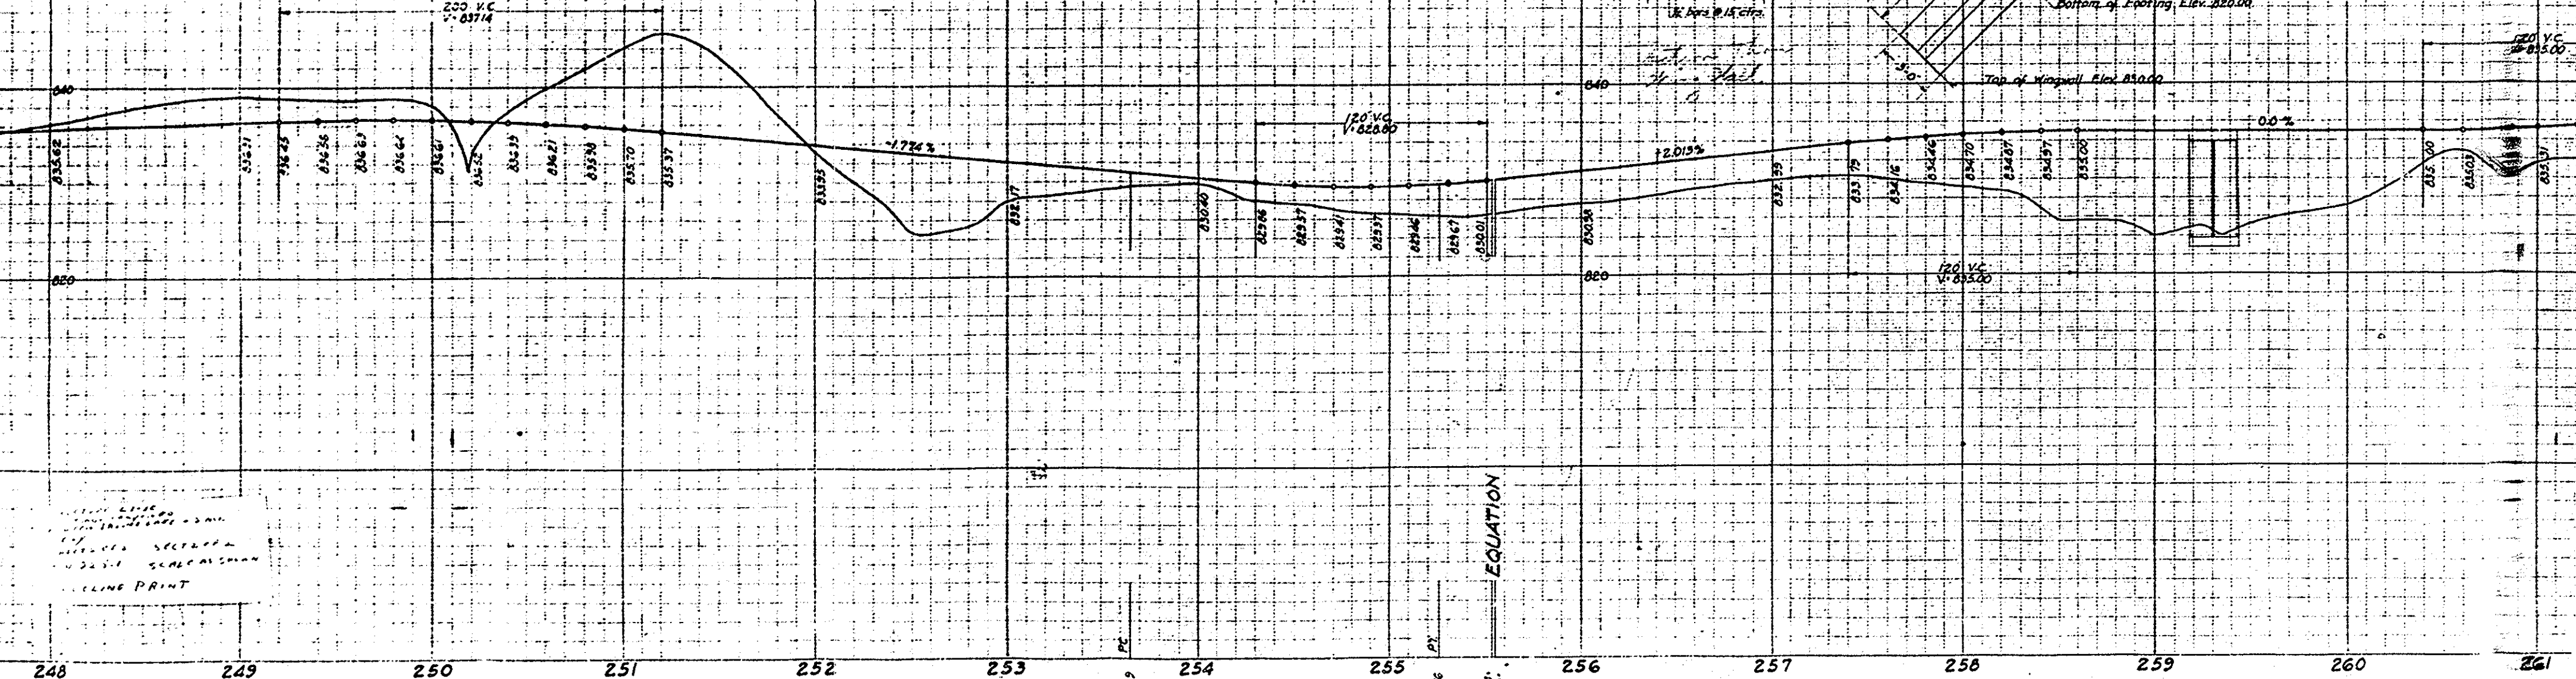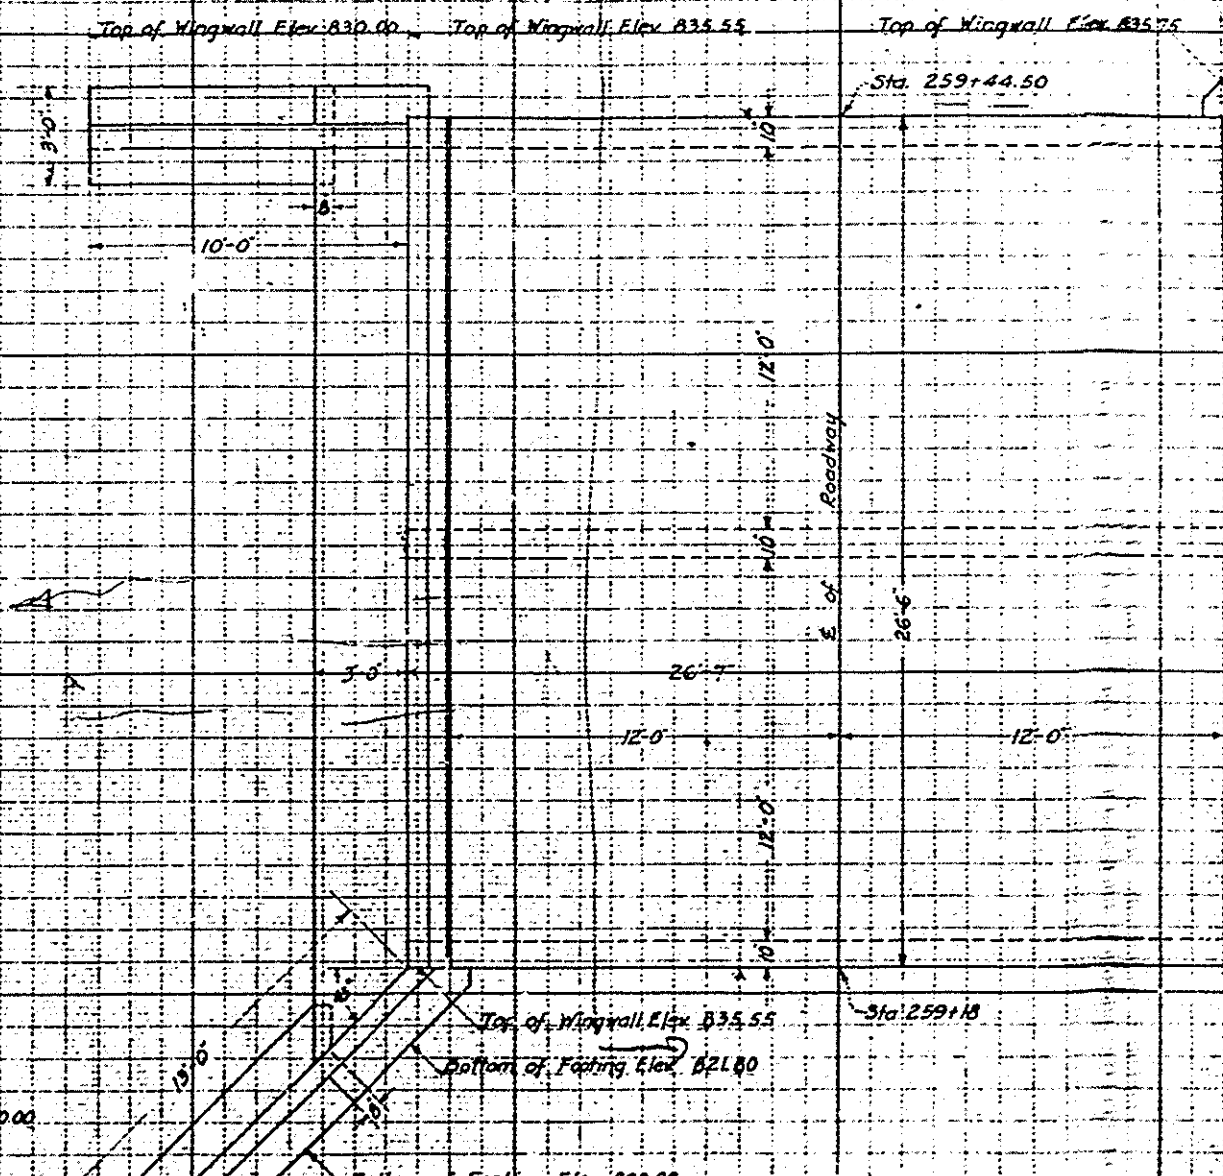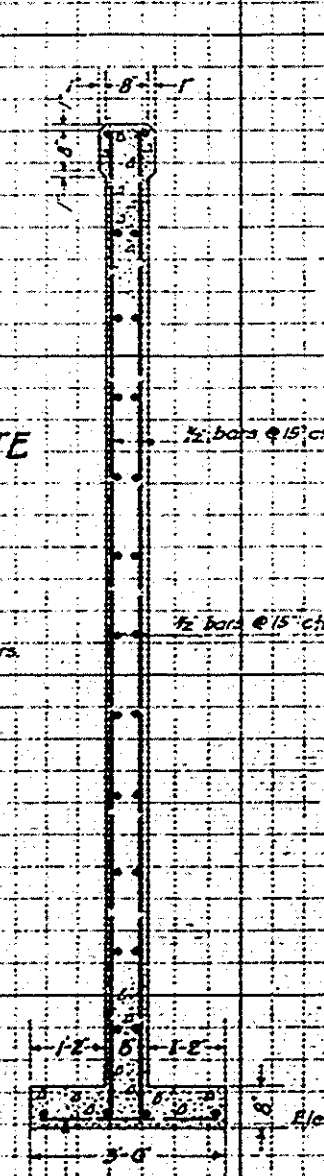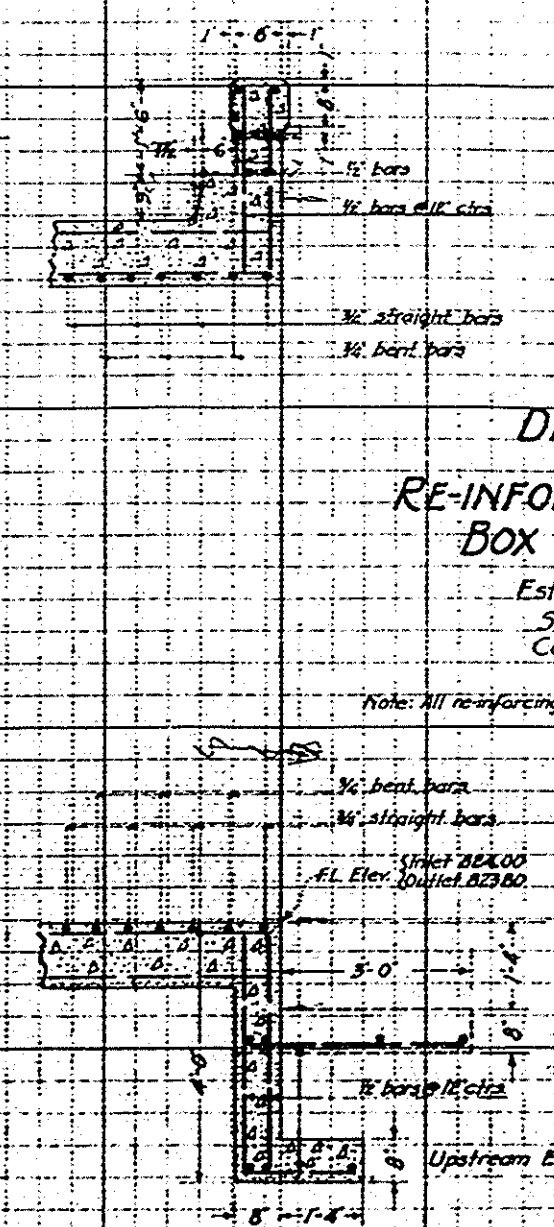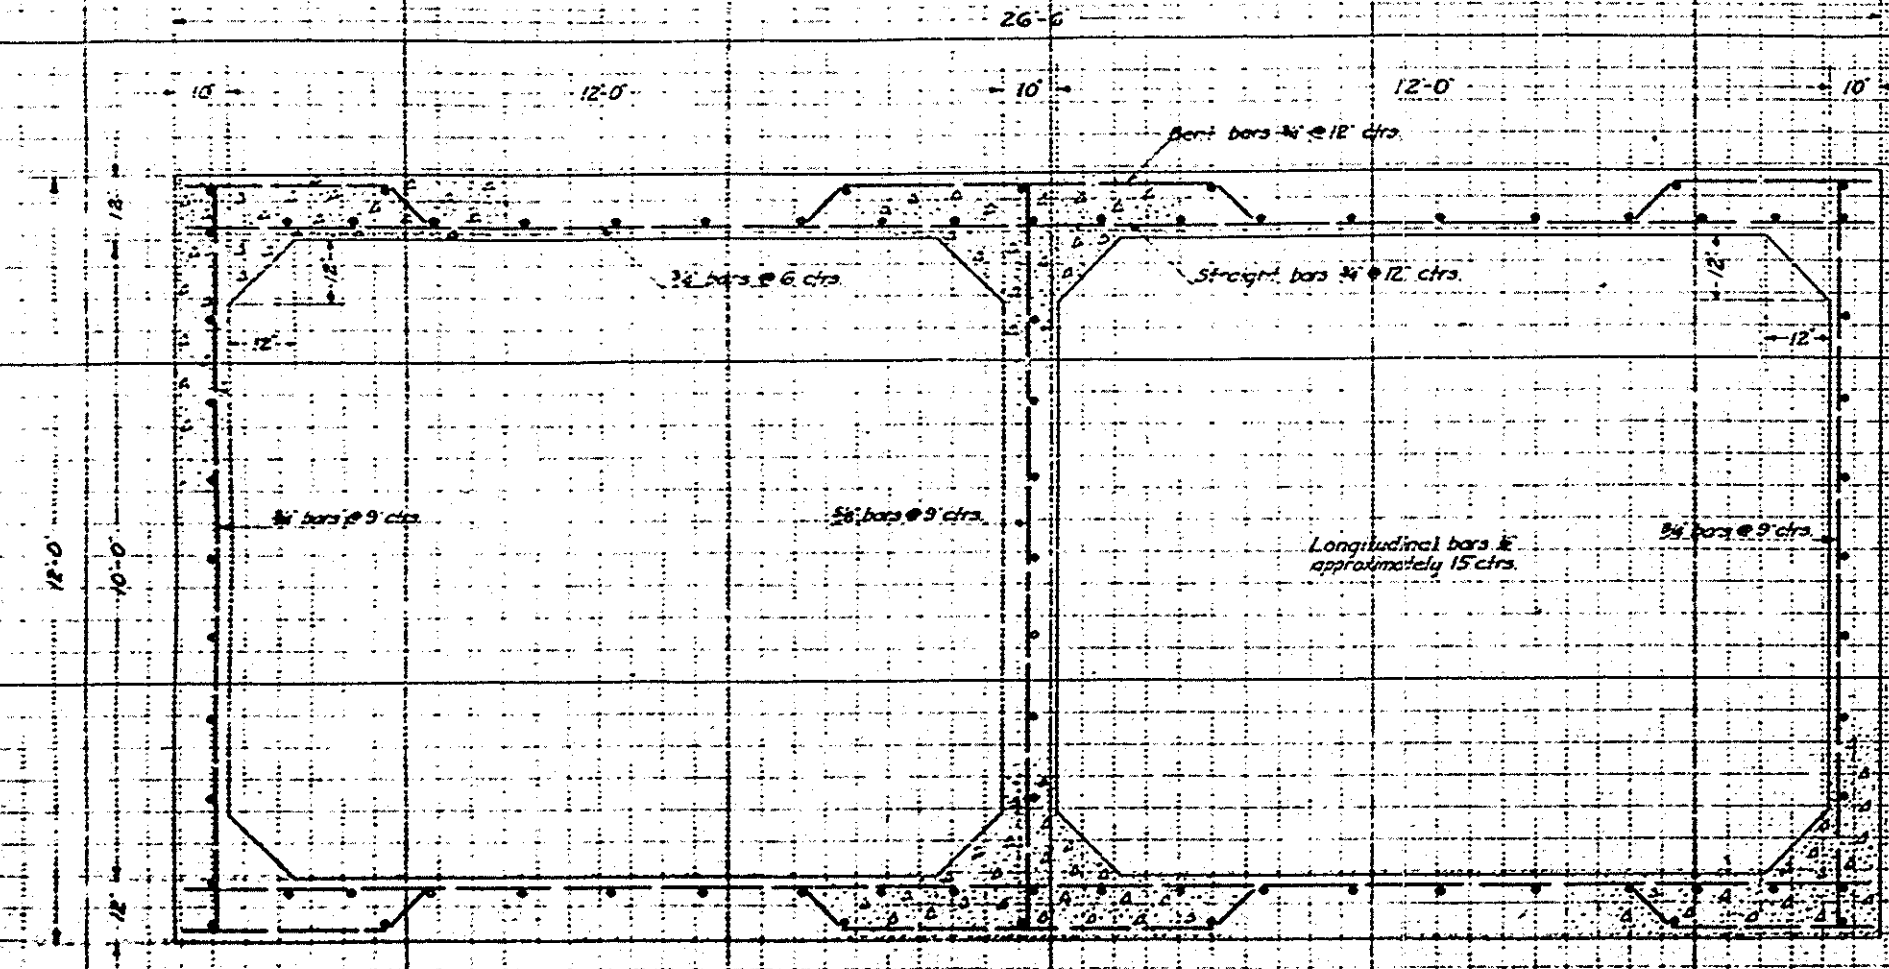

EQUATION

NOTES:
1. ALL DIMENSIONS ARE IN FEET AND INCHES.
2. ALL REINFORCING TO BE DEFORMED ROUND BARS.
3. ALL DIMENSIONS ARE TO FACE UNLESS OTHERWISE NOTED.
4. ALL DIMENSIONS ARE TO FACE UNLESS OTHERWISE NOTED.
5. ALL DIMENSIONS ARE TO FACE UNLESS OTHERWISE NOTED.