

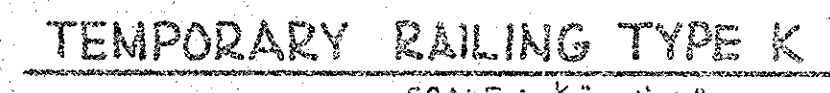
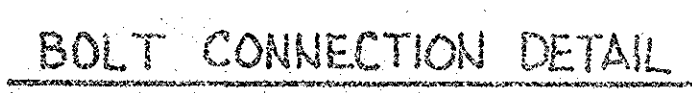


- (1) POST 693, G51 & 633 SIGNS.
- (2) POST TYPE "2" SIGN. SEE DETAIL THIS SHEET.
- (3) ERECT CHAIN ACROSS EXIST. TRAIL WITH SIGN "TRAIL CLOSED" BY OTHERS.
- (4) POST 693 & G51 SIGNS.
- (5) PAVE 8' WIDE TRAIL (Q17" A.C. OVER NATIVE SOIL) OVER EXIST. LEVEE, RAMPS, AND RIVER BED.
- (6) POST 3 W-21.

SIGN NUMBERS REFER TO CURRENT UNIFORM SIGN CHART (CALTRANS). SEE SIGN QUANTITY CHART, SHT. 2.

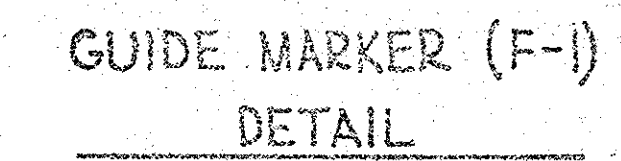

- SCALE: $\frac{1}{4} = 1'-0"$
- NOTES FOR RAILING:
1. ALL BOLTS TO HAVE CUT WASHERS UNLESS OTHERWISE STATED.
 2. PAINT ENTIRE UNIT WHITE.
 3. ALTERNATIVE DETAILS FOR LIFTING THE PRECAST CONCRETE PANELS OF THE TEMPORARY RAILING TYPE K MAY BE SUBMITTED BY THE CONTRACTOR FOR THE ENGINEER'S APPROVAL.
 4. #4 @ 18" MAY BE REPLACED BY WELDED WIRE FABRIC OF EQUIVALENT CROSS-SECTIONAL AREA.

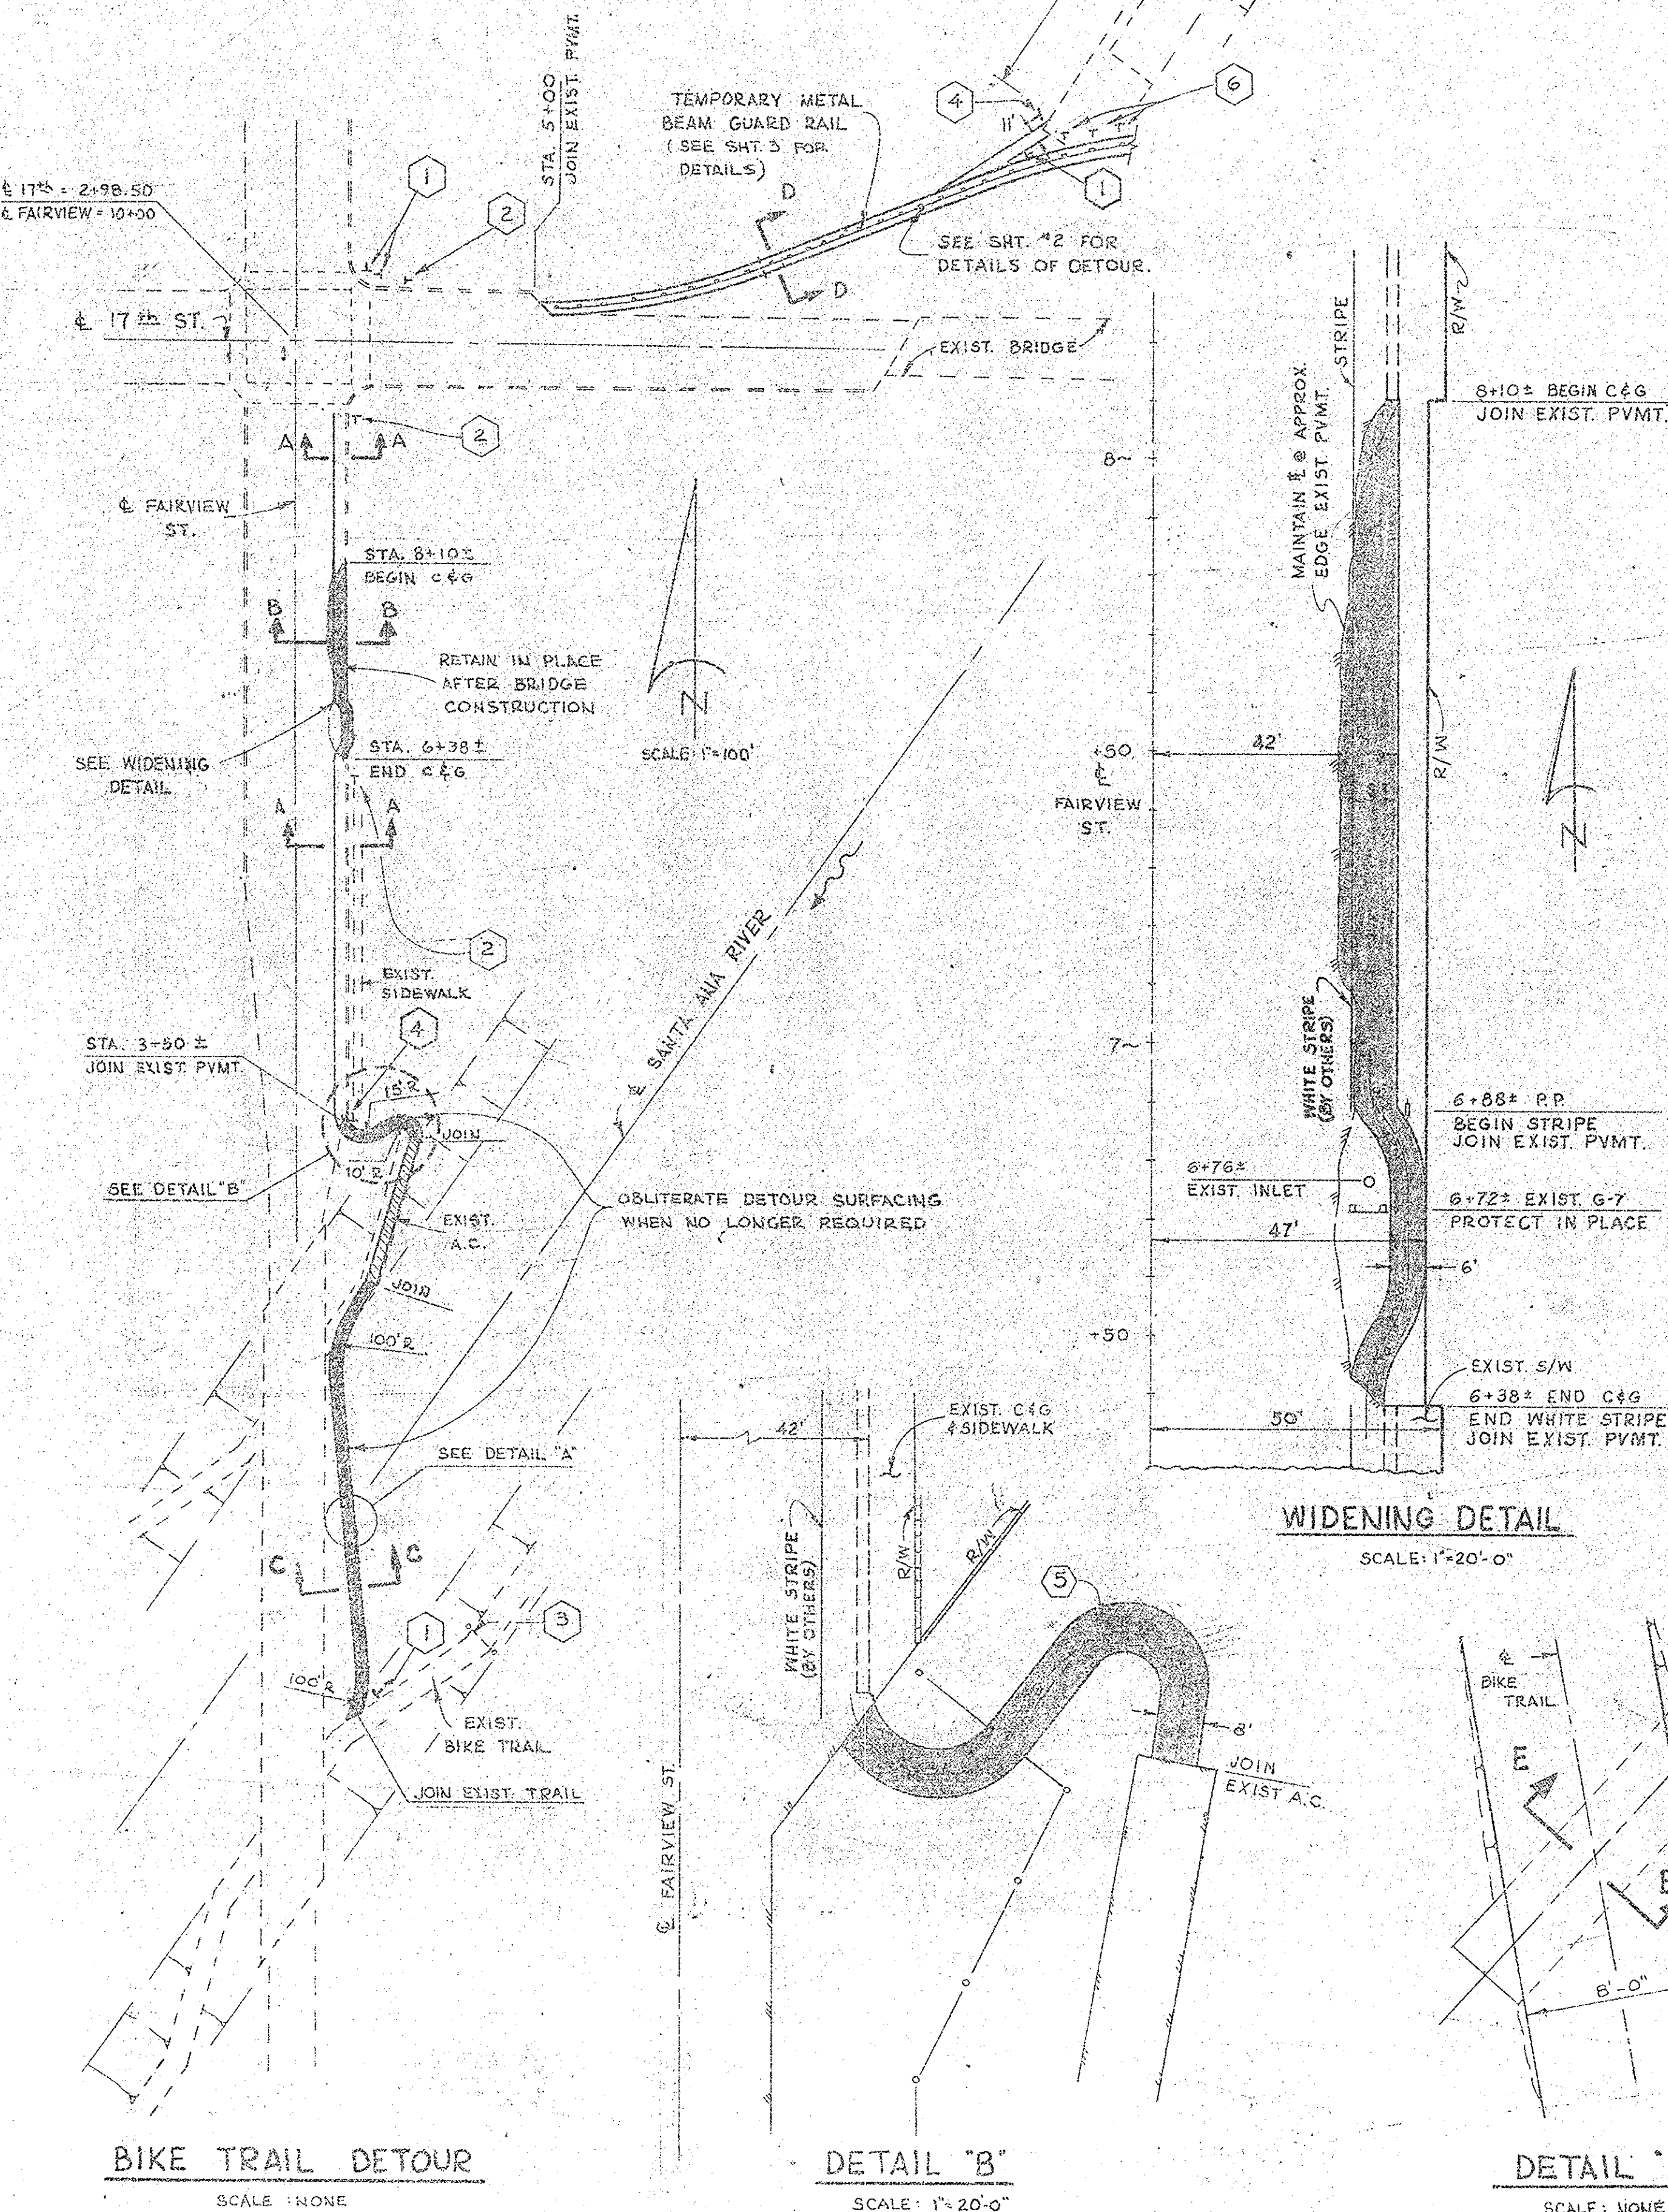