


ORANGE COUNTY ROAD DEPARTMENT
PROJECT 17th ST. DETOUR
LIMITS AT SANTA ANA RIVER
SCALE 1" = 40' HORIZ. SHEET 5 OF 20

DATE _____
BY _____
SUPERVISOR _____
PLANNING _____
DESIGN _____
CONSTRUCTION _____
NO. _____

DATE _____
BY _____
ORIGINAL SURVEY _____
SURVEY PLOTTED _____
NOTES RECORDED _____
NO. _____

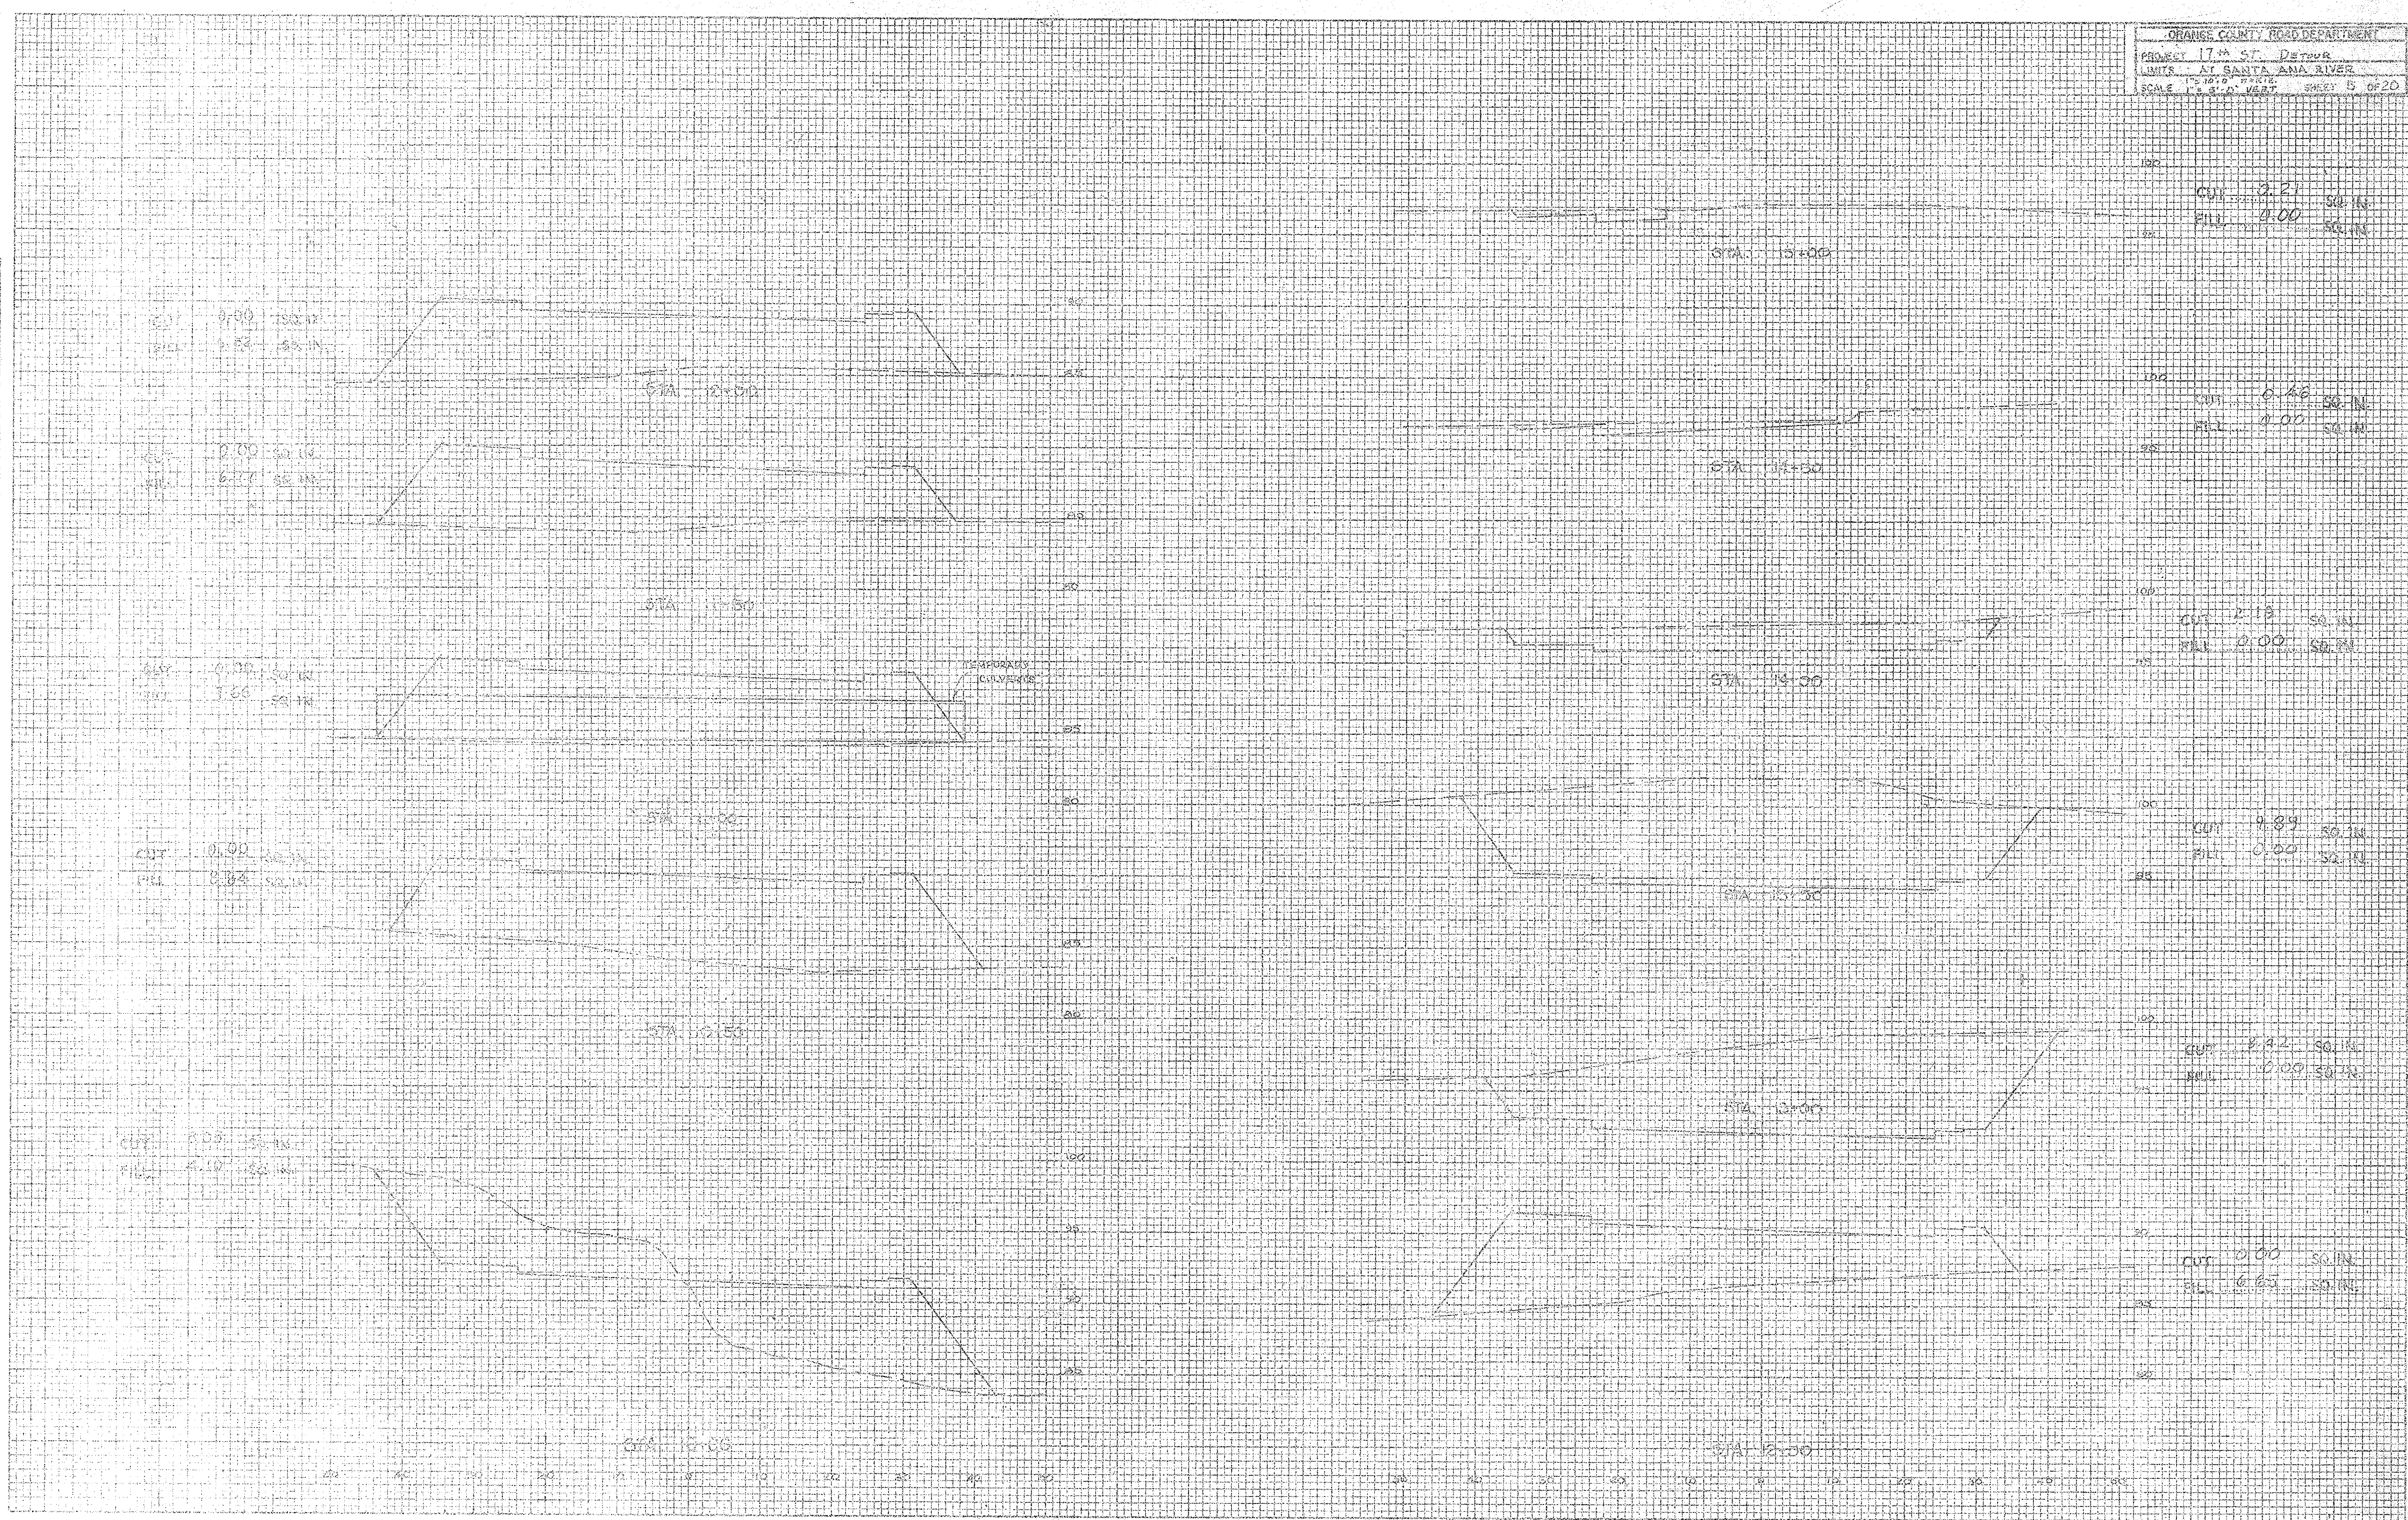

DR. #17(12215)