
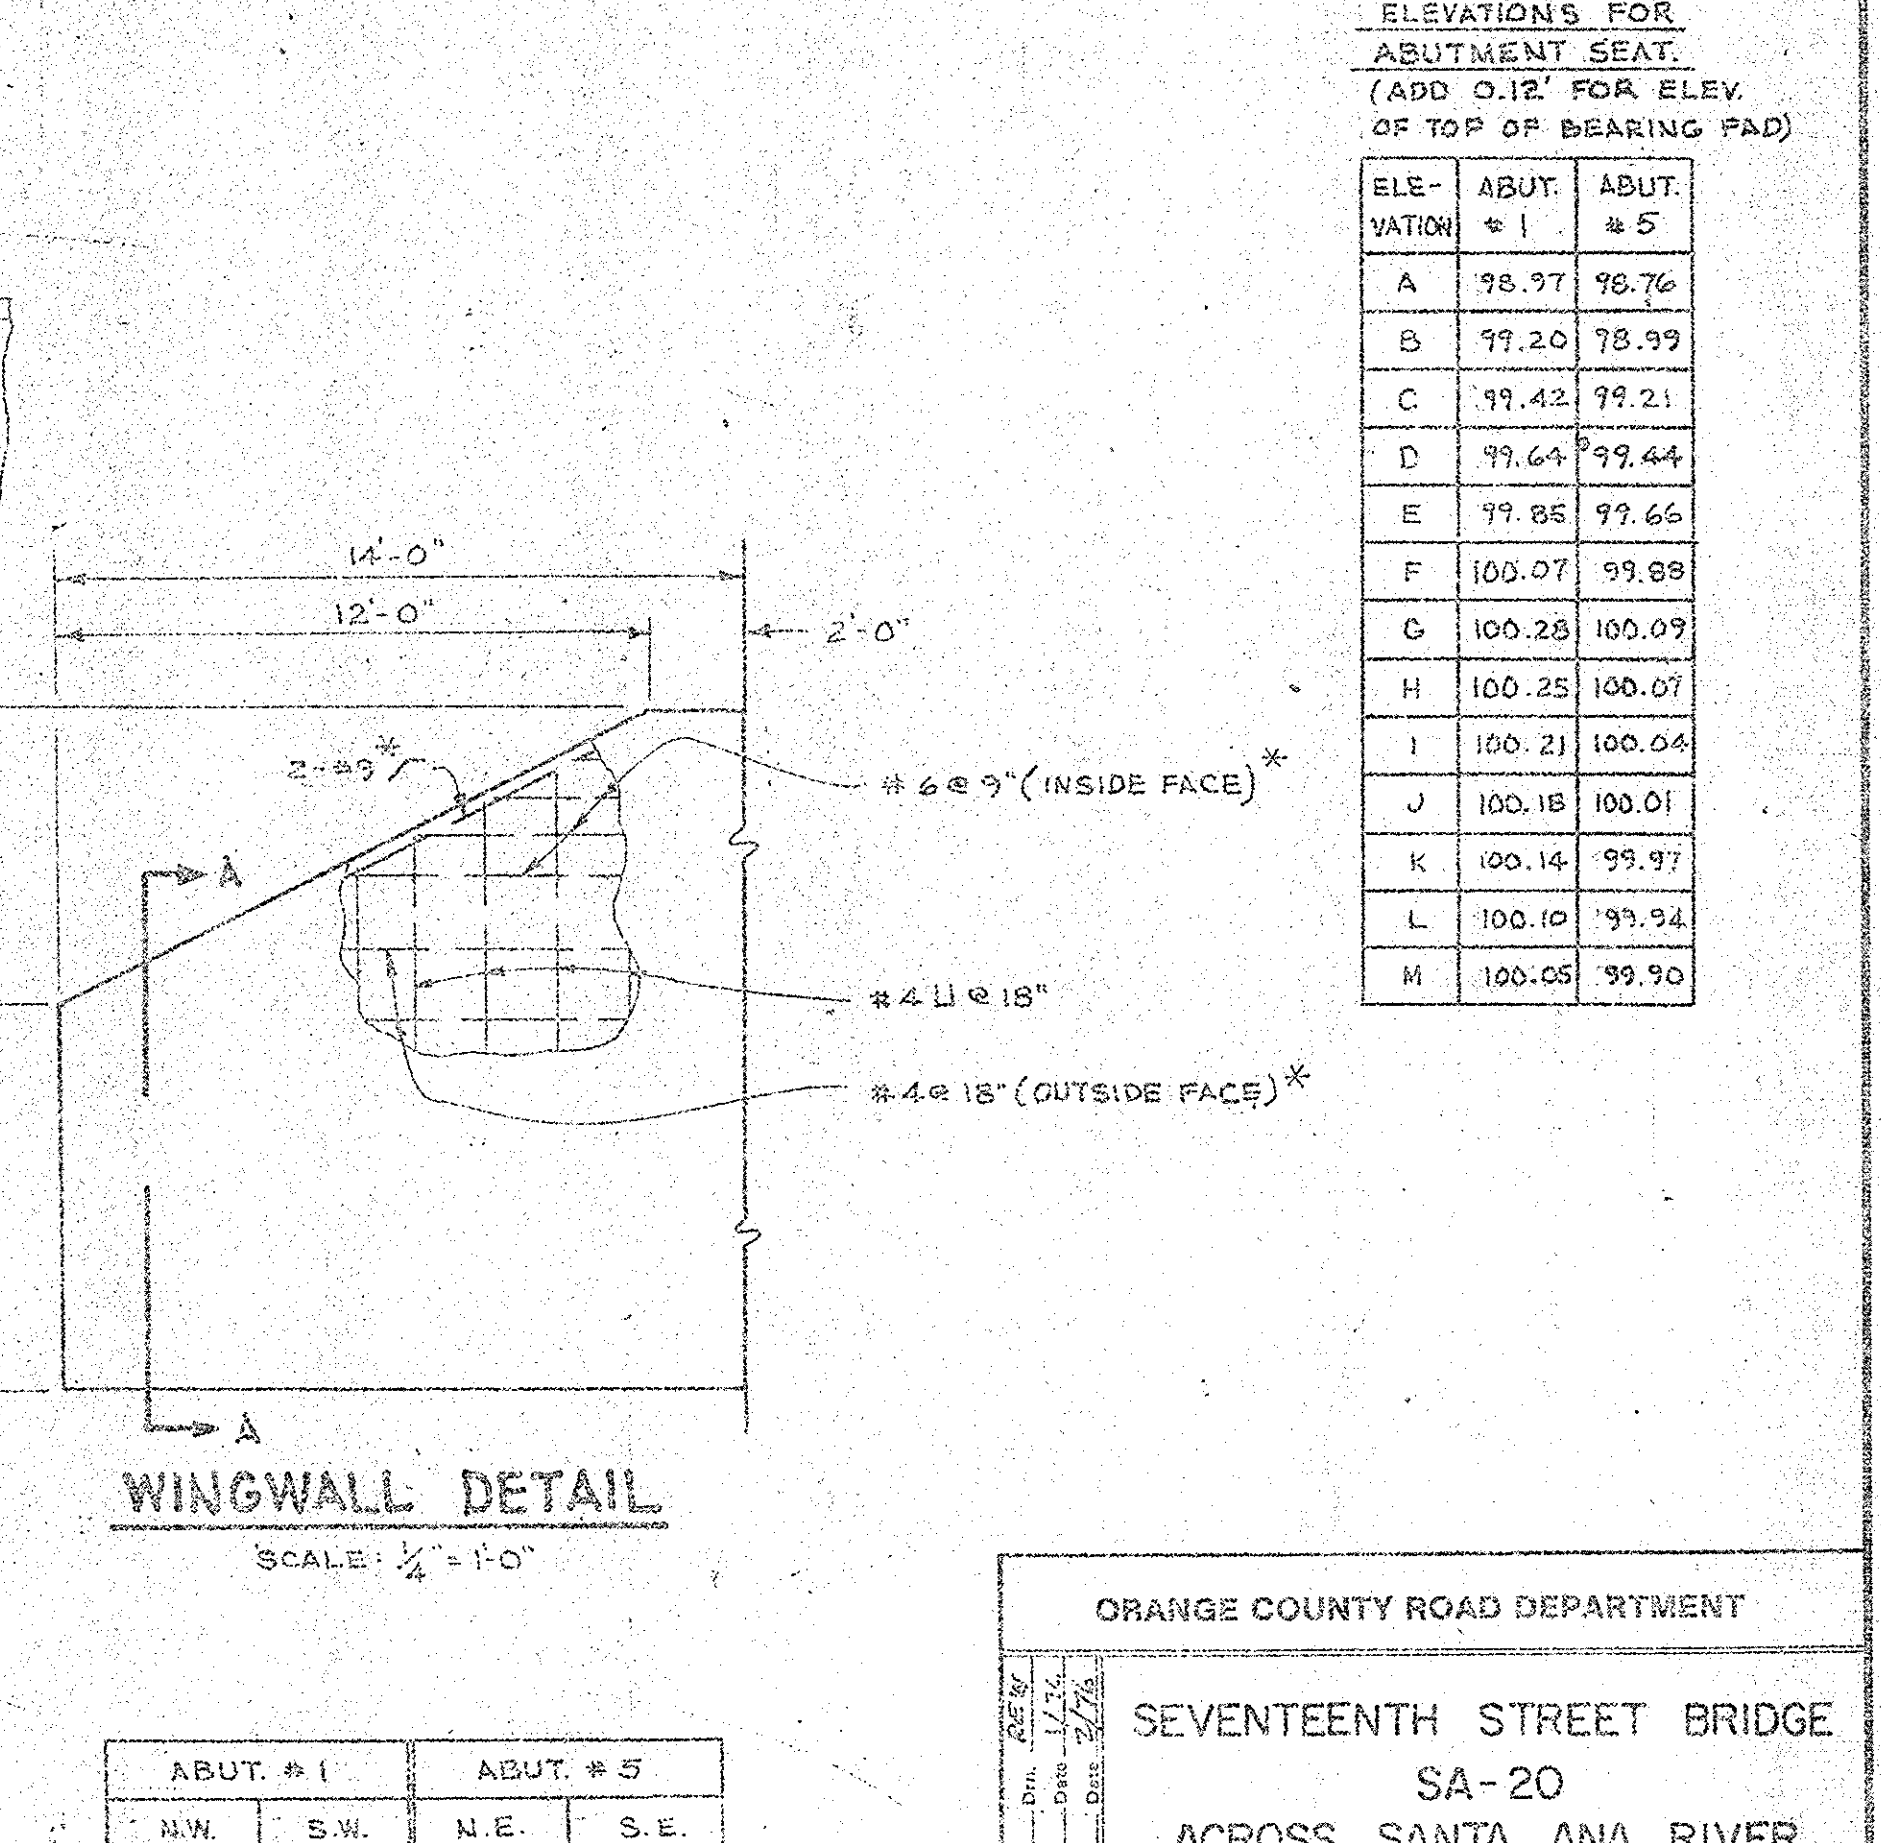
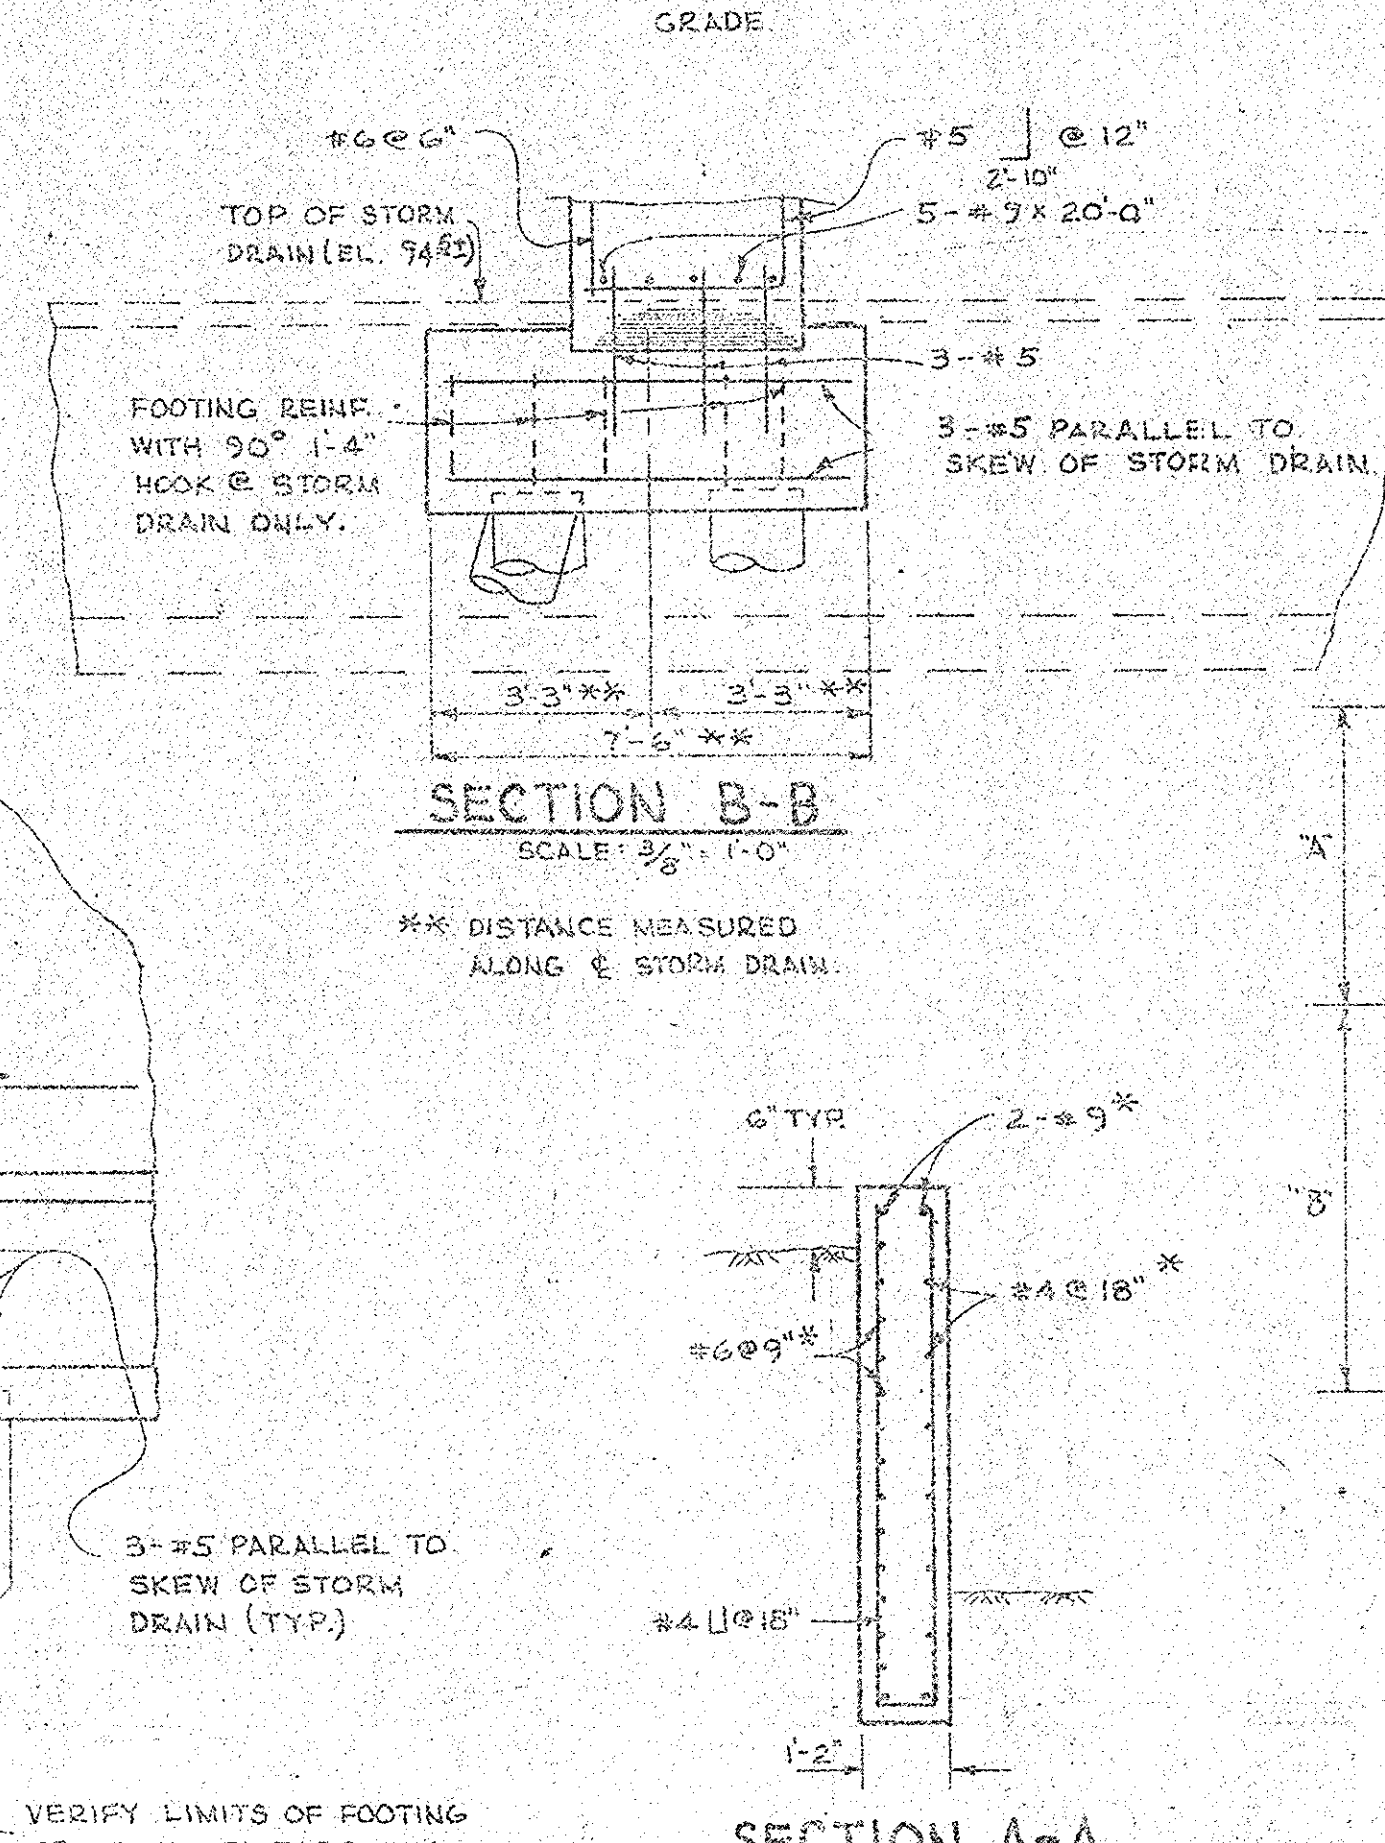
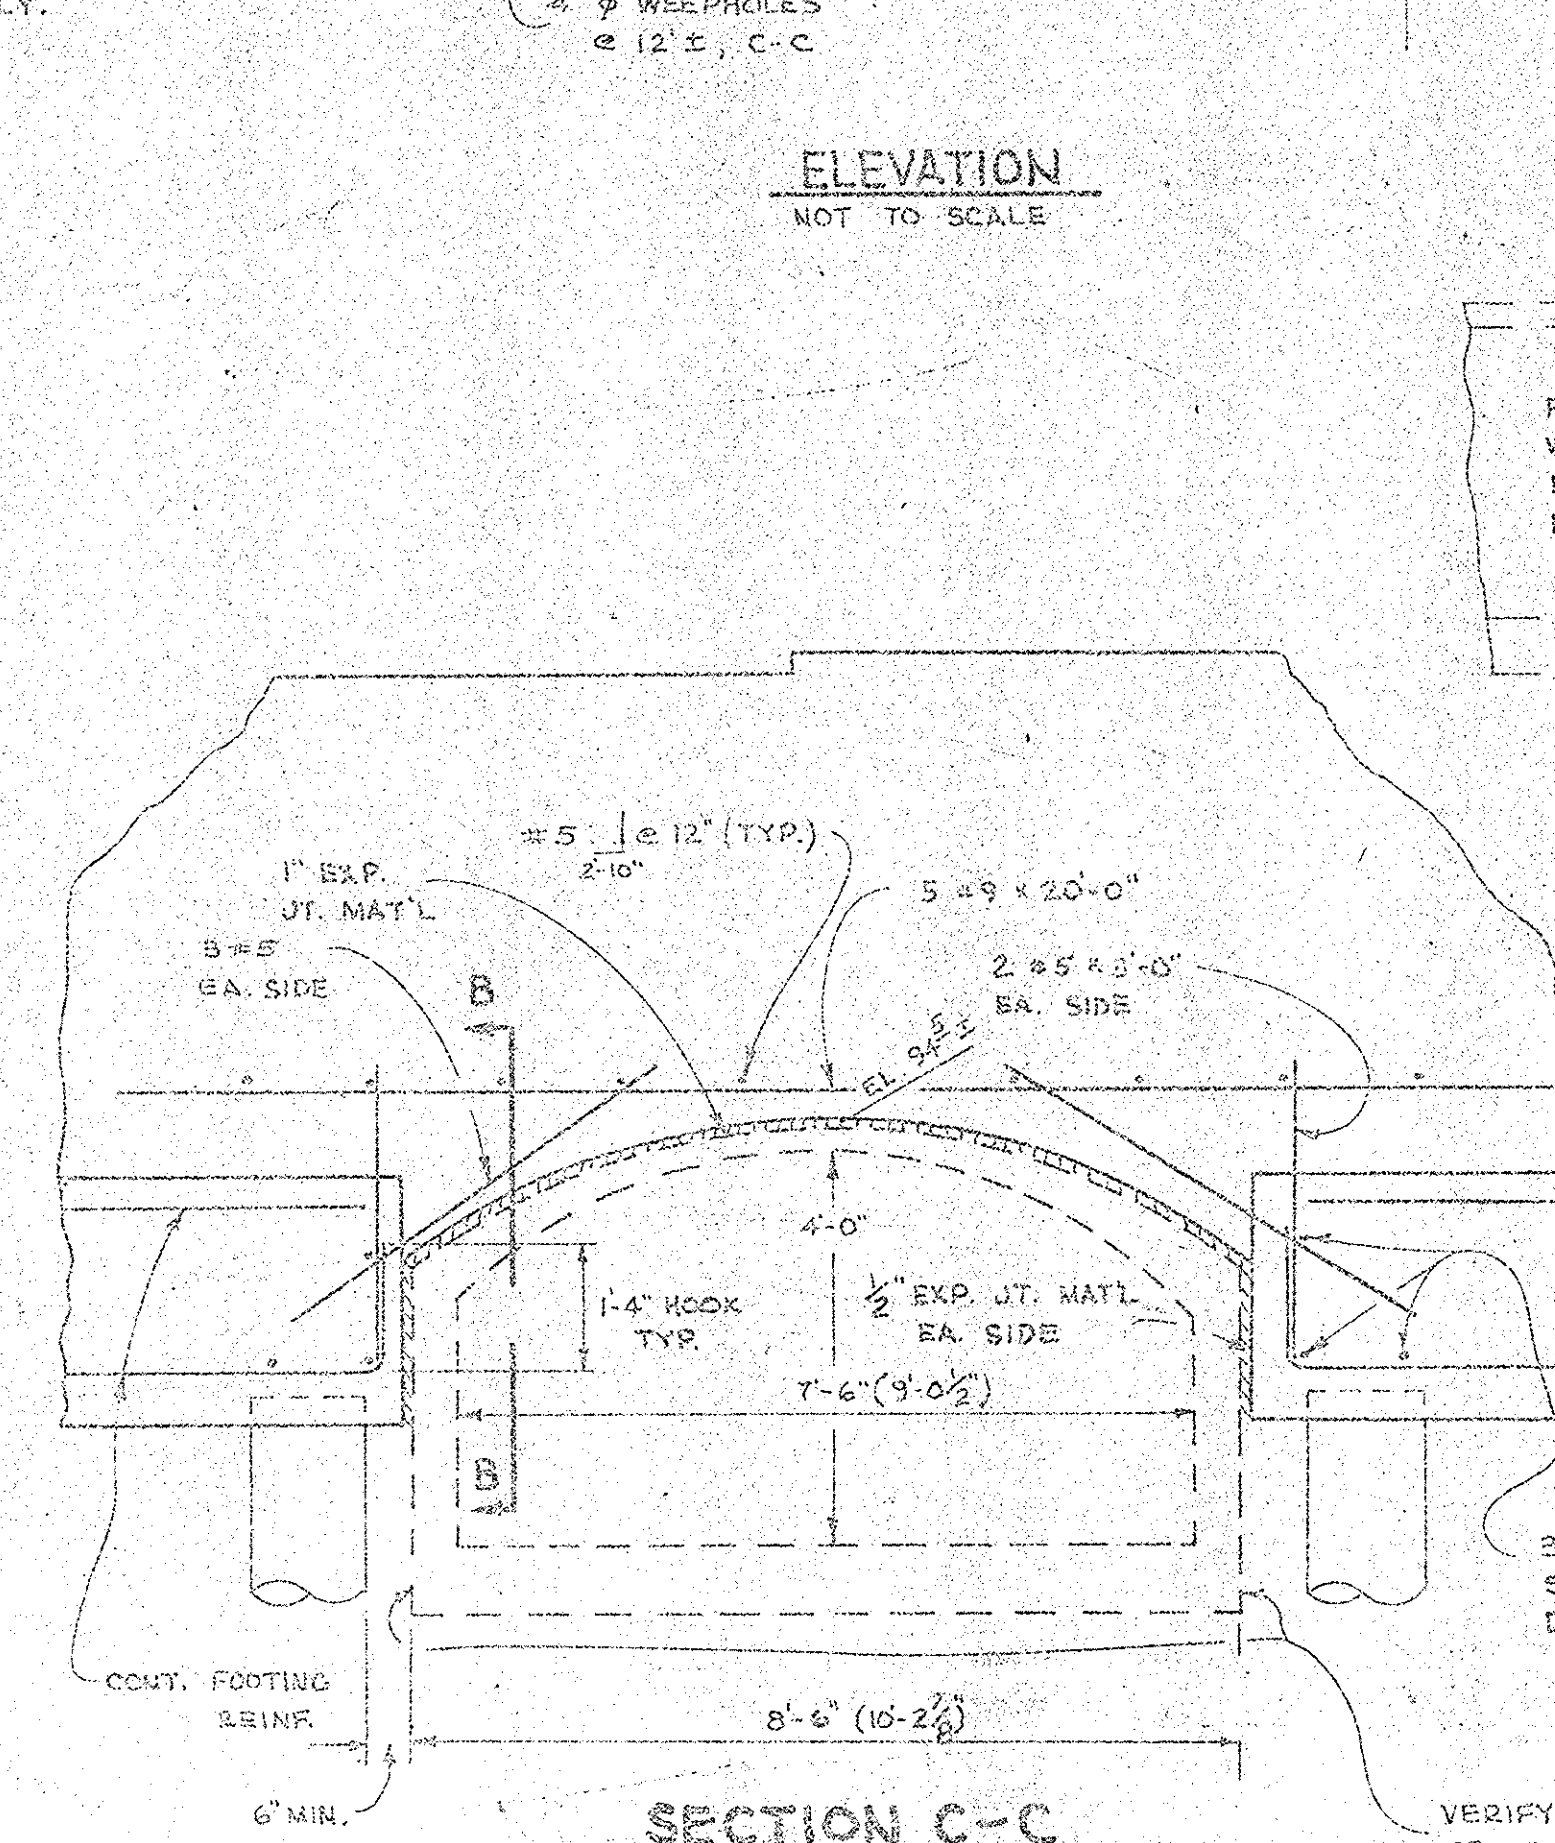
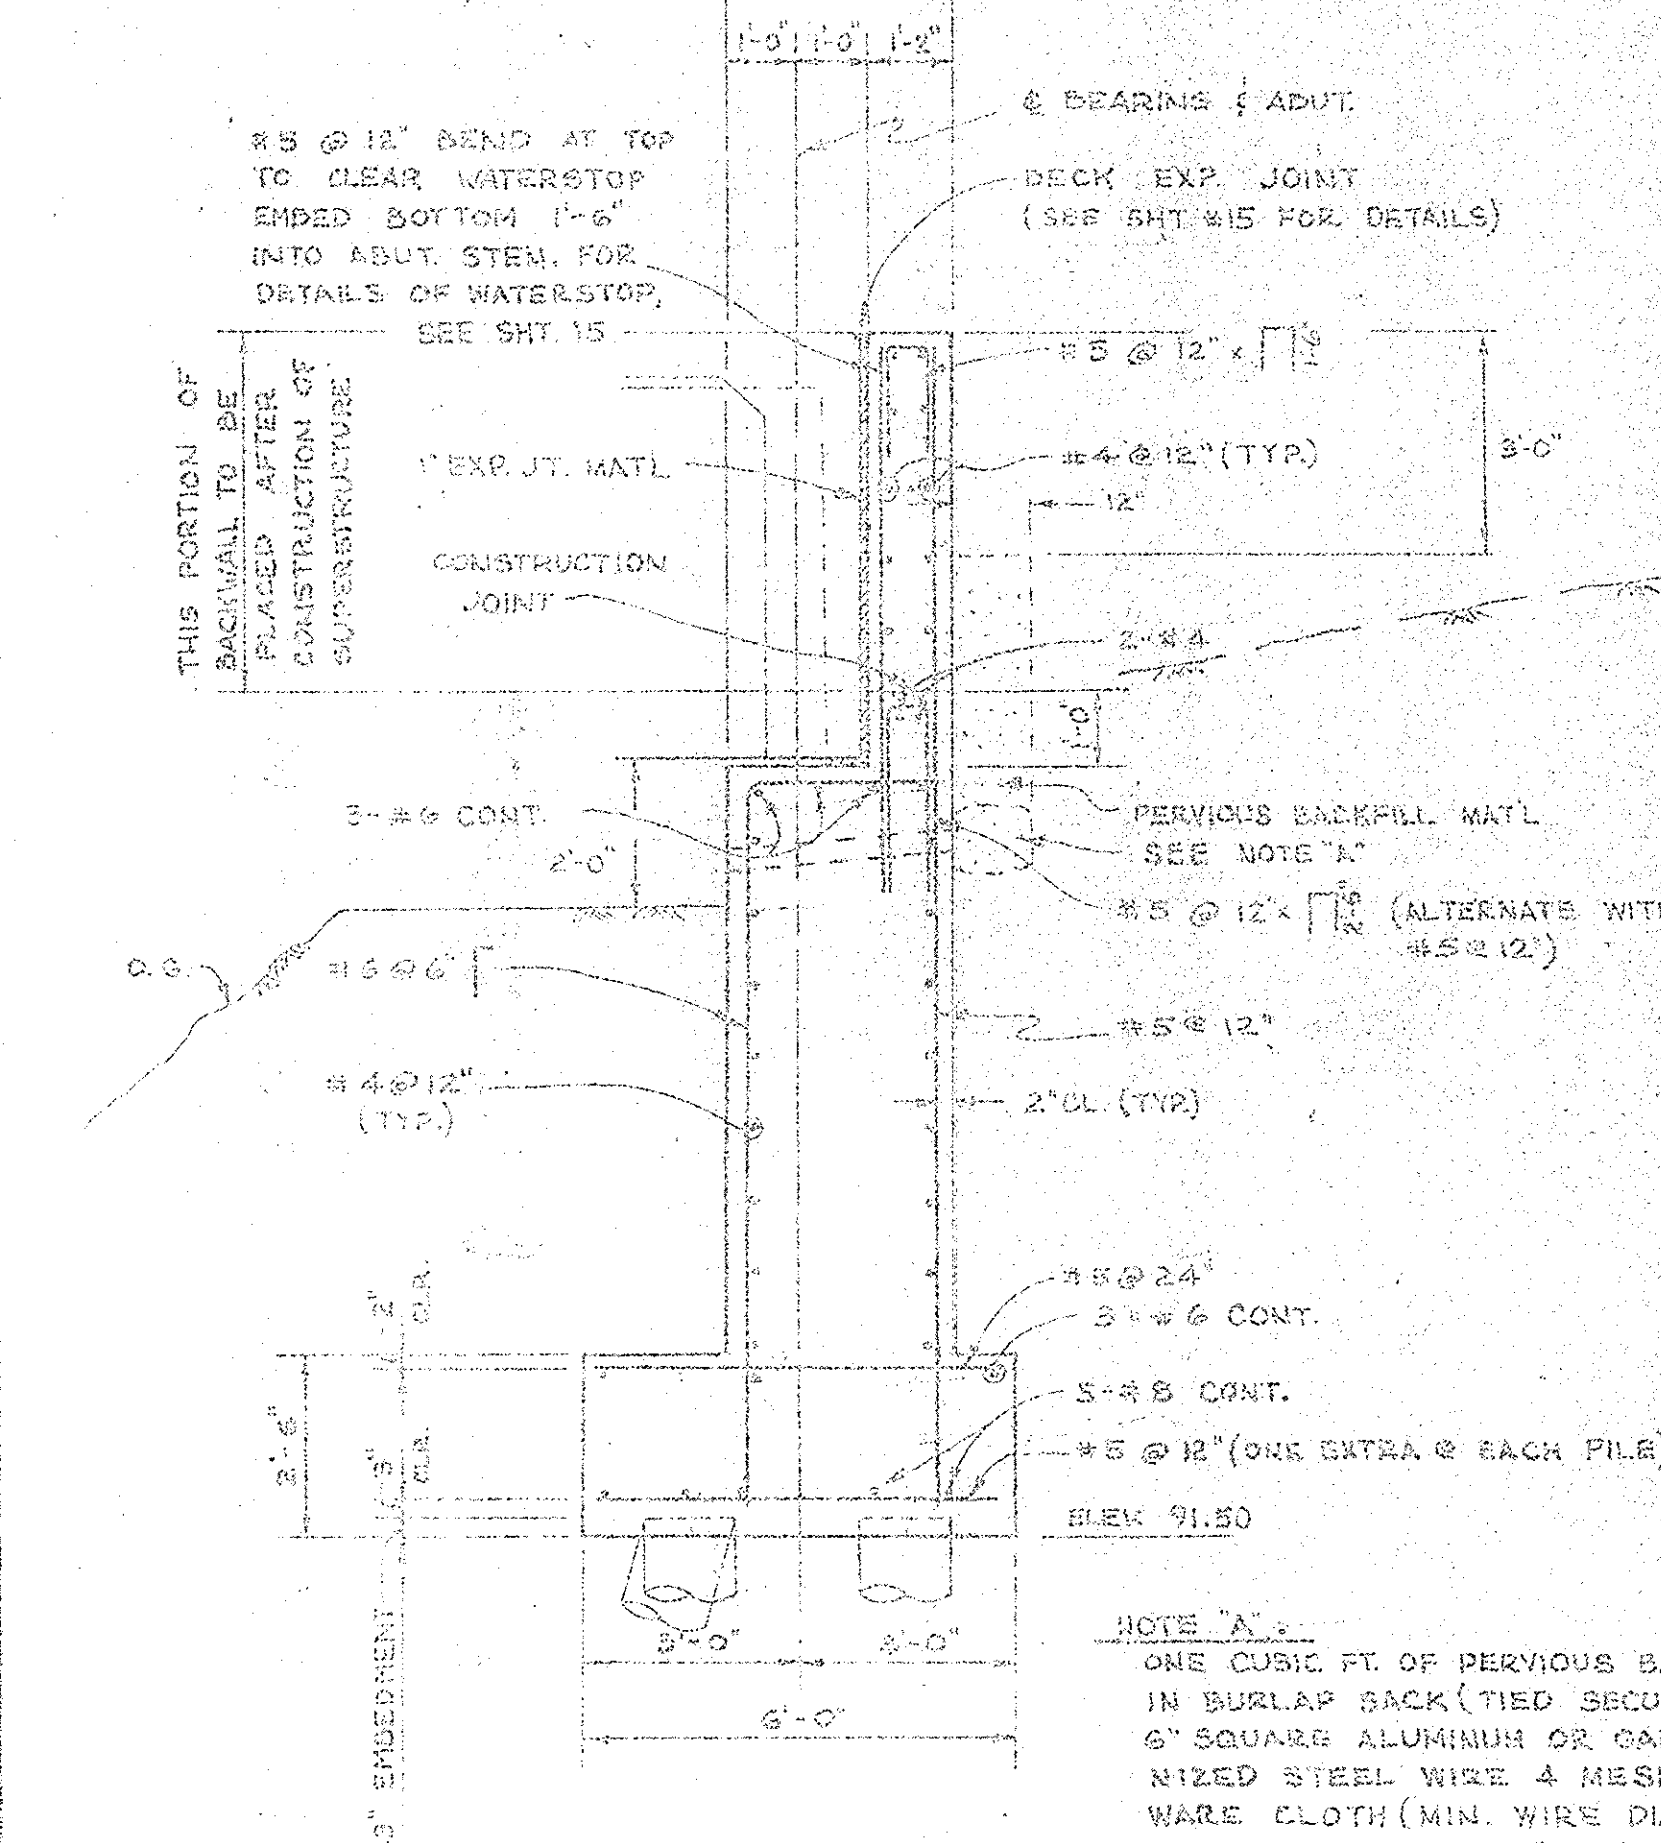


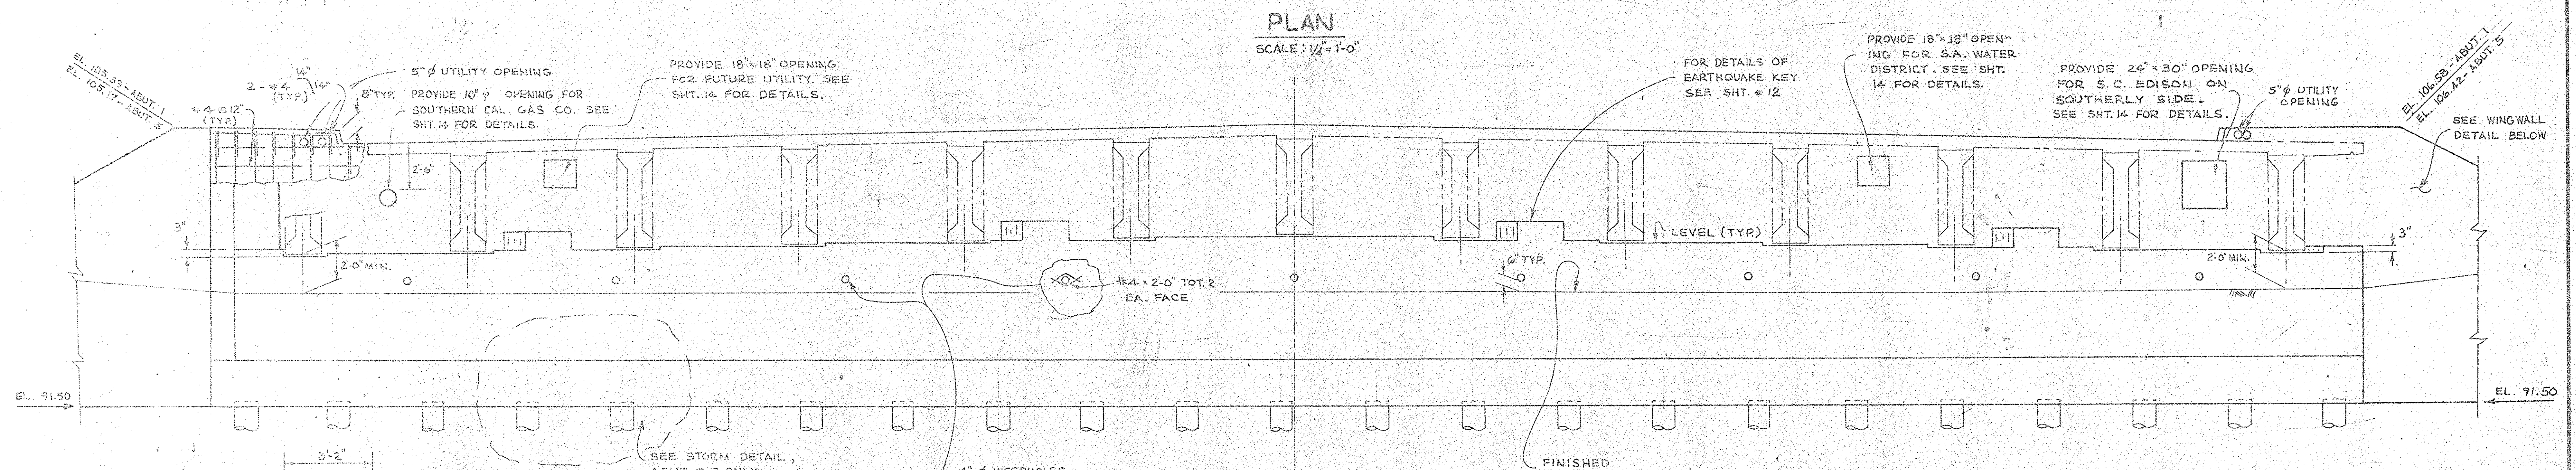

ELEVATIONS FOR ABUMENT SEAT. (ADD 0.12" FOR ELEV. OF TOP OF BEARING PAD)		
ELE- VATION	ABUT. # 1	ABUT. # 5
A	98.97	98.76
B	99.20	98.99
C	99.42	99.21
D	99.64	99.44
E	99.85	99.66
F	100.07	99.89
G	100.28	100.09
H	100.25	100.07
I	100.21	100.04
J	100.18	100.01
K	100.14	99.97
L	100.10	99.94
M	100.05	99.90

	ABUT. #1		ABUT. #5	
	N.W.	S.W.	N.E.	S.E.
"A"	8'-0"	7'-0"	7'-0"	8'-0"
"B"	7'-1"	6'-10"	6'-8"	6'-11"