

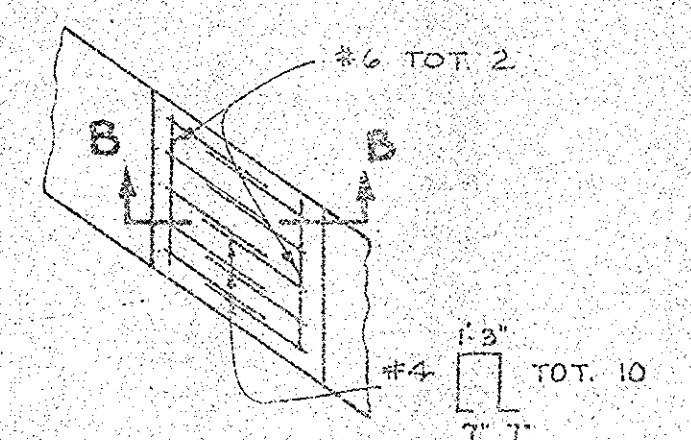
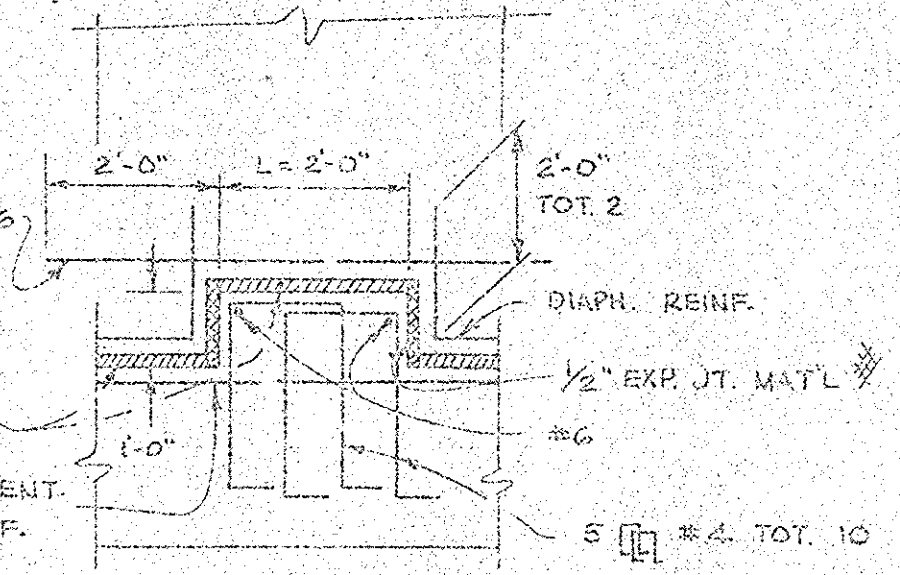
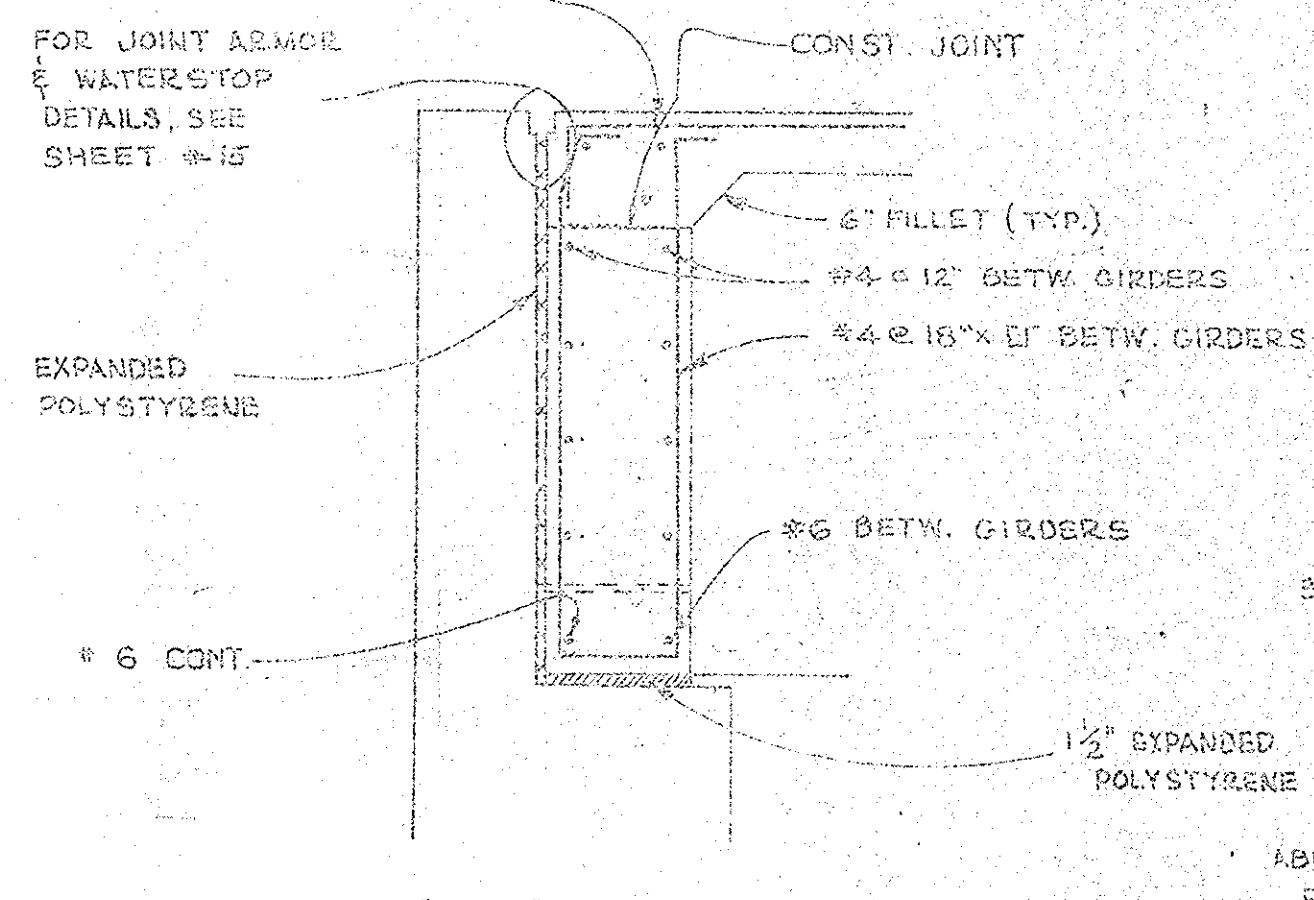
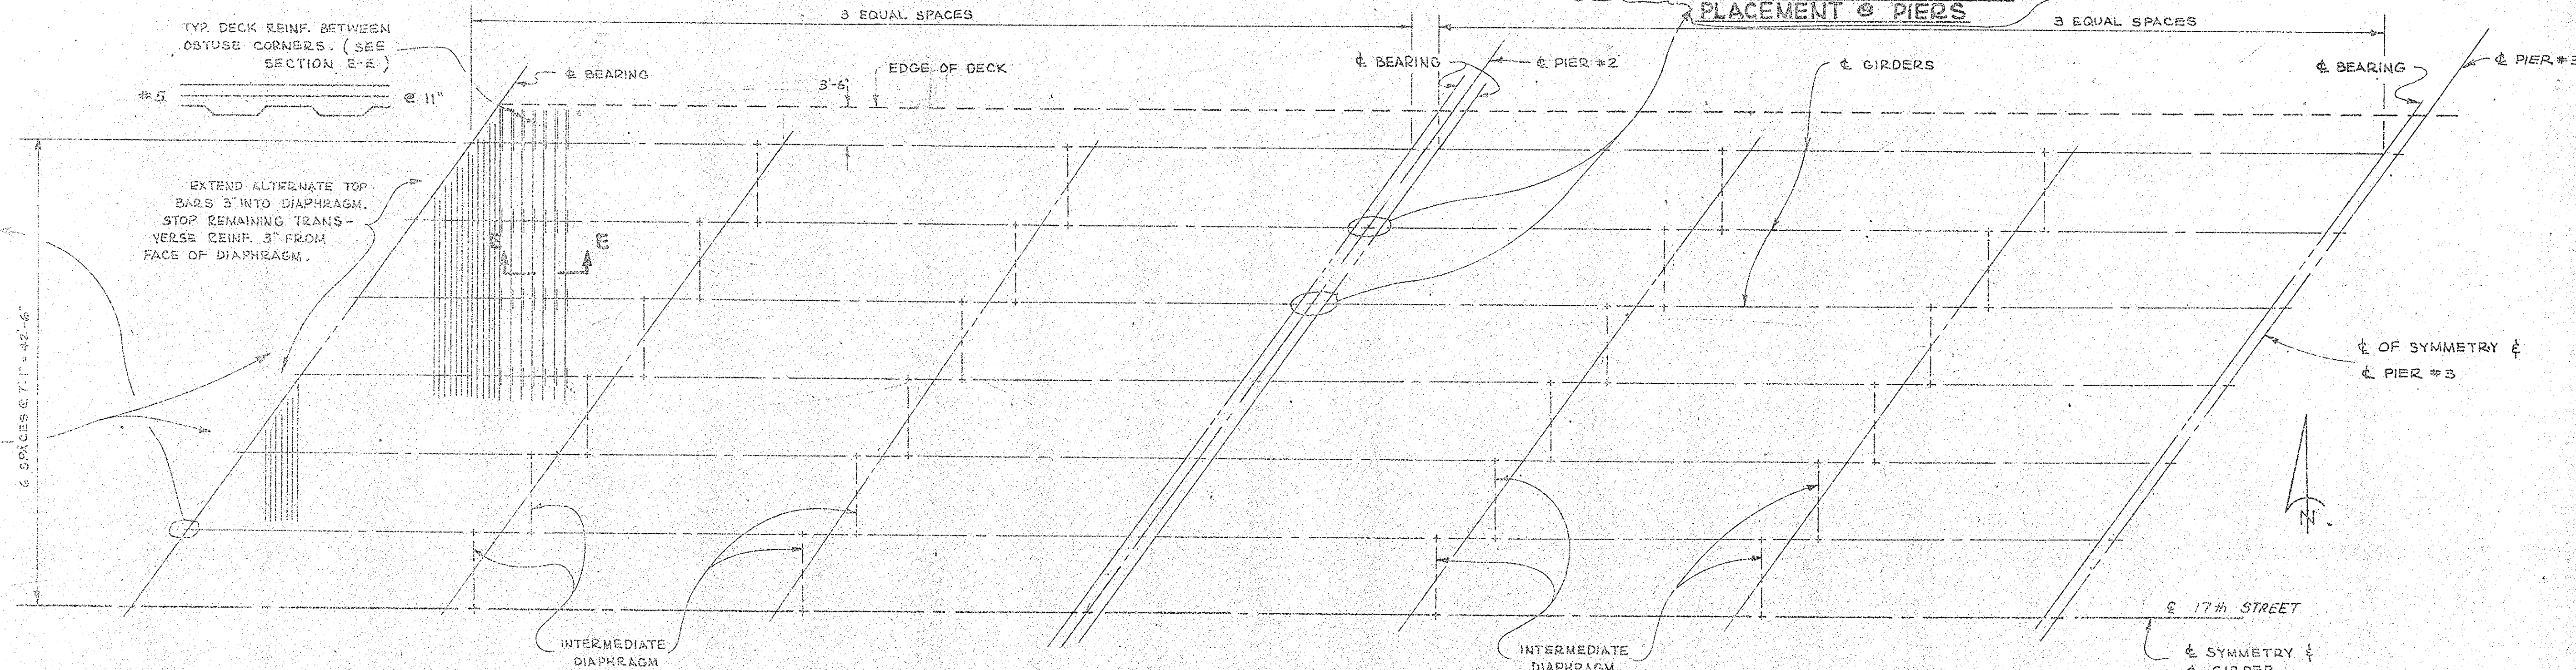
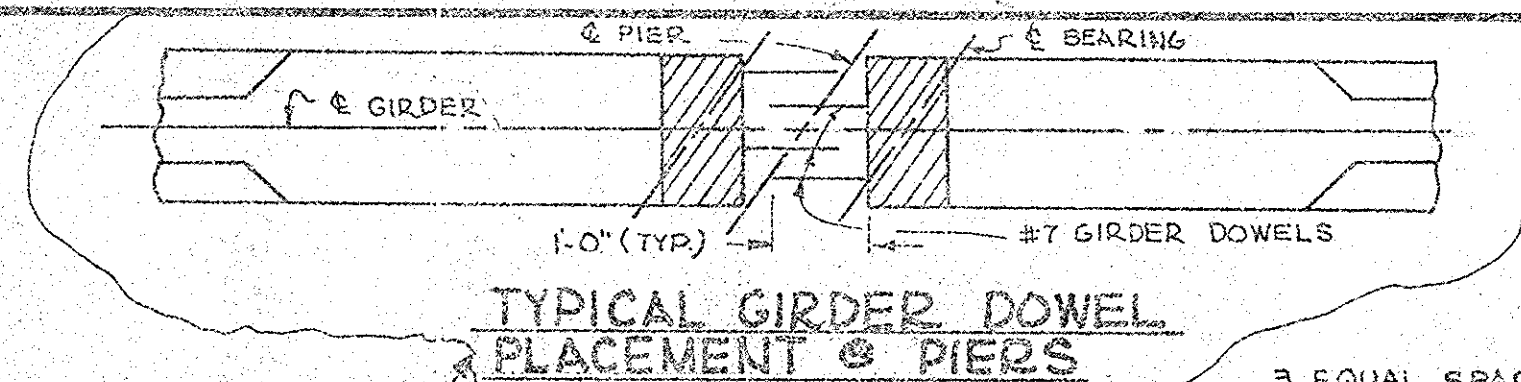
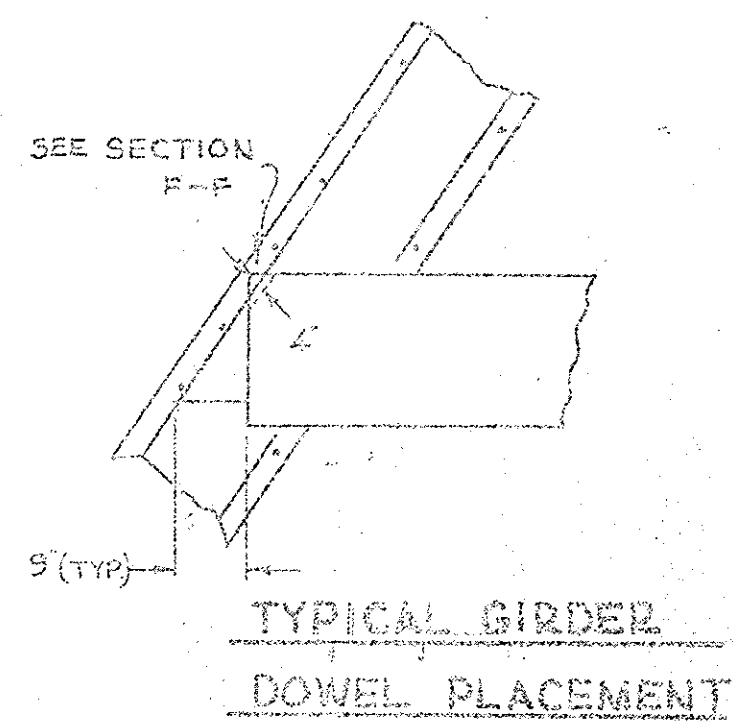
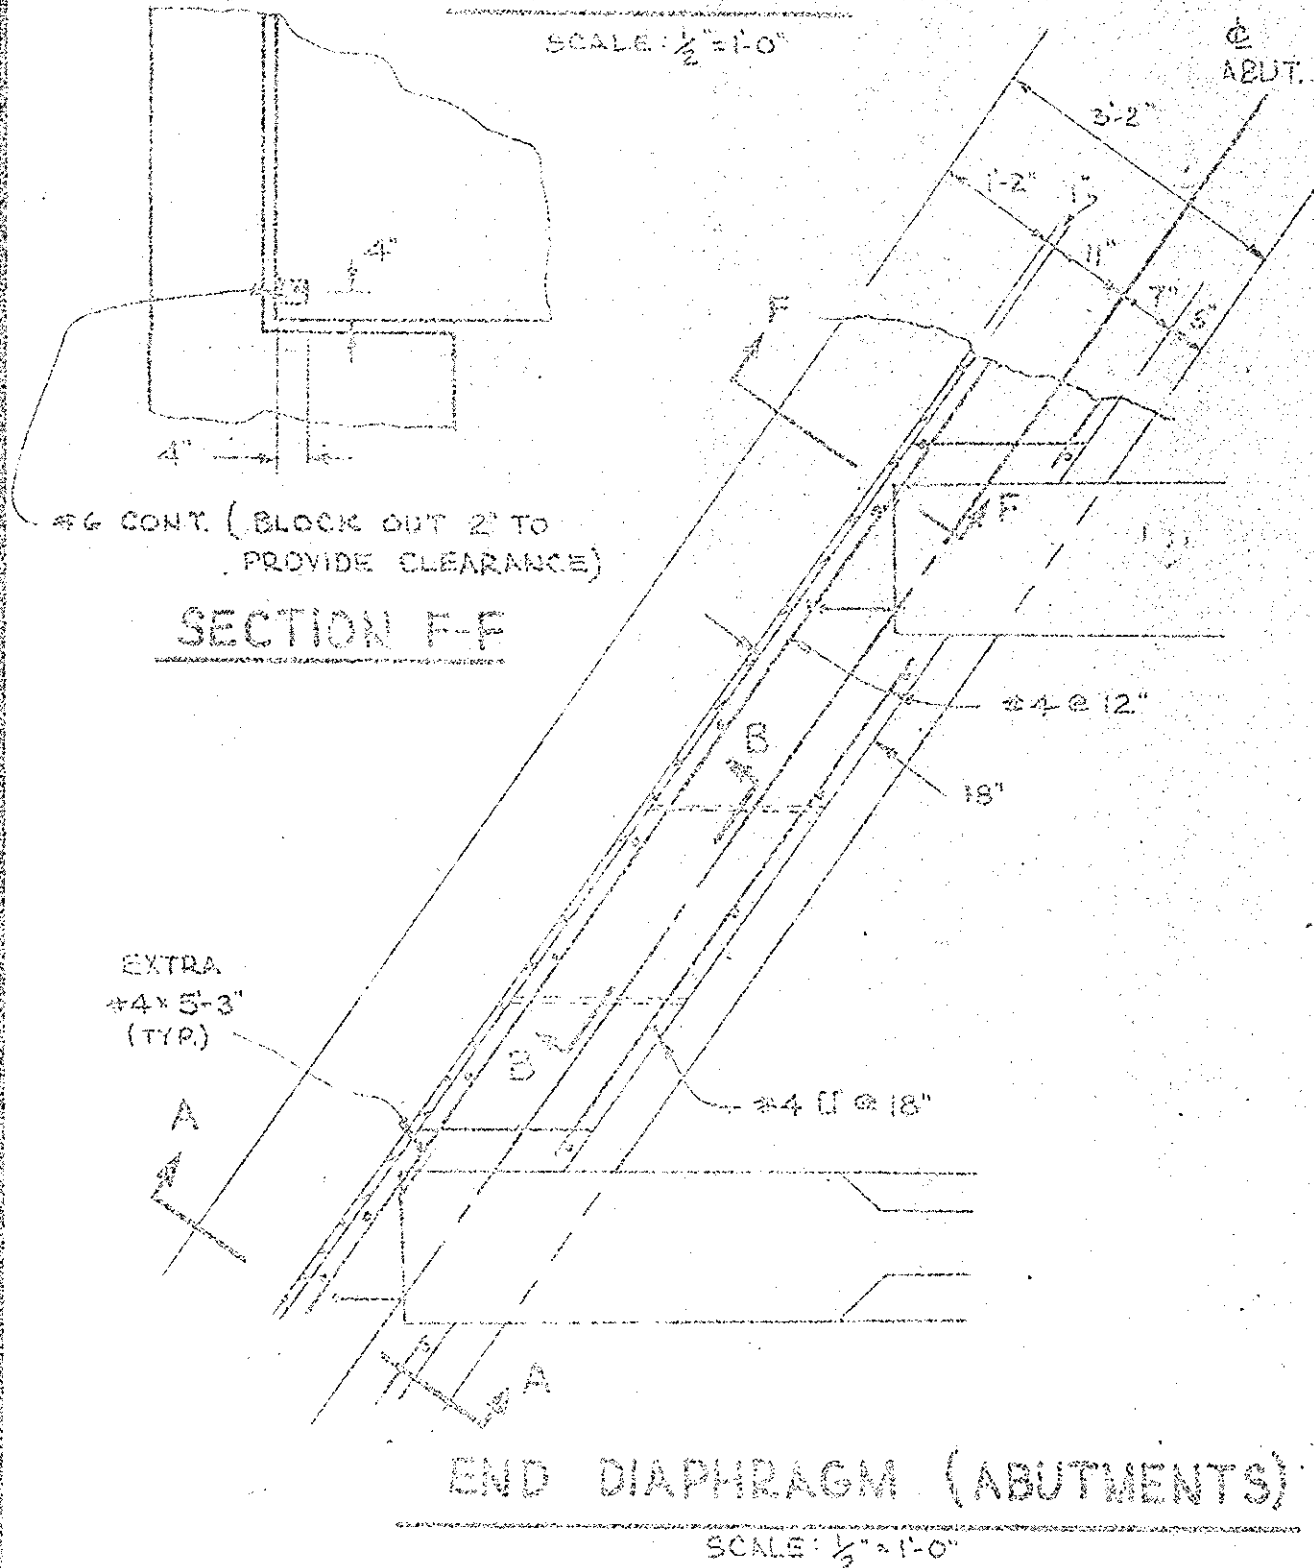


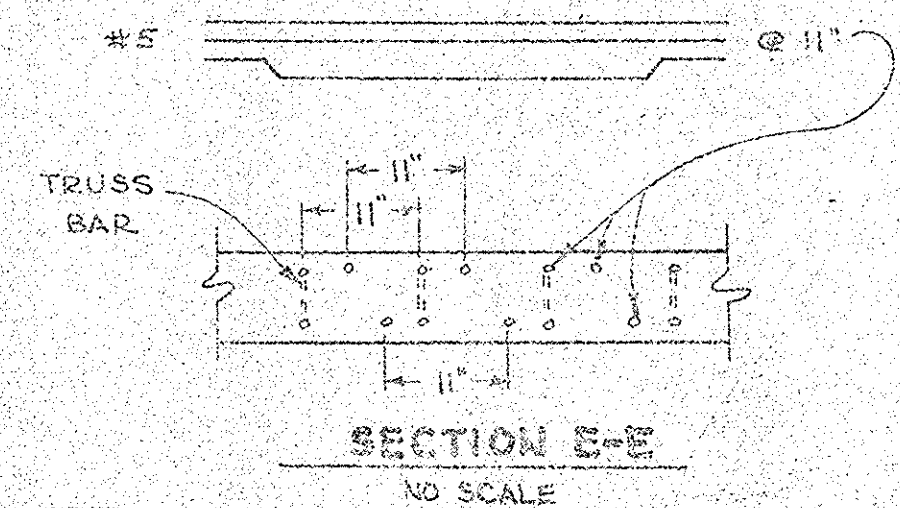

FRAMING PLAN
SCALE: 1/8" = 1'-0"



DECK PLACING NOTES

- THE CONTRACTOR SHALL SUBMIT A DECK PLACING SCHEDULE WHICH WILL BE SUBJECT TO THE APPROVAL OF THE ENGINEER. THE INTERMEDIATE AND END DIAPHRAGMS SHALL BE PLACED FIVE DAYS BEFORE THE DECK.
- IF THE ENTIRE DECK IS NOT PLACED IN ONE OPERATION, THE FOLLOWING CONDITION SHALL BE PROVIDED FOR:
1. TRANSVERSE JOINTS SHALL BE LOCATED AT ABOUT THE 1/4 POINT OF SPAN, AND THE PORTION OVER THE SUPPORTS PLACED LAST.
 2. LONGITUDINAL JOINTS SHALL BE LOCATED AT THE EDGE OF A TRAFFIC LANE.
 3. A SEPARATE CLOSURE POUR AT LEAST TWO FEET WIDE WILL BE REQUIRED WHERE A LONGITUDINAL JOINT IS USED. THE CLOSURE SHALL NOT BE PLACED UNTIL THREE DAYS AFTER THE ADJACENT DECKS (SEE DETAIL SHT. 14).
 4. REINFORCING STEEL SHALL BE CONTINUOUS THROUGH ALL CONSTRUCTION JOINTS.

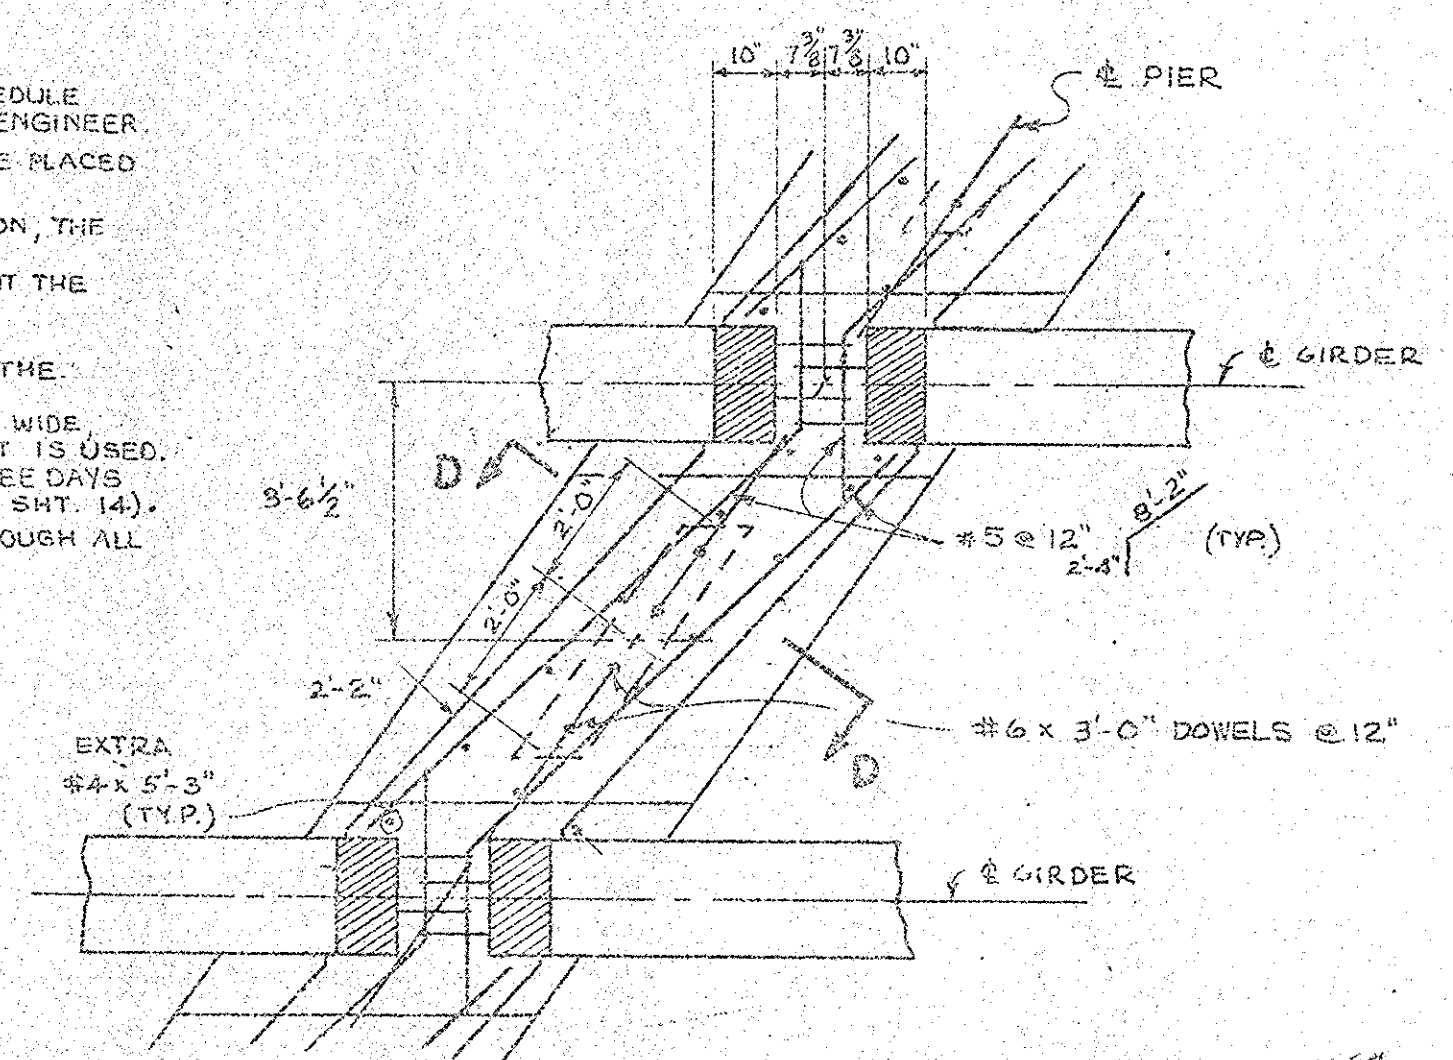

SECTION B-B
NO SCALE
NOTE: FOR LOCATION OF EARTHQUAKE KEYS, SEE SHT. #8

PLAN VIEW OF ABUTMENT KEY
SCALE: 1/2" = 1'-0"

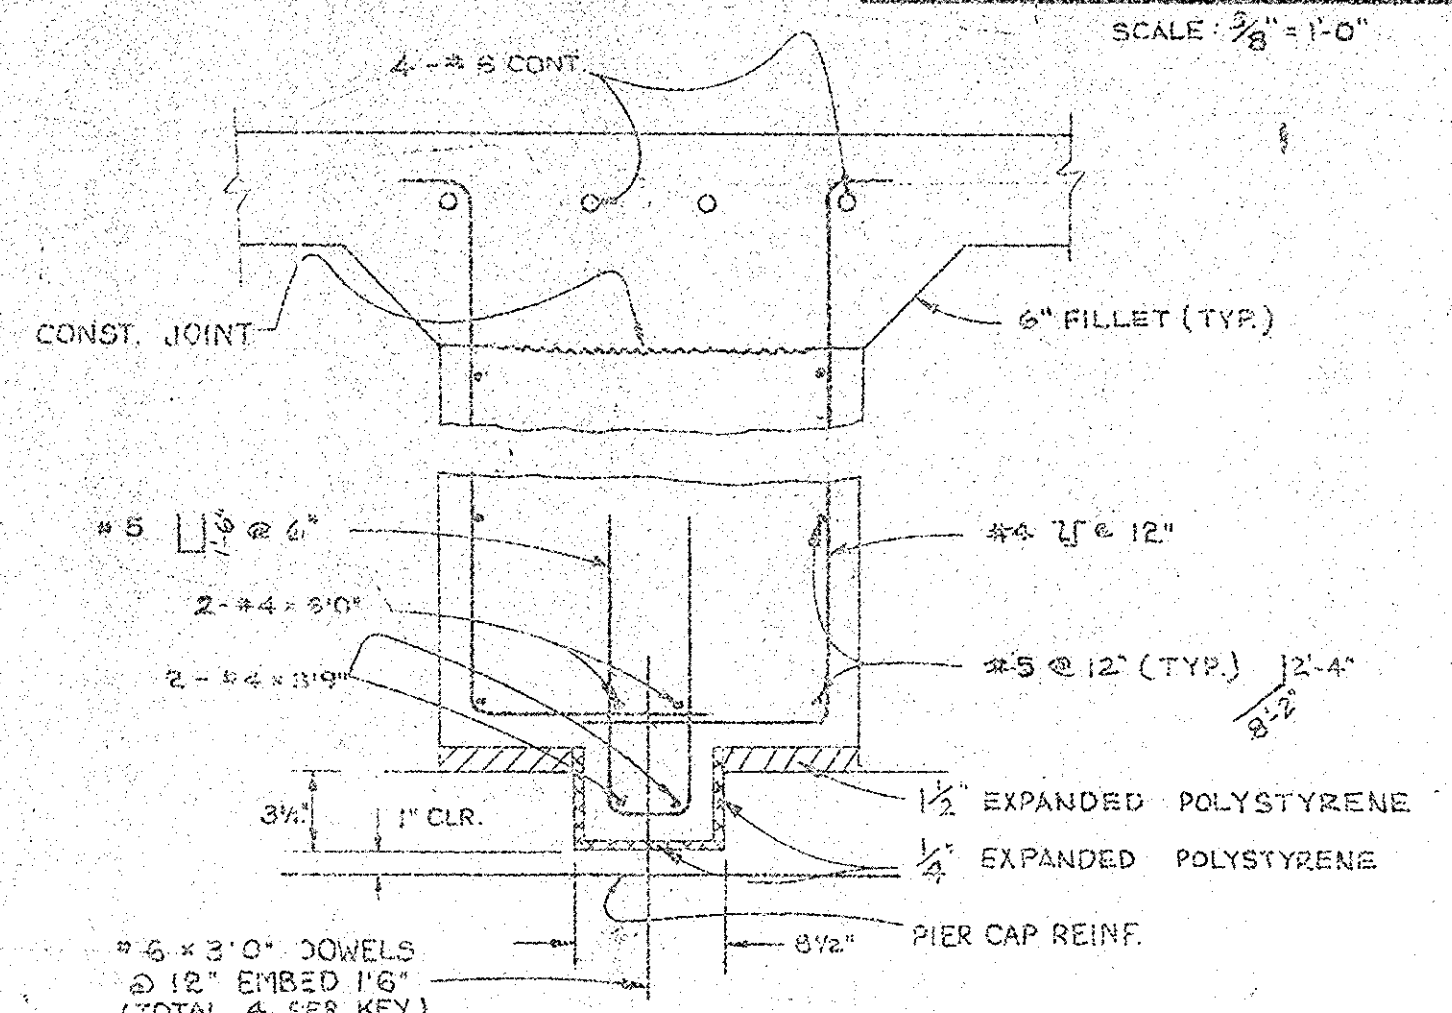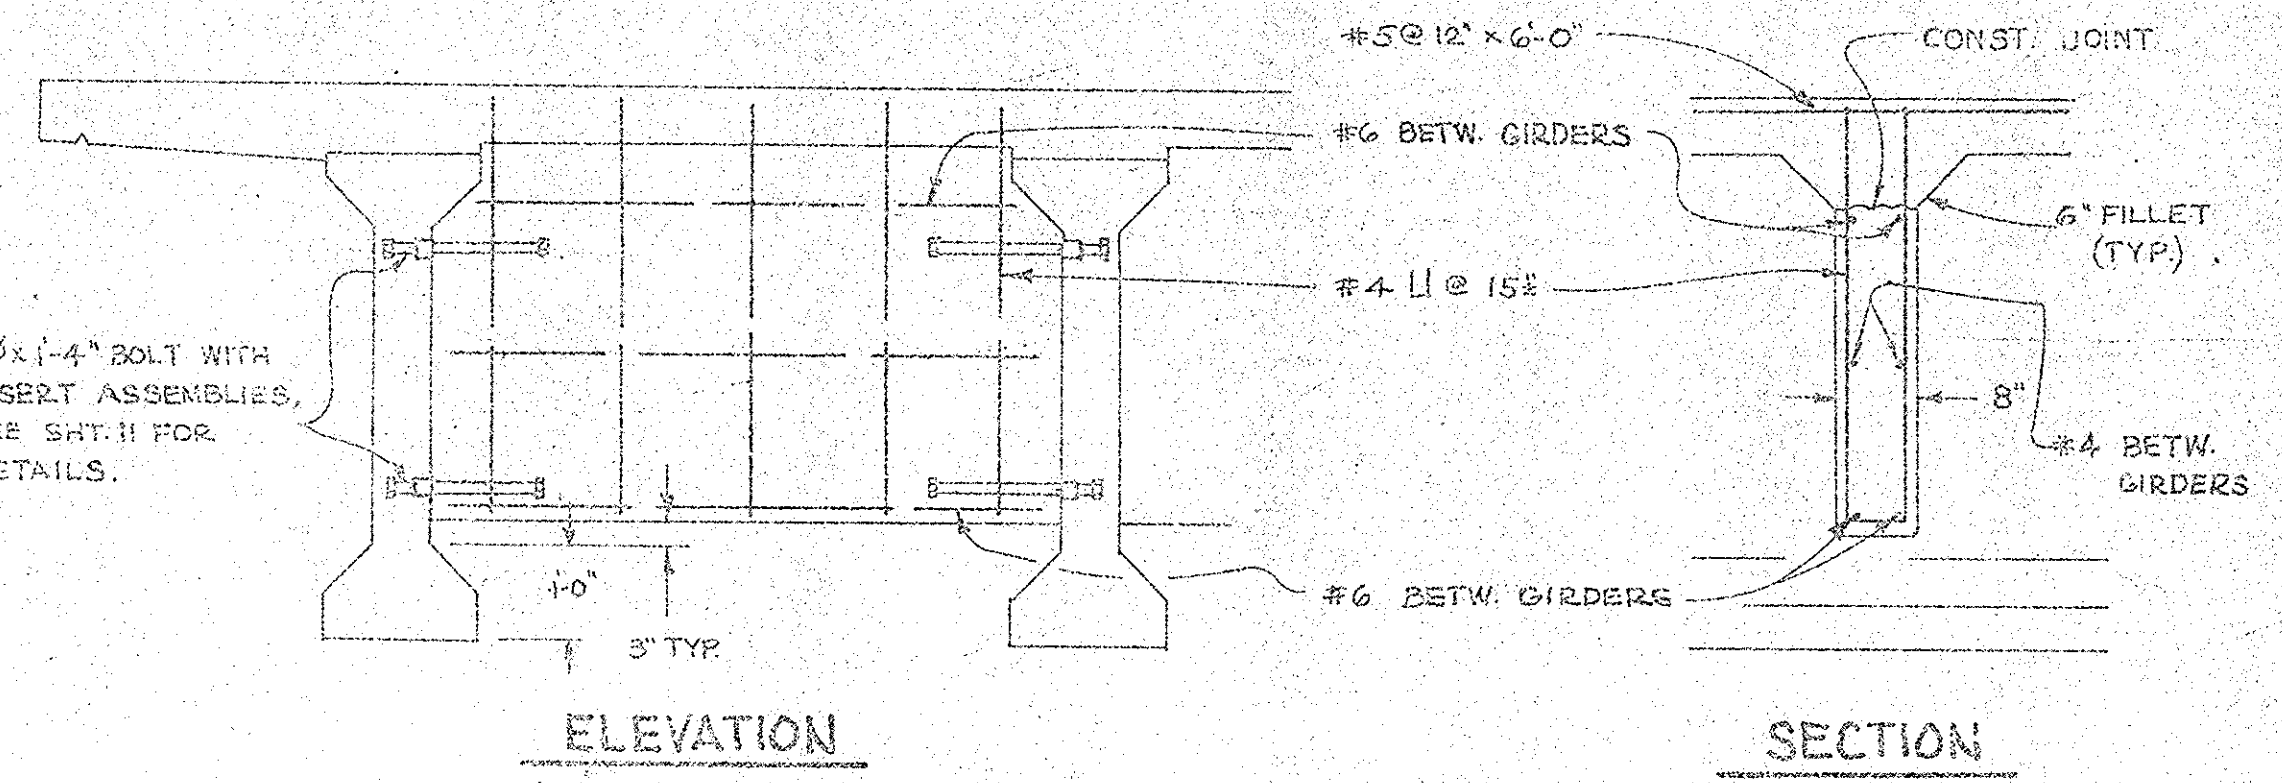

ORANGE COUNTY ROAD DEPARTMENT	
SEVENTEENTH STREET BRIDGE	
SA-20	
ACROSS SANTA ANA RIVER	
FRAMING PLAN B	
DIAPHRAGM DETAILS	
AS SHOWN	SHEET 12 OF 20

NO 17 7/12 1/2