
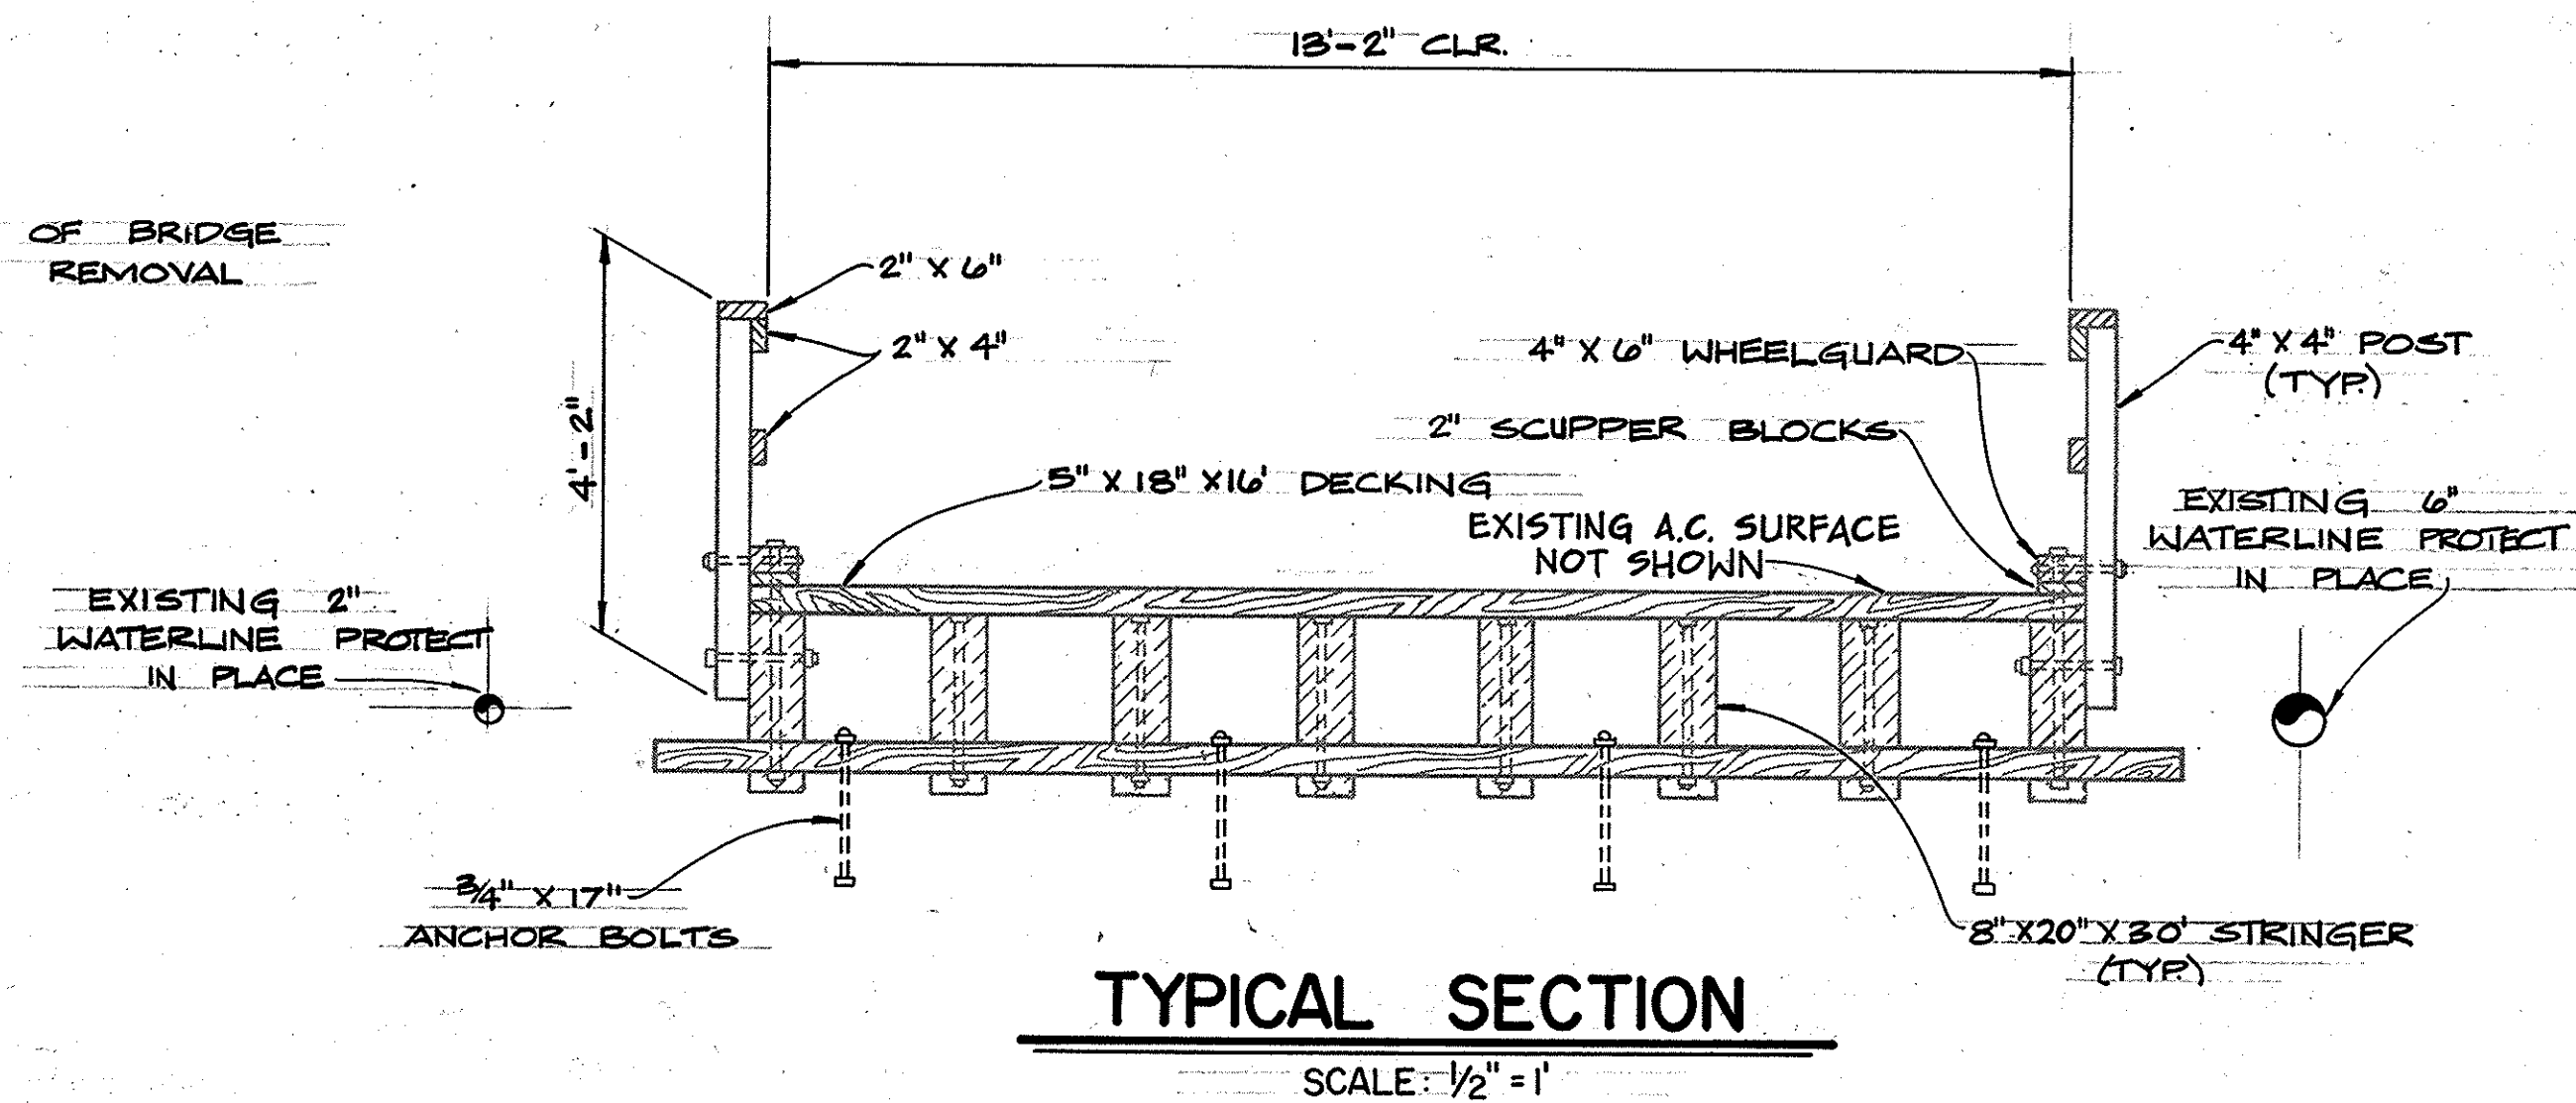
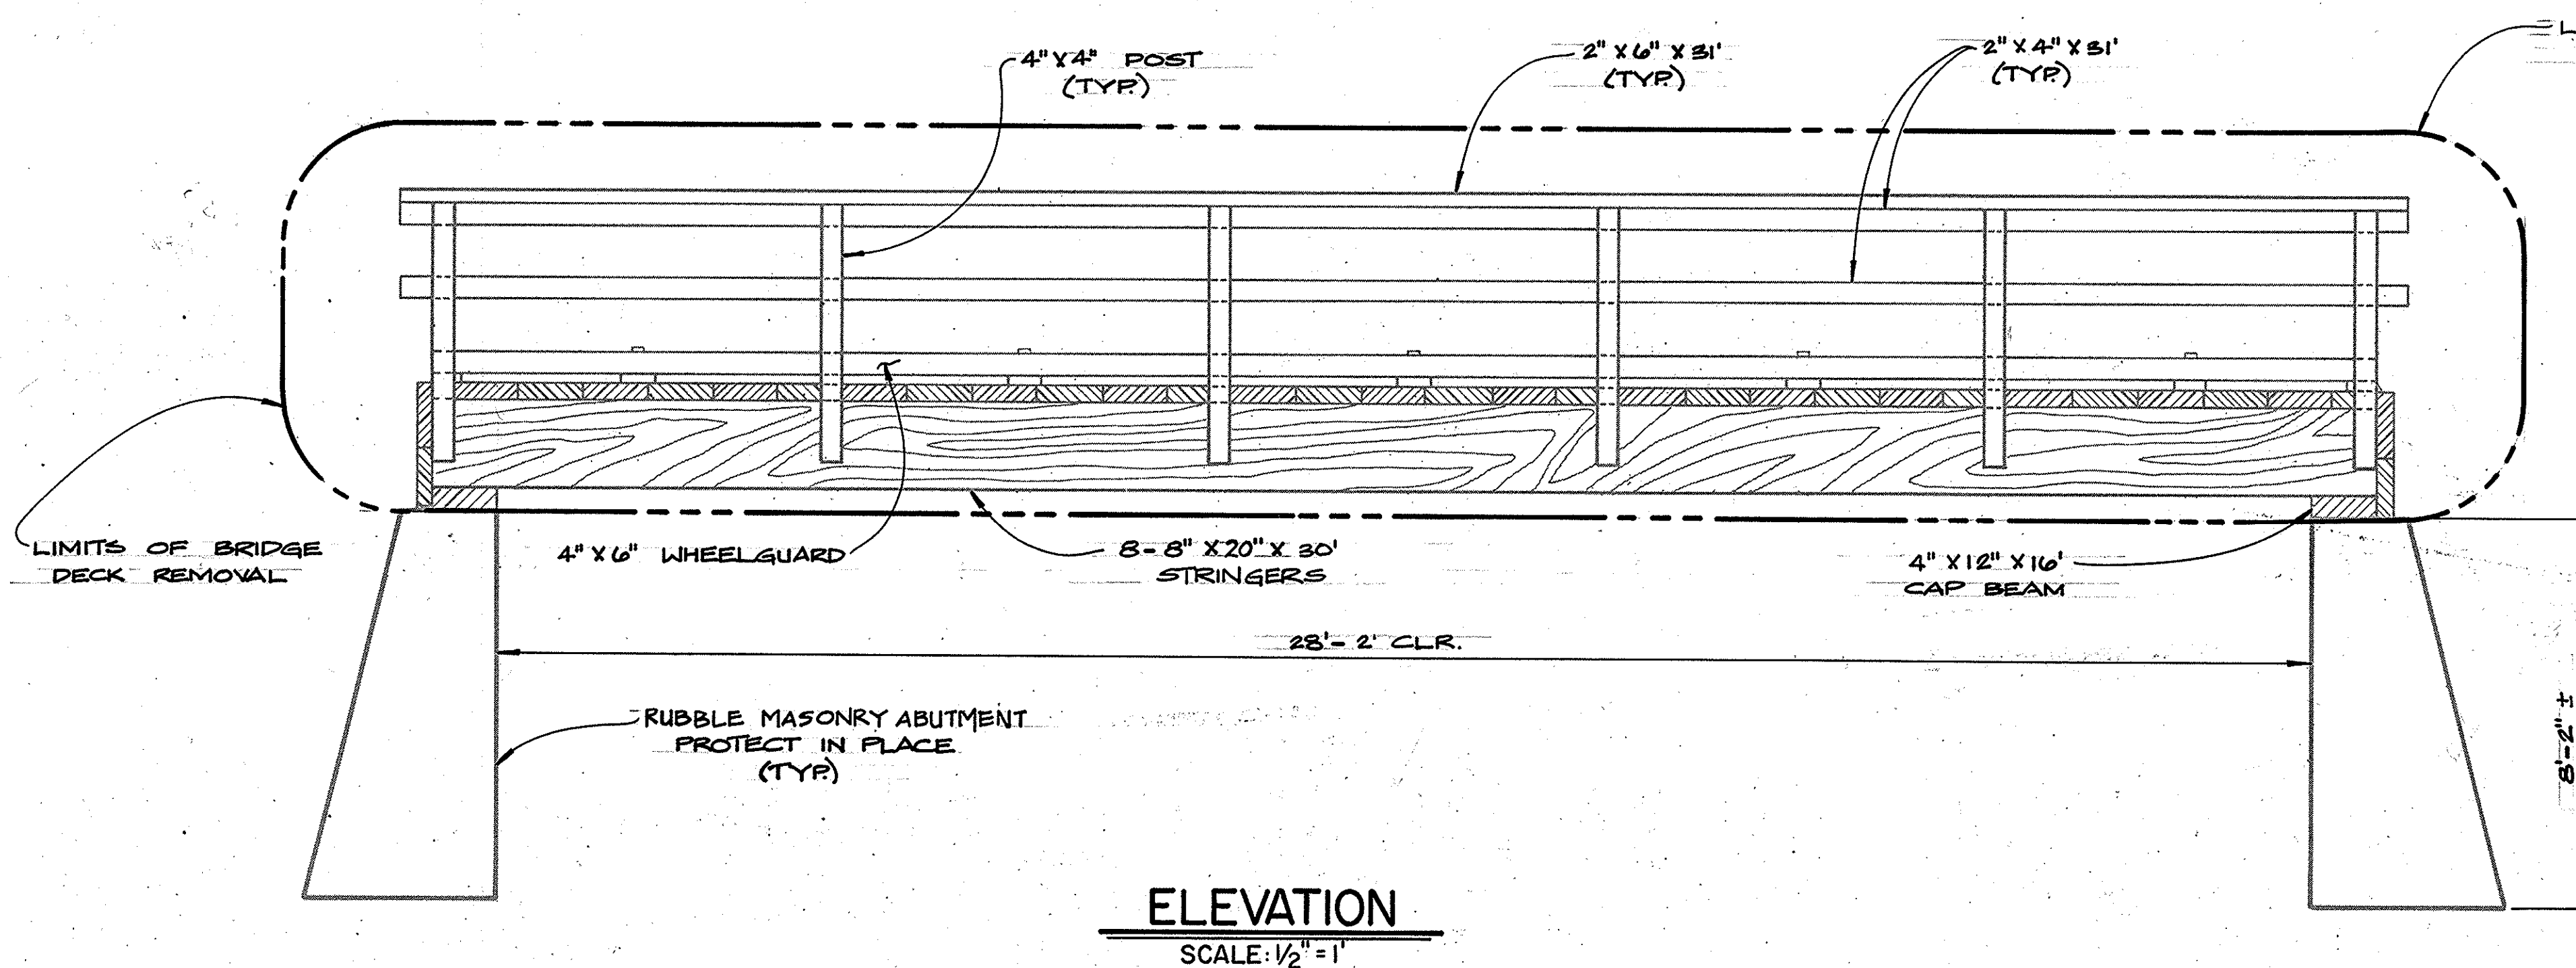


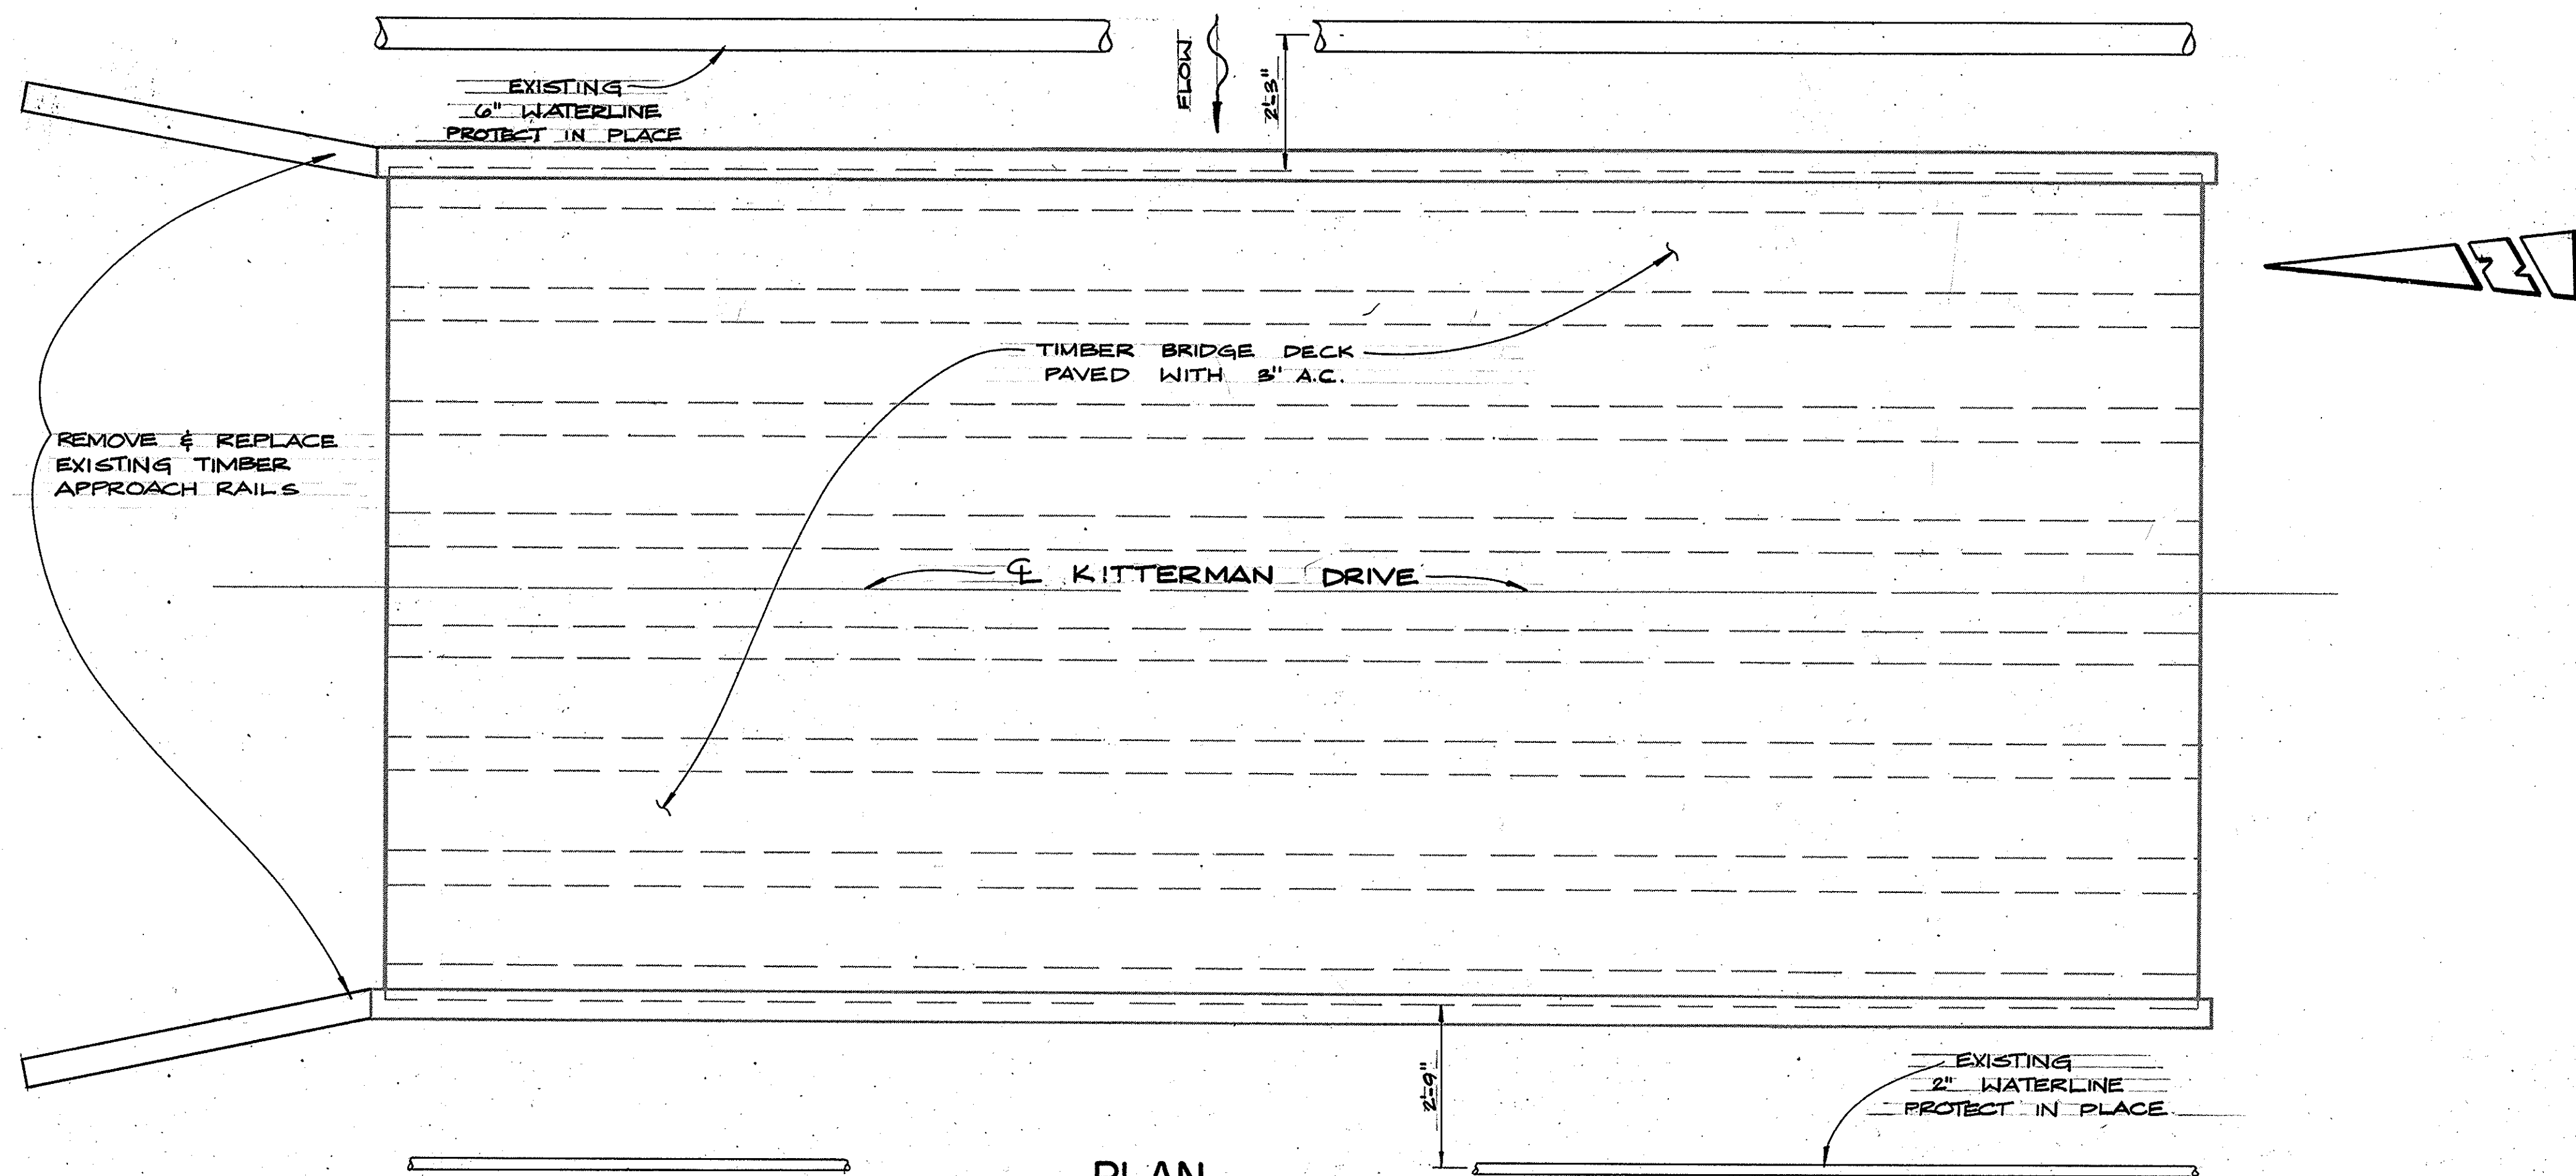

1 1/2 0 1 2
3 inches on original drawing

BRIDGE DECK REMOVAL NOTES

- ① CONTRACTOR SHALL PROTECT IN PLACE ALL EXISTING UTILITIES.
- ② CONTRACTOR SHALL NOT REMOVE EXISTING BRIDGE DECK UNTIL NEW TIMBER BRIDGE DECK IS COMPLETELY FABRICATED AND APPROVED BY THE ENGINEER.
- ③ CONTRACTOR SHALL VERIFY THAT ADEQUATE (VERTICAL AND HORIZONTAL) CLEARANCE EXISTS FOR CRANE OPERATIONS
 - A. TO REMOVE THE EXISTING BRIDGE DECK.
 - B. TO INSTALL THE PRE-FABRICATED BRIDGE DECK.
- ④ IT IS ESTIMATED THAT THE EXISTING TIMBER BRIDGE DECK (INCLUDING RAILING, HARDWARE AND A.C. SURFACE) WEIGHS 44,000 lbs. CONTRACTOR SHALL VERIFY THIS WEIGHT BY FIELD MEASUREMENTS BEFORE SELECTING A CRANE FOR THE REMOVAL OPERATIONS.

AS BUILT

WHILE THE INFORMATION SHOWN IS BELIEVED TO BE ACCURATE, THE ORANGE COUNTY ENVIRONMENTAL MANAGEMENT AGENCY WILL NOT BE RESPONSIBLE FOR OMISSIONS, ERRORS, OR INACCURACIES.

ORANGE COUNTY ENVIRONMENTAL MANAGEMENT AGENCY			
KITTERMAN DR. BRIDGE (SV-15) ACROSS SILVERADO CREEK			
PLANS FOR BRIDGE DECK REMOVAL			
MARK	DATE	DESCRIPTION	PREPARED UNDER SUPERVISION OF
DESIGNED	DATE	SCALE	DATE
DRAWN	CHECKED	AS SHOWN	DWG. NO.
9/83	9/83	1/2" = 1'	2/4