




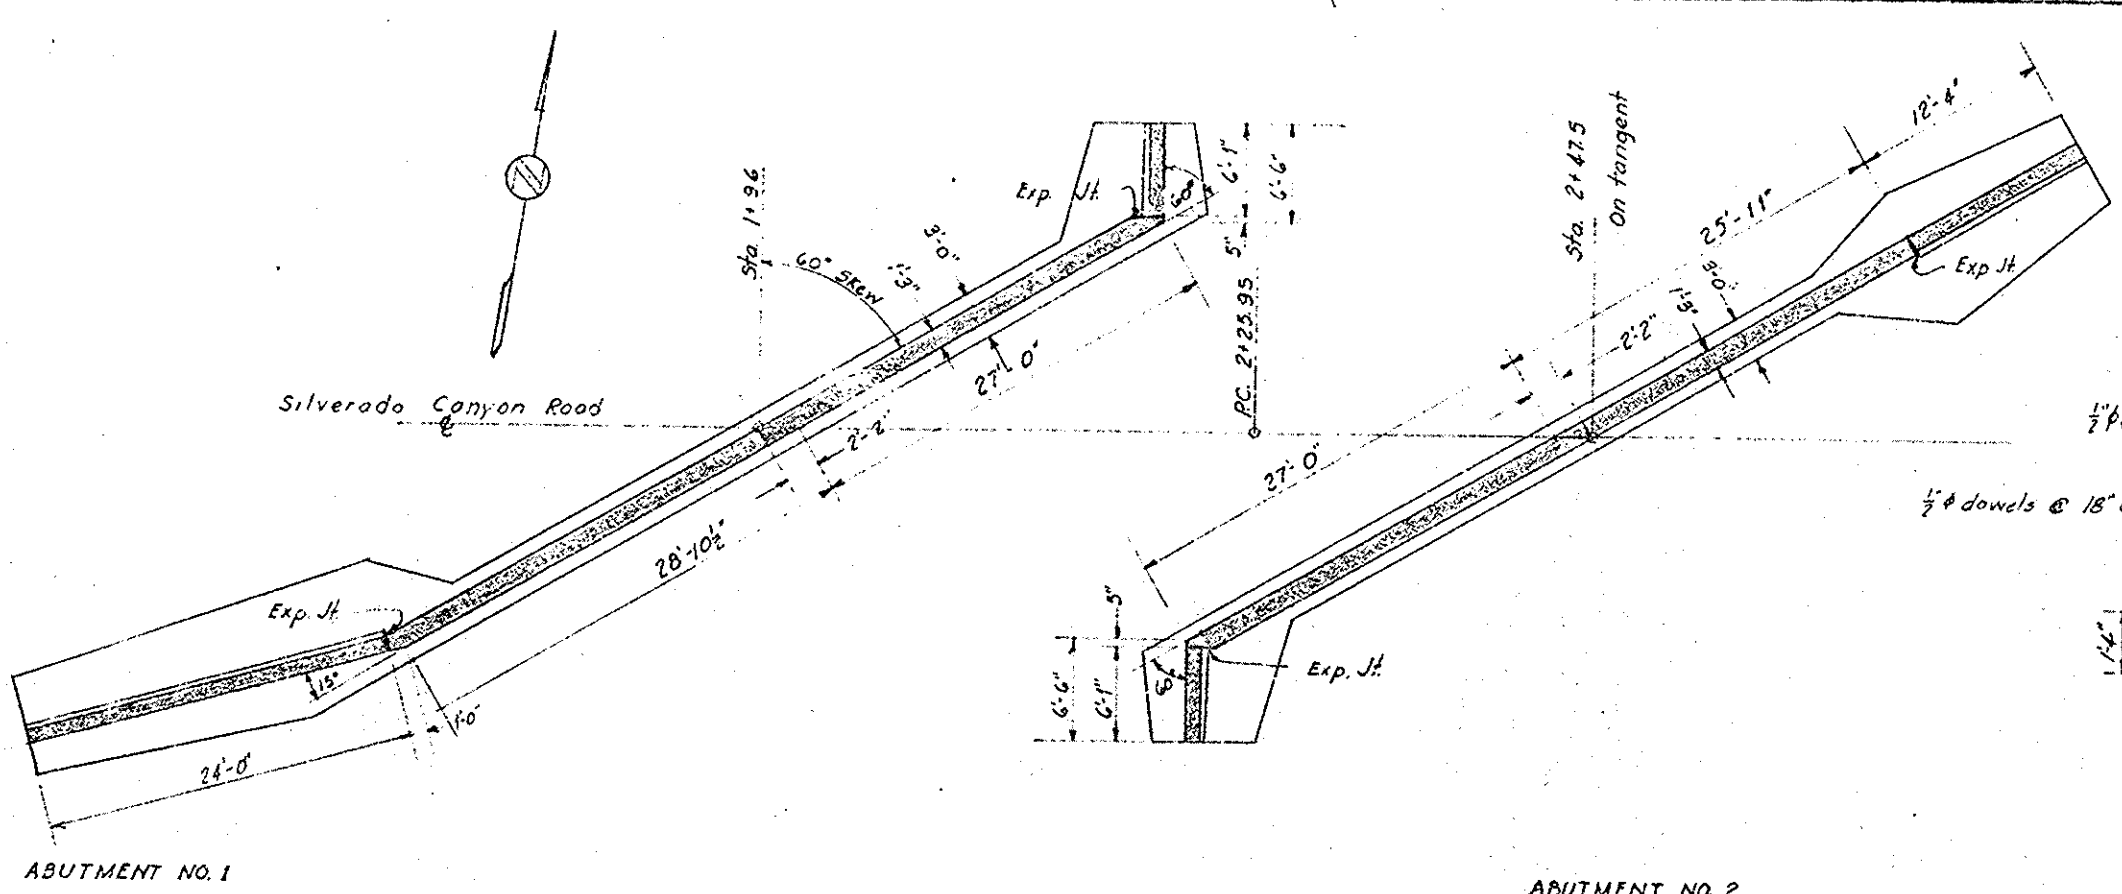


FOUNDATION PLAN
Scale ~ 1/8" = 1'-0"

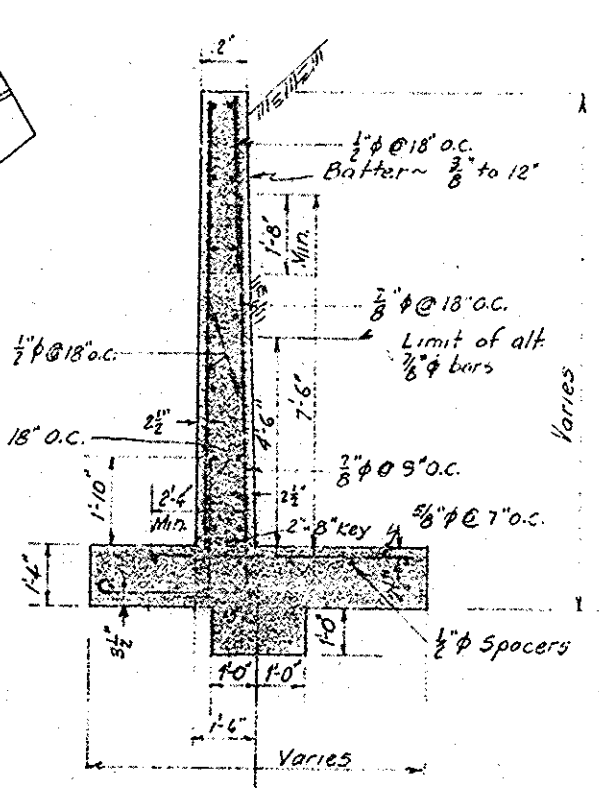


SECTION A-A
Scale ~ 3/8" = 1'-0"

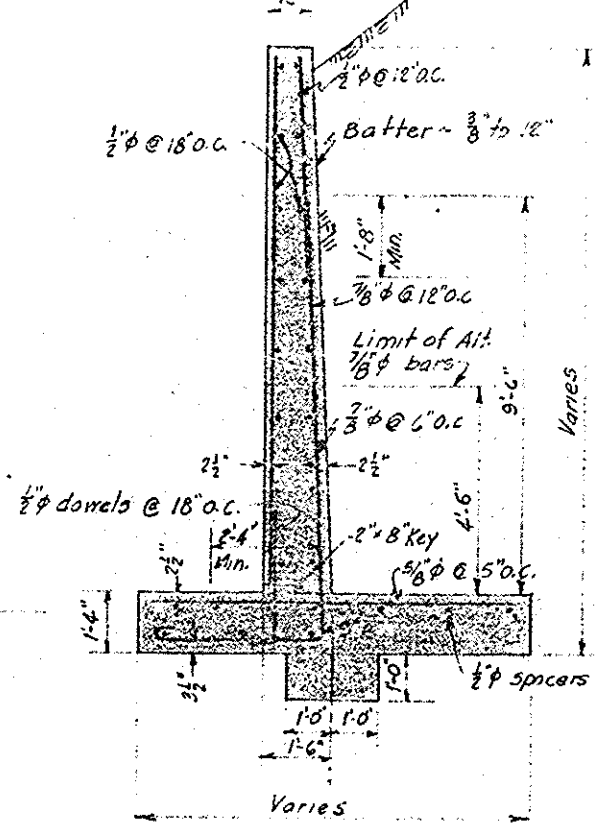


SECTION B-B
Scale ~ 3/8" = 1'-0"

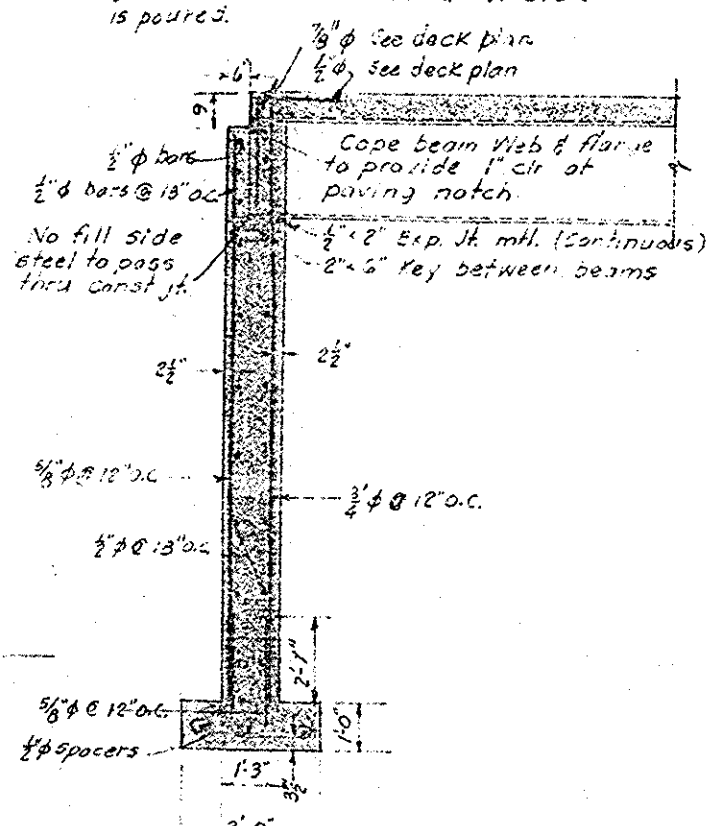


SECTION D-D
Scale ~ 3/8" = 1'-0"

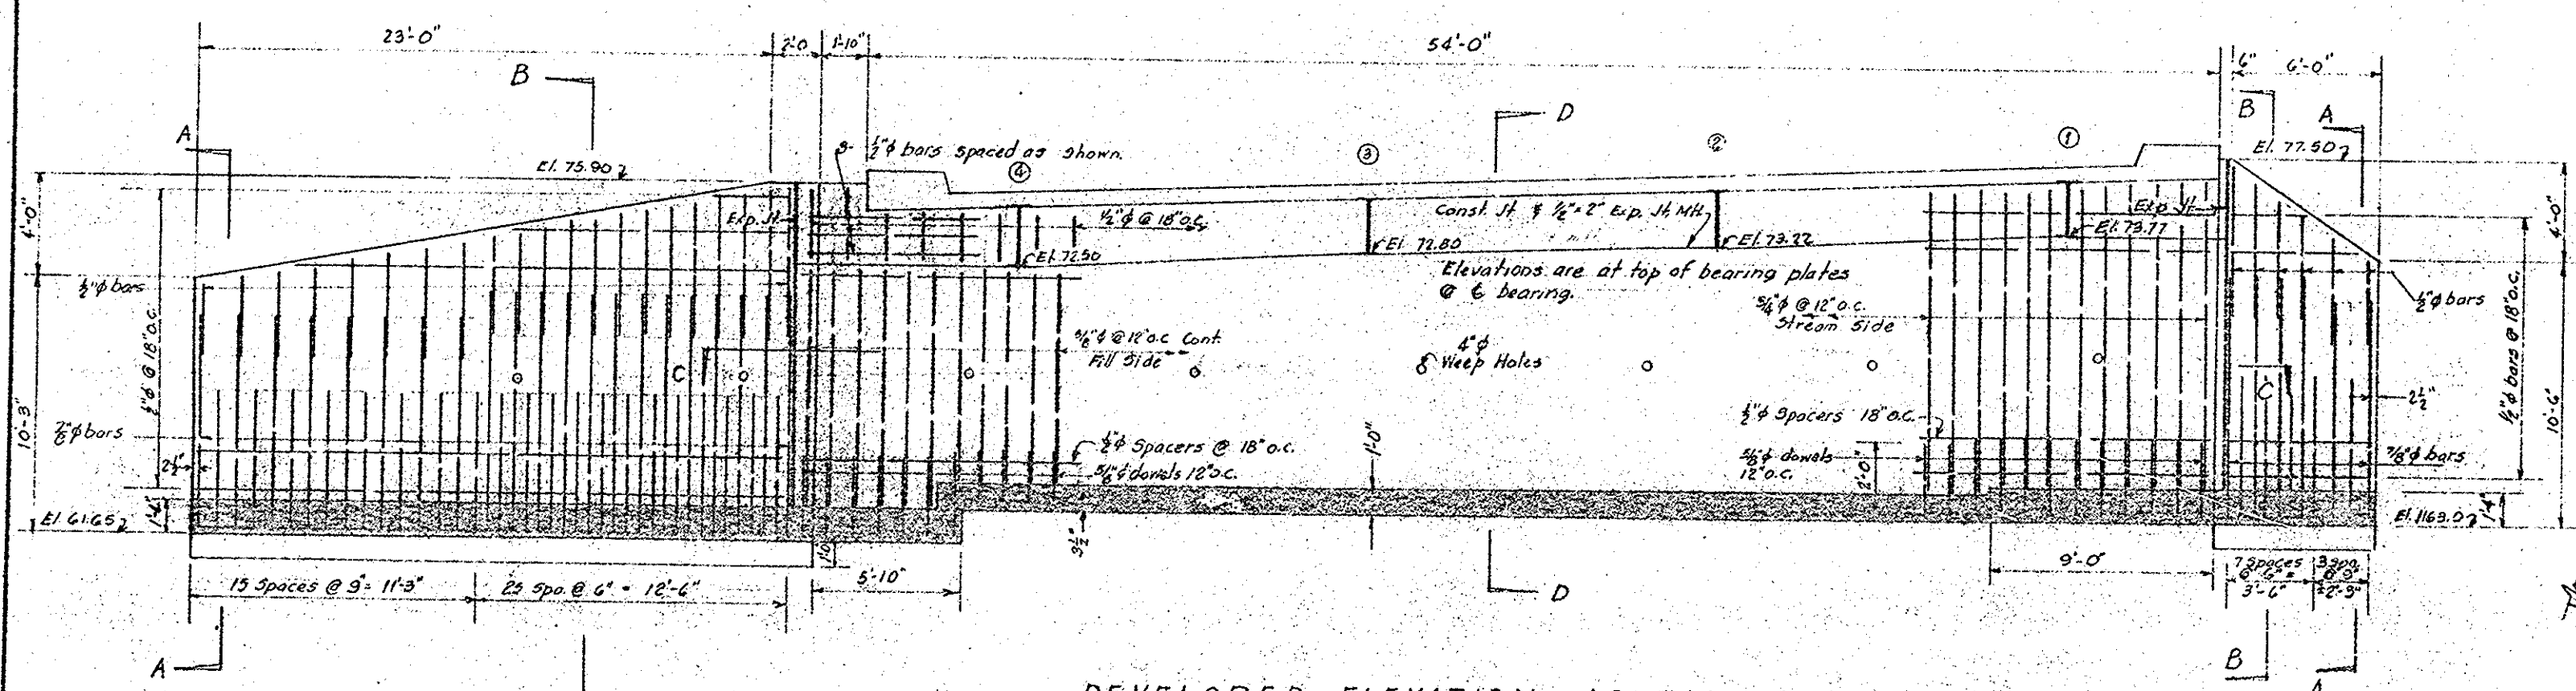


DEVELOPED ELEVATION- ABUTMENT NO. 1
FILL SIDE REINFORCING SHOWN-EXCEPT AS NOTED
Scale ~ 1/4" = 1'-0"

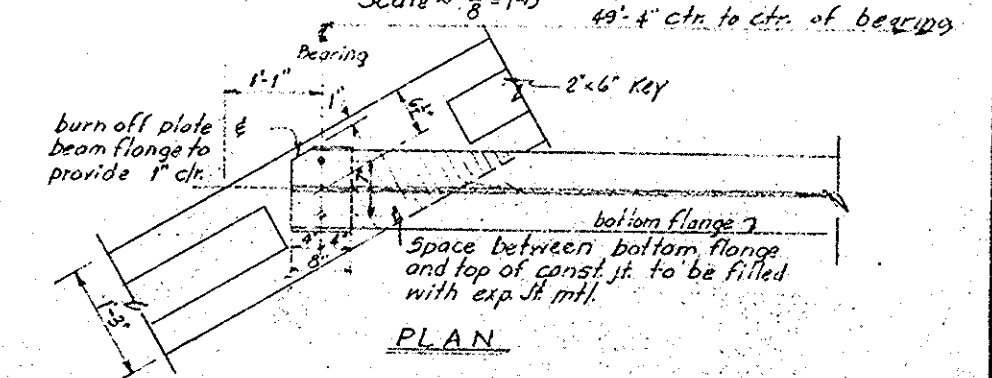

PLAN

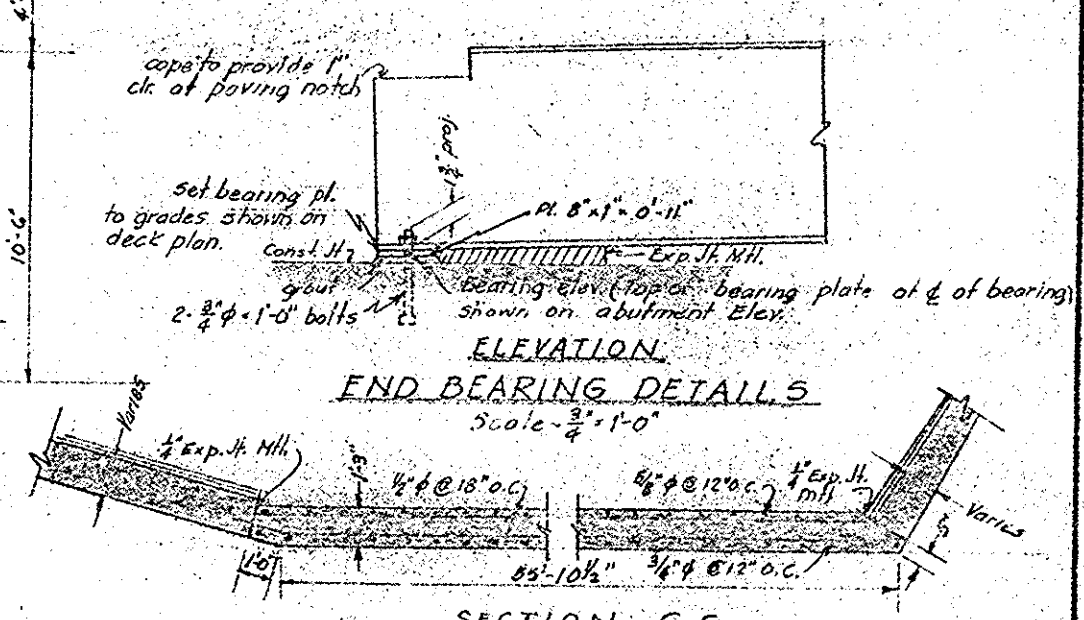

END BEARING DETAILS
Scale ~ 1/4" = 1'-0"

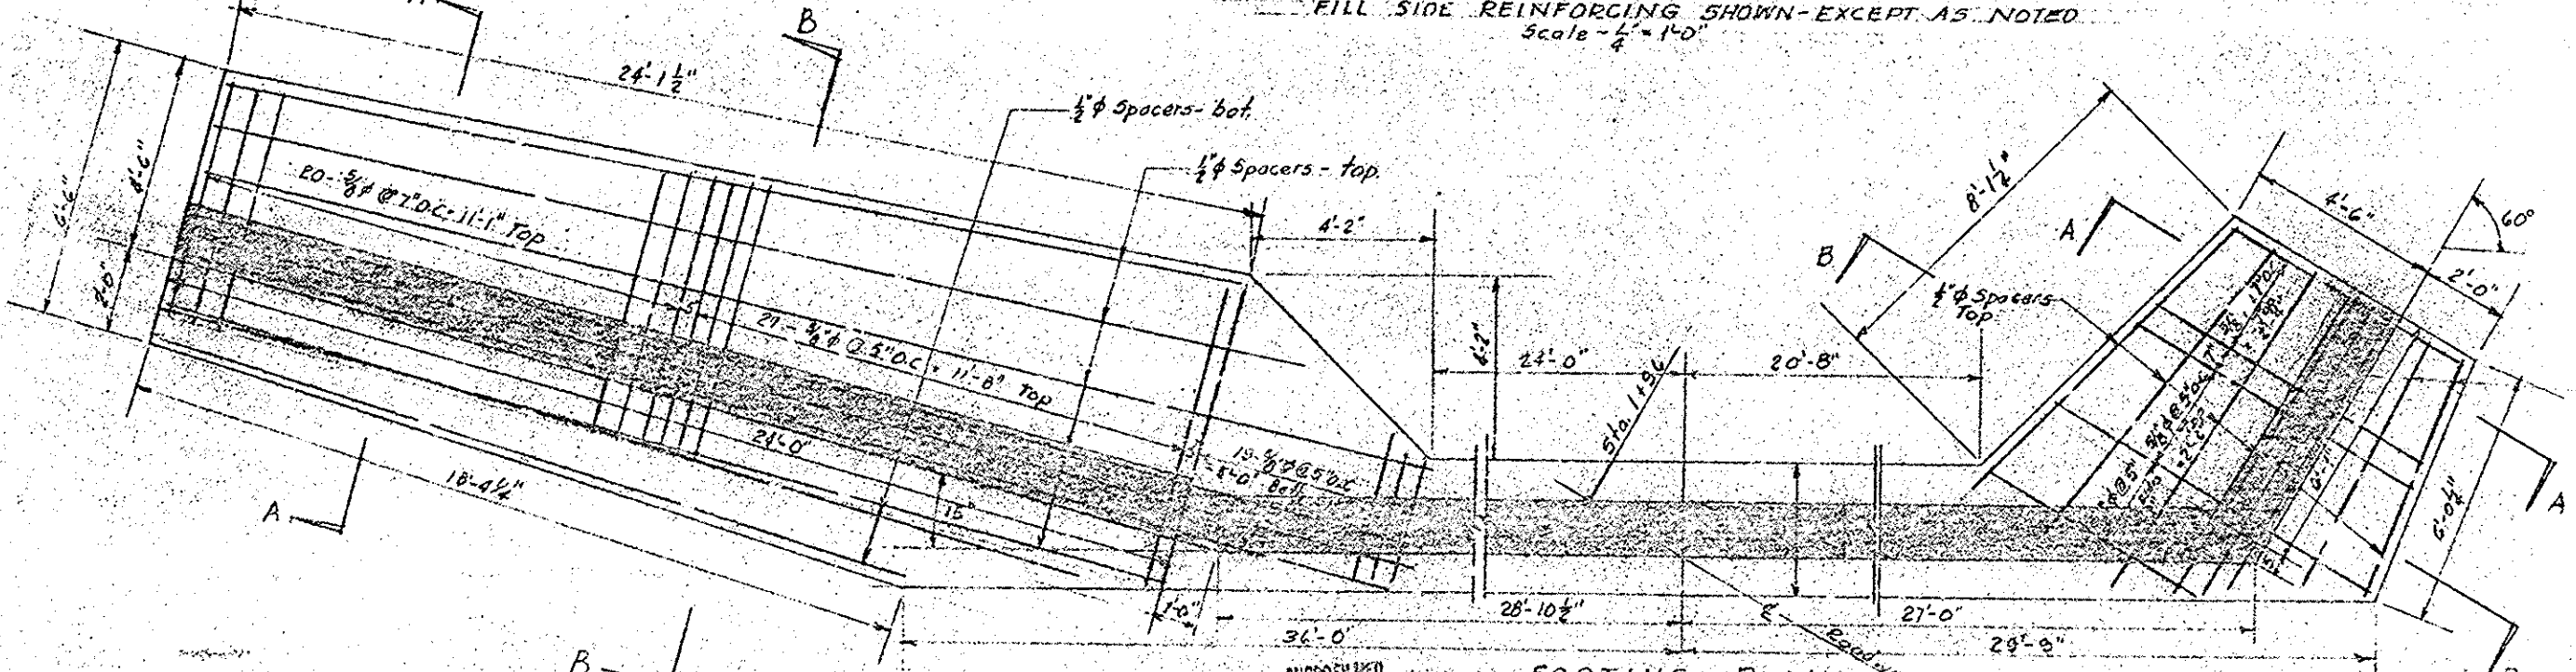

FOOTING PLAN
SHOWING WING REINFORCING
Scale ~ 3/8" = 1'-0"

APPROVED *A.A. Beard*
A.A. BEARD
SUPERINTENDENT OF HIGHWAYS
DATE 8-8-46

by J. Sprenger
Asst. Supt.

REV.	DATE	REVISION	BY	APP'D.
1	8-8-46	ORANGE COUNTY, CALIFORNIA BRIDGES ACROSS SILVERADO, LADD & SANTIAGO CREEKS DETAILS OF ABUTMENT NO. 1 LADD CREEK (SV 8)		
2		DONALD R. WARREN CO. ENGINEERS LOS ANGELES SAN FRANCISCO		
3		LA 48-17 9		

Bridge #358
Details of Abutment #1
Ladd Creek
Sheet 10 of 13
Scale as noted
Vollum-Pencil Sketch