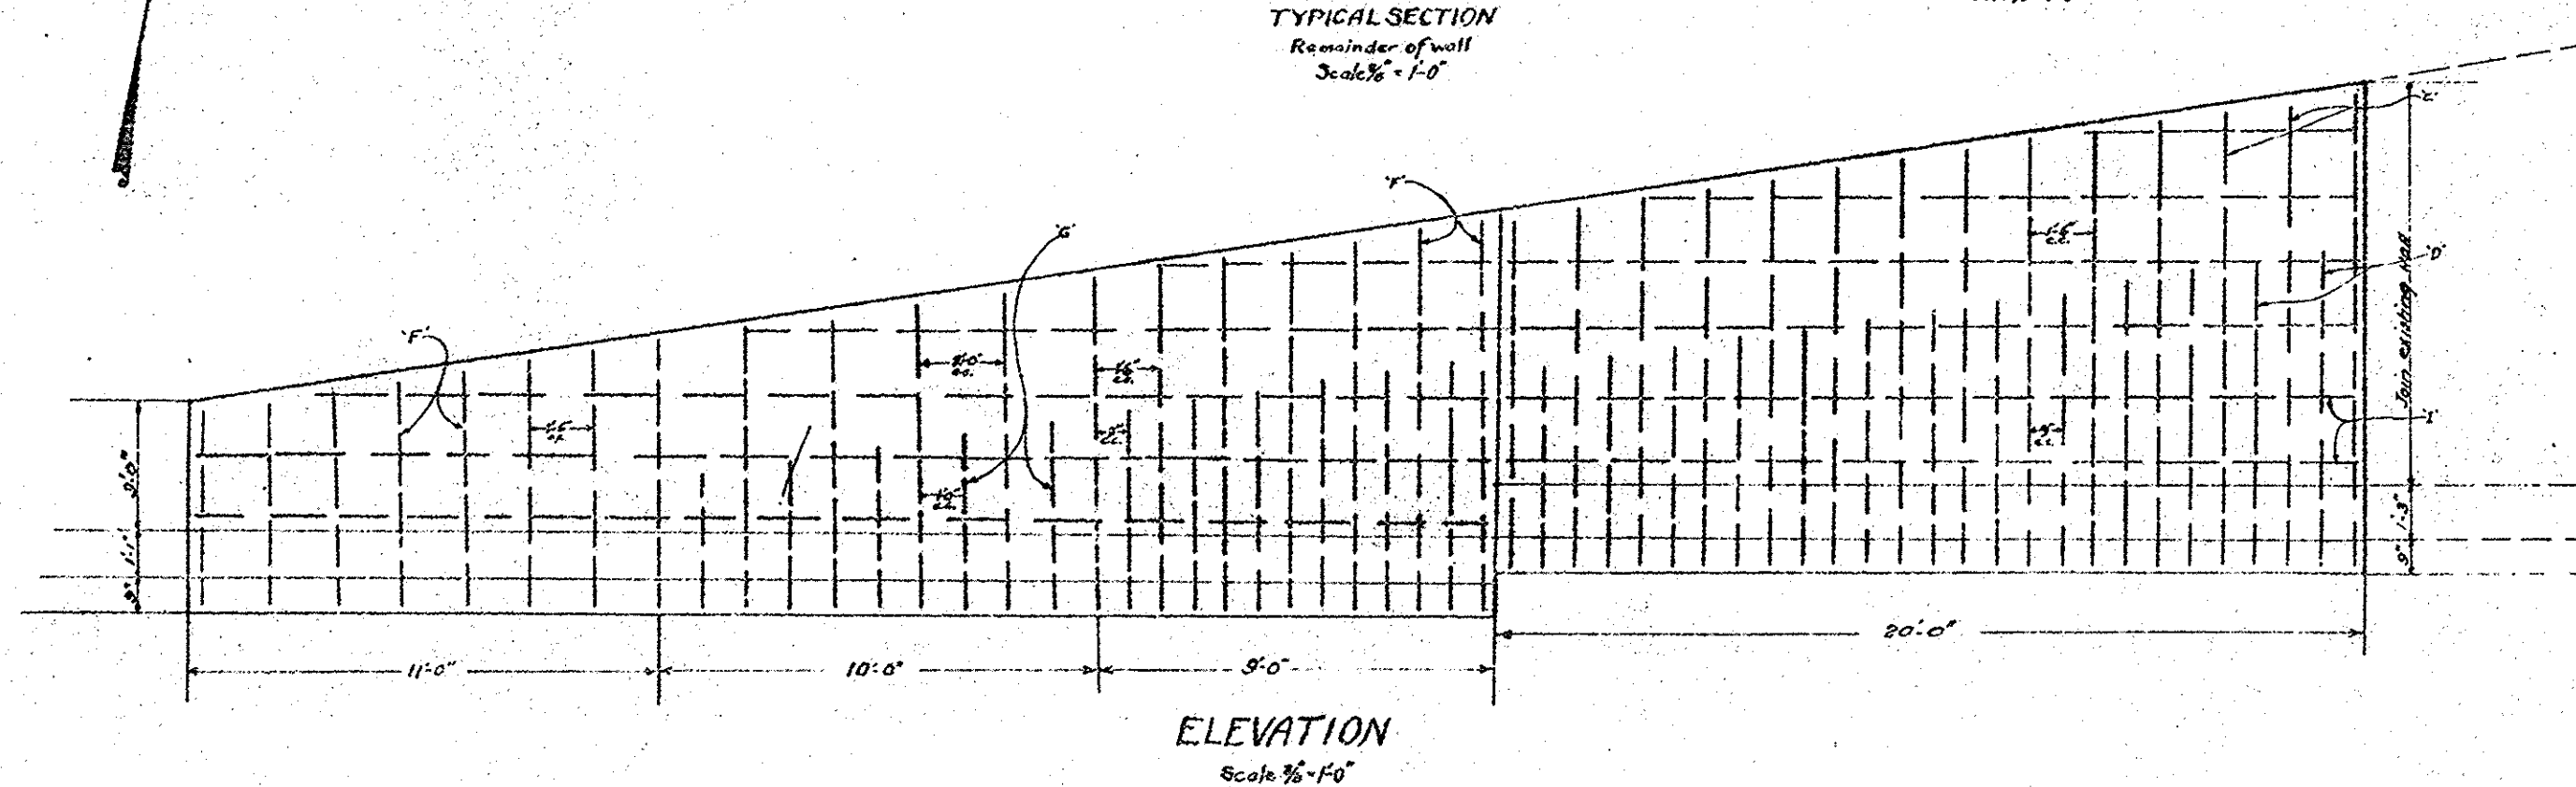
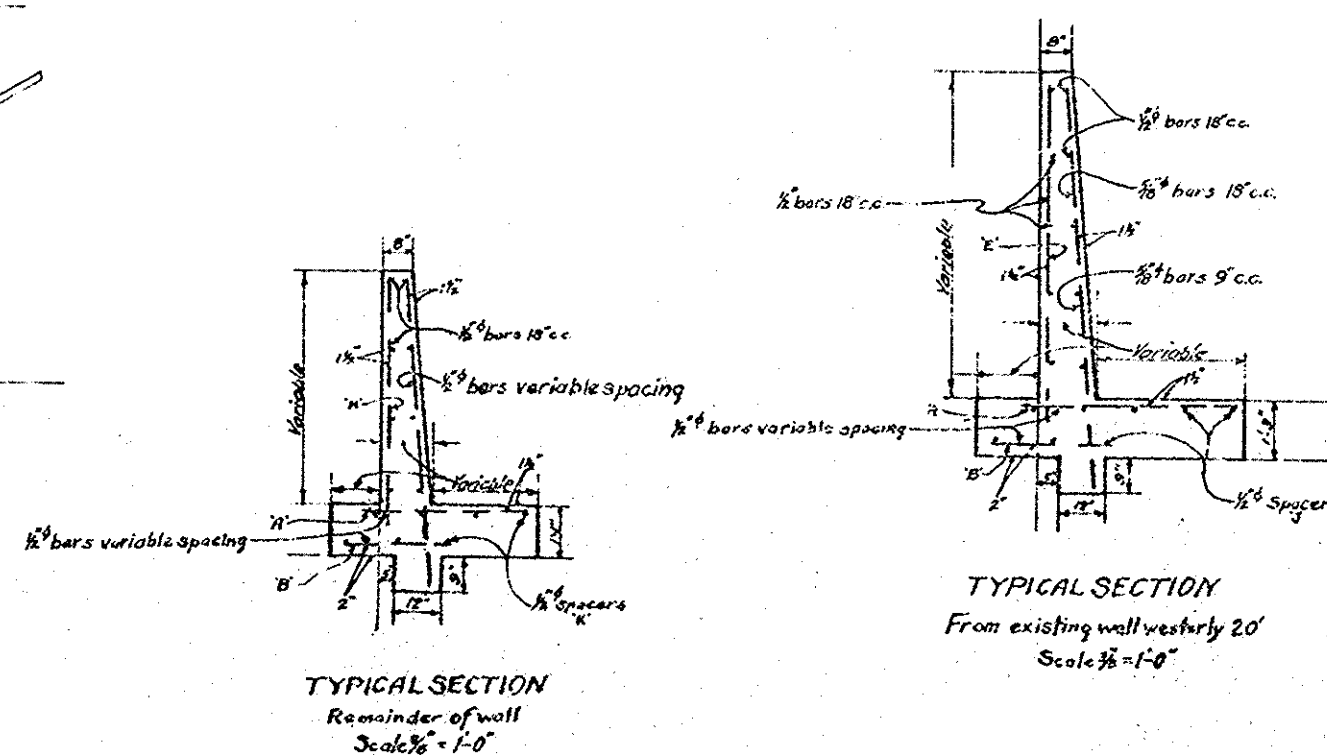
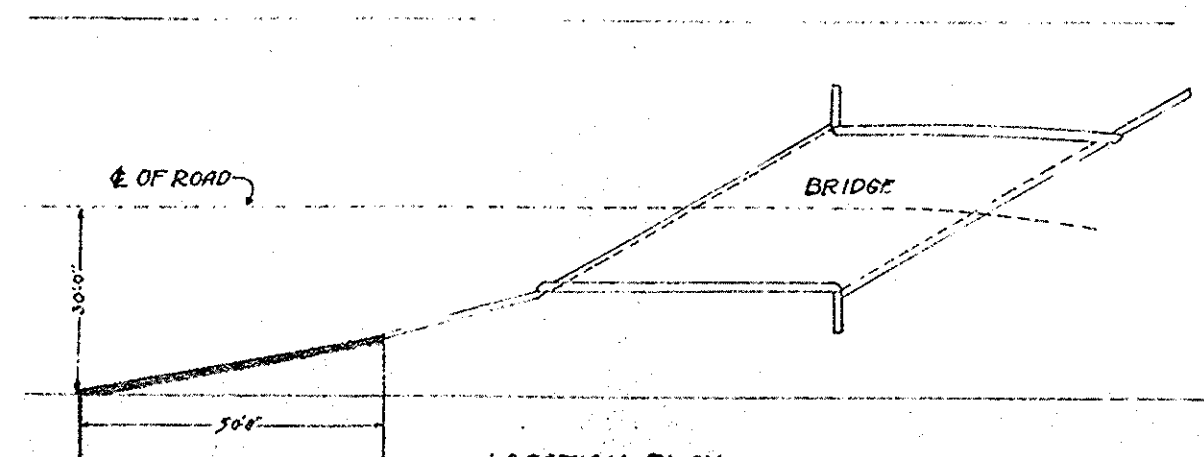


ORANGE COUNTY HIGHWAY DEPT.
REINFORCED CONCRETE
RETAINING WALL
LADD CANYON BRIDGE SV-8
FEB. 1947 SCALE AS SHOWN

Bridge #37-8
Ladd Canyon Bridge
Reinforced Concrete
Retaining Wall
Sheet 1 of 1
Red: 223 / Scale as shown
Yellow

#14673 SILVERADO CYN. ROAD
Ladd Cyn. BR. @ SILVERADO CREEK.
SV-8
55C-175
THOS. MAP: 832-E2

1947

1/1