
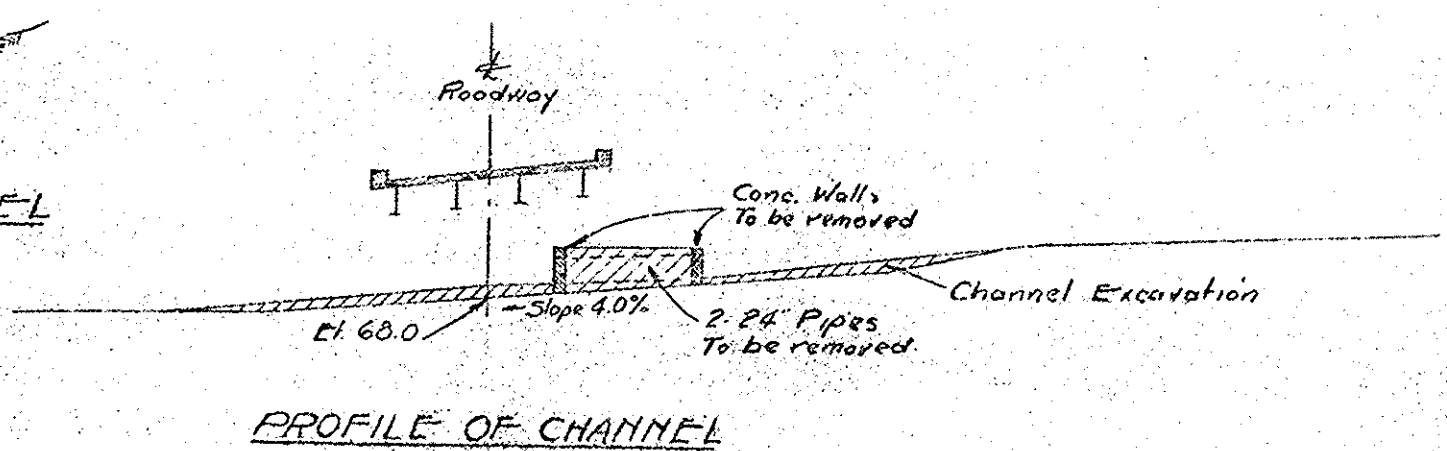
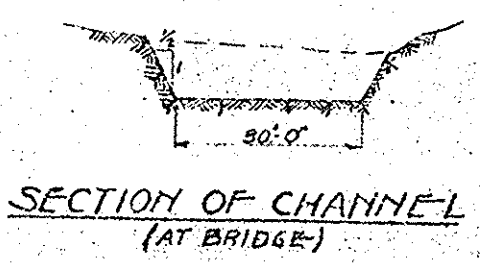
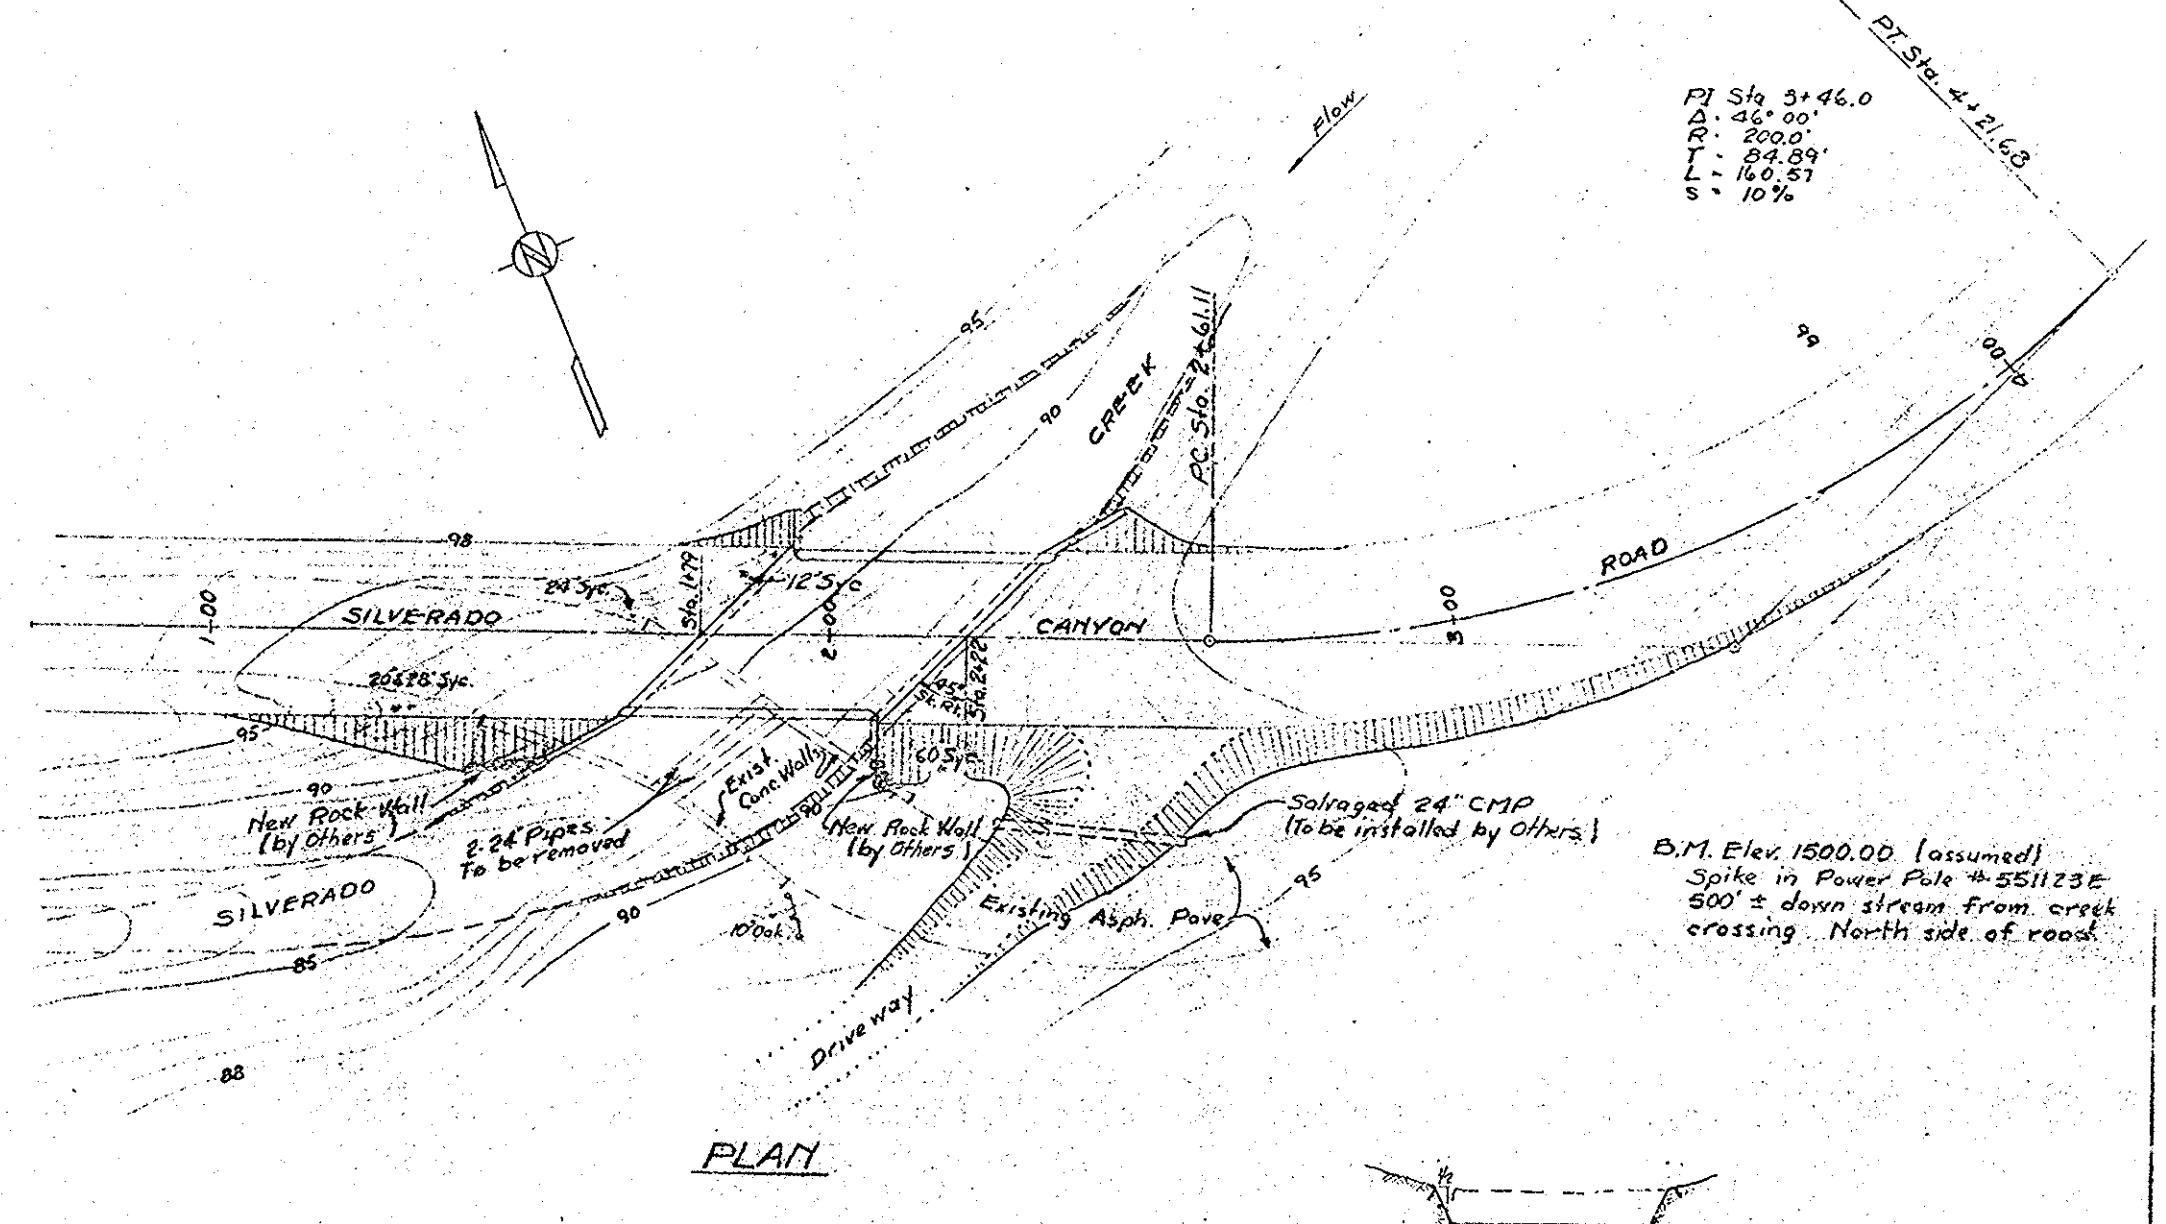
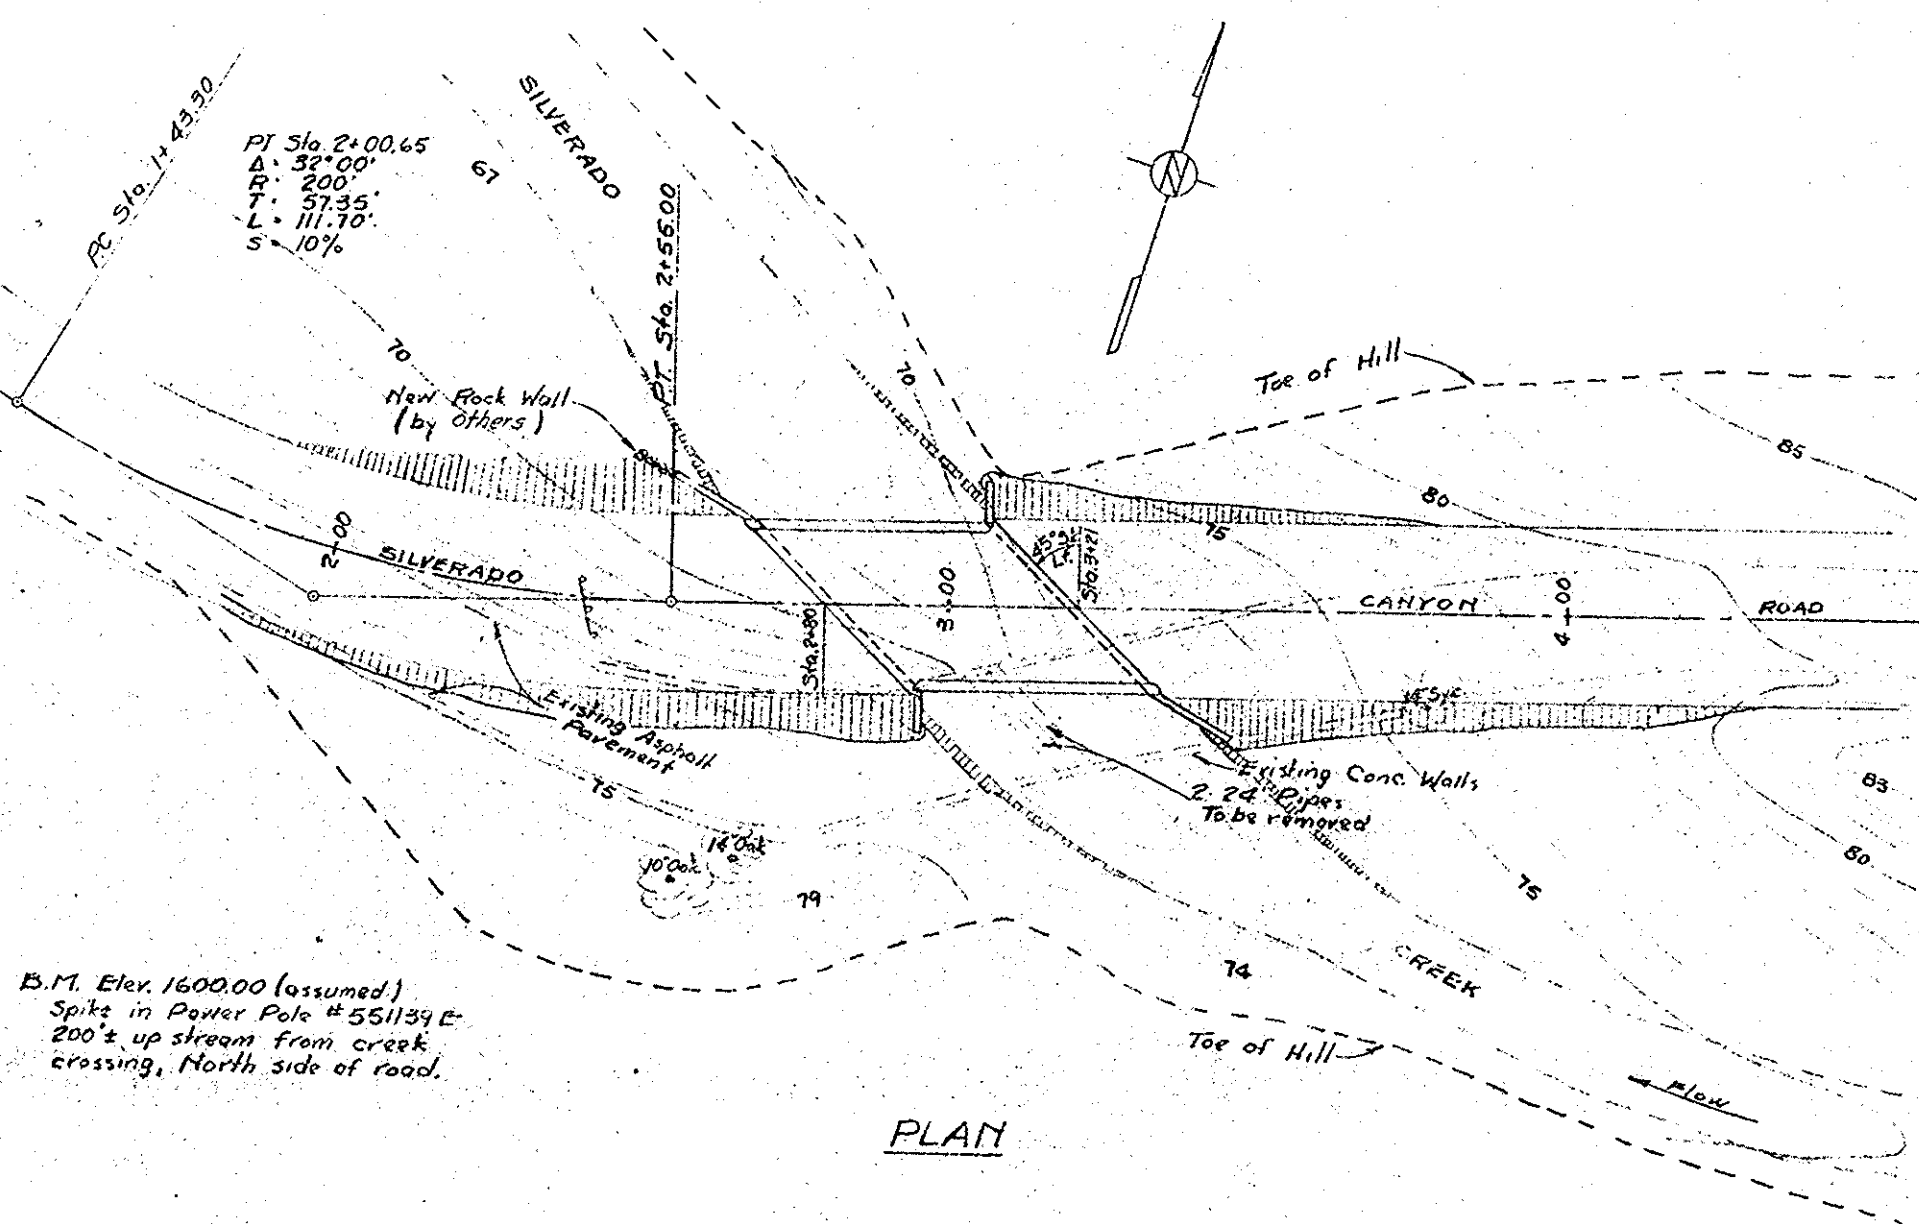
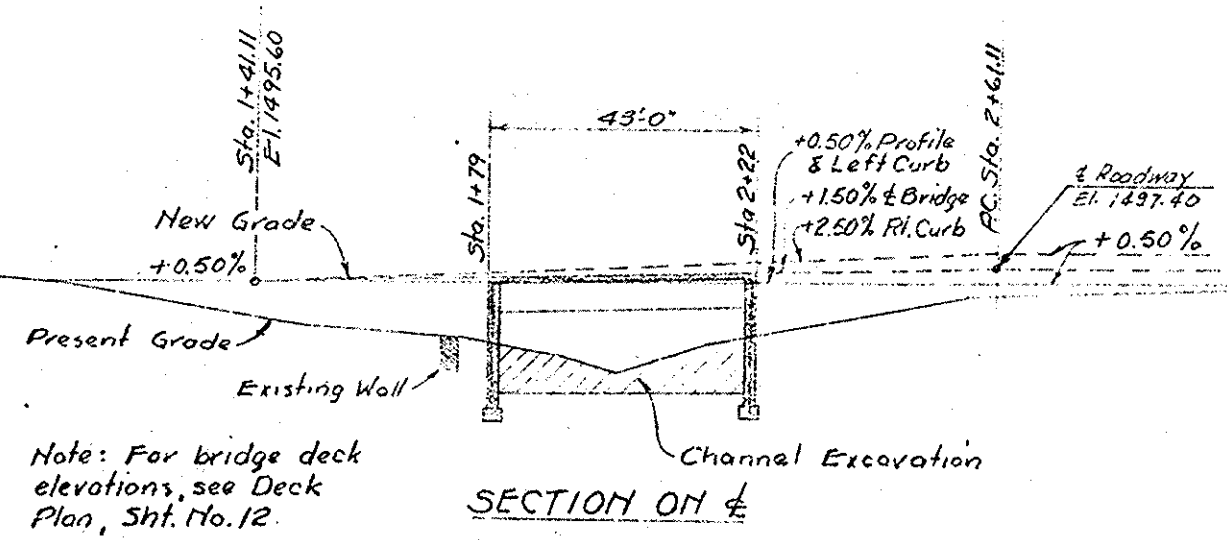


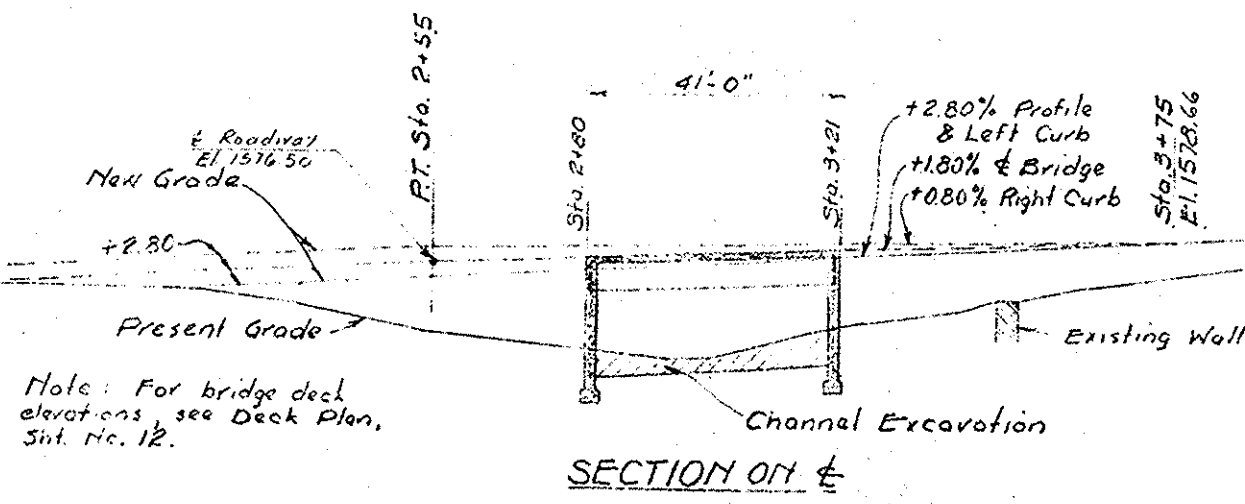


BRIDGE SV 12
Scale: Horiz. 1"=20'-0"
Vert. 1"=10'-0"


Bridge #SV 12 & 13
General Plan
Silverado Creek
Sheet 5 of 13
R.D. 27.5' Scale 1"=20' H
1"=10' V
Vellum-Pencil Sketch

NOTE:
Road approaches, channel excavation
and removal of pipe culverts not part of
bridge contract.

MICROFILMED
JUL 6 1960

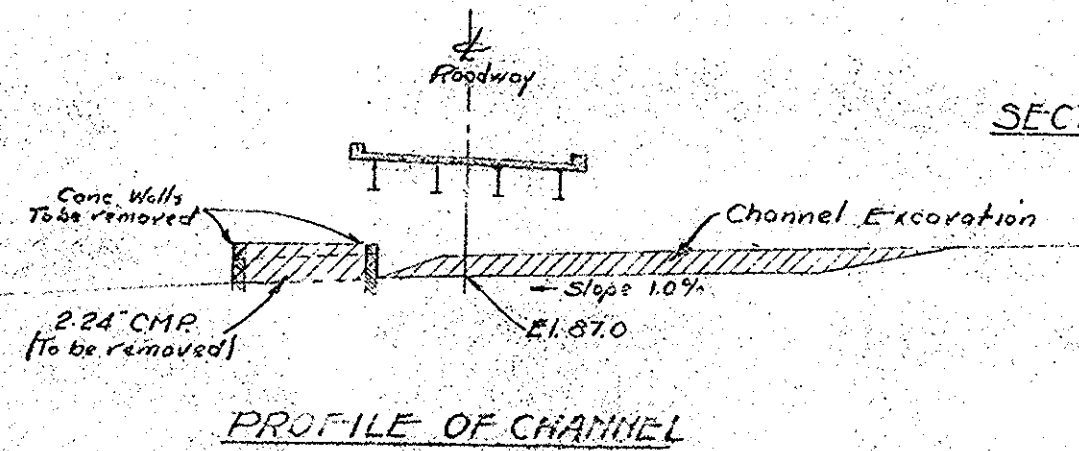

BRIDGE SV 13
Scale: Horiz. 1"=20'-0"
Vert. 1"=10'-0"

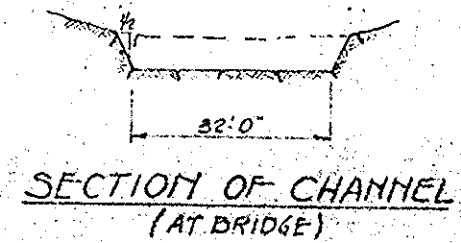

APPROVED: *A.A. Beard*
A.A. BEARD
SUPERINTENDENT OF HIGHWAYS
DATE: 8-8-46
By: *H. Spranger, Asst. Supt.*

REV.	DATE	REVISION	BY	APPROD.
1	8-8-46			

ORANGE COUNTY, CALIFORNIA
BRIDGES ACROSS SILVERADO, LADD,
& SANTIAGO CREEKS
GENERAL PLAN
SILVERADO CREEK (SV 12) & (SV 13)

Noted: *Donald R. Warren*
DONALD R. WARREN CO.
ENGINEERS
LOS ANGELES SAN FRANCISCO
7/6/46

LA-46-17
4