



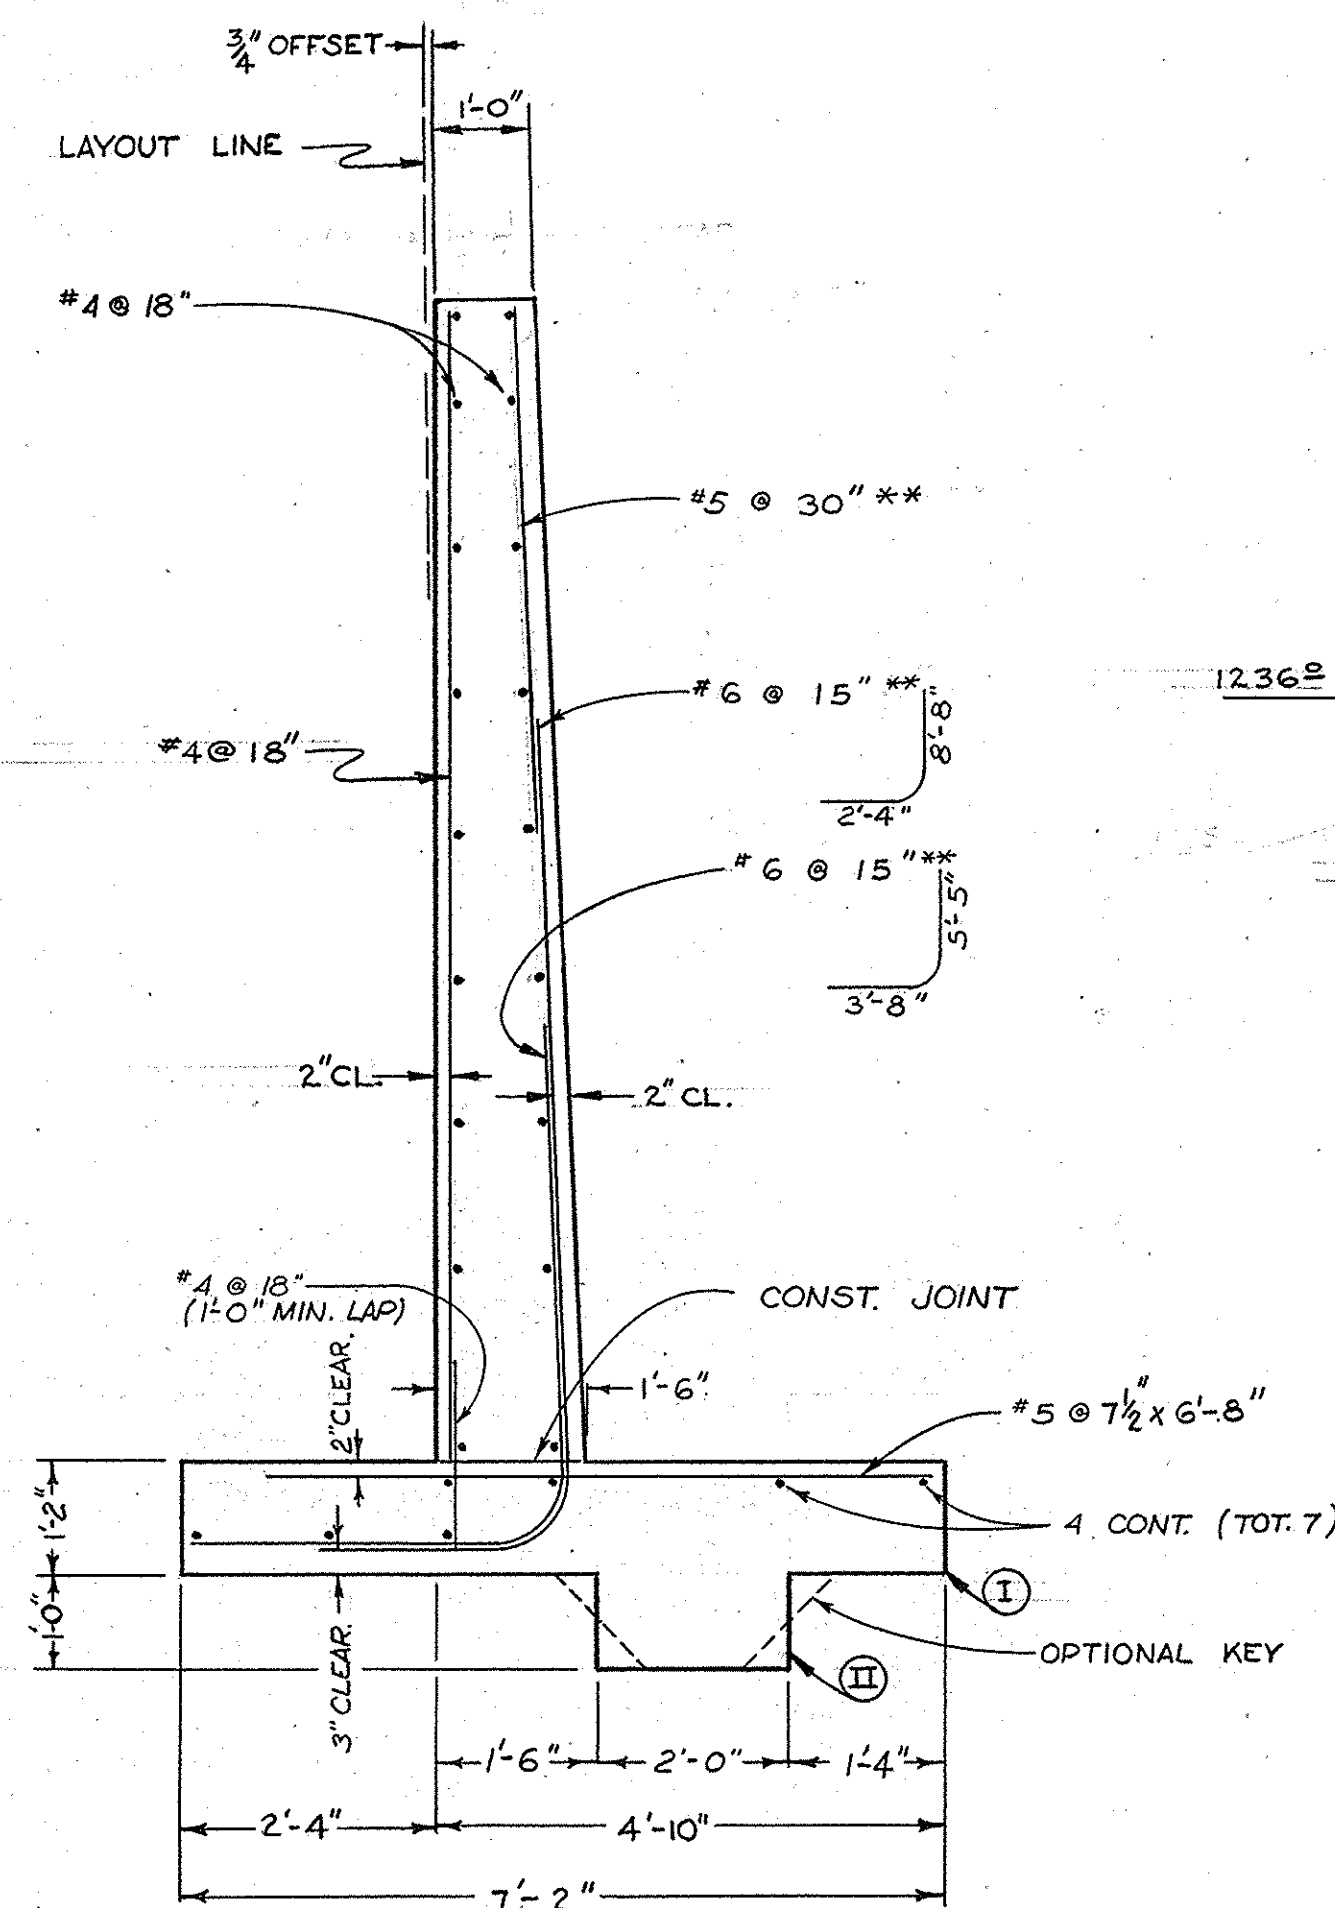


SECTION B-B
NO SCALE

**SEE WEST ABUT. ELEVATION SHT. #4 FOR SPACING LAYOUT

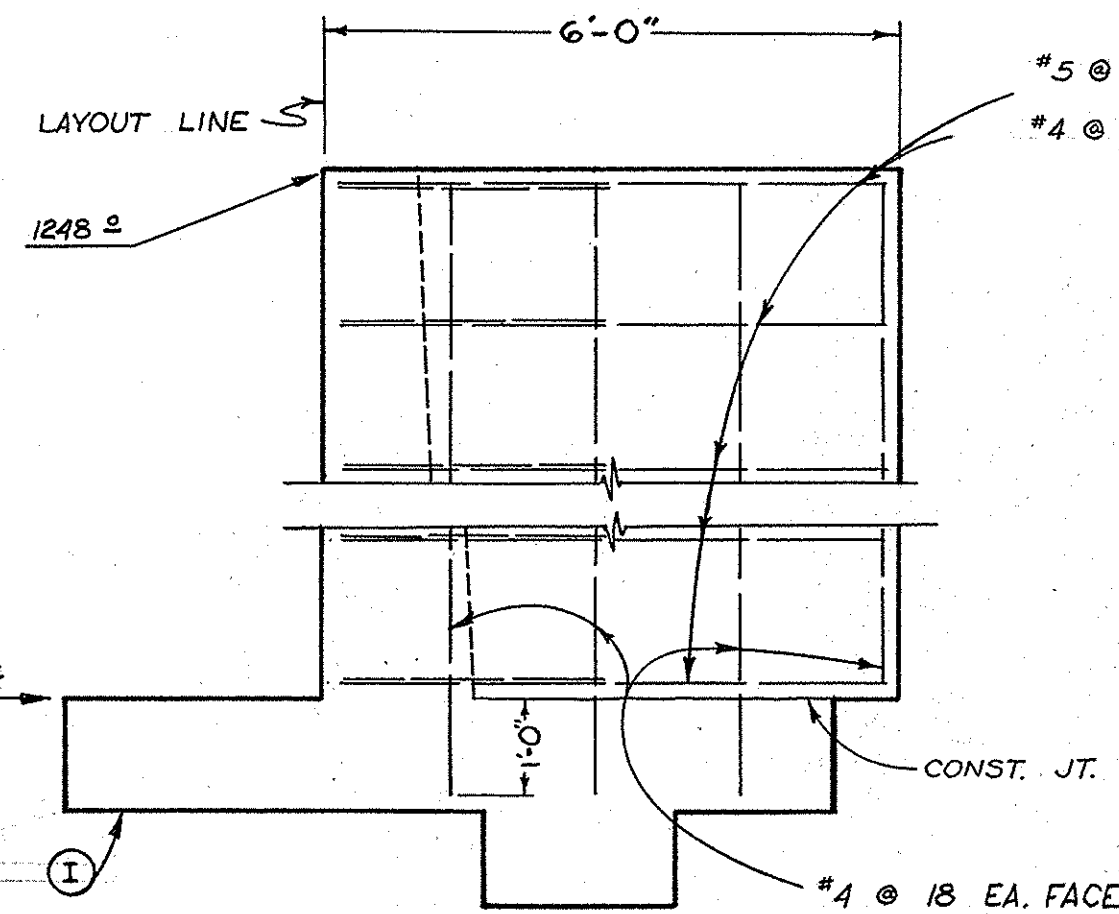


SECTION C-C
SCALE 1/2"=1'-0"

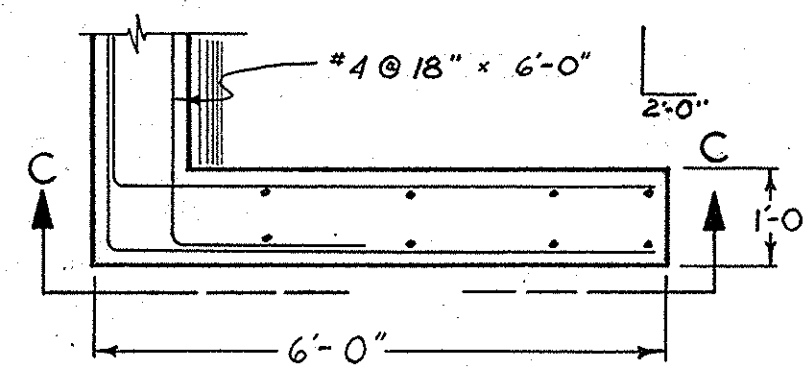


DETAIL 1
SCALE 1/2"=1'-0"

NOTES:

- I FOOTINGS TO BE PLACED @ PLAN ELEV'S INTO BEDROCK OR @ BEDROCK ELEV. AS DIRECTED BY THE ENGINEER.
- II KEY NOT REQUIRED ON IRREGULAR BEDROCK AS DIRECTED BY THE ENGINEER.

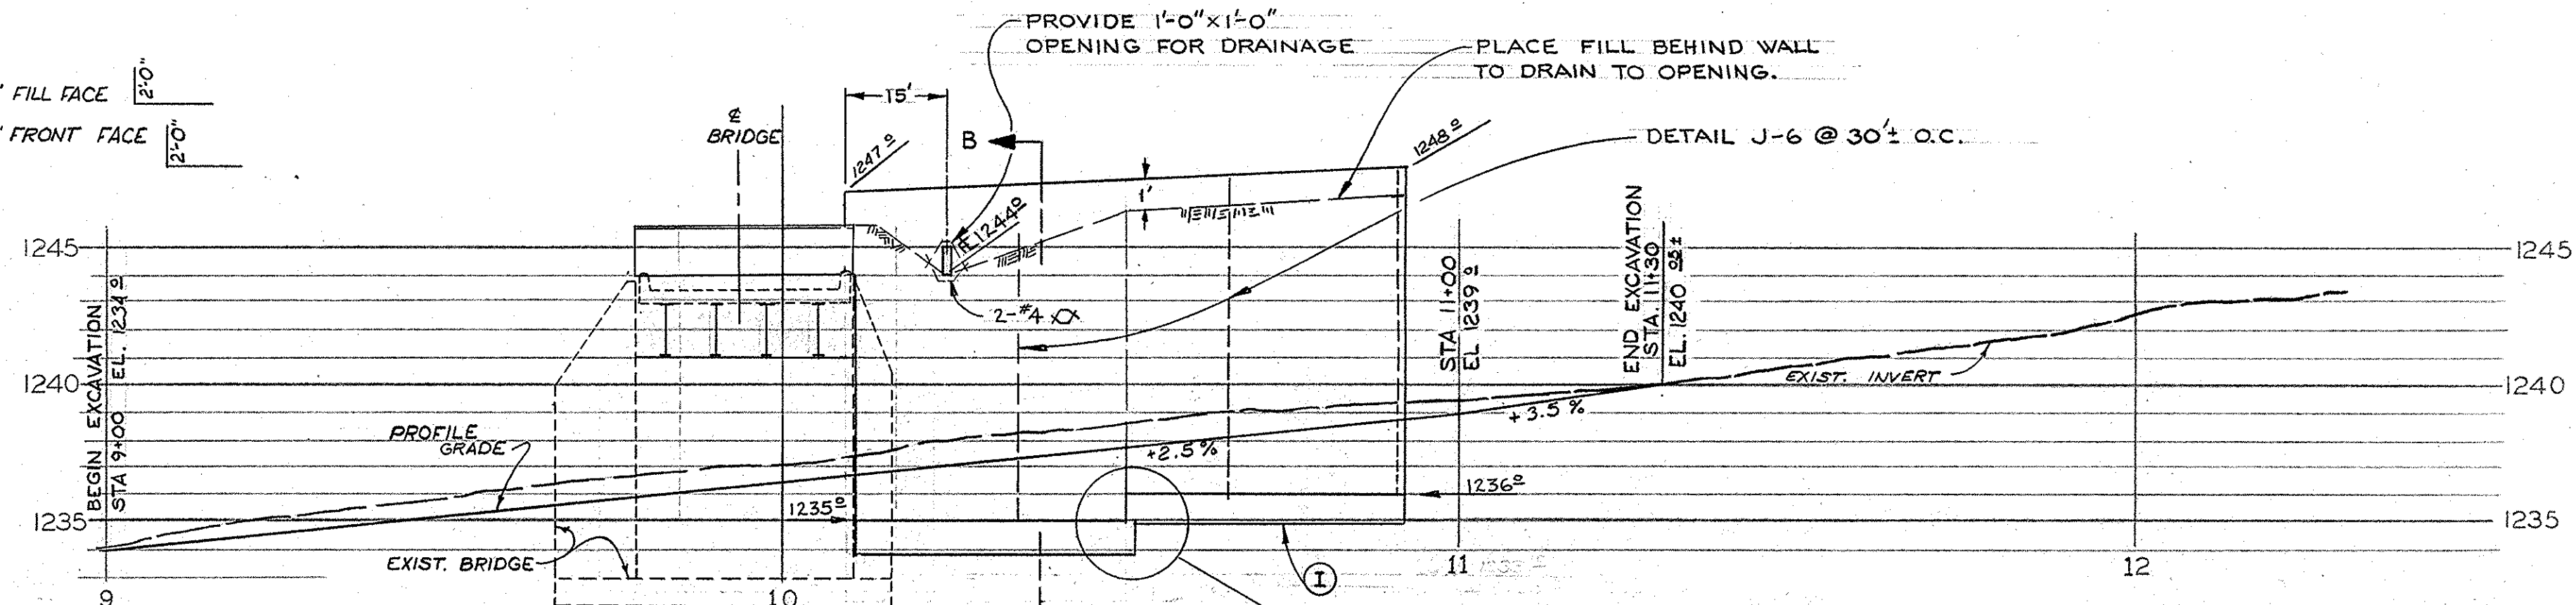

PROFILE
SILVERADO CREEK
SCALE - VERT. 1"=5'-0" HORIZ. 1"=20'-0"

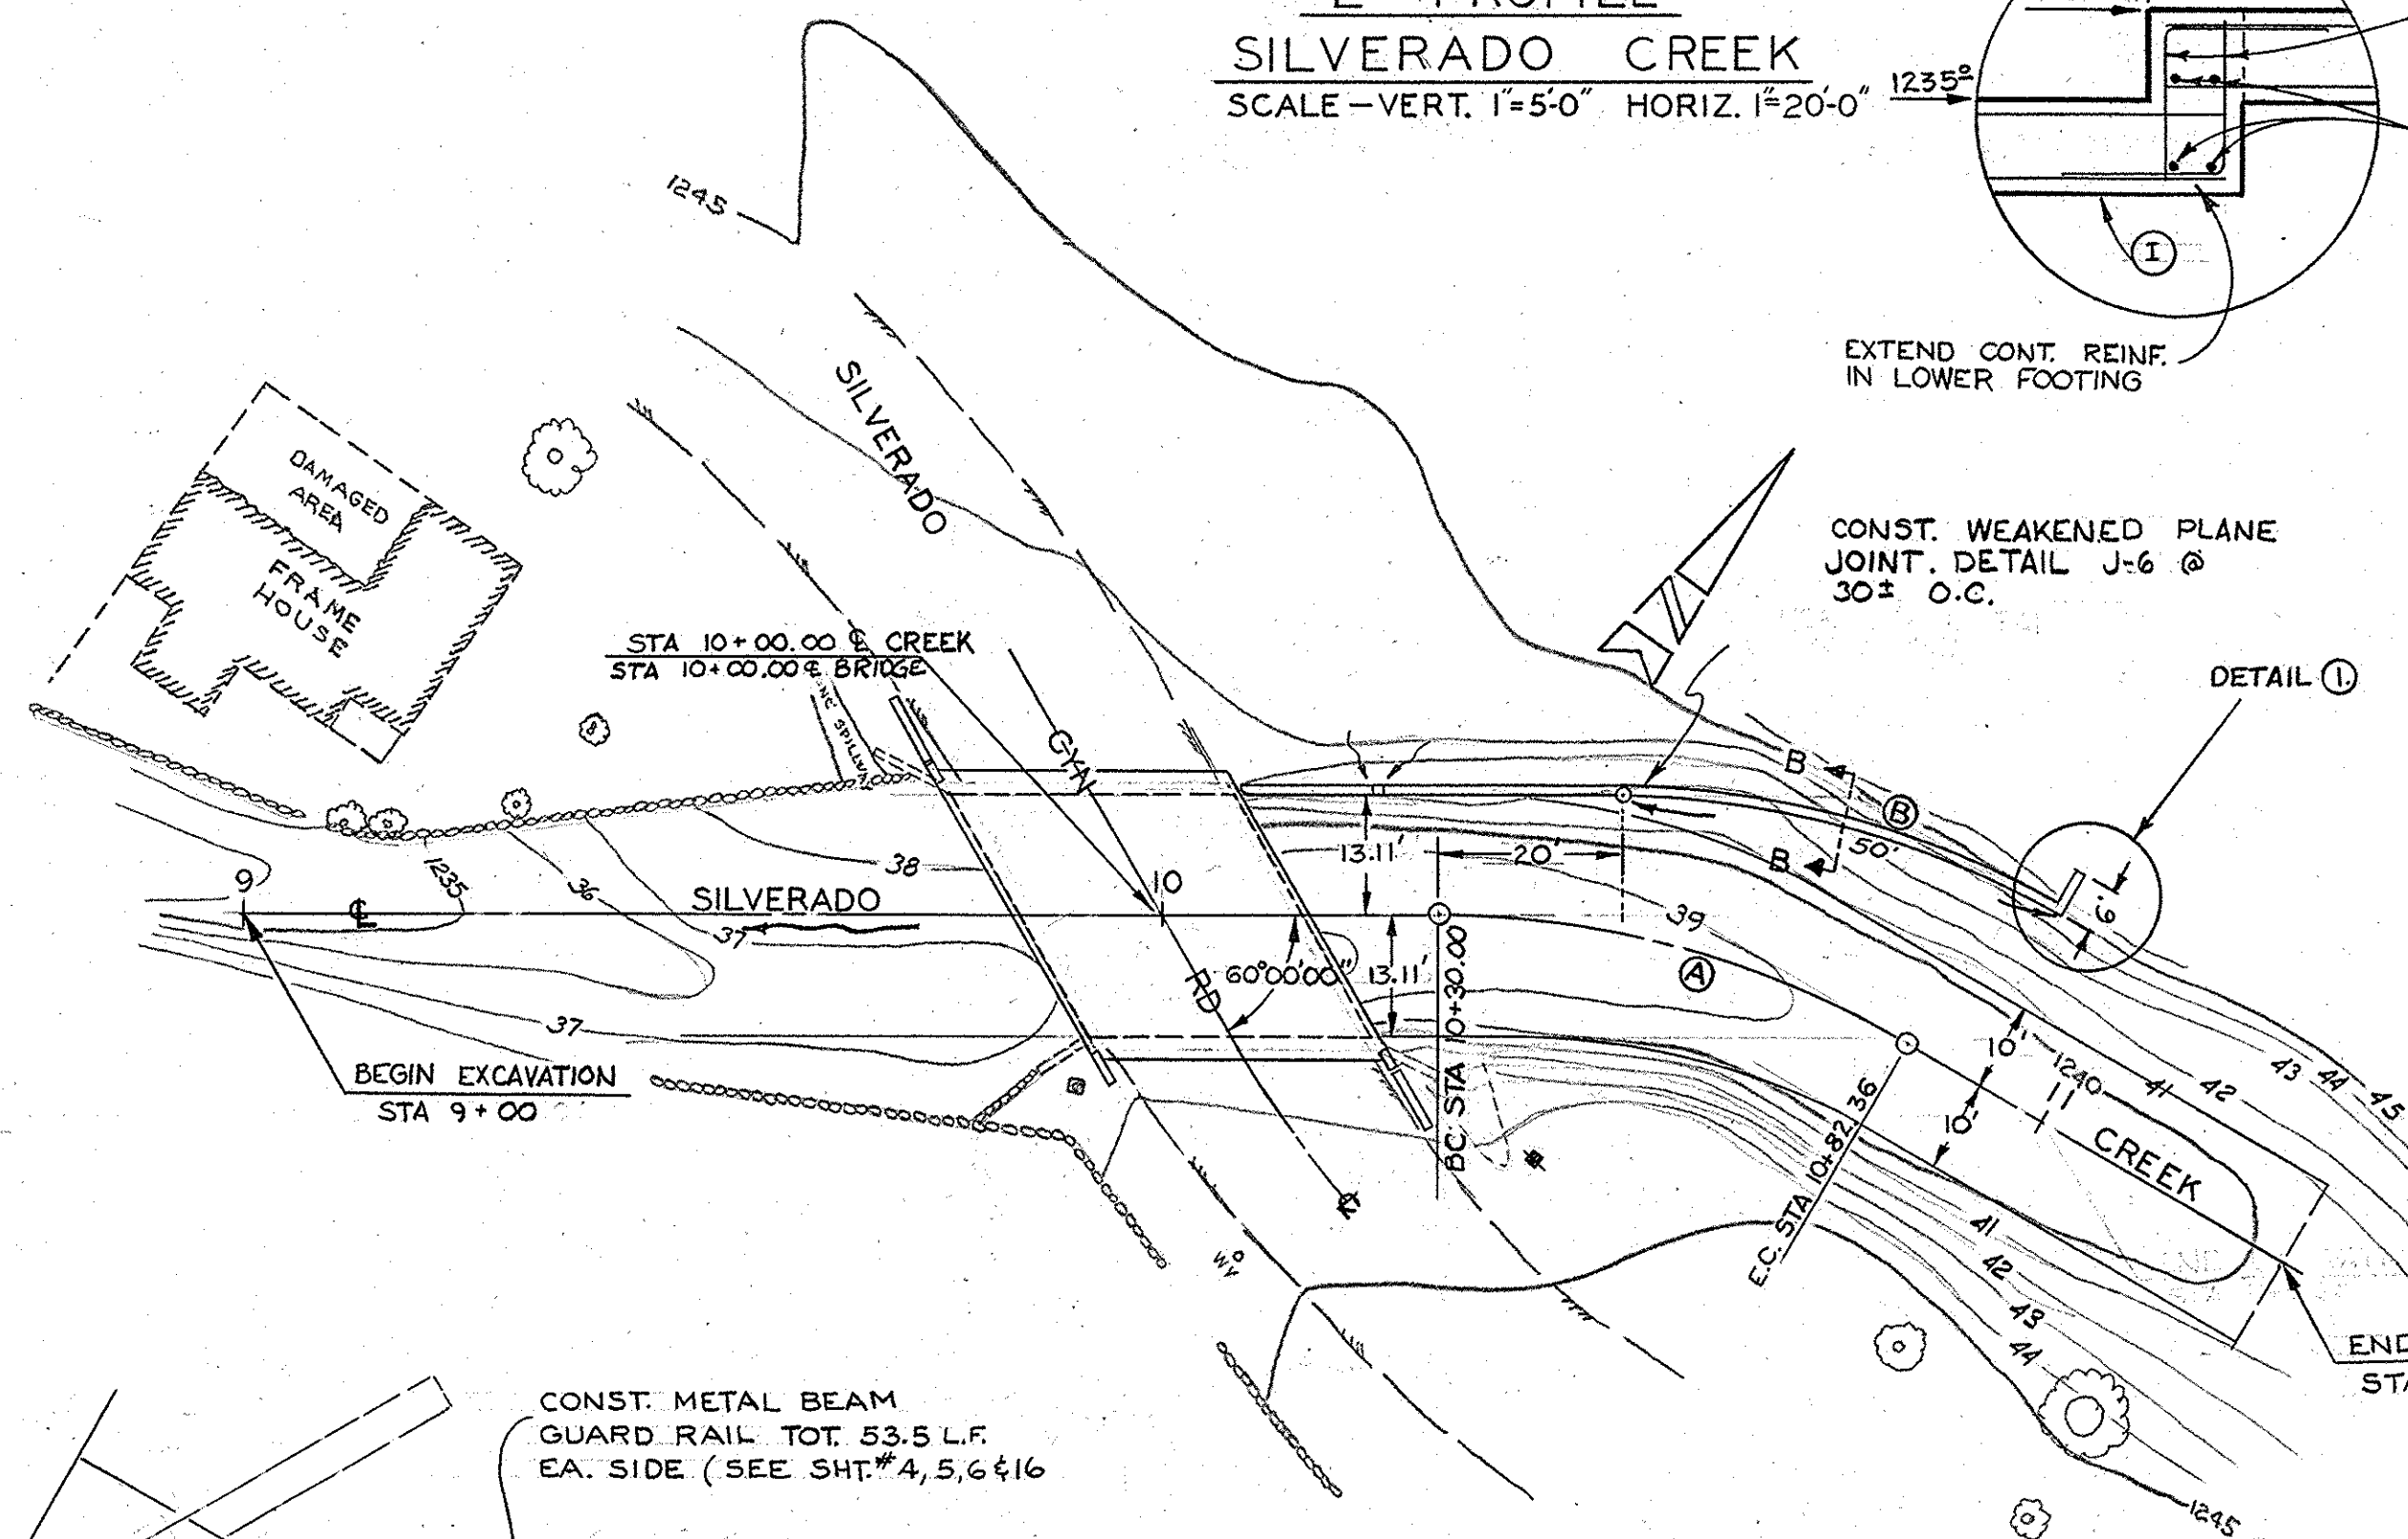

PLAN
SILVERADO CREEK
SCALE 1"=20'-0"

TYPICAL SECTION
CHANNEL
NO SCALE


A SILVERADO CREEK
CURVE DATA

$\Delta = 30^\circ 00' 00''$
 $R = 100.00'$
 $L = 52.36'$
 $T = 26.79'$

B LAYOUT LINE / RETAINING
WALL CURVE DATA


$\Delta = 28^\circ 36' 52''$
 $R = 100.00'$
 $L = 50.00'$
 $T = 25.53'$

CONSTRUCTION PLANS - BRIDGES
Silverado Canyon Road
Sheet 3 of 12
Red. 22.5:1 Scale: as shown
Vellum

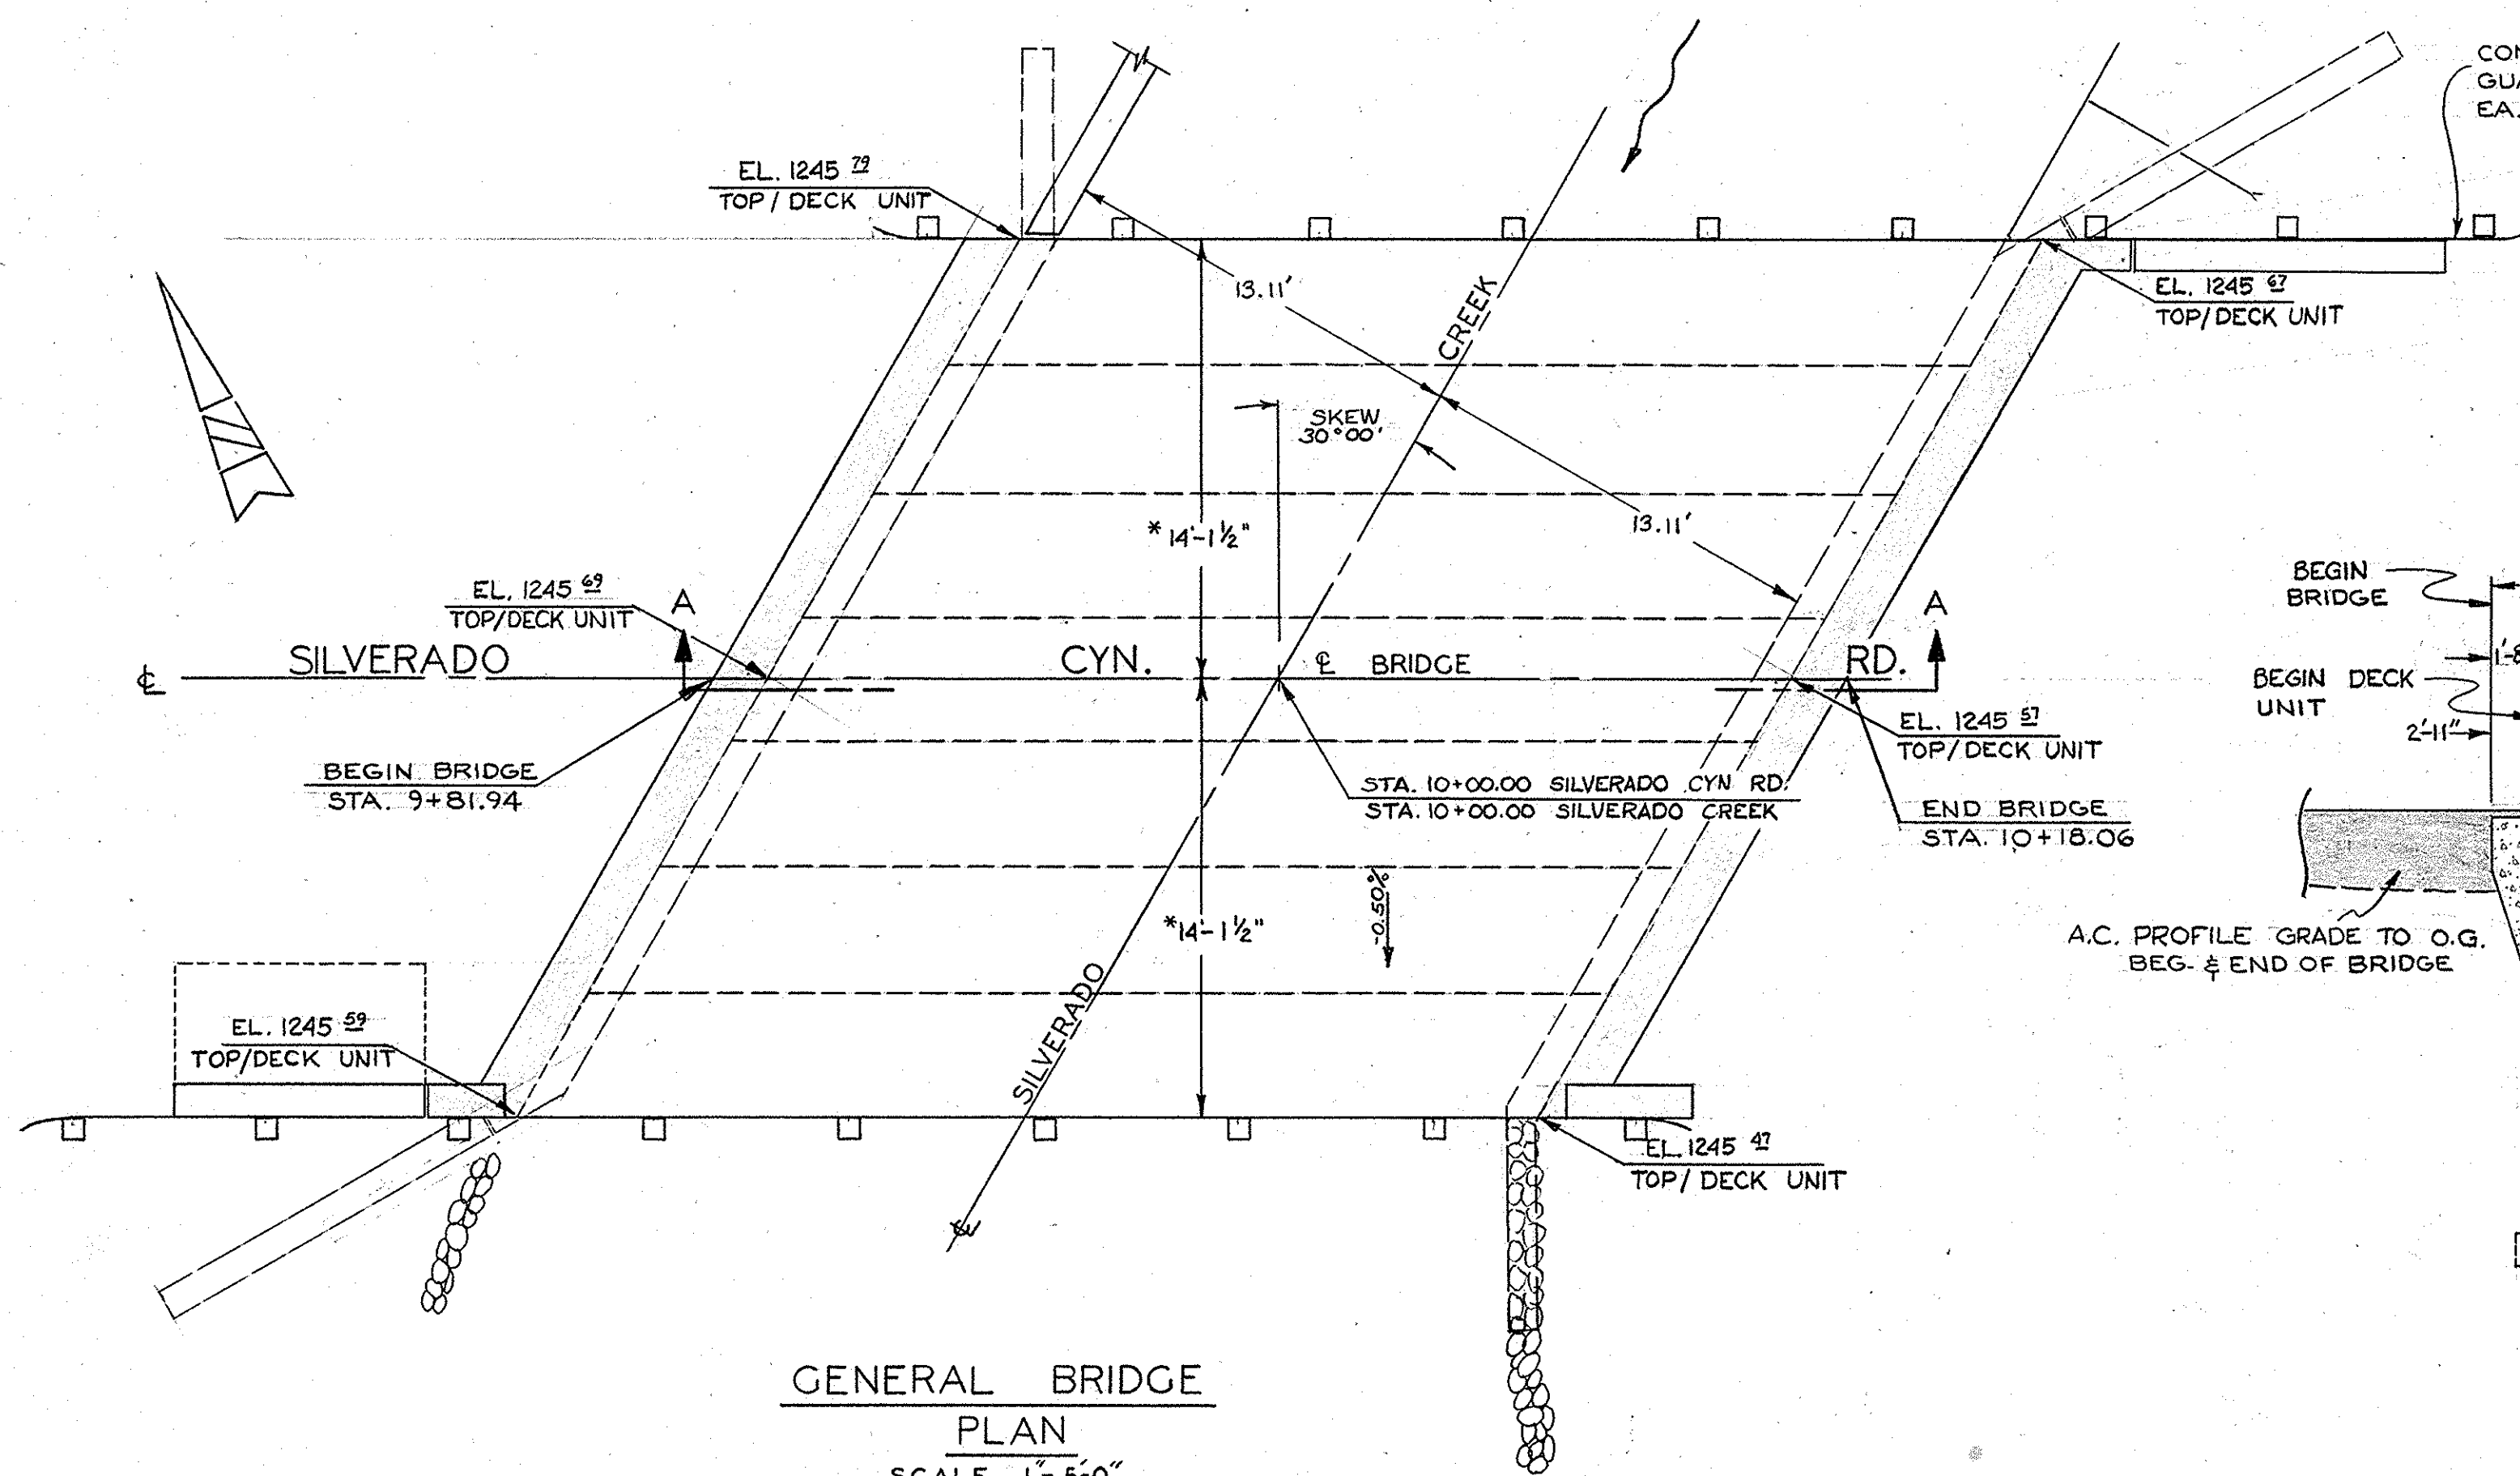


GENERAL BRIDGE
PLAN
SCALE 1"=5'-0"

*INCLUDES 1/2" TOLERANCE BETW. UNITS

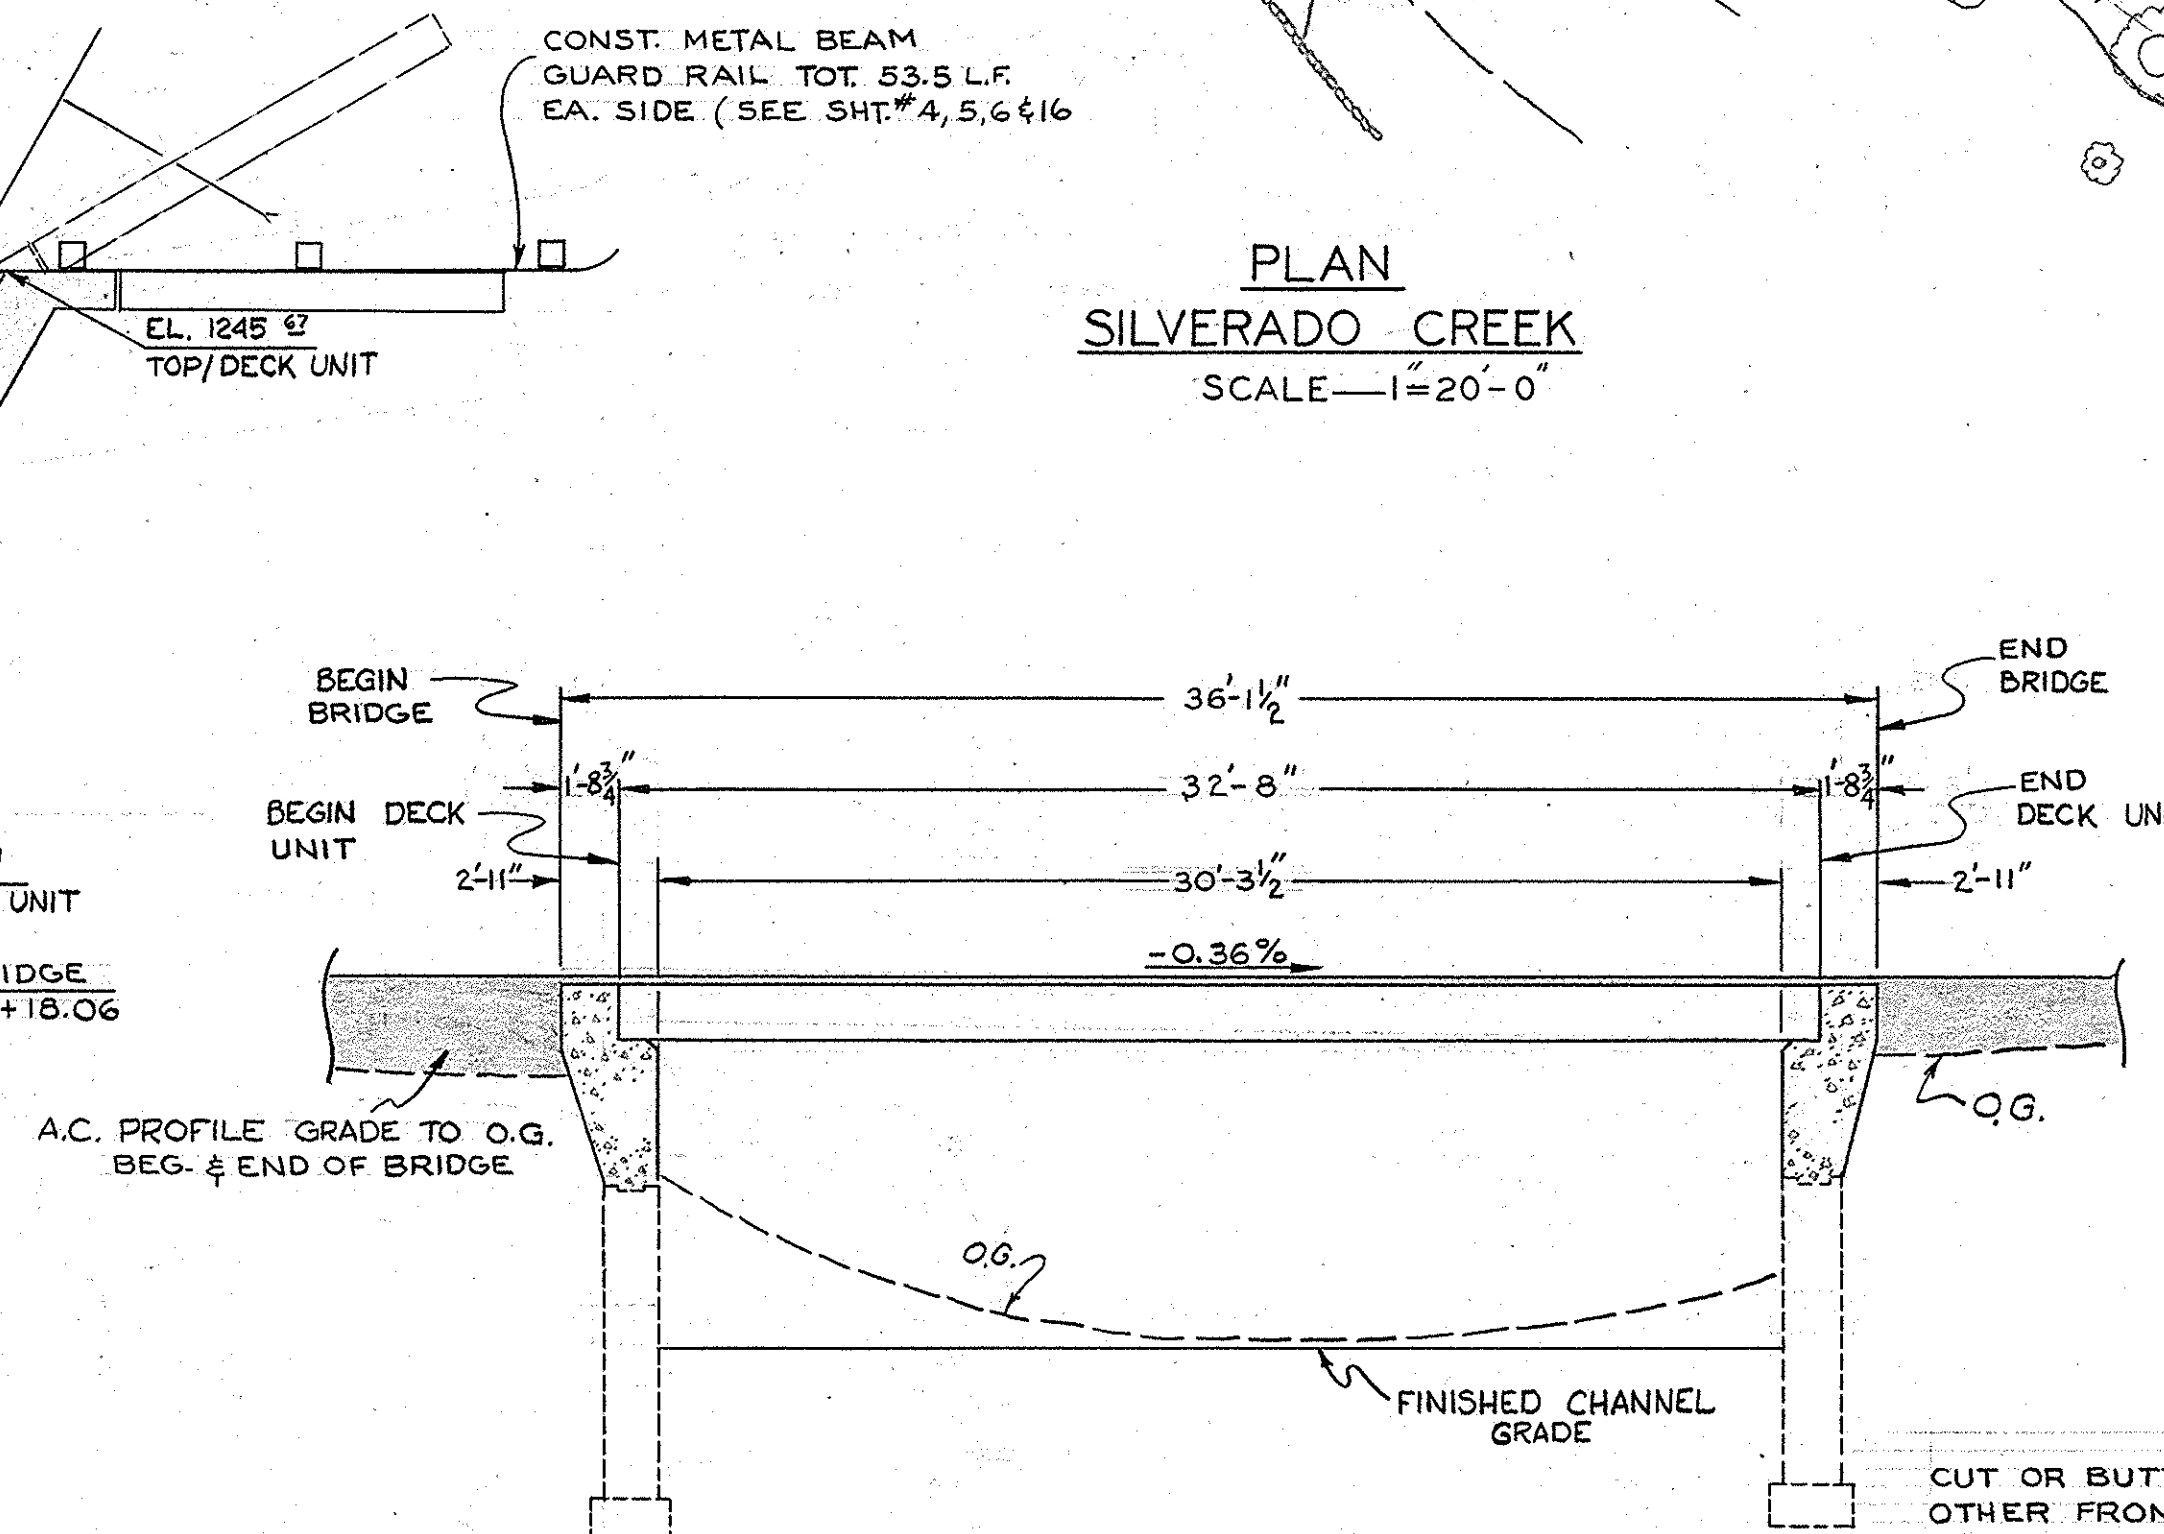


SECTION A-A
SCALE 1"=5'-0"

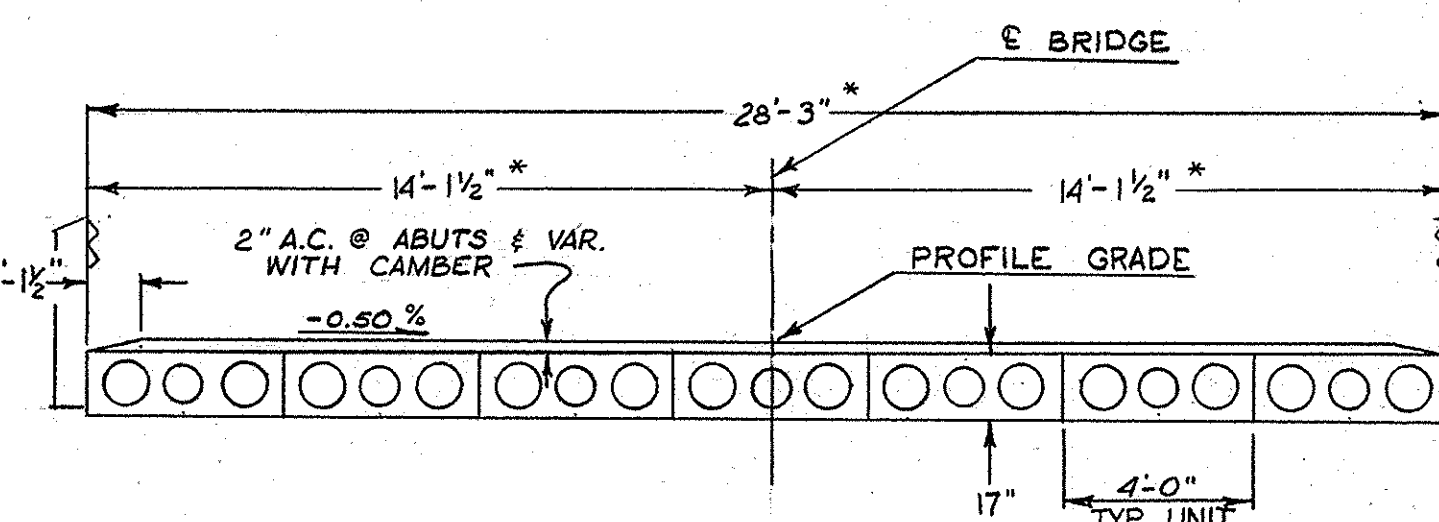

TYPICAL SECTION
SCALE 1/4"=1'-0"

* INCLUDES 1/2" TOLERANCE BET. UNITS

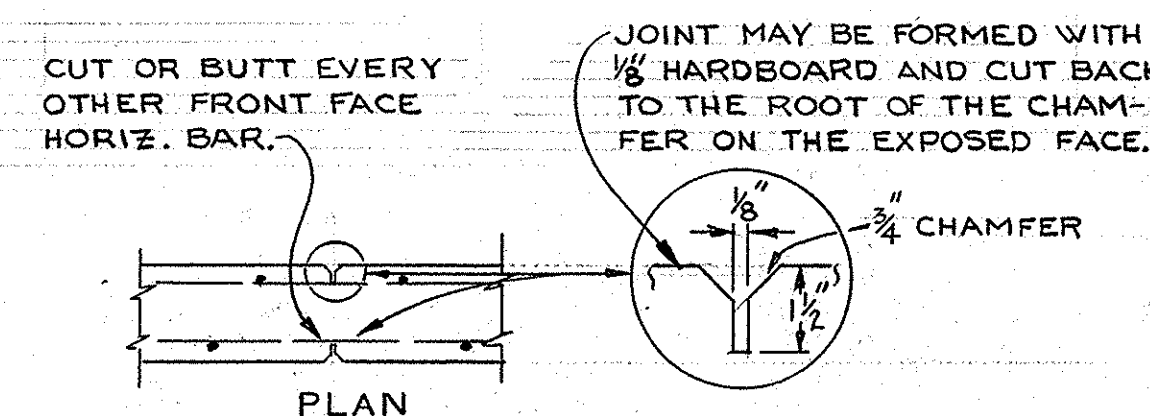

DETAIL J-6
NO SCALE

ORANGE COUNTY ROAD DEPARTMENT
SILVERADO CYN. RD.
BRIDGE SV-9
ACROSS
SILVERADO CREEK
GENERAL BRIDGE PLAN
& CREEK DETAILS

NOTED

SHEET 3 OF 12