



FINAL SURVEYED BY DATE
 SURVEY PLOTTED BY DATE
 NOTE BOOK NO. NO.
 TEMPLATE AREAS CHECKED
 AREAS CHECKED

ORIGINAL SURVEYED BY DATE
 SURVEY PLOTTED BY DATE
 NOTE BOOK NO. NO.
 TEMPLATE AREAS CHECKED
 AREAS CHECKED

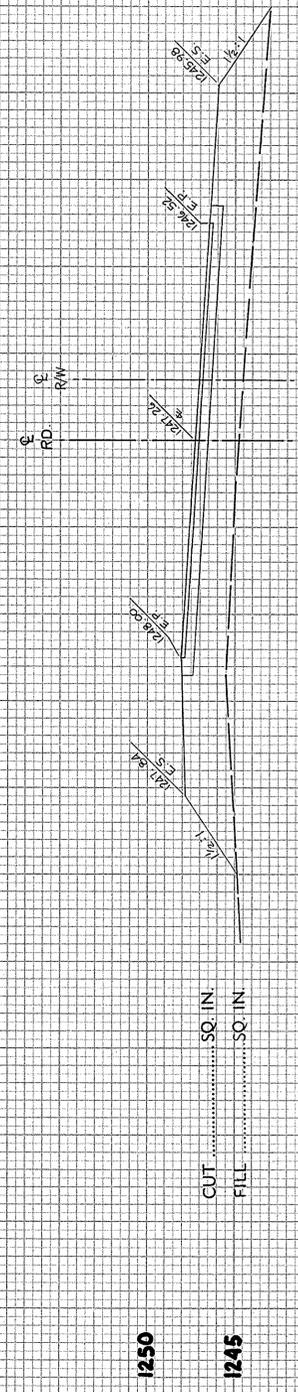


CUT SQ. IN.
 FILL SQ. IN.

STA 9+00

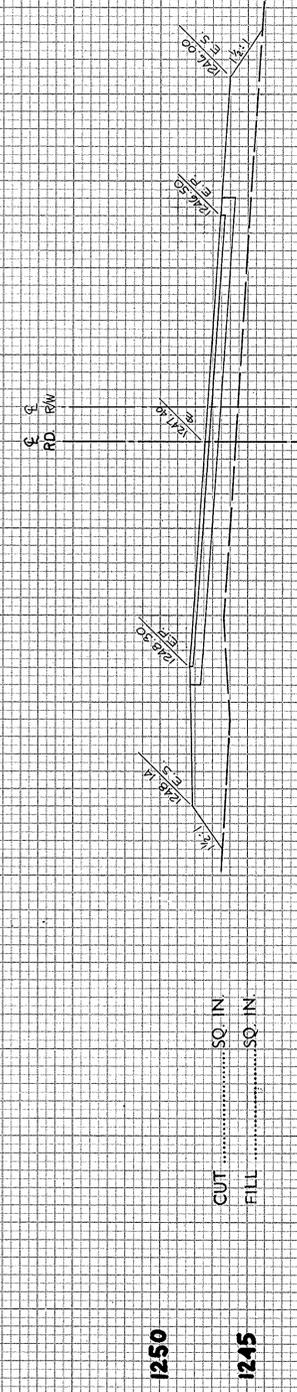


CUT SQ. IN.
 FILL SQ. IN.

STA 8+50

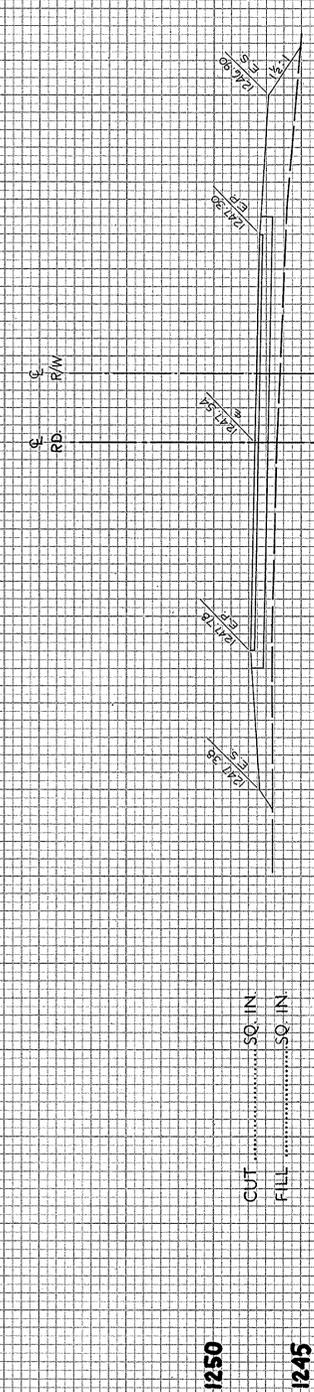


CUT SQ. IN.
 FILL SQ. IN.

STA 8+00

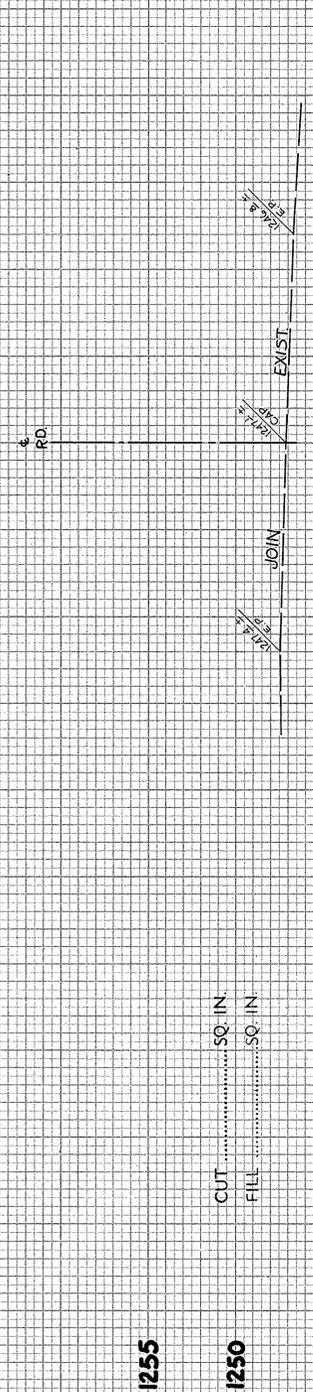


CUT SQ. IN.
 FILL SQ. IN.

STA 7+25
 (INSERT BELOW)

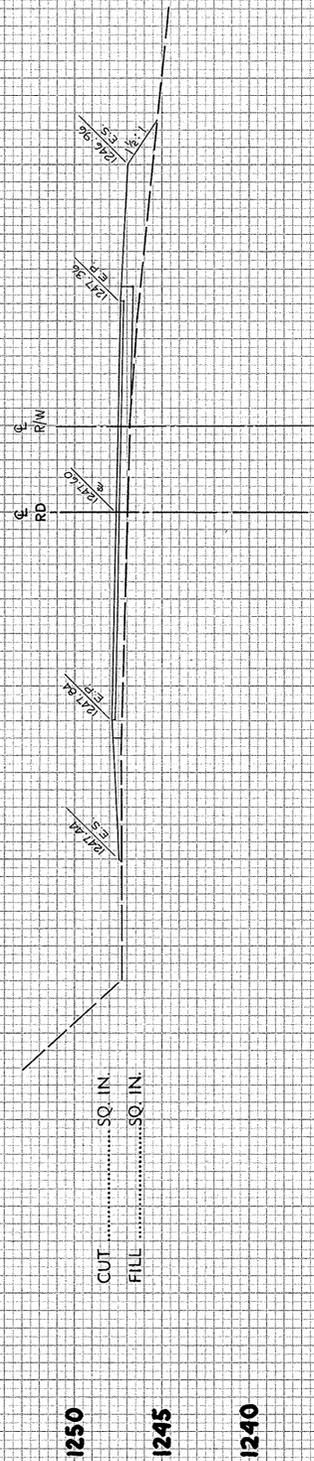

CUT SQ. IN.
 FILL SQ. IN.

STA 7+75

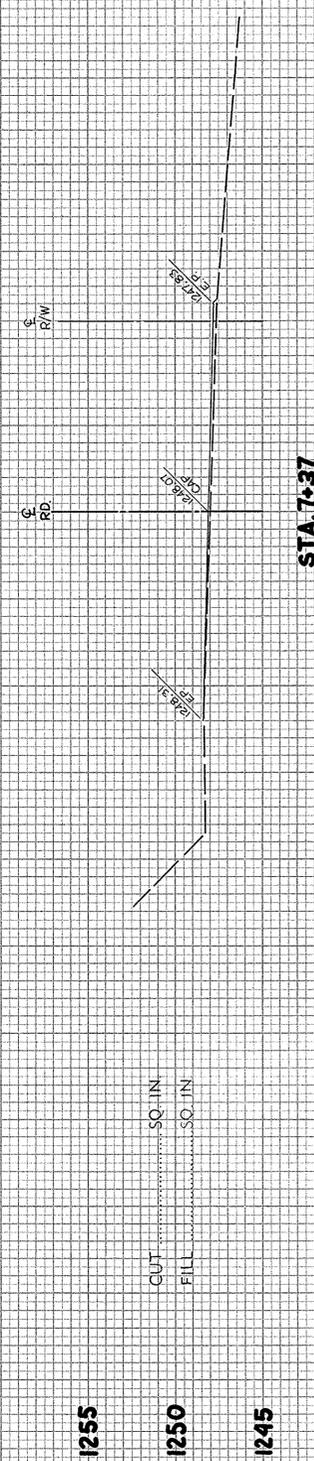

CUT SQ. IN.
 FILL SQ. IN.

STA 7+37