



FINAL SURVEY	SUBMITTED PLOTTED NOTE BOOK AREAS CHECKED	BY	DATE

ORIGINAL SURVEY	SUBMITTED PLOTTED NOTE BOOK AREAS CHECKED	BY	DATE

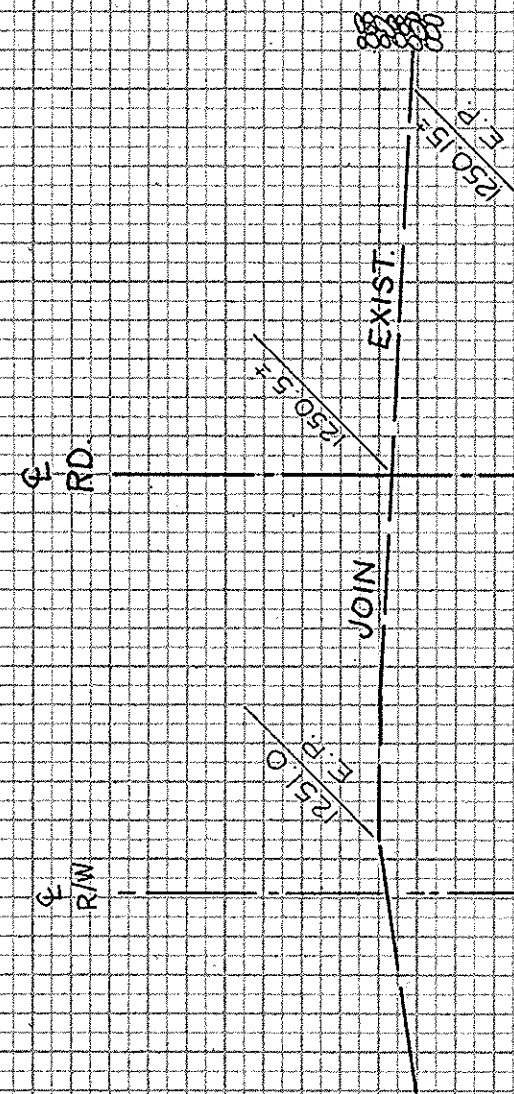


STA 11+70

CUT SQ. IN.
FILL SQ. IN.

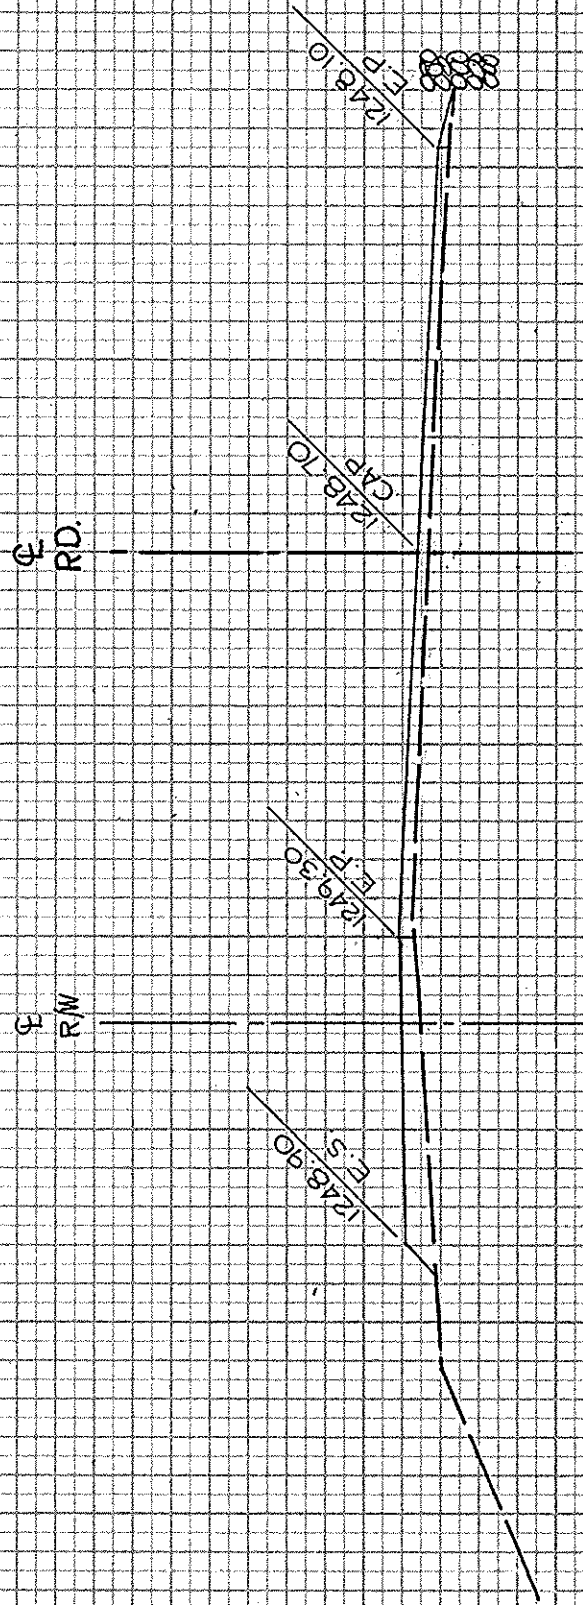


STA 11+35

CUT SQ. IN.
FILL SQ. IN.

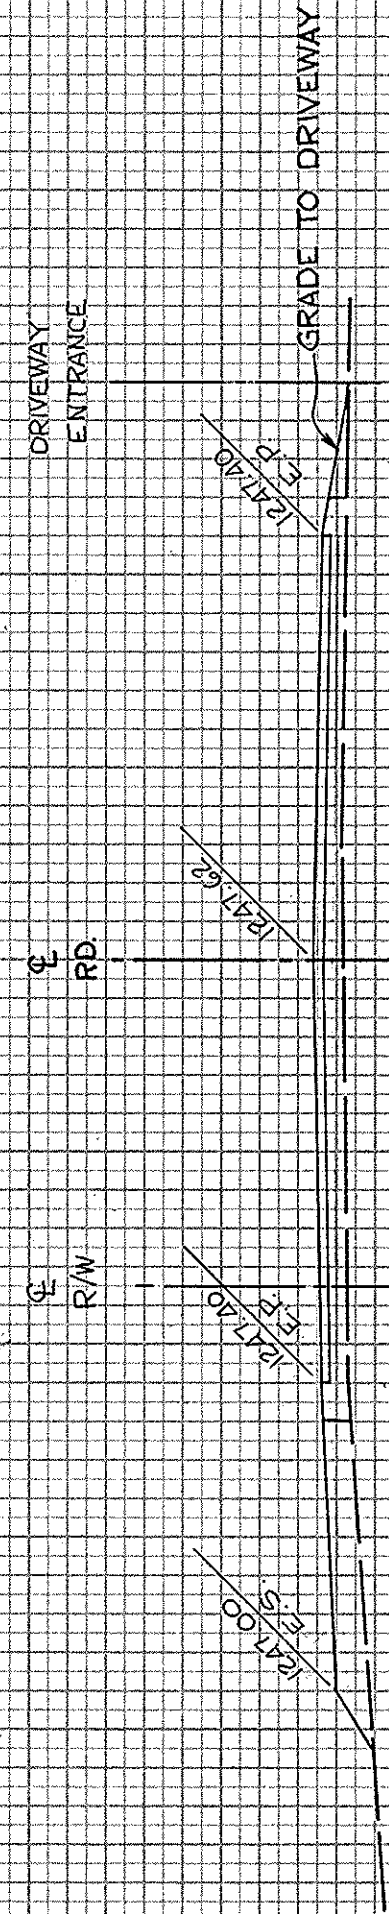


STA 11+00

CUT SQ. IN.
FILL SQ. IN.

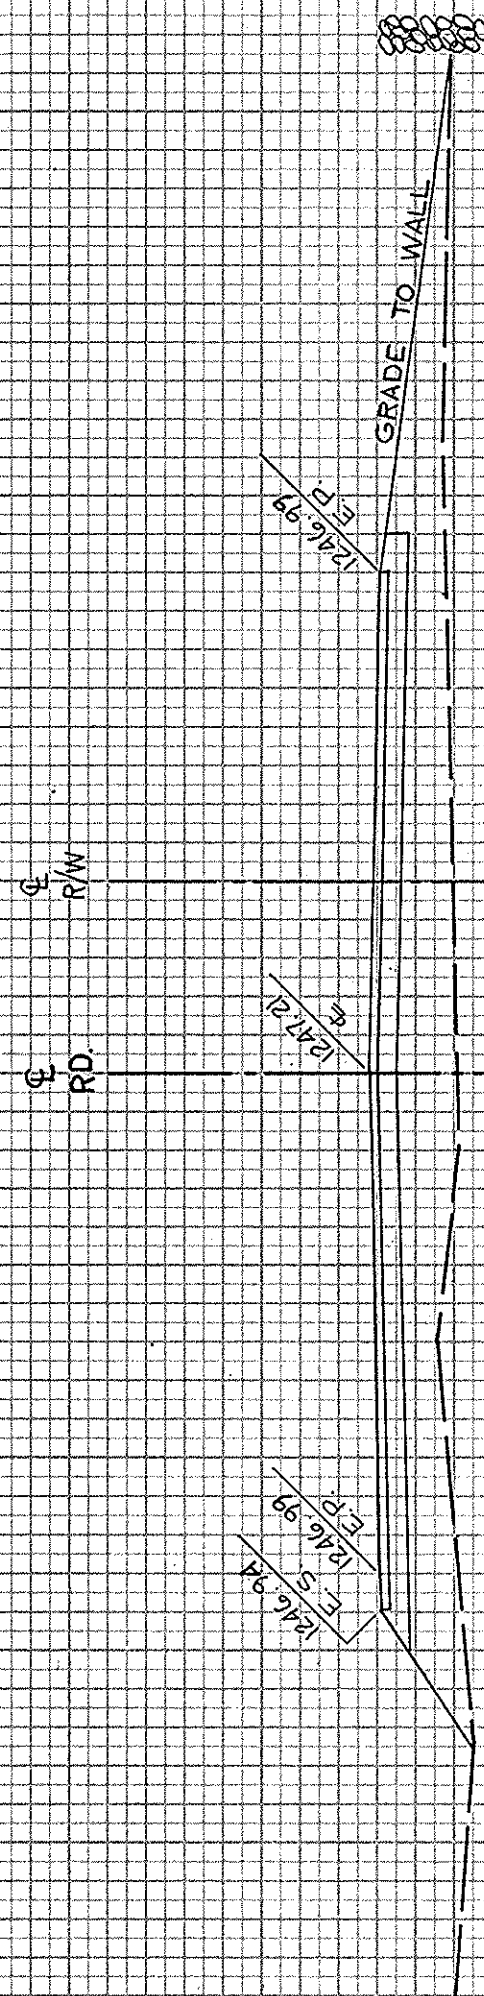


STA 10+50

CUT SQ. IN.
FILL SQ. IN.

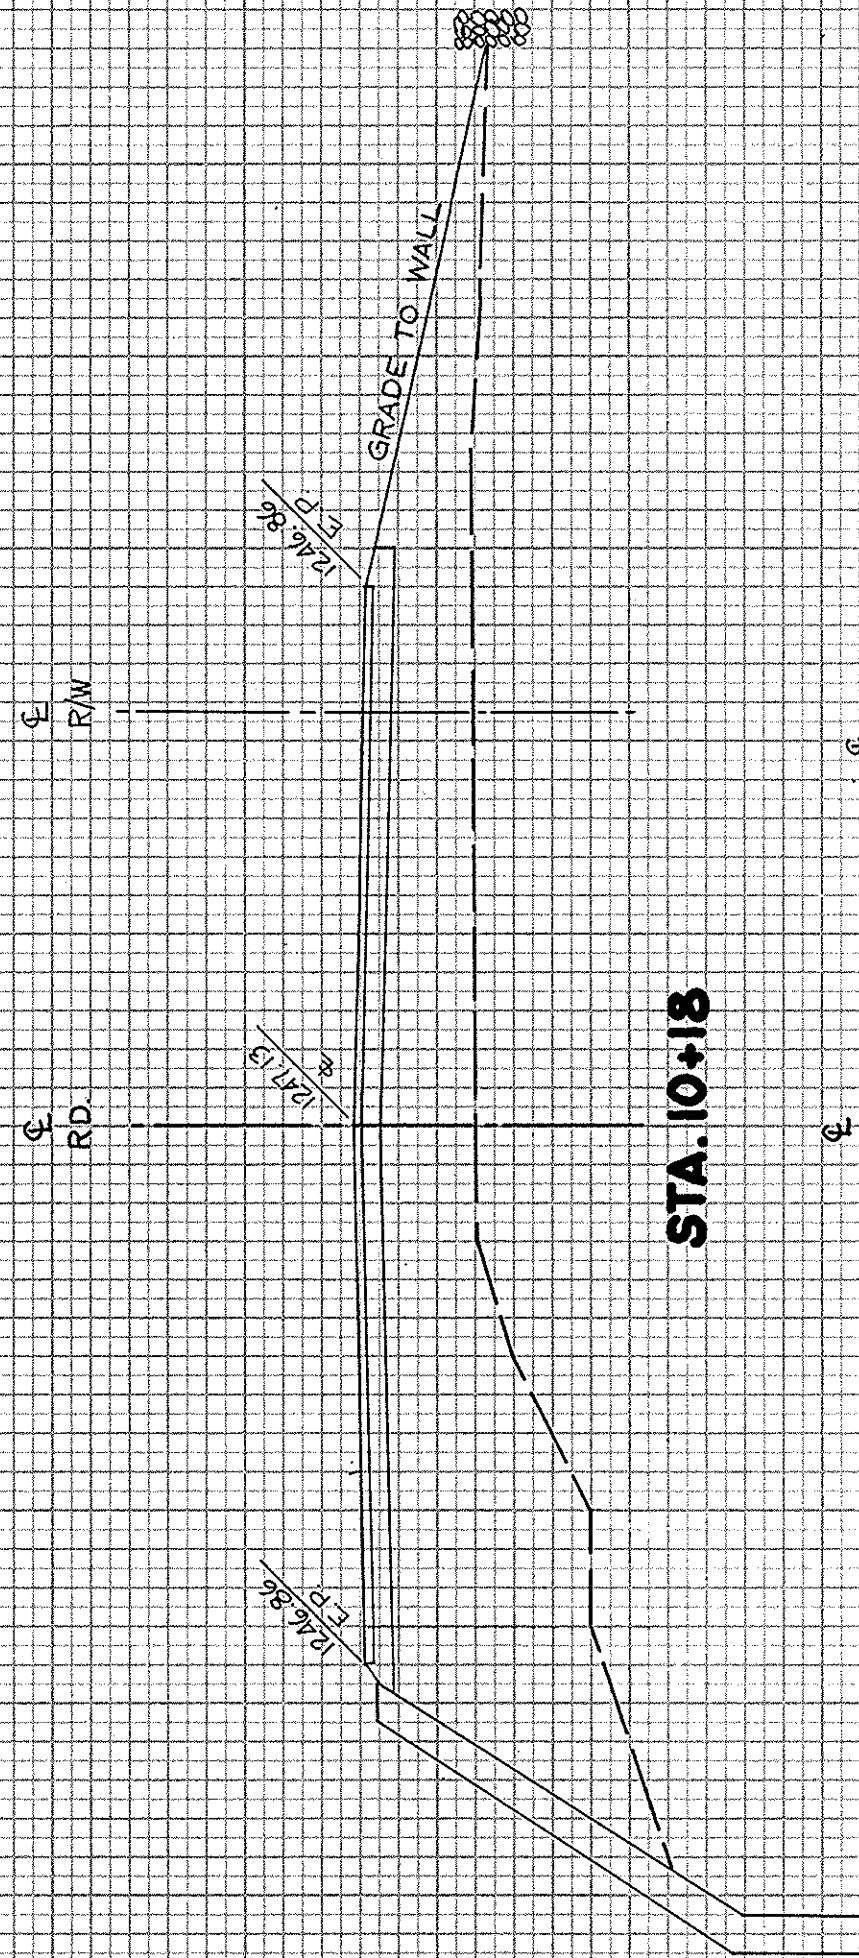


STA 10+18

CUT SQ. IN.
FILL SQ. IN.

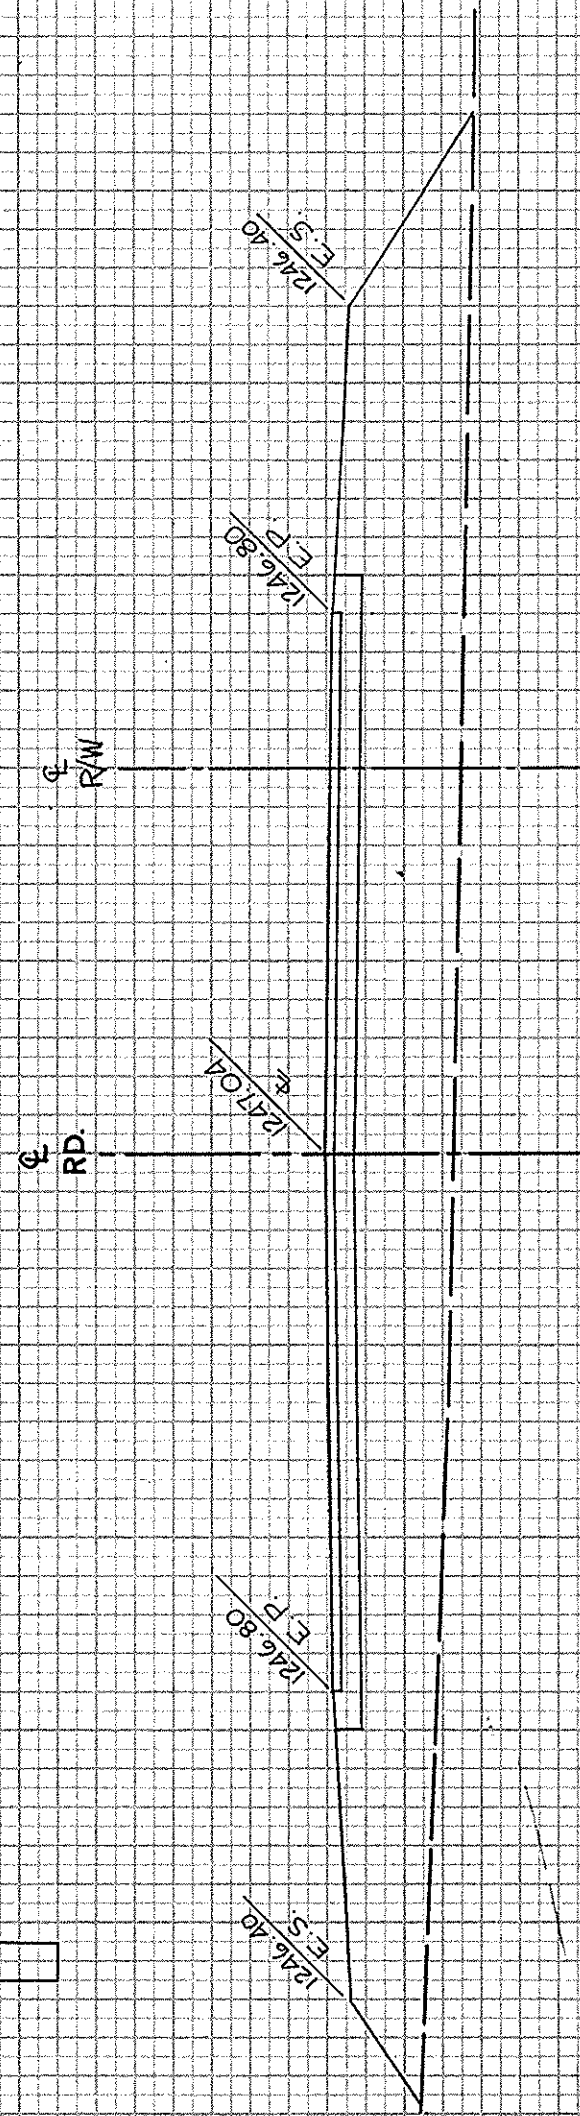

STA 9+82

CUT SQ. IN.
FILL SQ. IN.

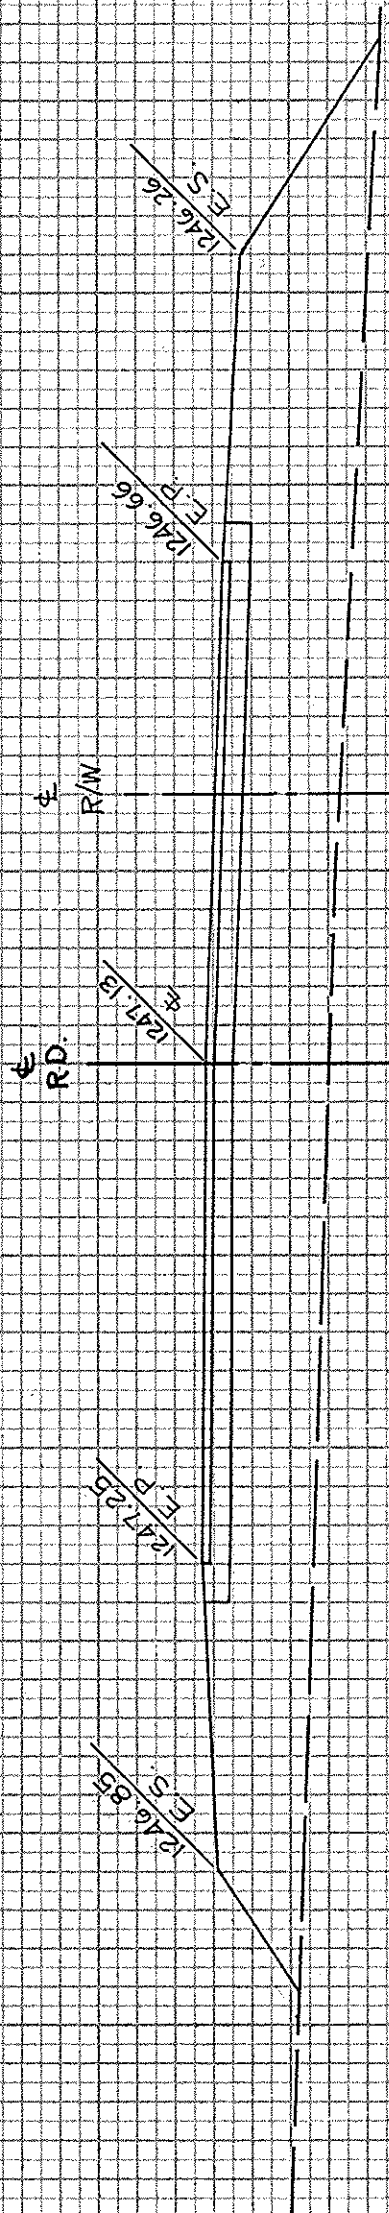

STA 9+50

CUT SQ. IN.
FILL SQ. IN.