


P. 17
3-19-77
D.C.

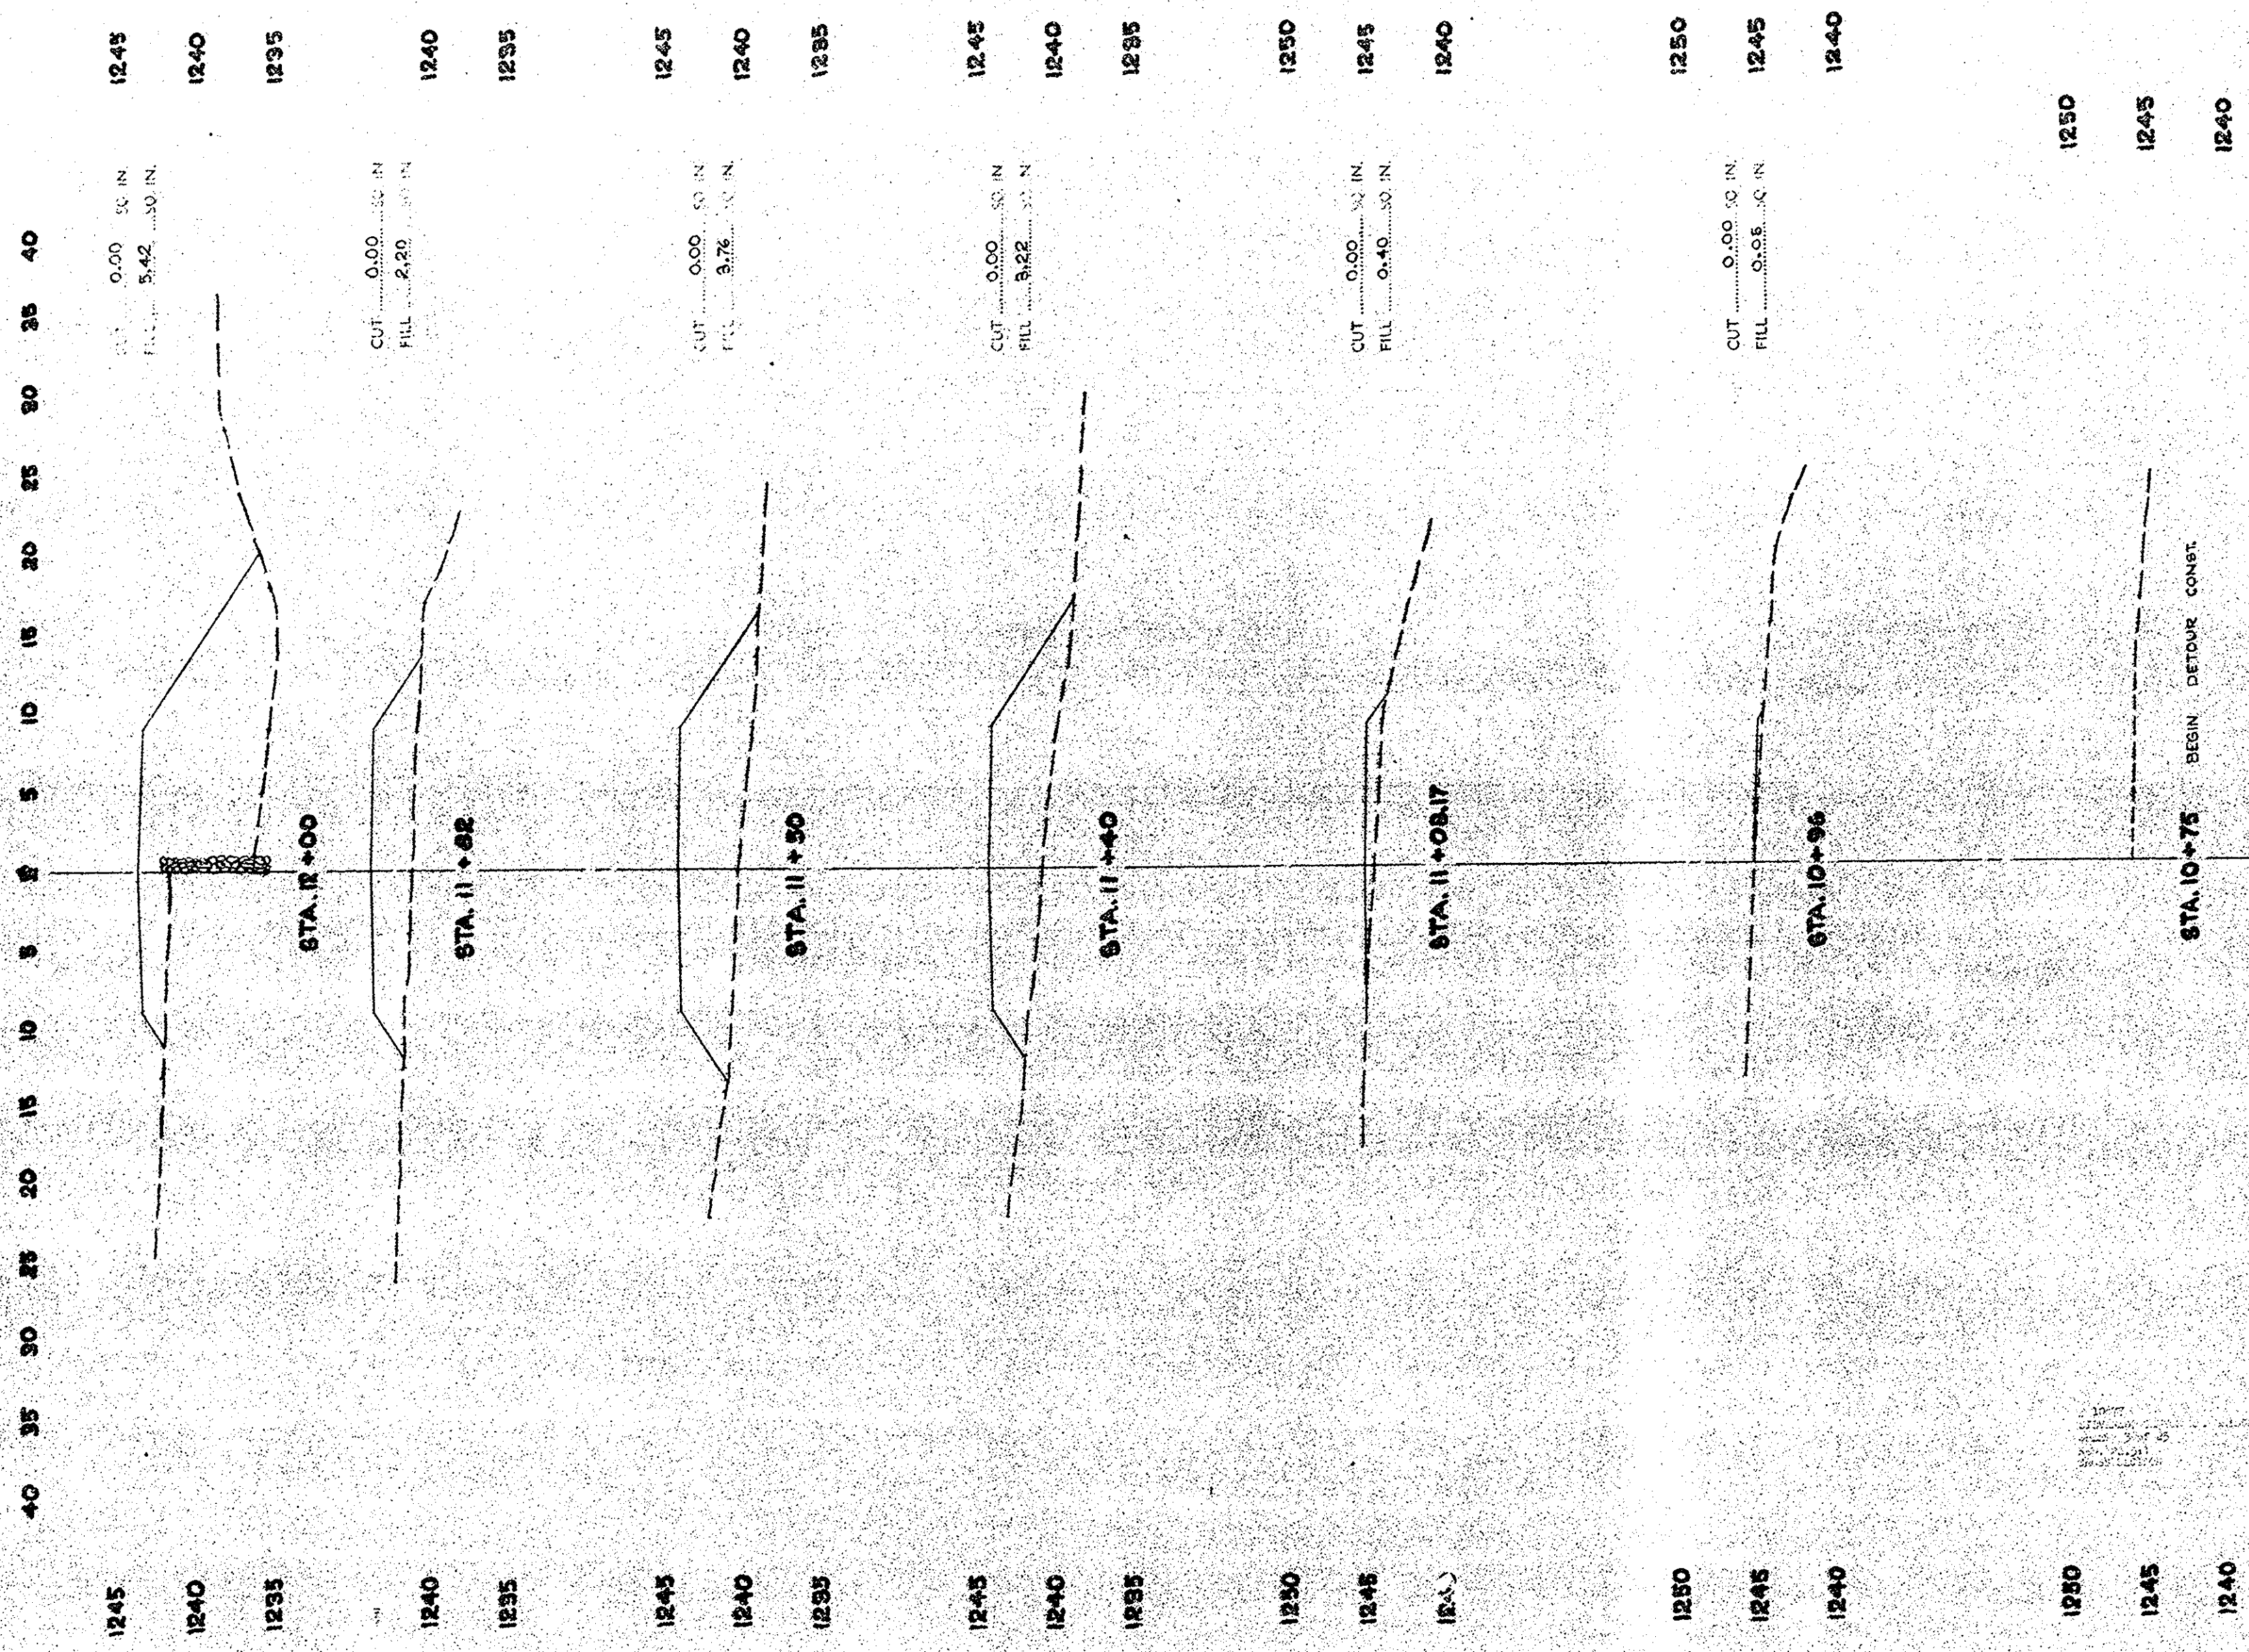

DETOUR ROAD SV-9
STA. 10+75 TO STA. 13+06.81
1" = 5'-0"

10677