


R. J. T.
1000
3-19-77
3-28-77

40 35 30 25 20 15 10 5 0 5 10 15 20 25 30 35 40

1250
1245
1240

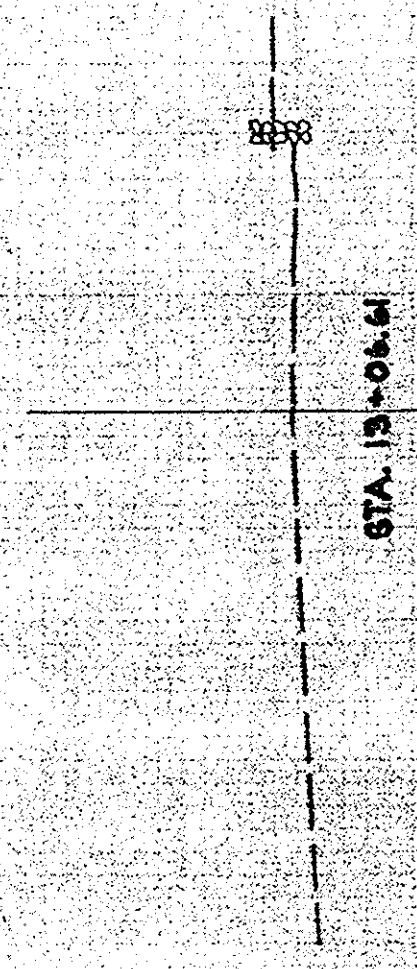

1250
1245
1240

1250
1245
1240


CUT 0.13 SQ. IN.
FILL 0.00 SQ. IN.



1250
1245
1240

1245
1240
1235
1230

CUT 0.20 SQ. IN.
FILL 5.05 SQ. IN.

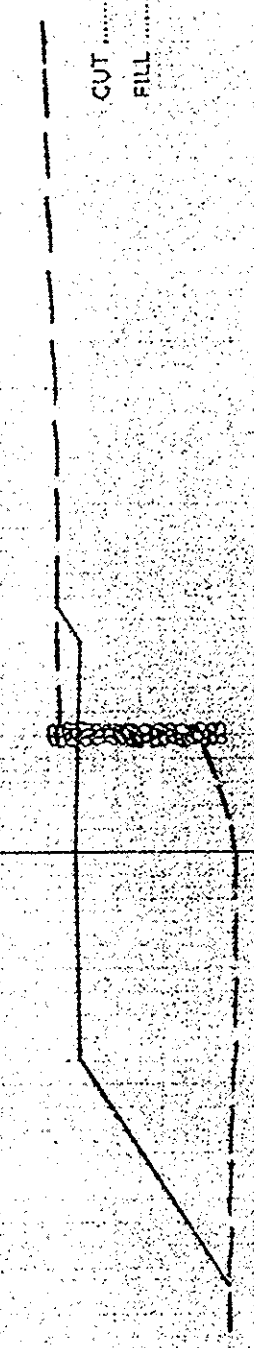

1245
1240
1235
1230

1245
1240
1235
1230

CUT 0.00 SQ. IN.
FILL 7.43 SQ. IN.



1245
1240
1235
1230

STRAIGHT EDGE RULE SE-48
STA. 10+75 TO STA. 13+06.61
1" = 50'

(2290) 11 12 11