
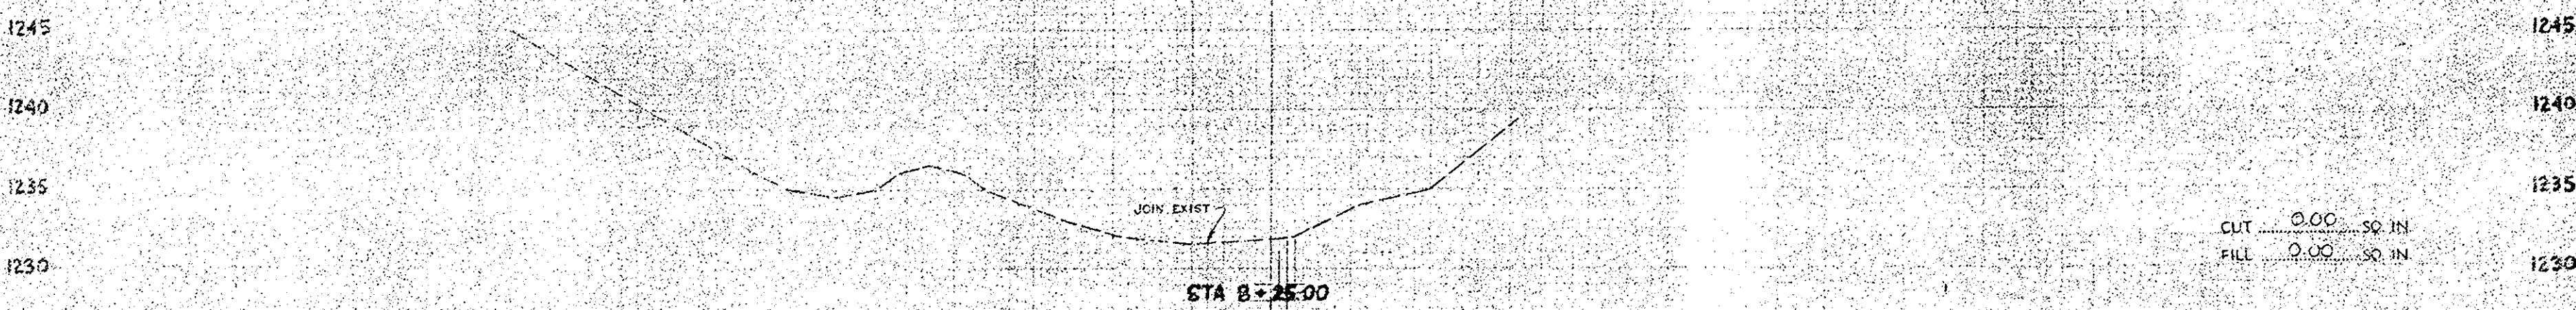
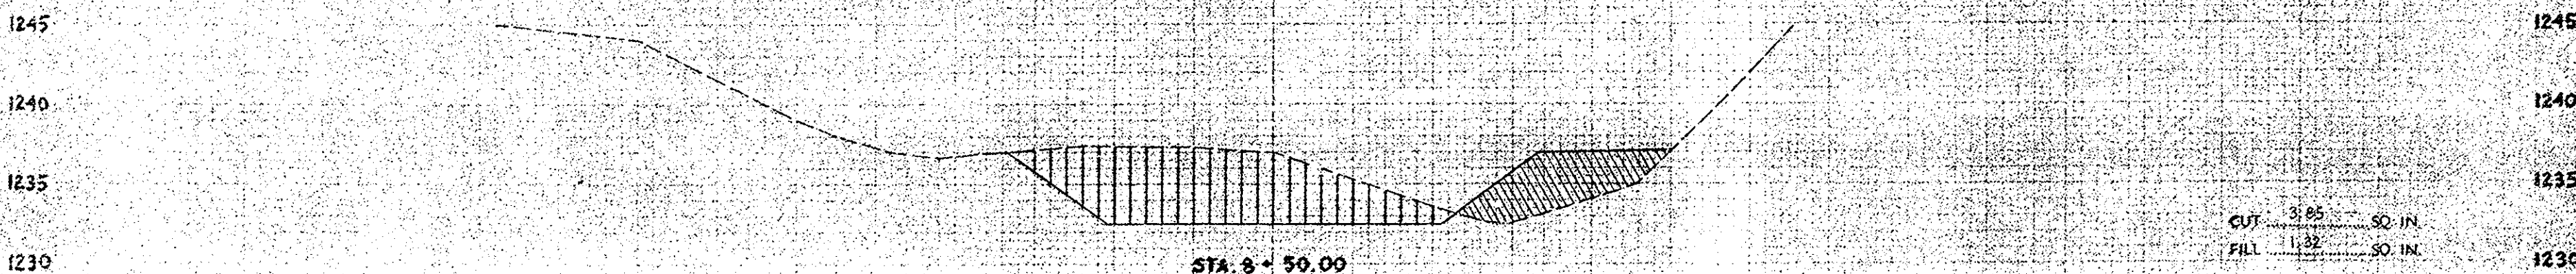
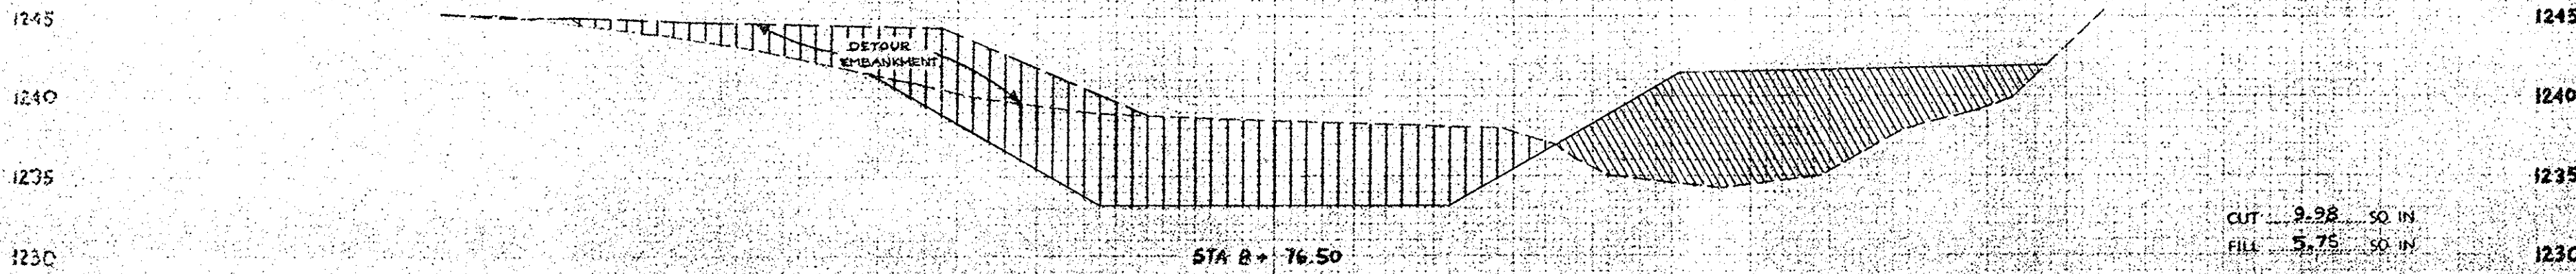


EXACT®

STRAIGHT EDGE RULE SE-88

BRIDGE 57-9
OVER ETERNOO CREEK
6 25

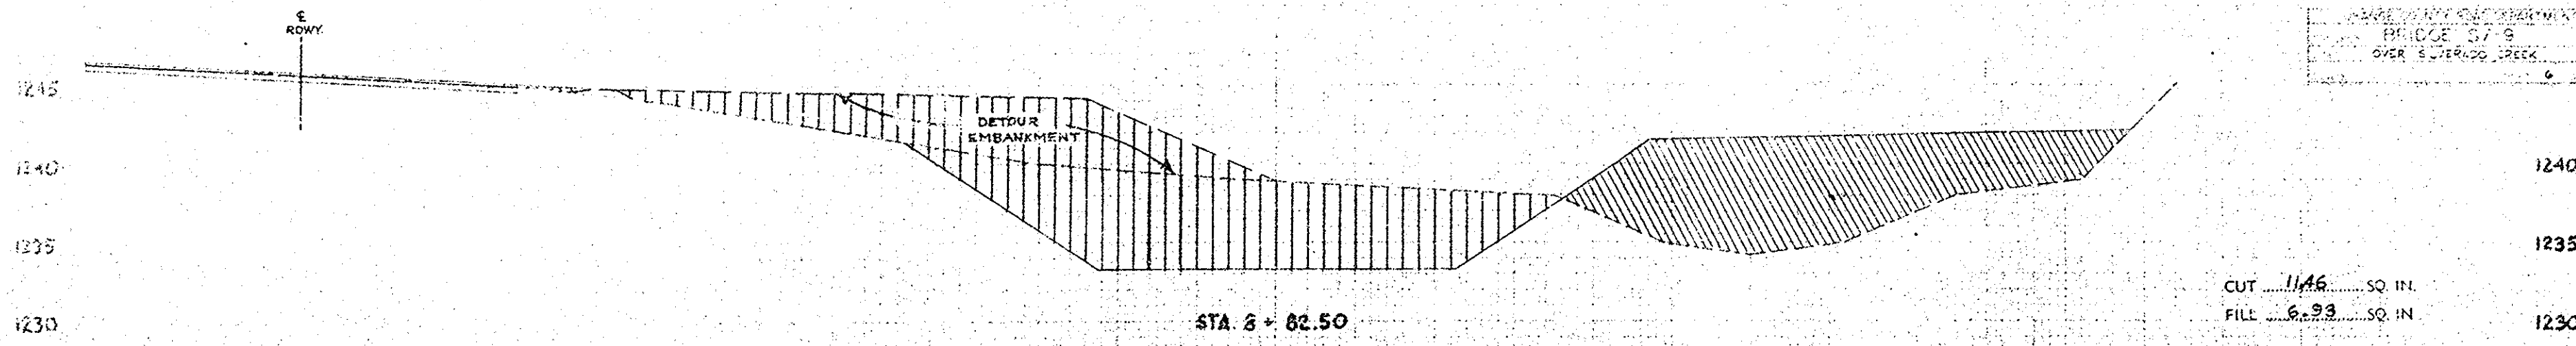

CREEK

DA 7 (267)