


EXACT®

STRAIGHT EDGE RULE SE-48

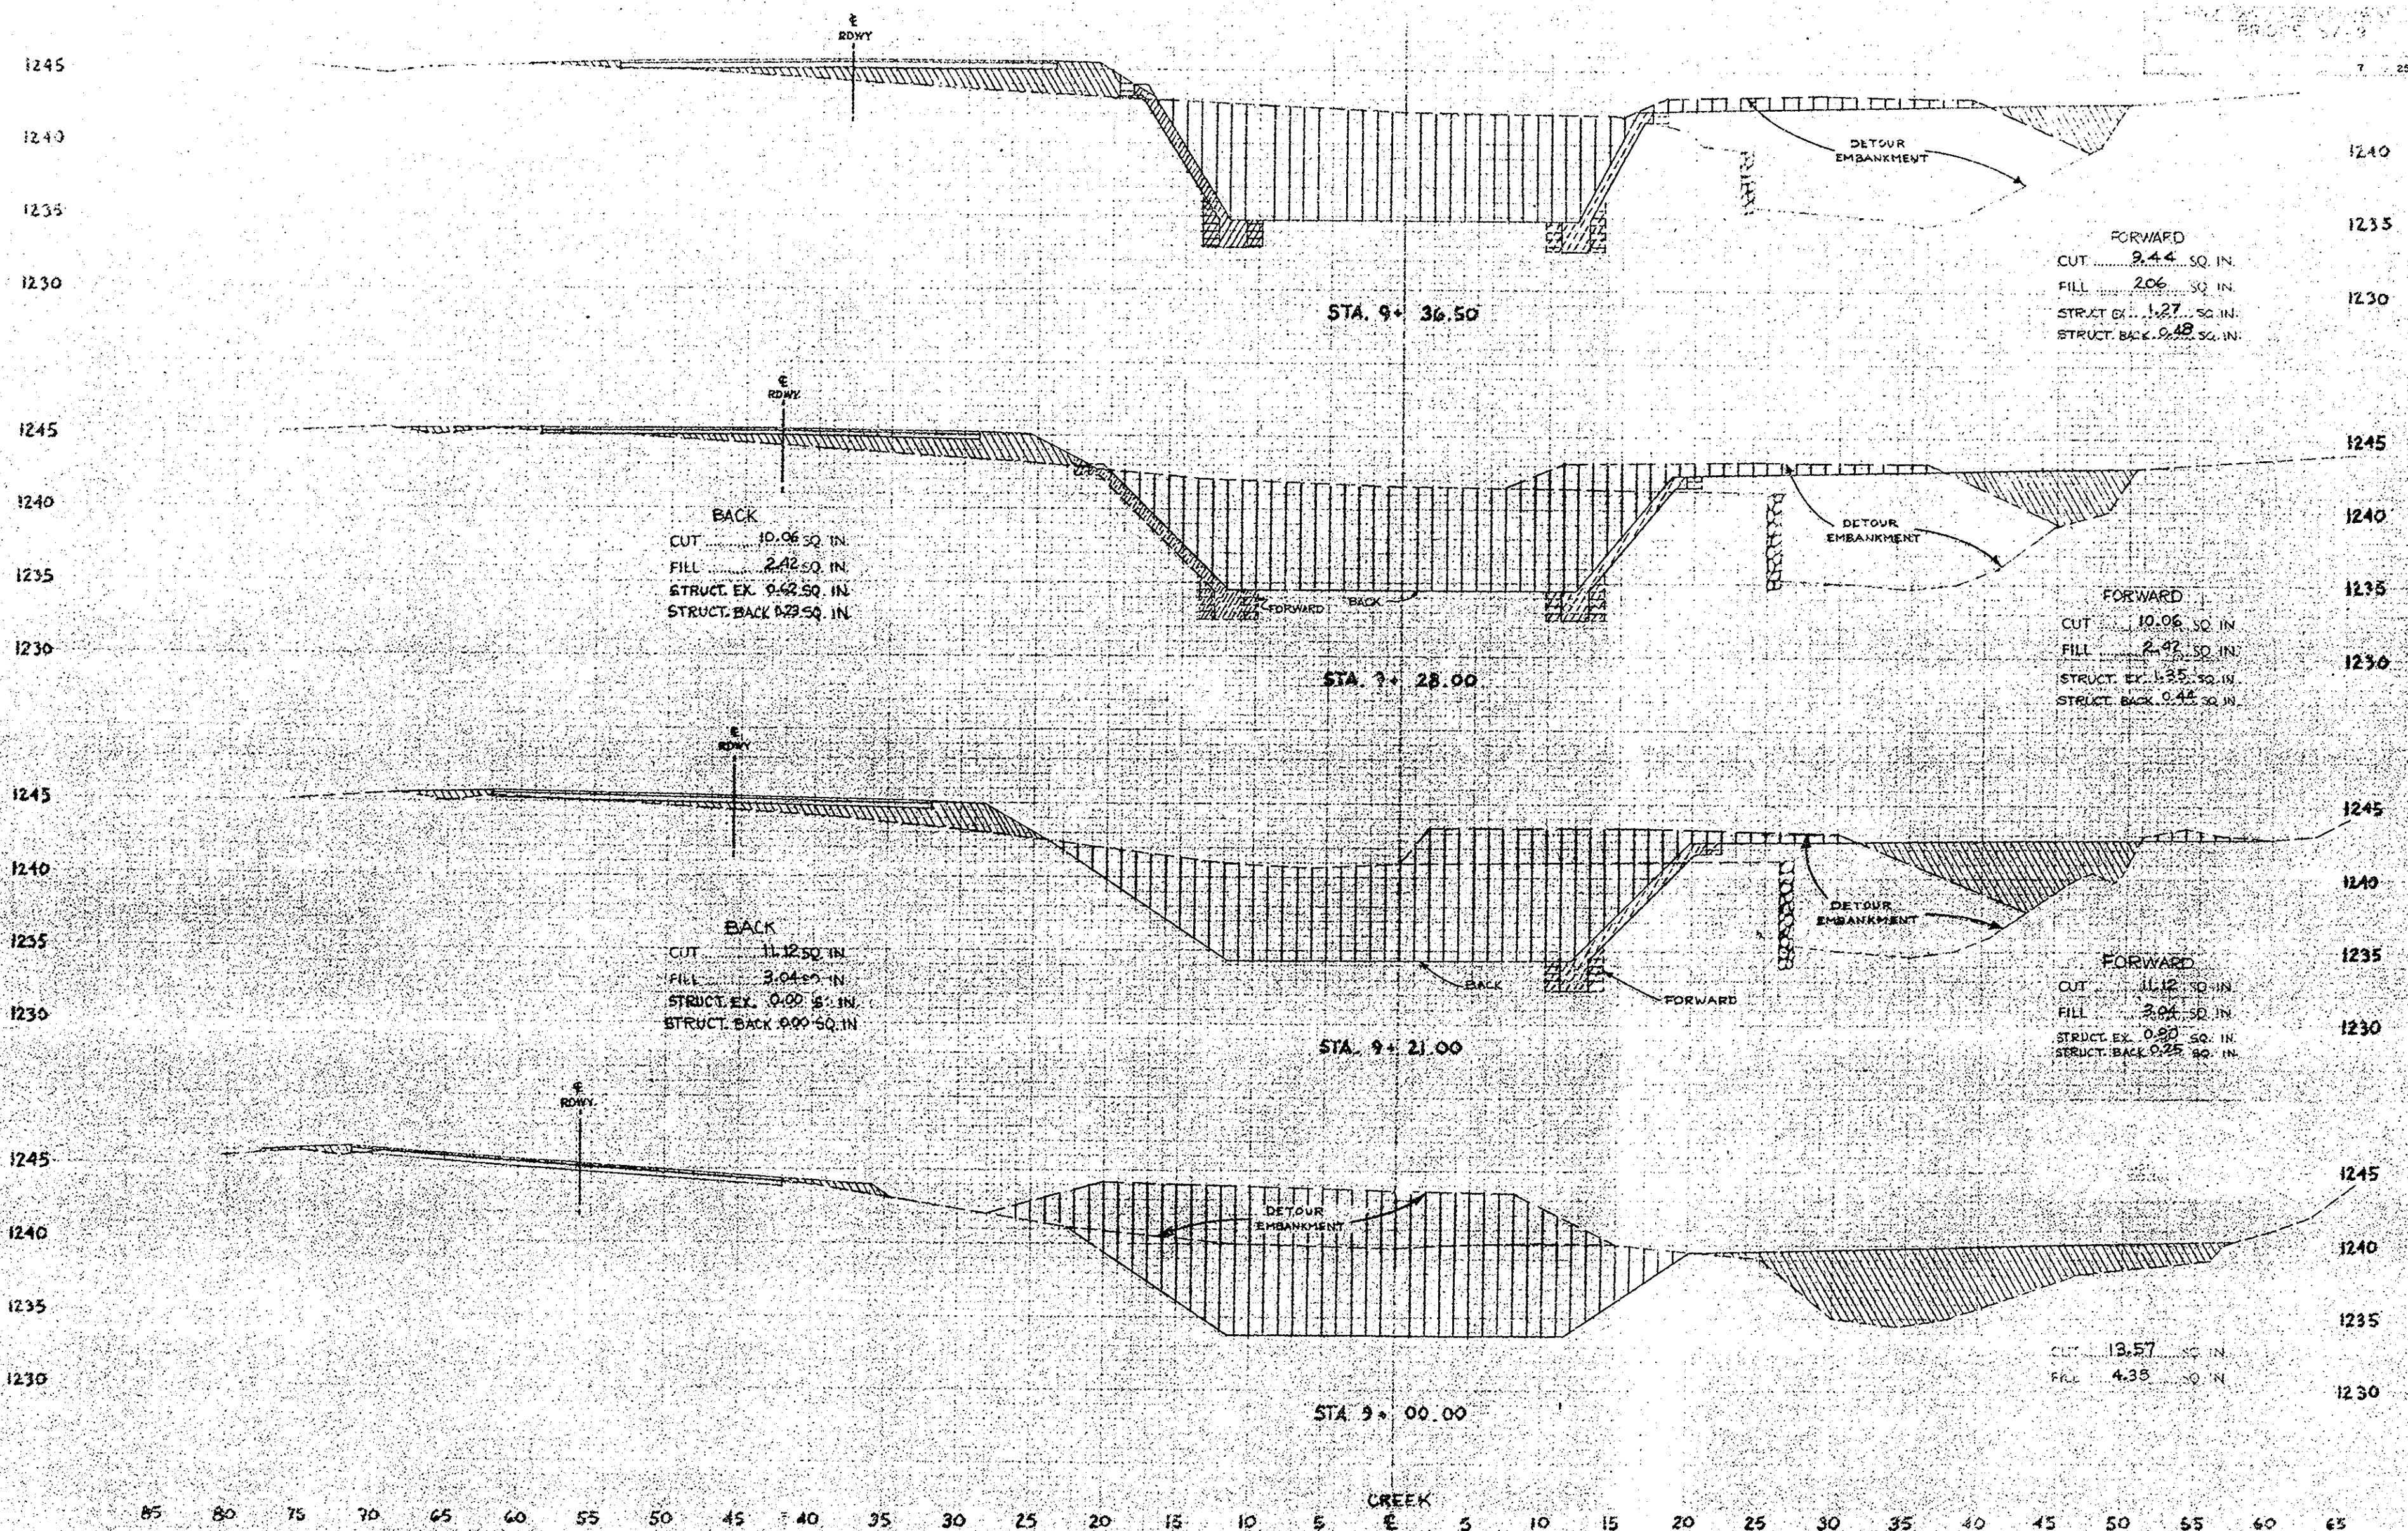

DR. 7 (10677)