


EXACT®

STRAIGHT EDGE RULE SE-48

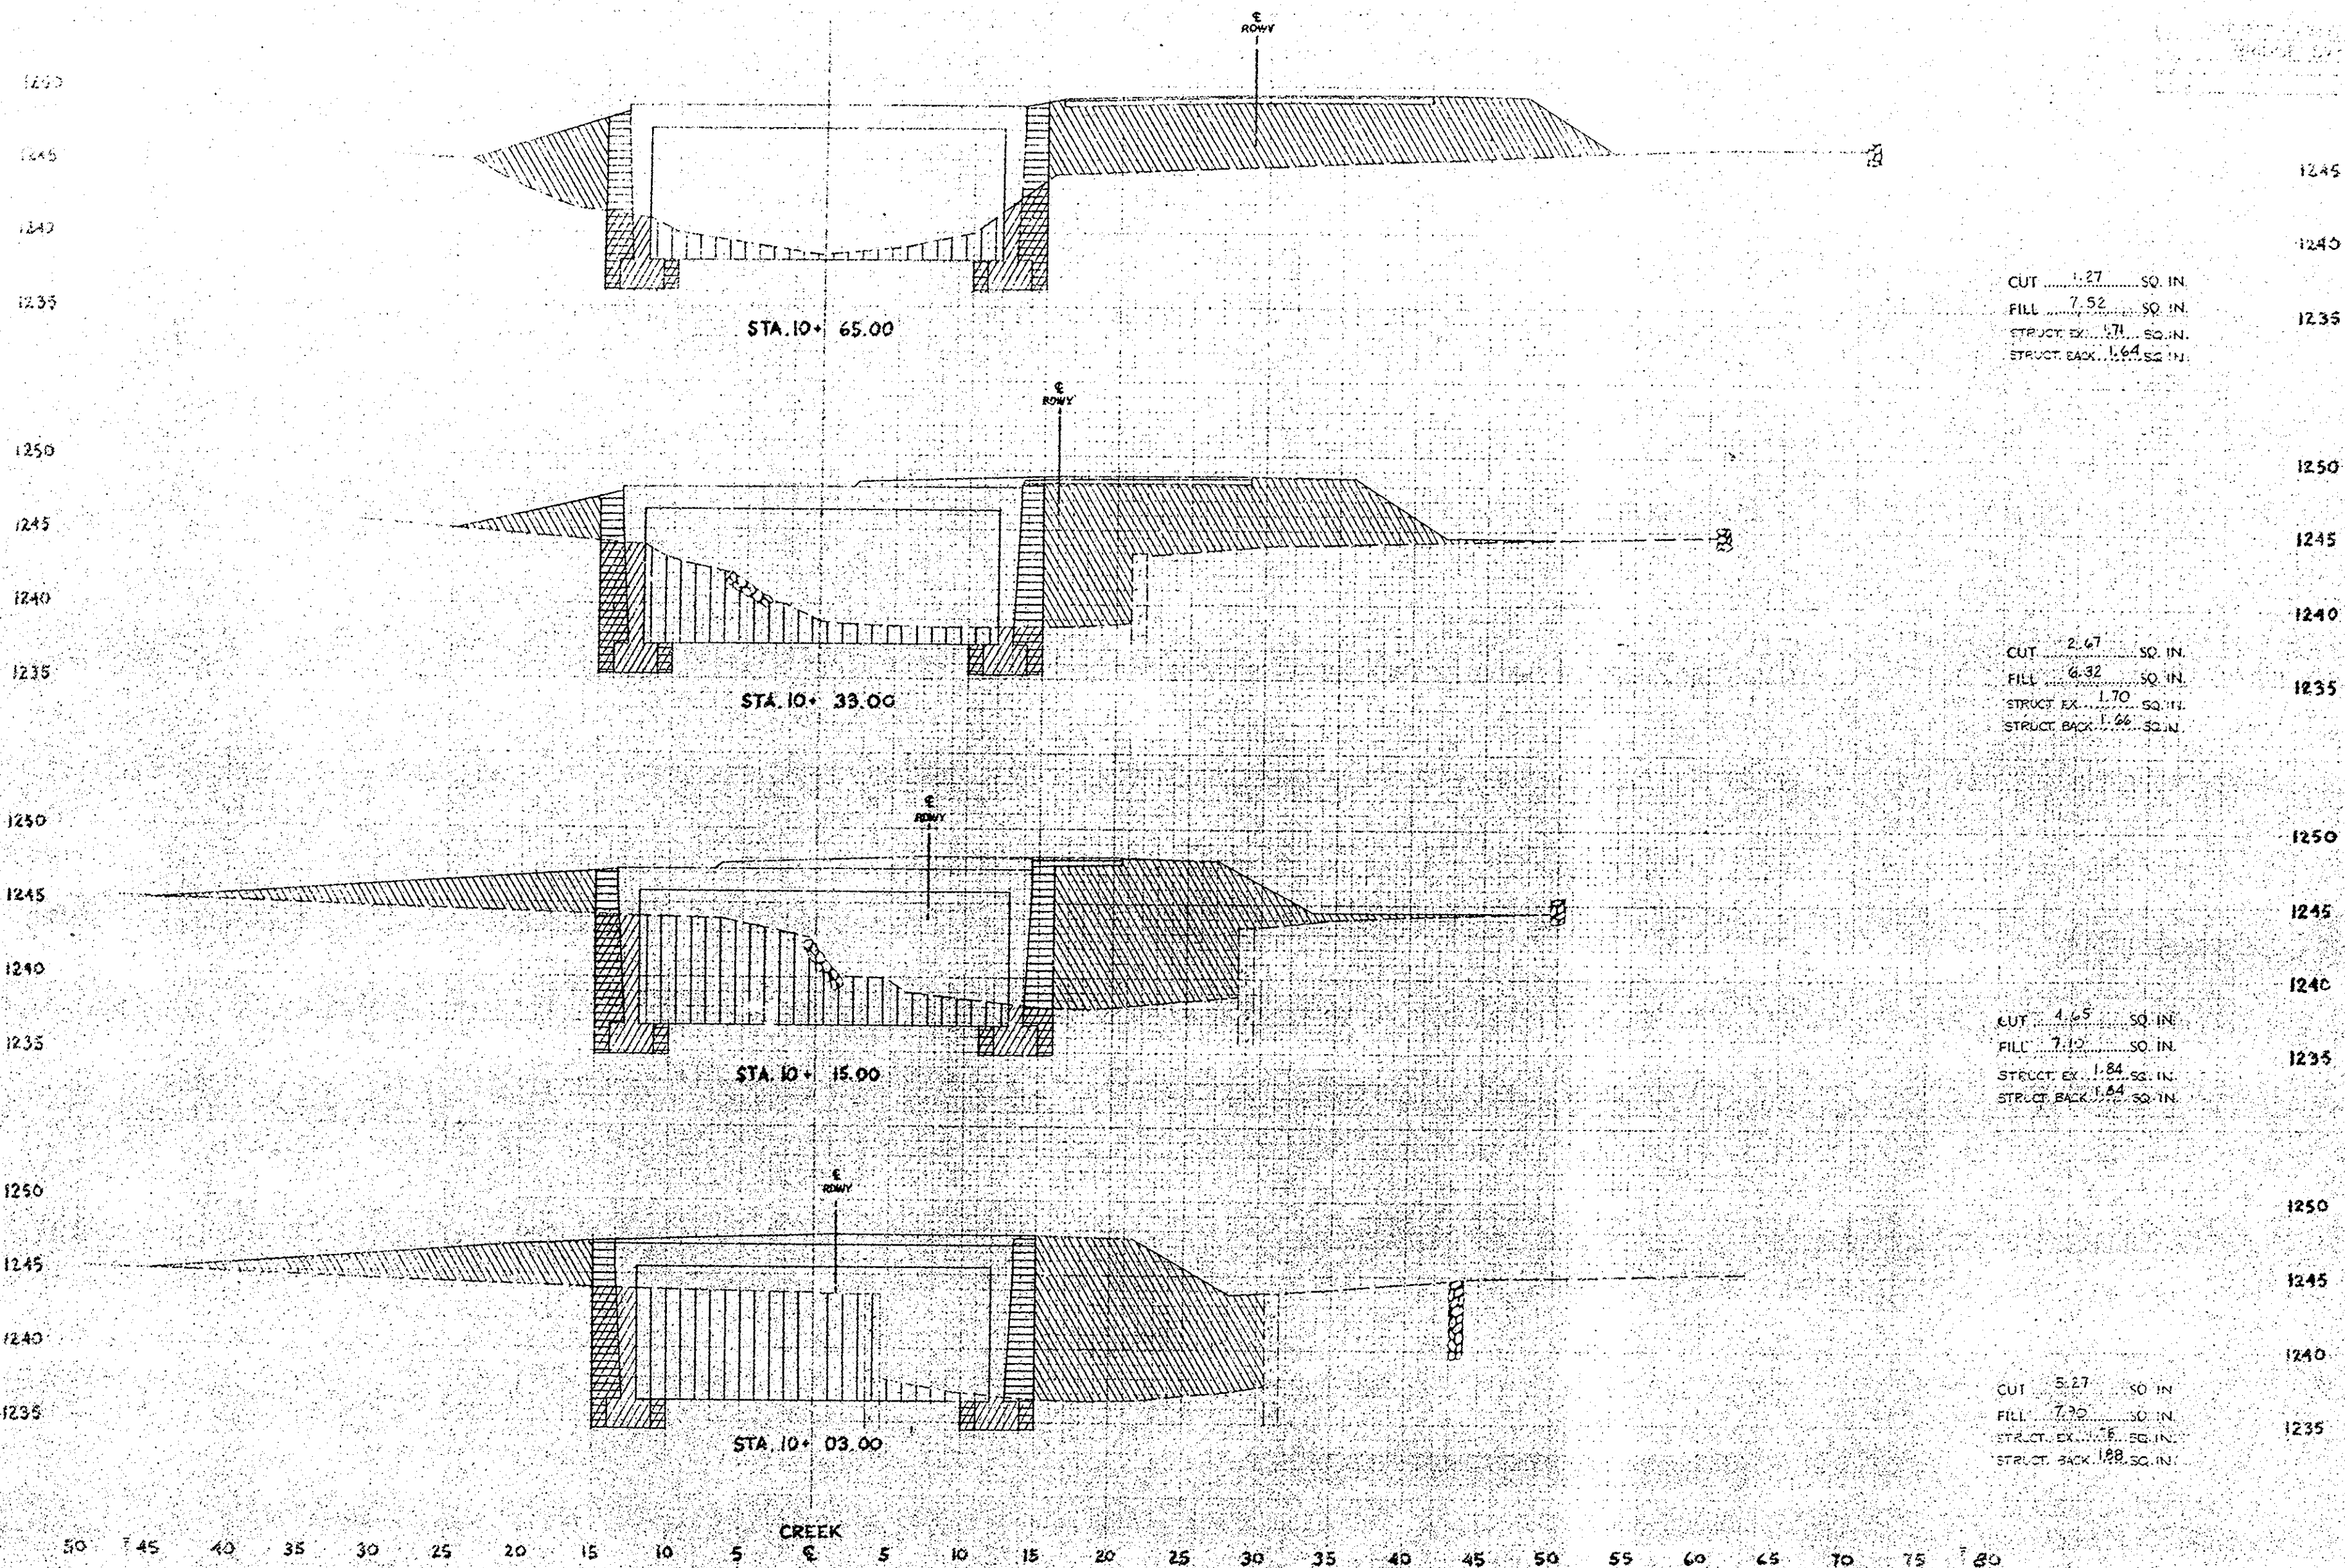

100 (10000)