

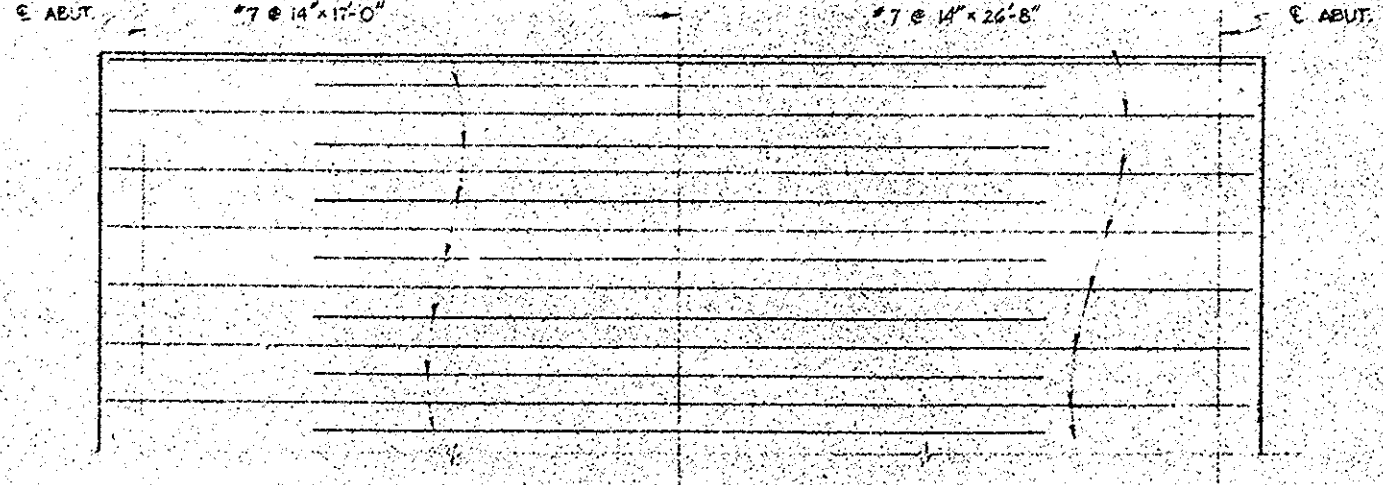
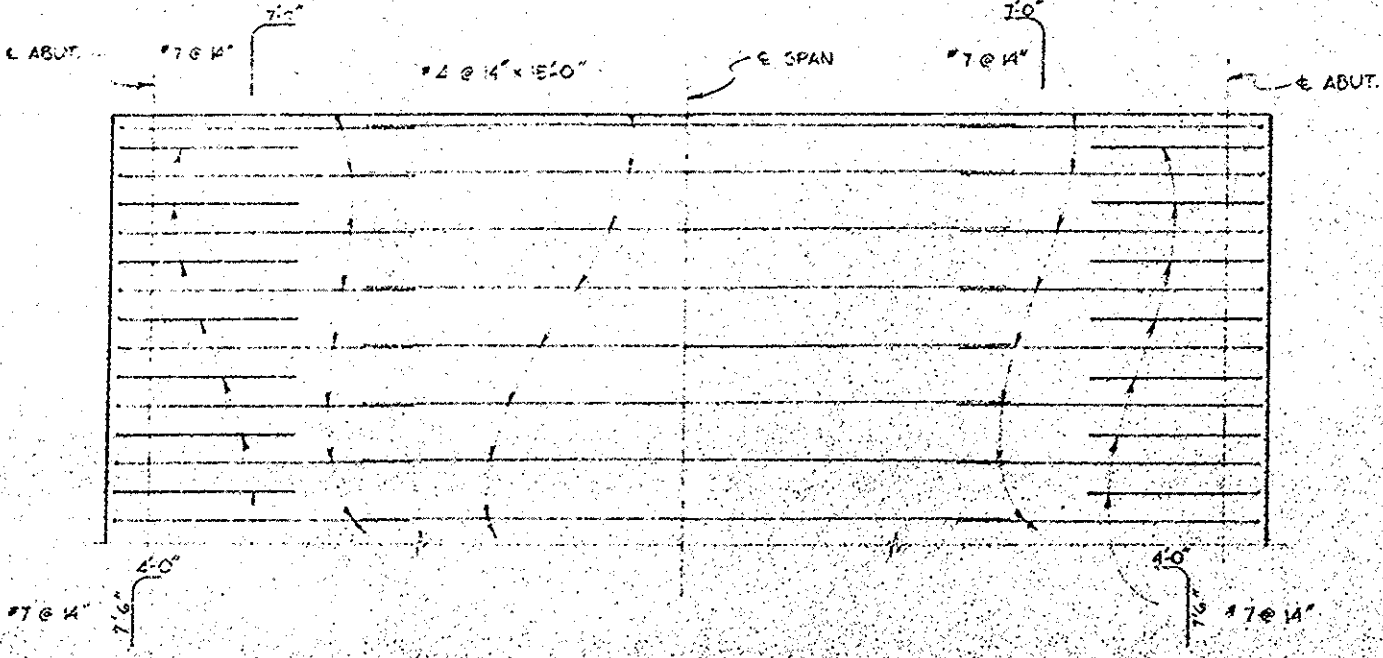


EXACT



STRAIGHT EDGE RULE SE-43

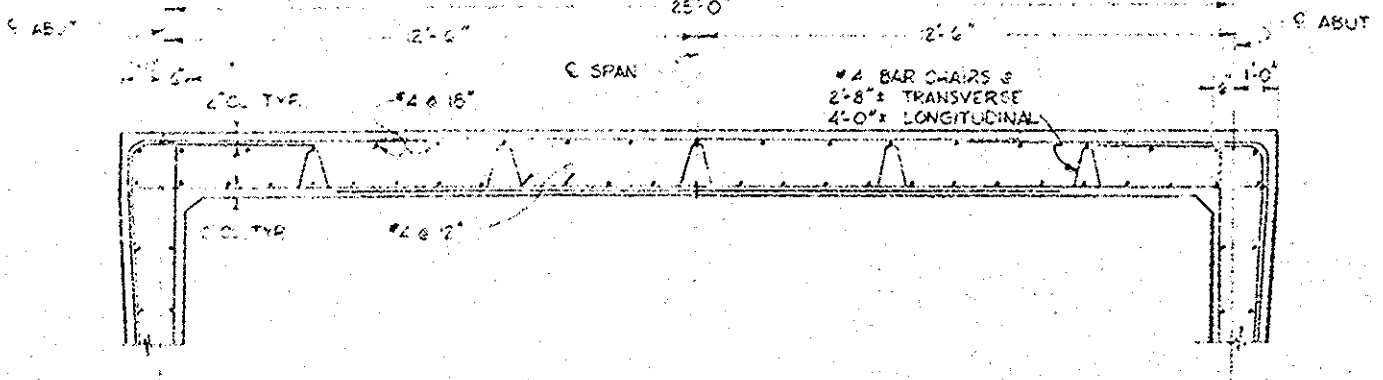





WEAKENED PLANE JOINT DETAIL
NO SCALE
LOCATE WEAKENED PLANE JOINT AT 24'-0"

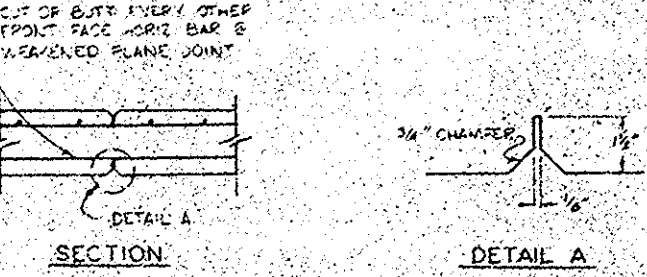

JOINT MAY BE FORMED W/ 1/8" HARDBOARD AND CUT BACK TO THE ROOT OF THE CHAMFER ON THE EXPOSED FACE.

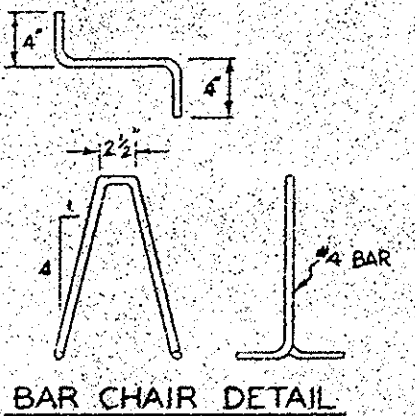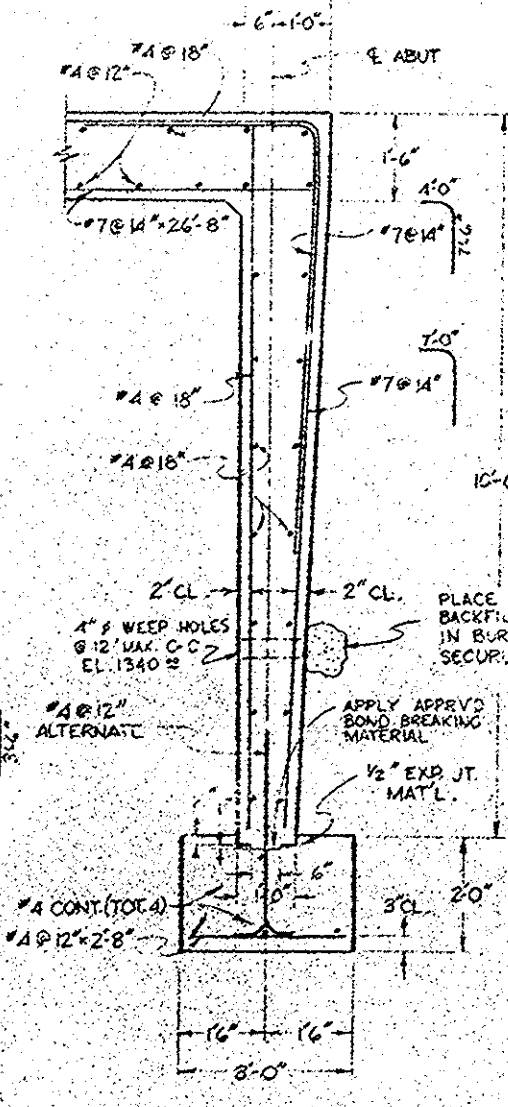

GUIDE MARKER
TYPE L-2
NO SCALE

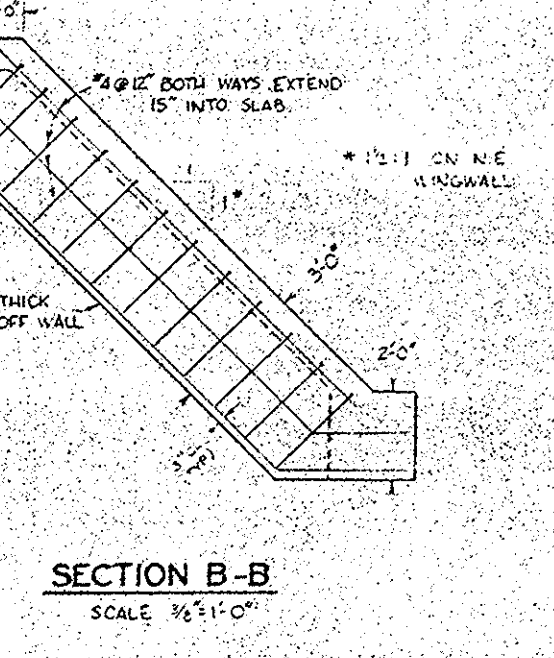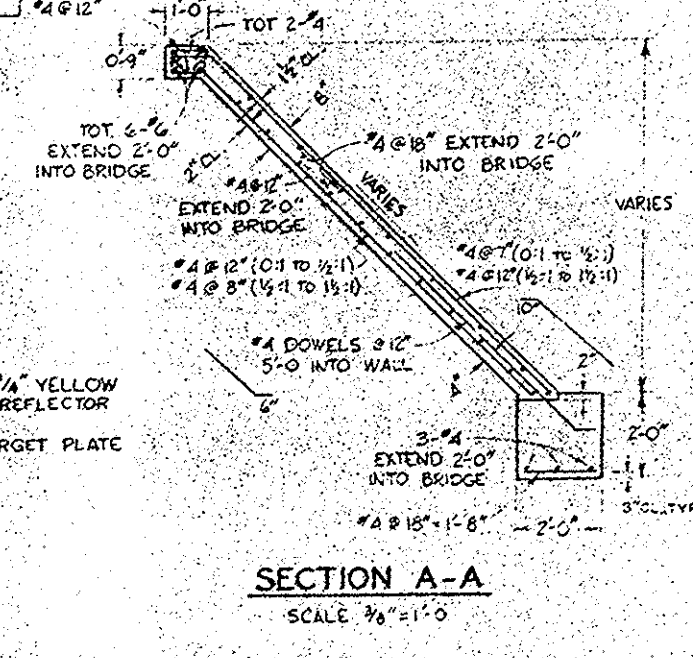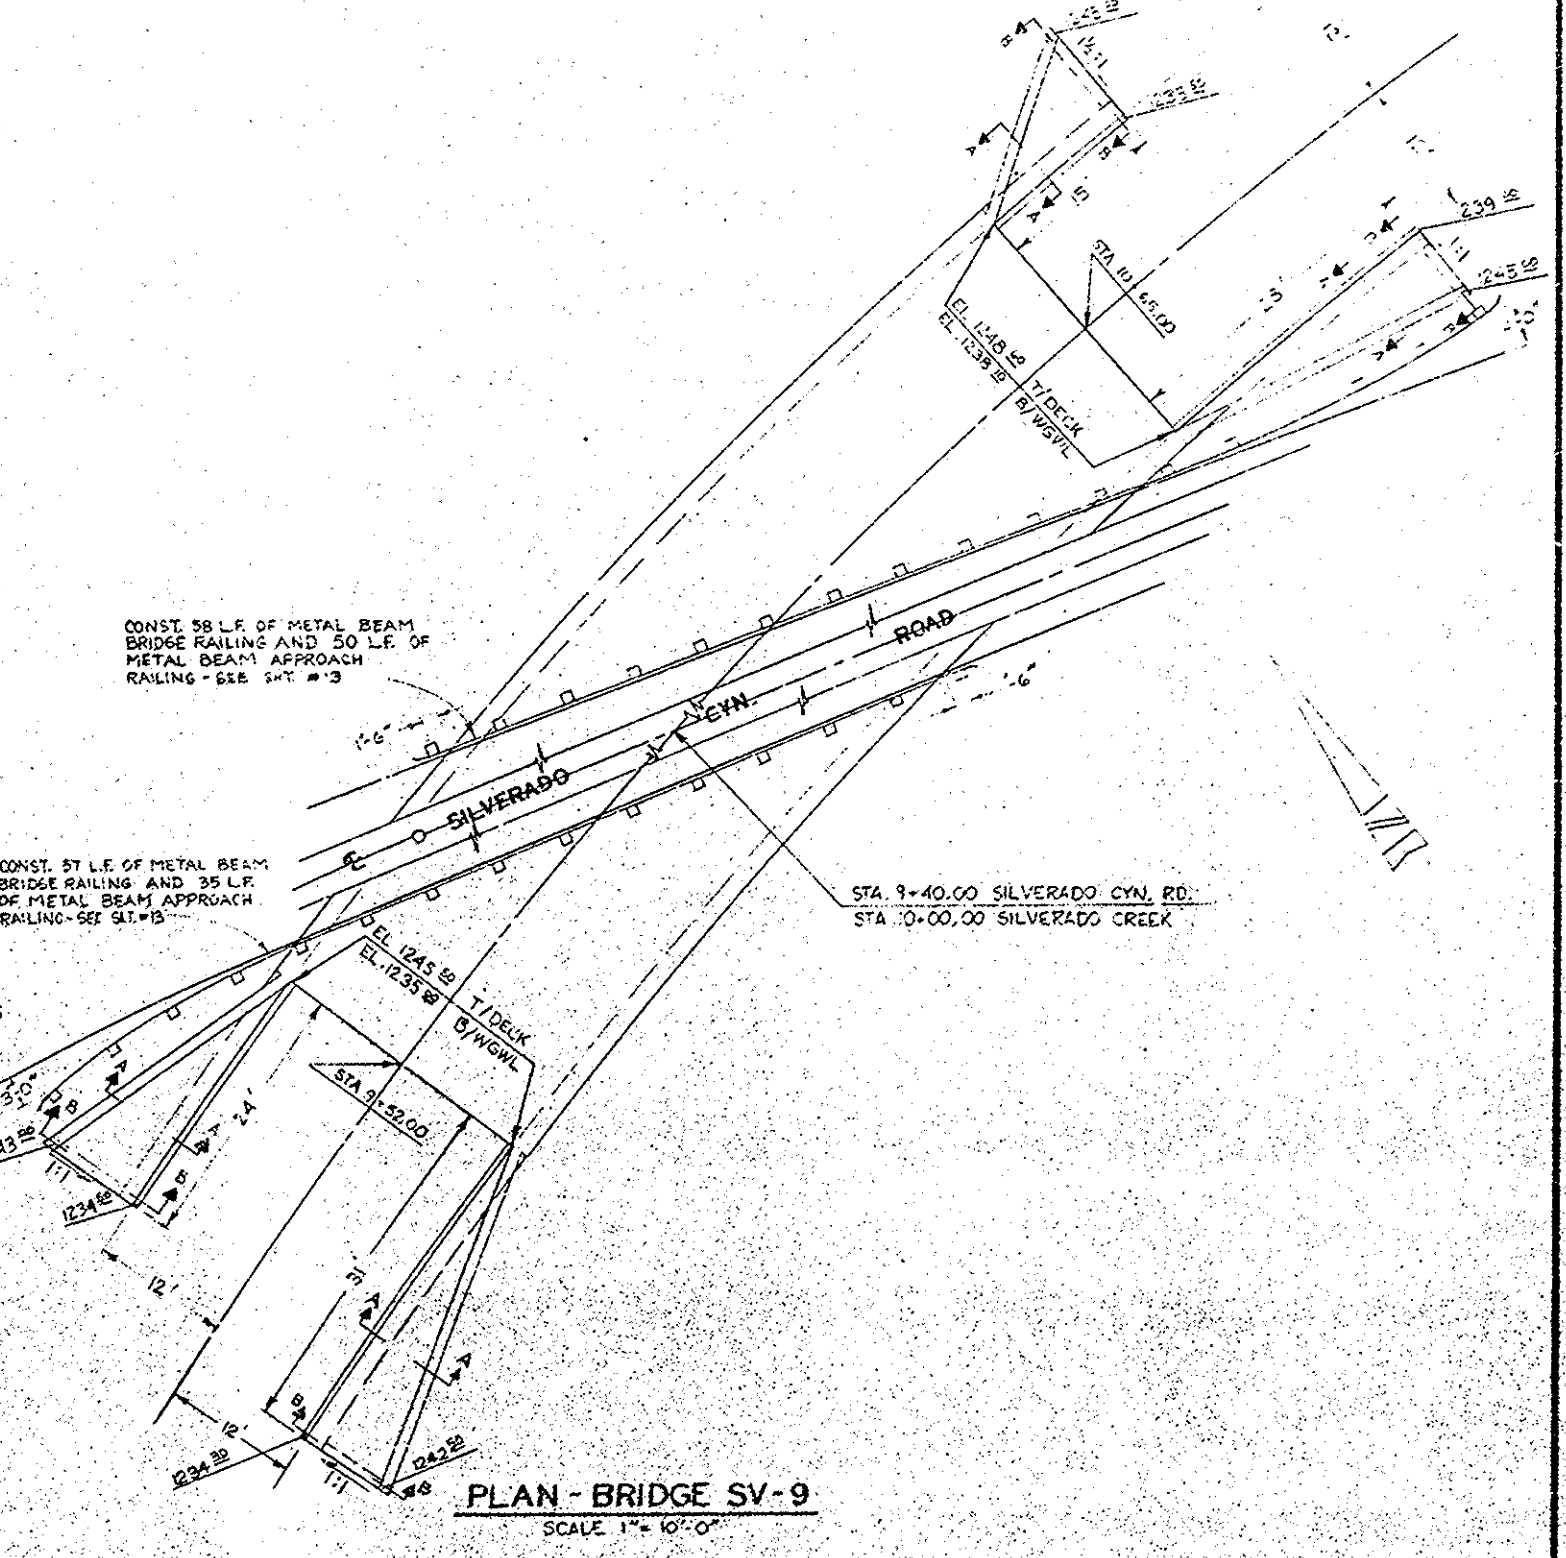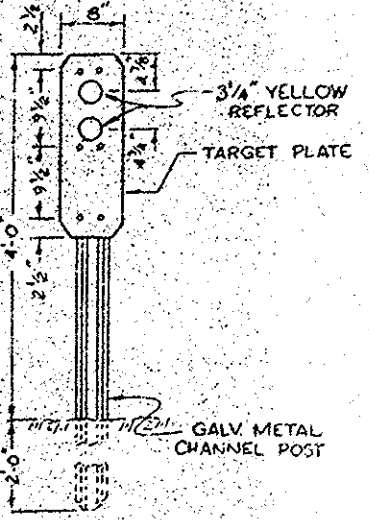

ORANGE COUNTY ROAD DEPARTMENT	
SILVERADO CYN. ROAD	
BRIDGE SV-9	
ACROSS SILVERADO CREEK	
DECK REINFORCEMENT AND WARPED WINGWALL DETAILS	
AS NOTED	SHEET 12 OF 25

DE 17(10677)