
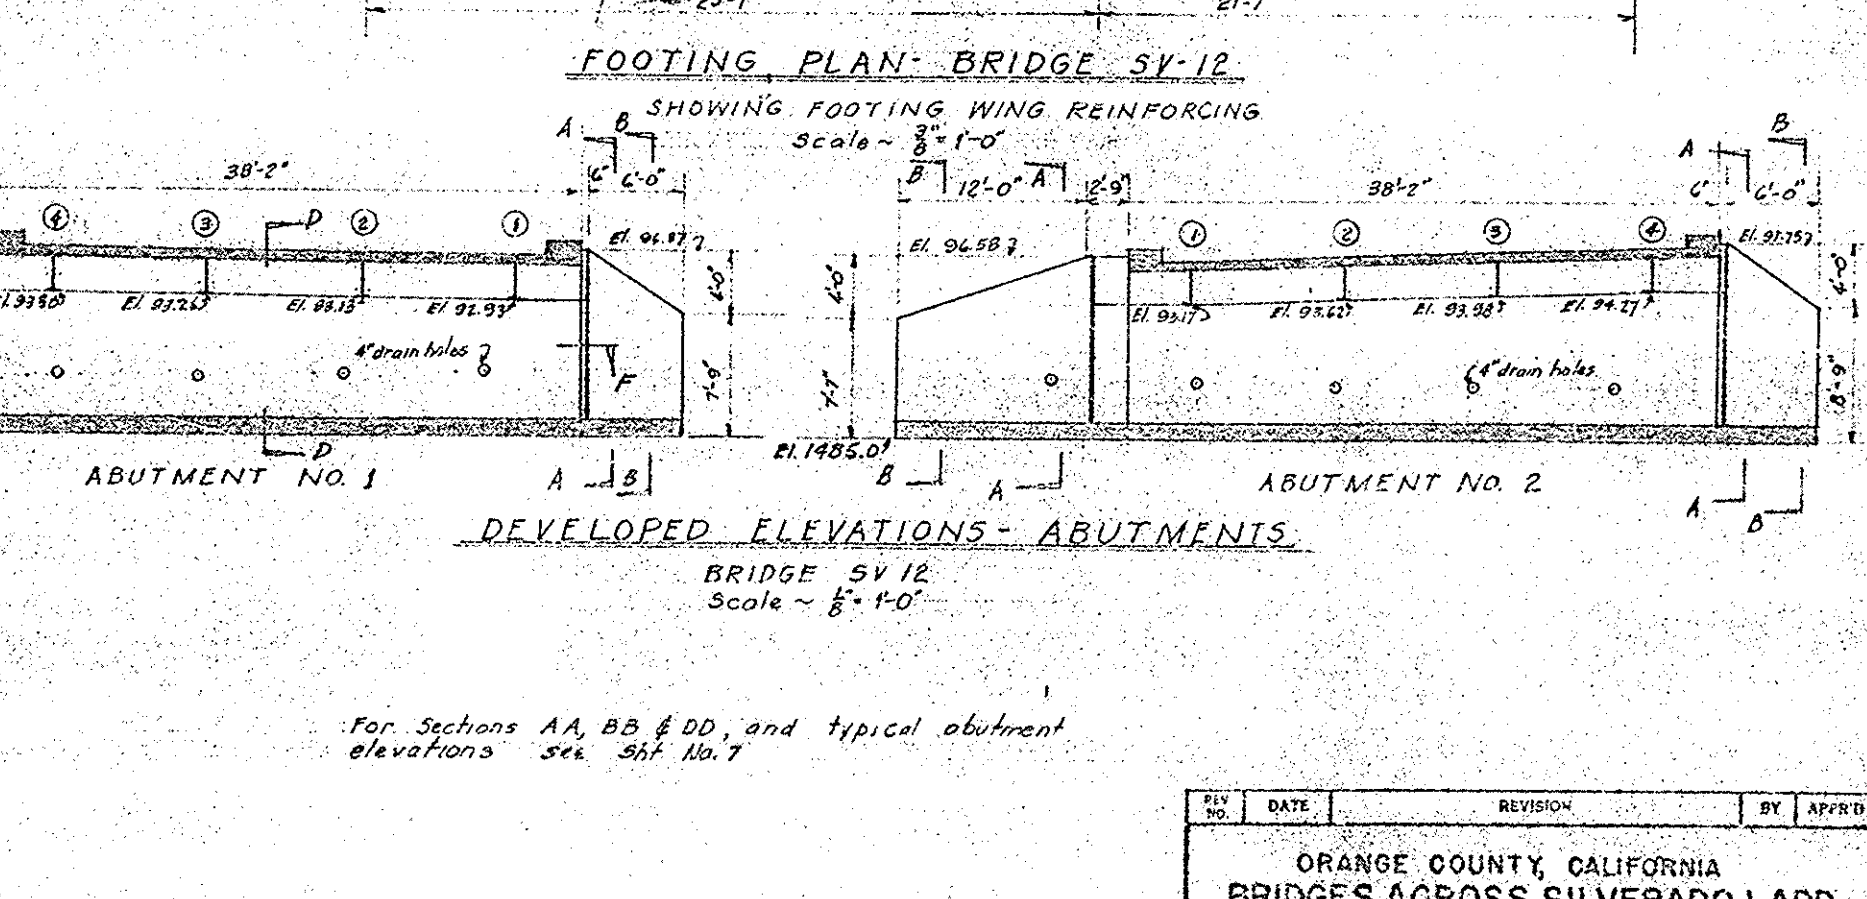
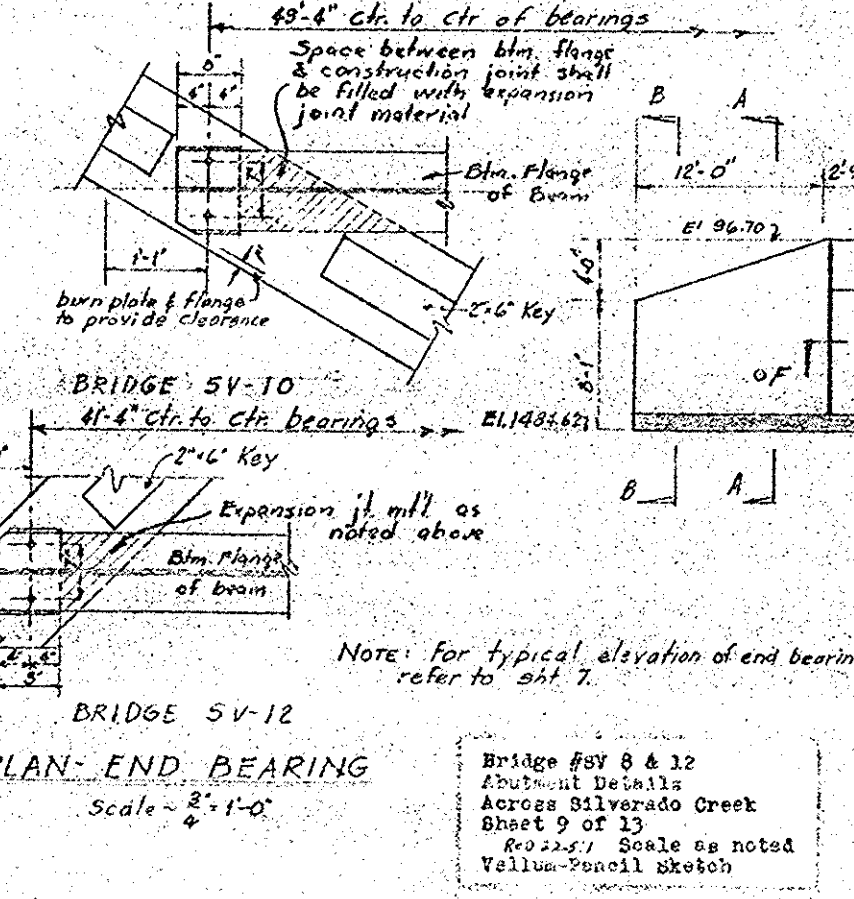
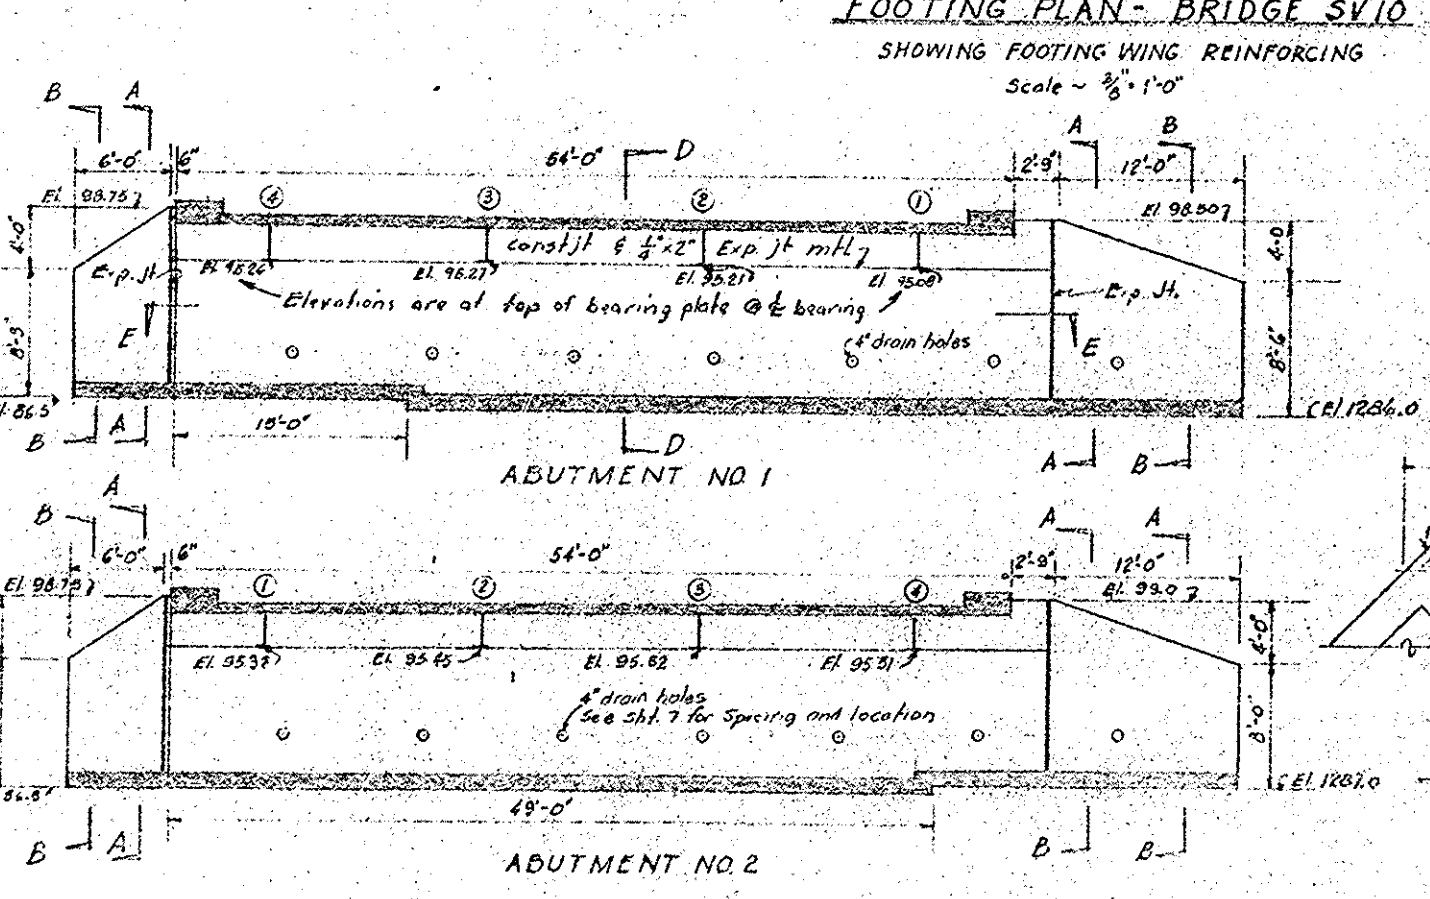
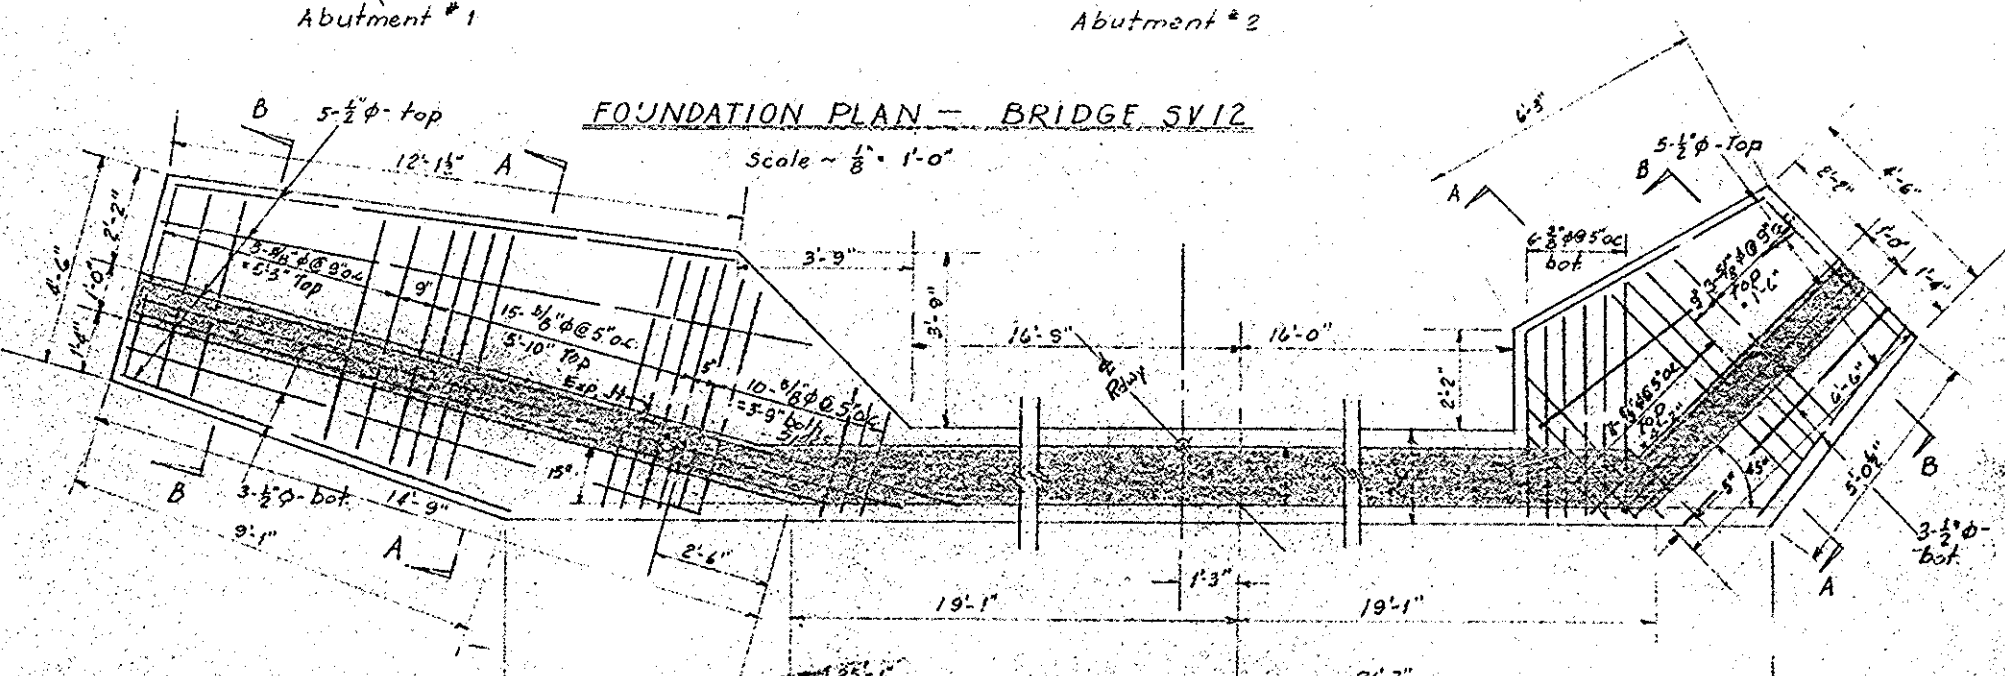
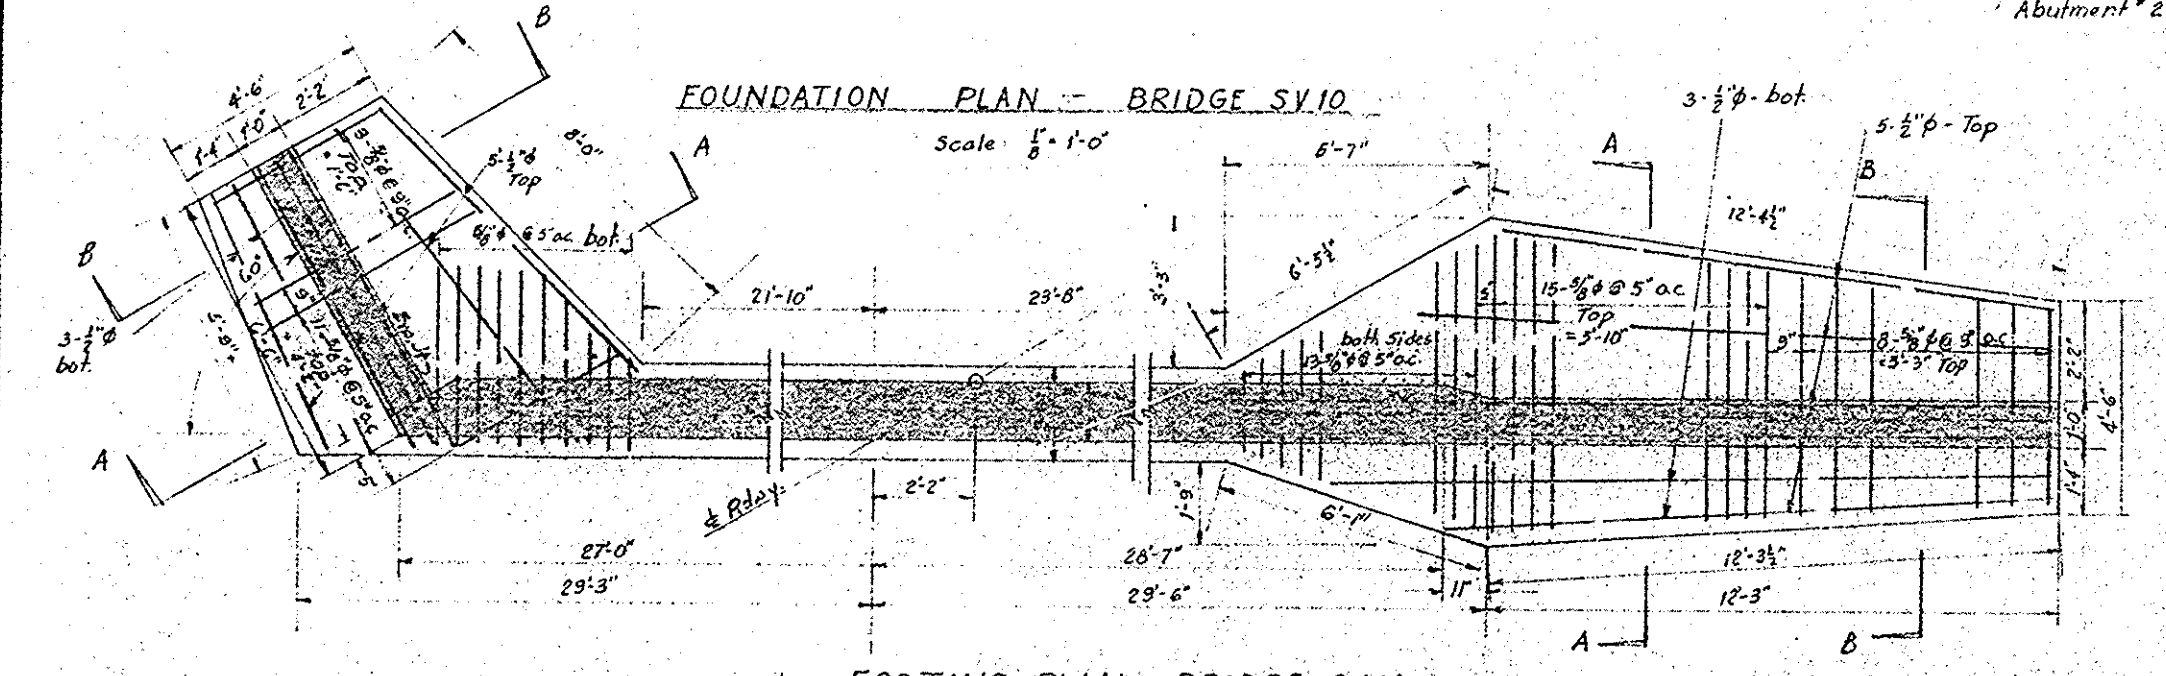


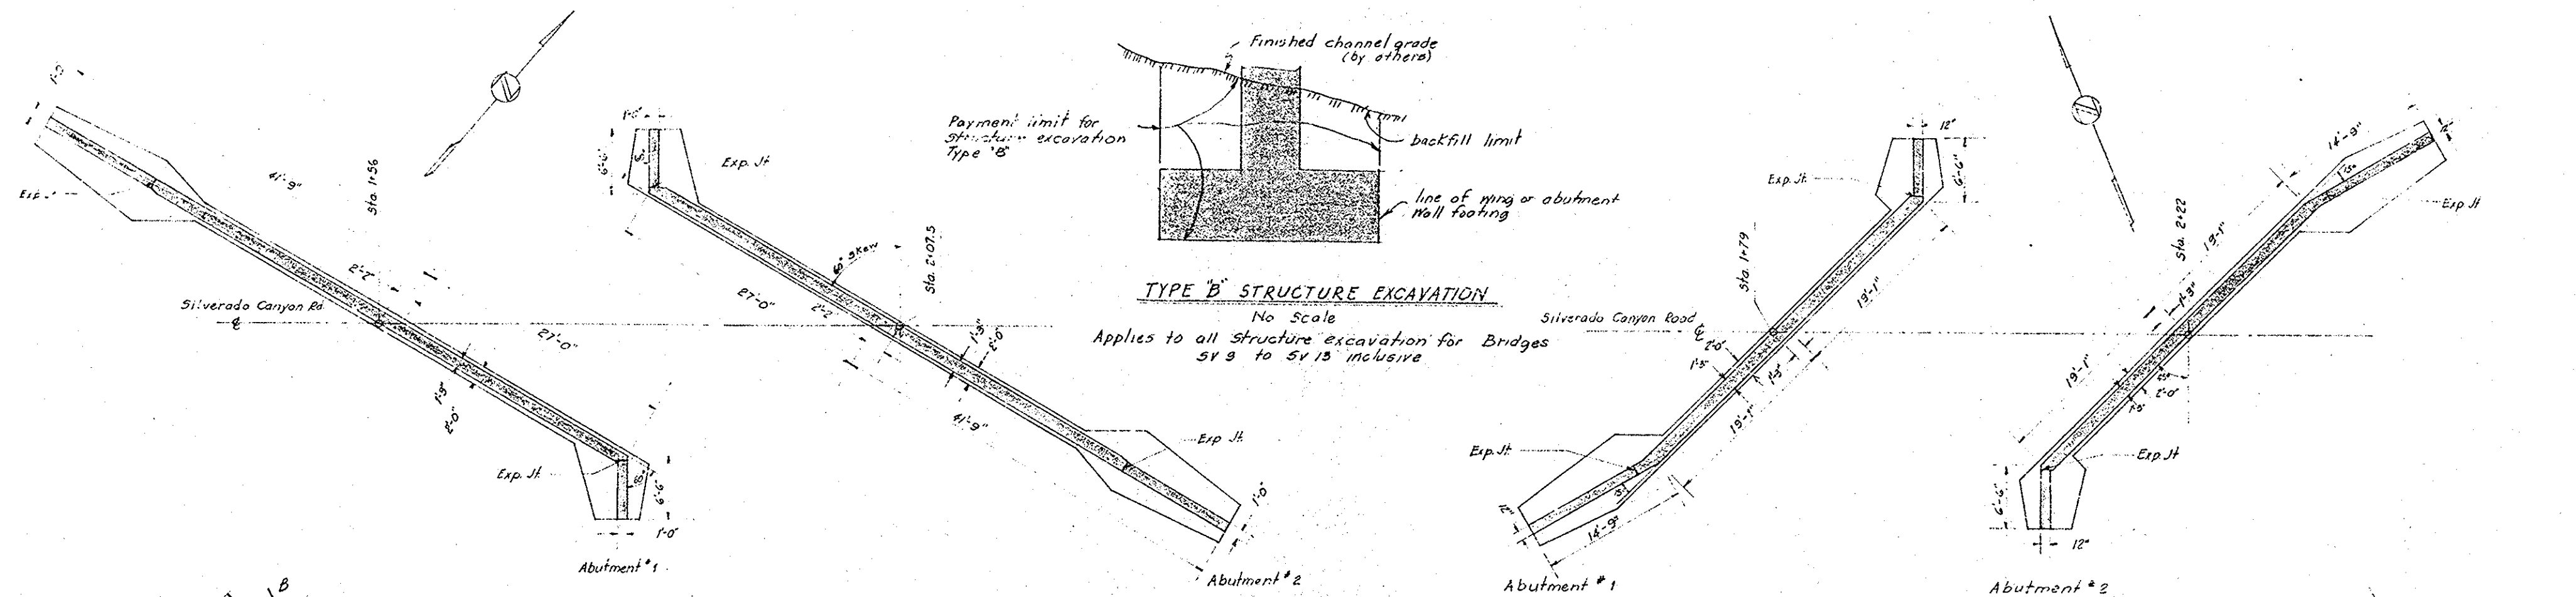

APPROVED *A.A. Beard*
A.A. BEARD
SUPERINTENDENT OF HIGHWAYS
DATE 8-8-46
H. Spreng

REV. NO.	DATE	REVISION	BY	APPROV.
ORANGE COUNTY, CALIFORNIA BRIDGES ACROSS SILVERADO, LADD, & SANTIAGO CREEKS				
ABUTMENT DETAILS SILVERADO CREEK (SV10)&(SV12)				
AS NOTED REV. 1		DONALD R. WARREN CO. ENGINEERS		LA 46-17 JES-10
DESIGNED BY E.L.S.	LOS ANGELES	SAN FRANCISCO		8 DICKENS AND
DRAWN BY E.S.	DONALD R. WARREN			
CHECKED BY P.R.	DATE 7/1/64			