



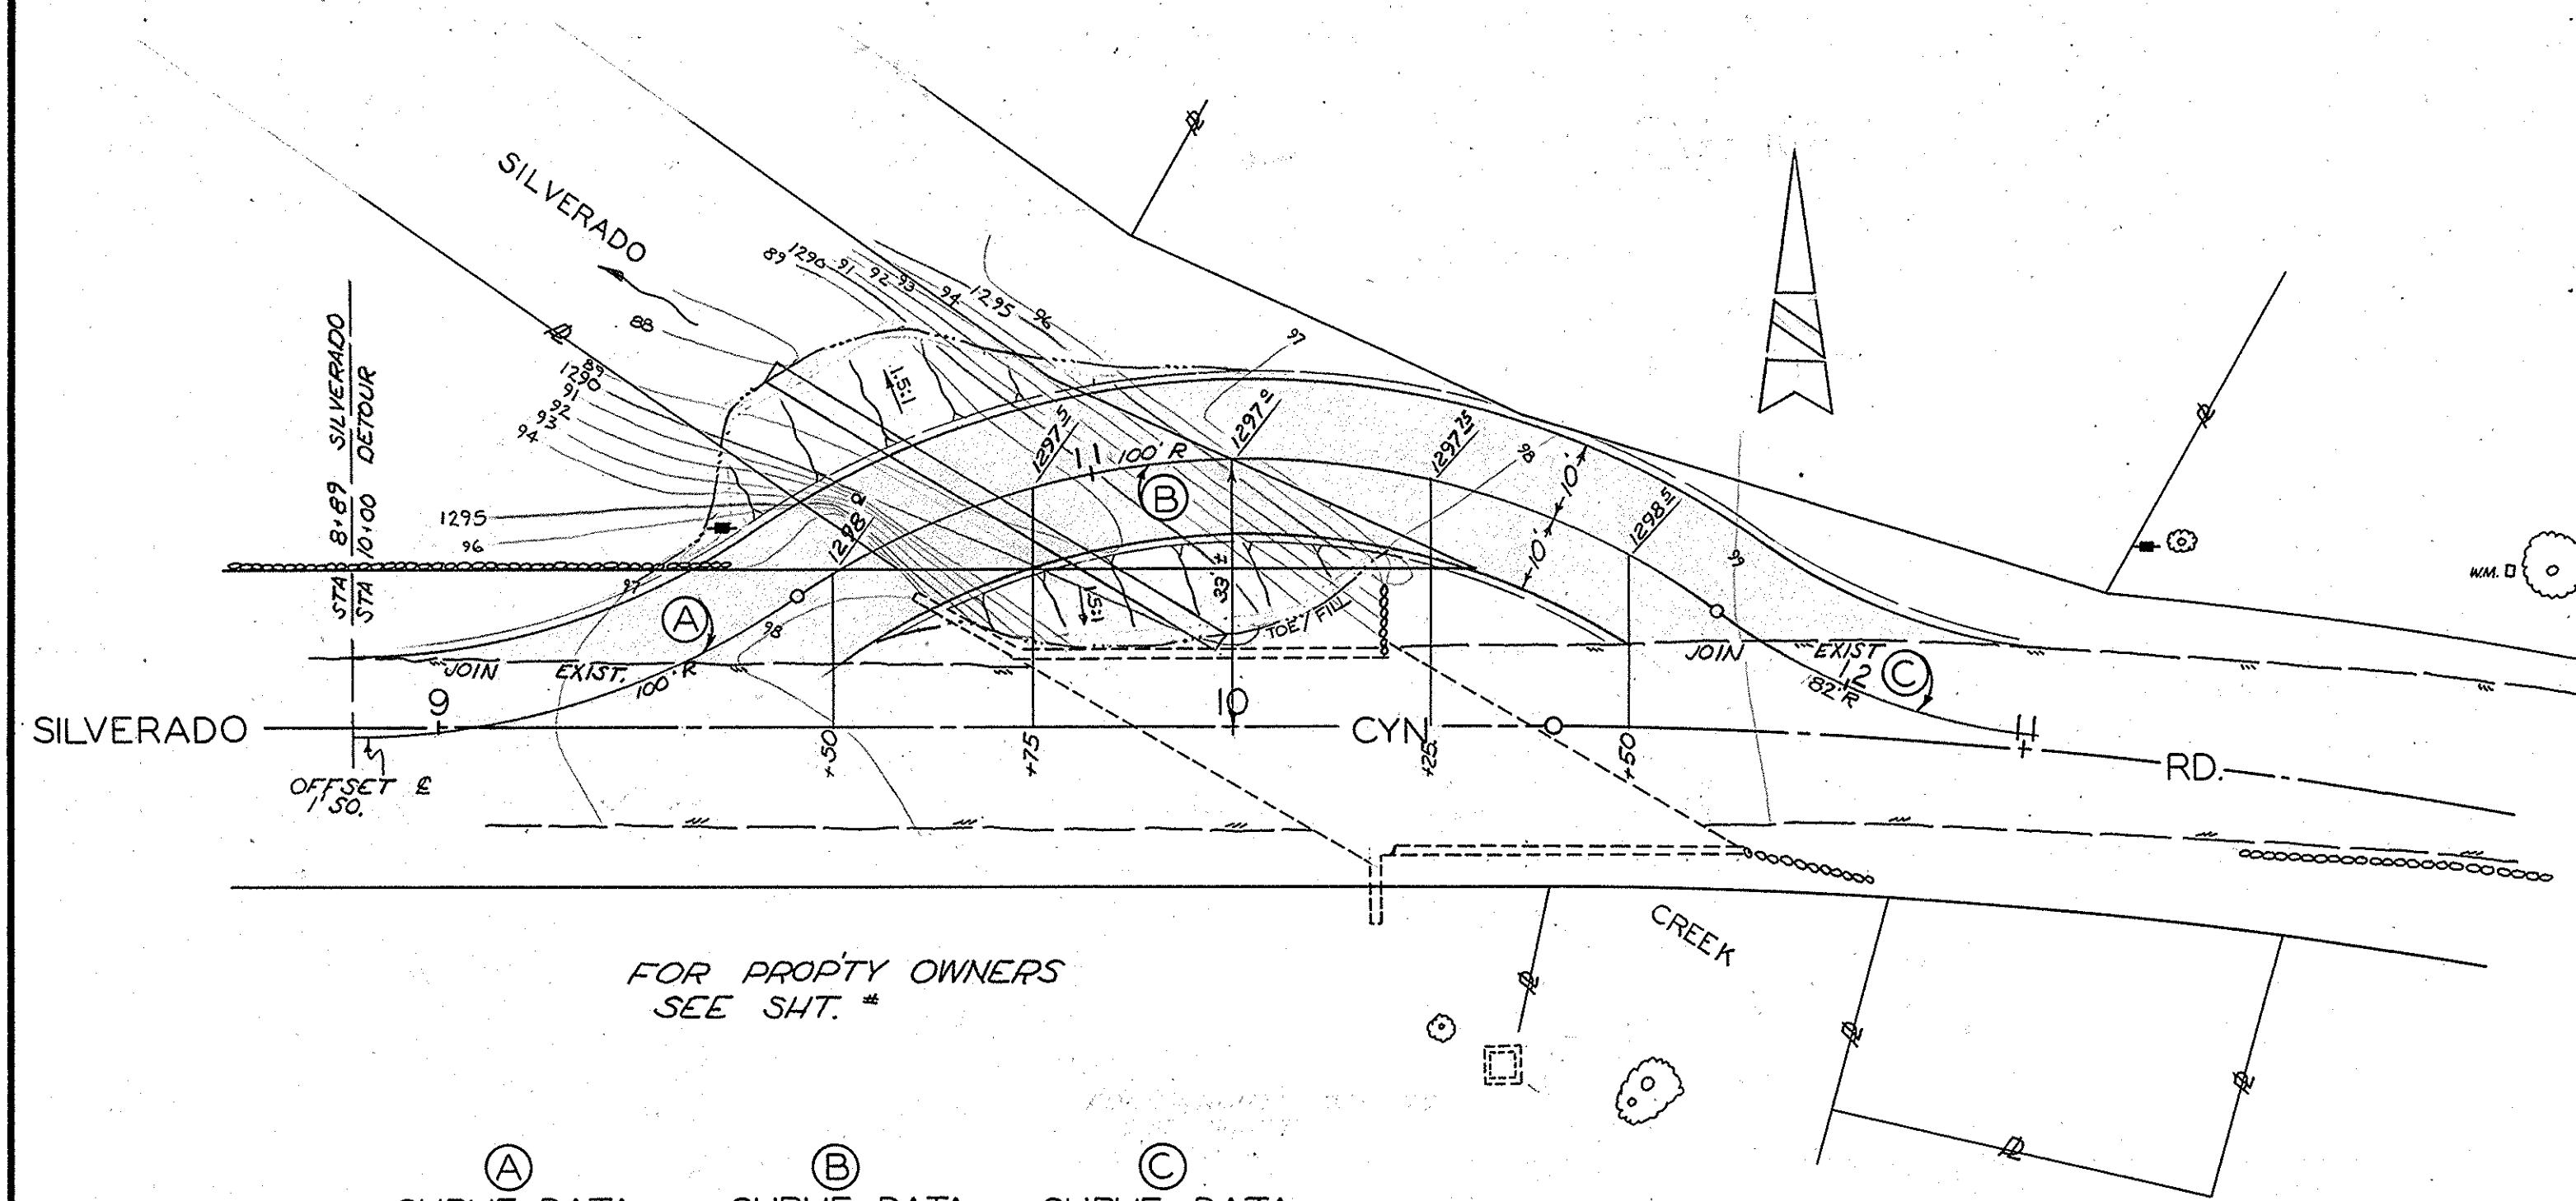


| CURVE DATA | CURVE DATA  | CURVE DATA |
|------------|-------------|------------|
| R = 100'   | R = 100'    | R = 82'    |
| Δ = 34°    | Δ = 70°     | Δ = 30°    |
| L = 59.31' | L = 122.17' | L = 41.87' |
| T = 30.57' | T = 70.02'  | T = 21.97' |

### PLAN SV-10 DETOUR


SCALE 1" = 20'

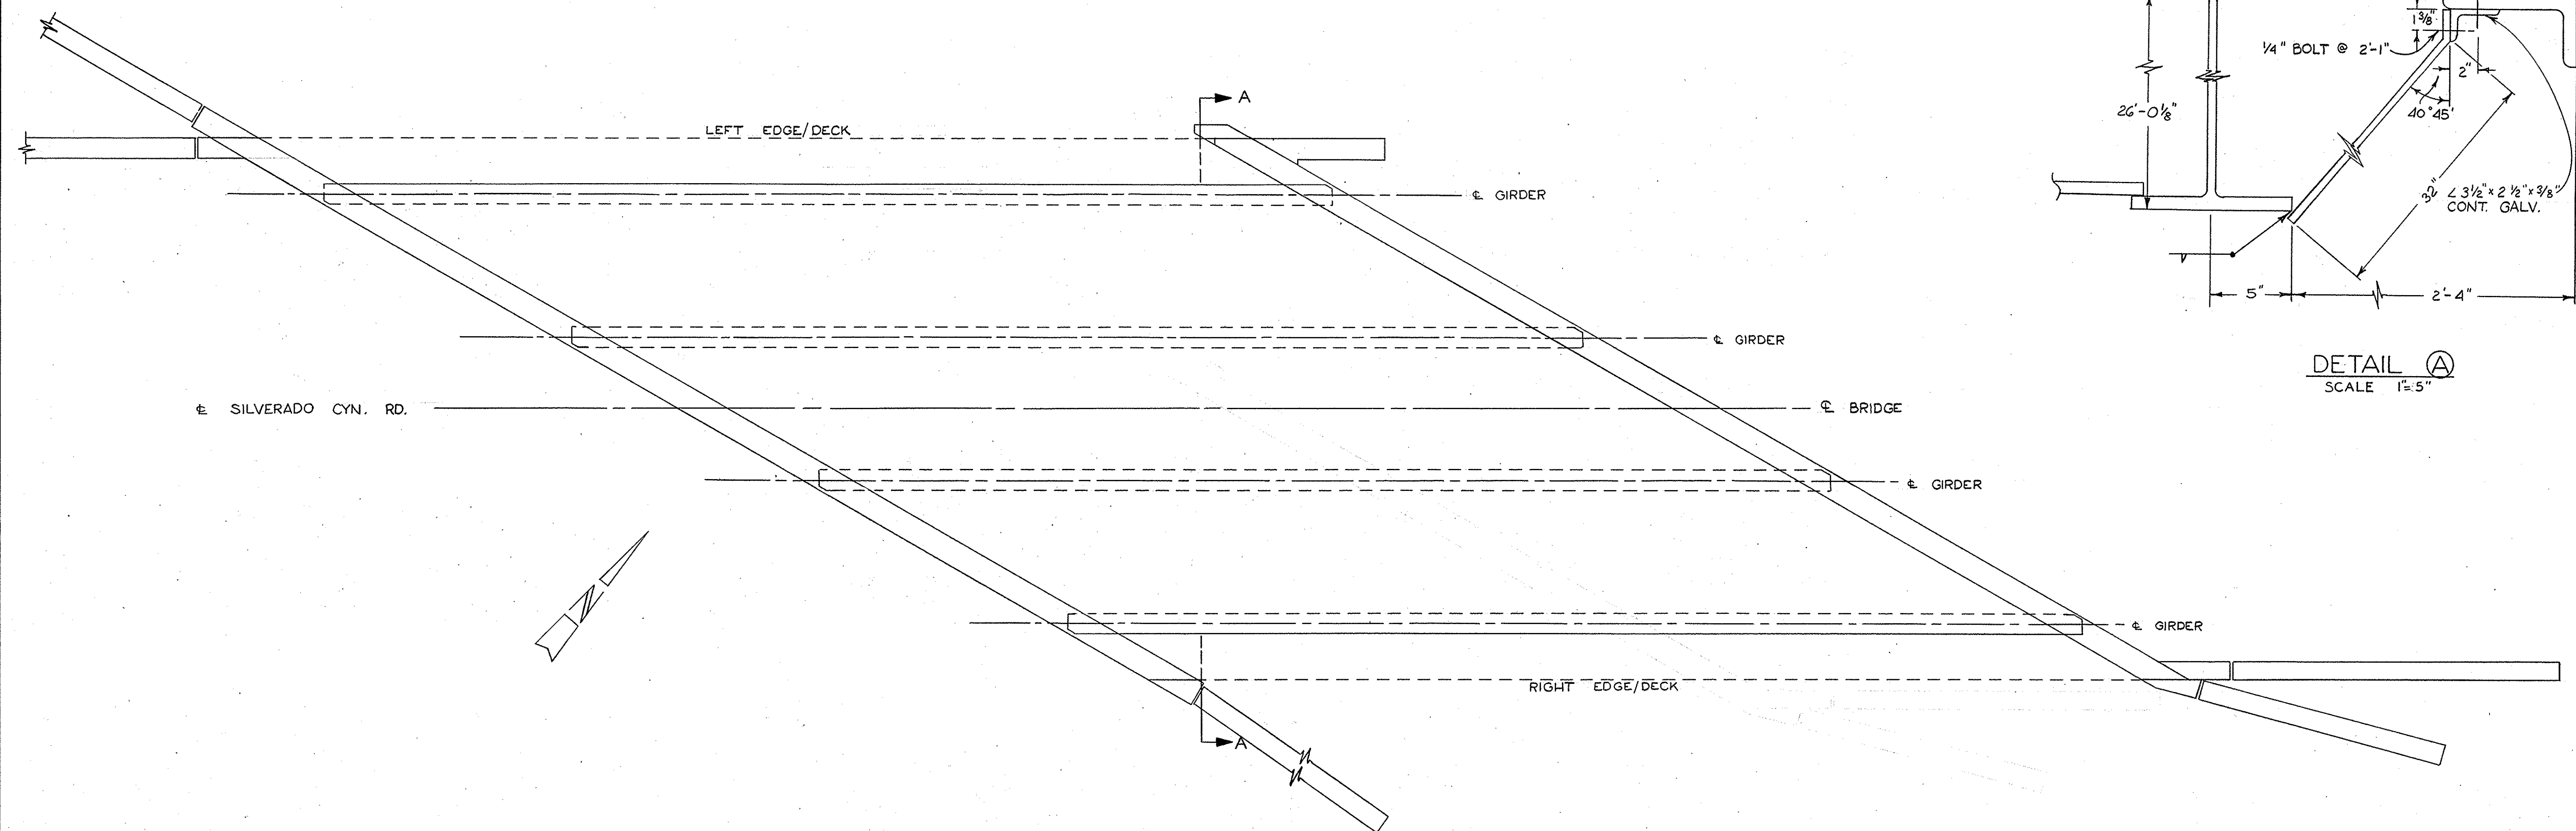

EXISTING W GIRDER SOFFIT INCLOSURE LAYOUT PLAN  
SCALE 1/4" = 1'-0"

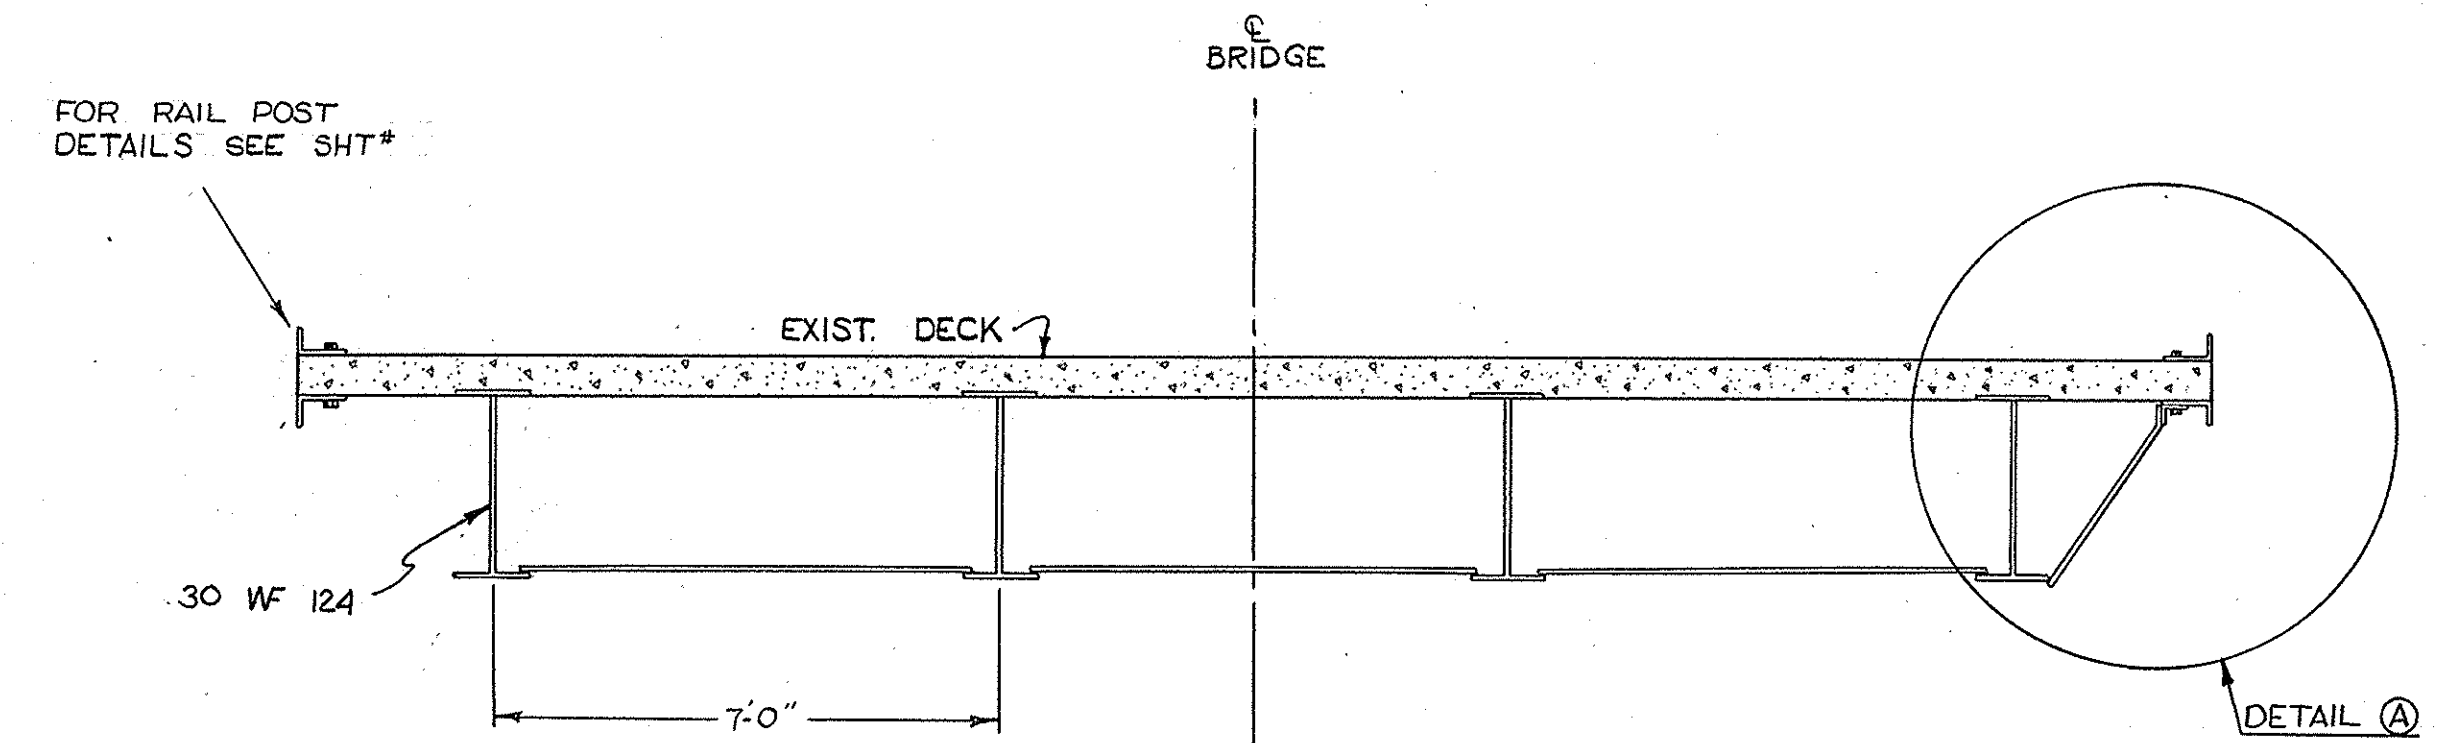

SECTION A-A  
SCALE 3/8" = 1'-0"

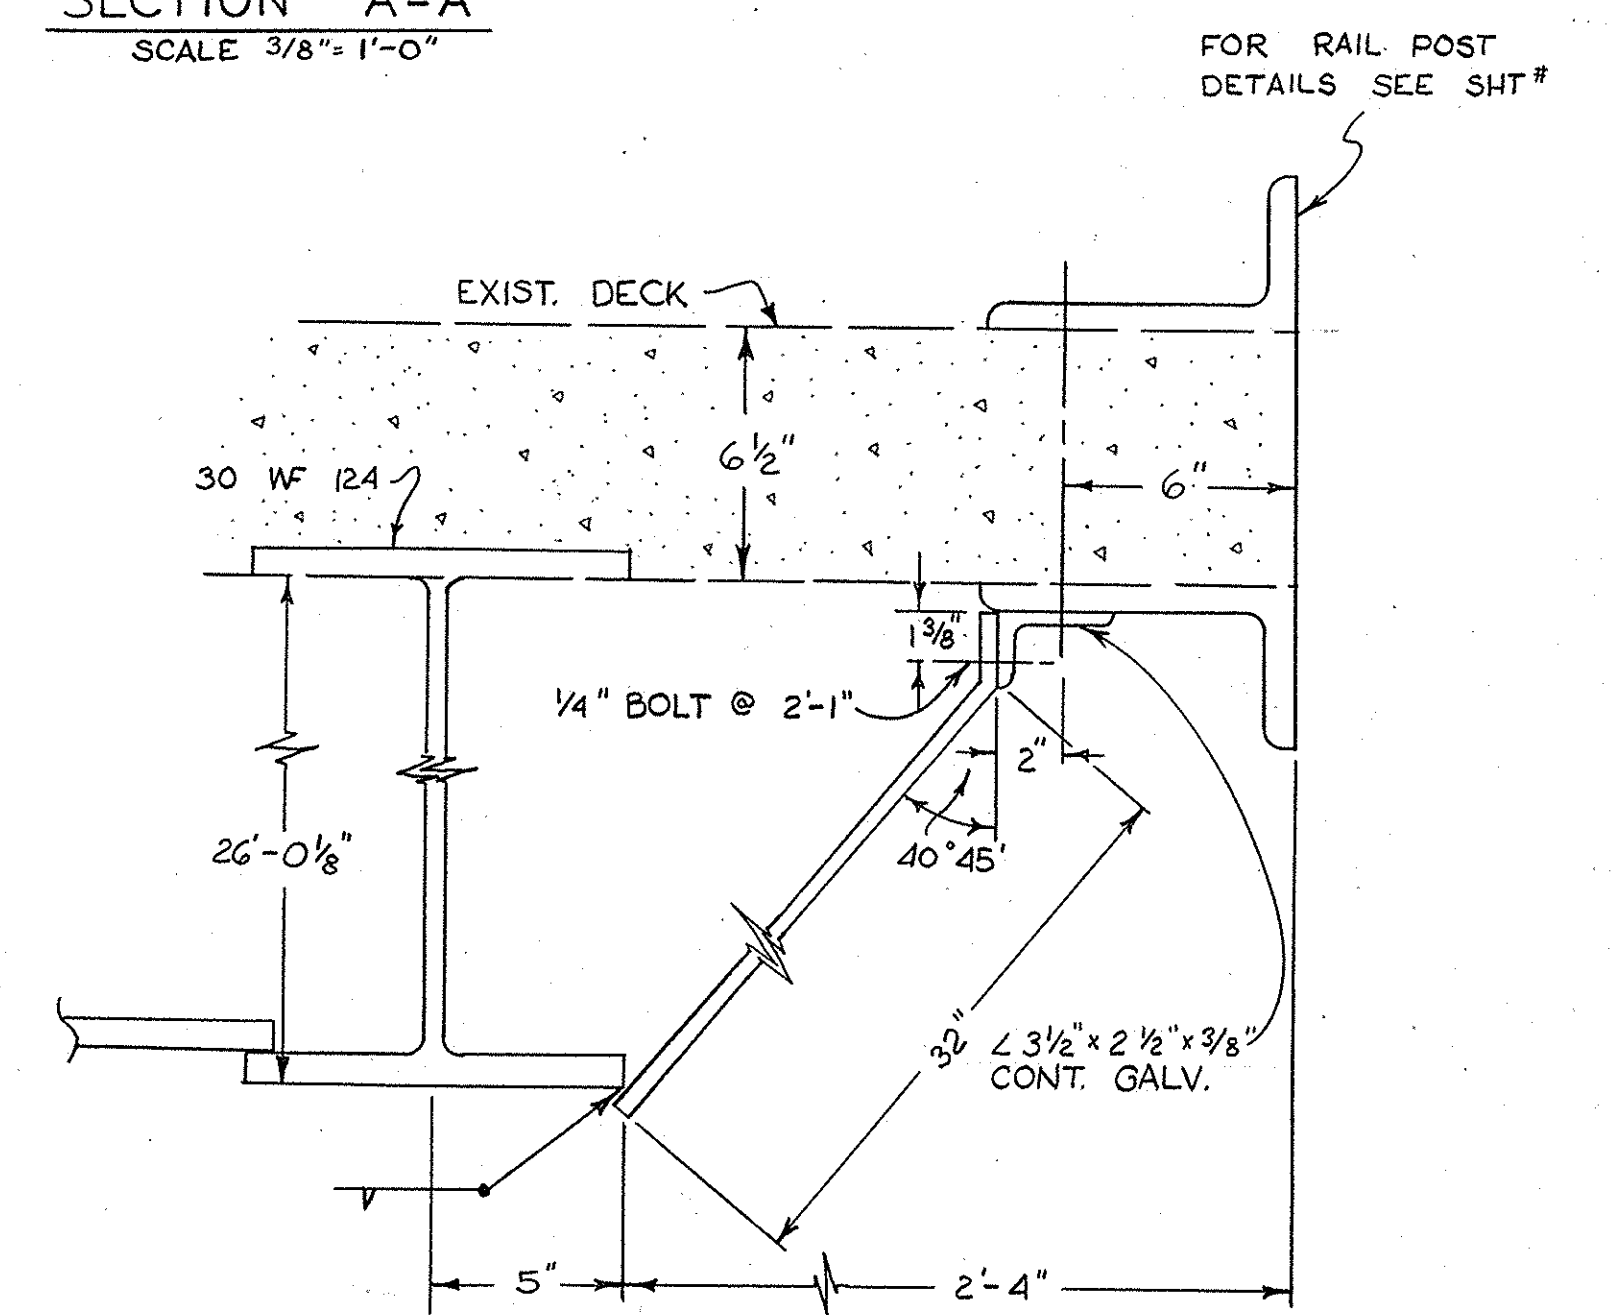

DETAIL A  
SCALE 1" = 5"