

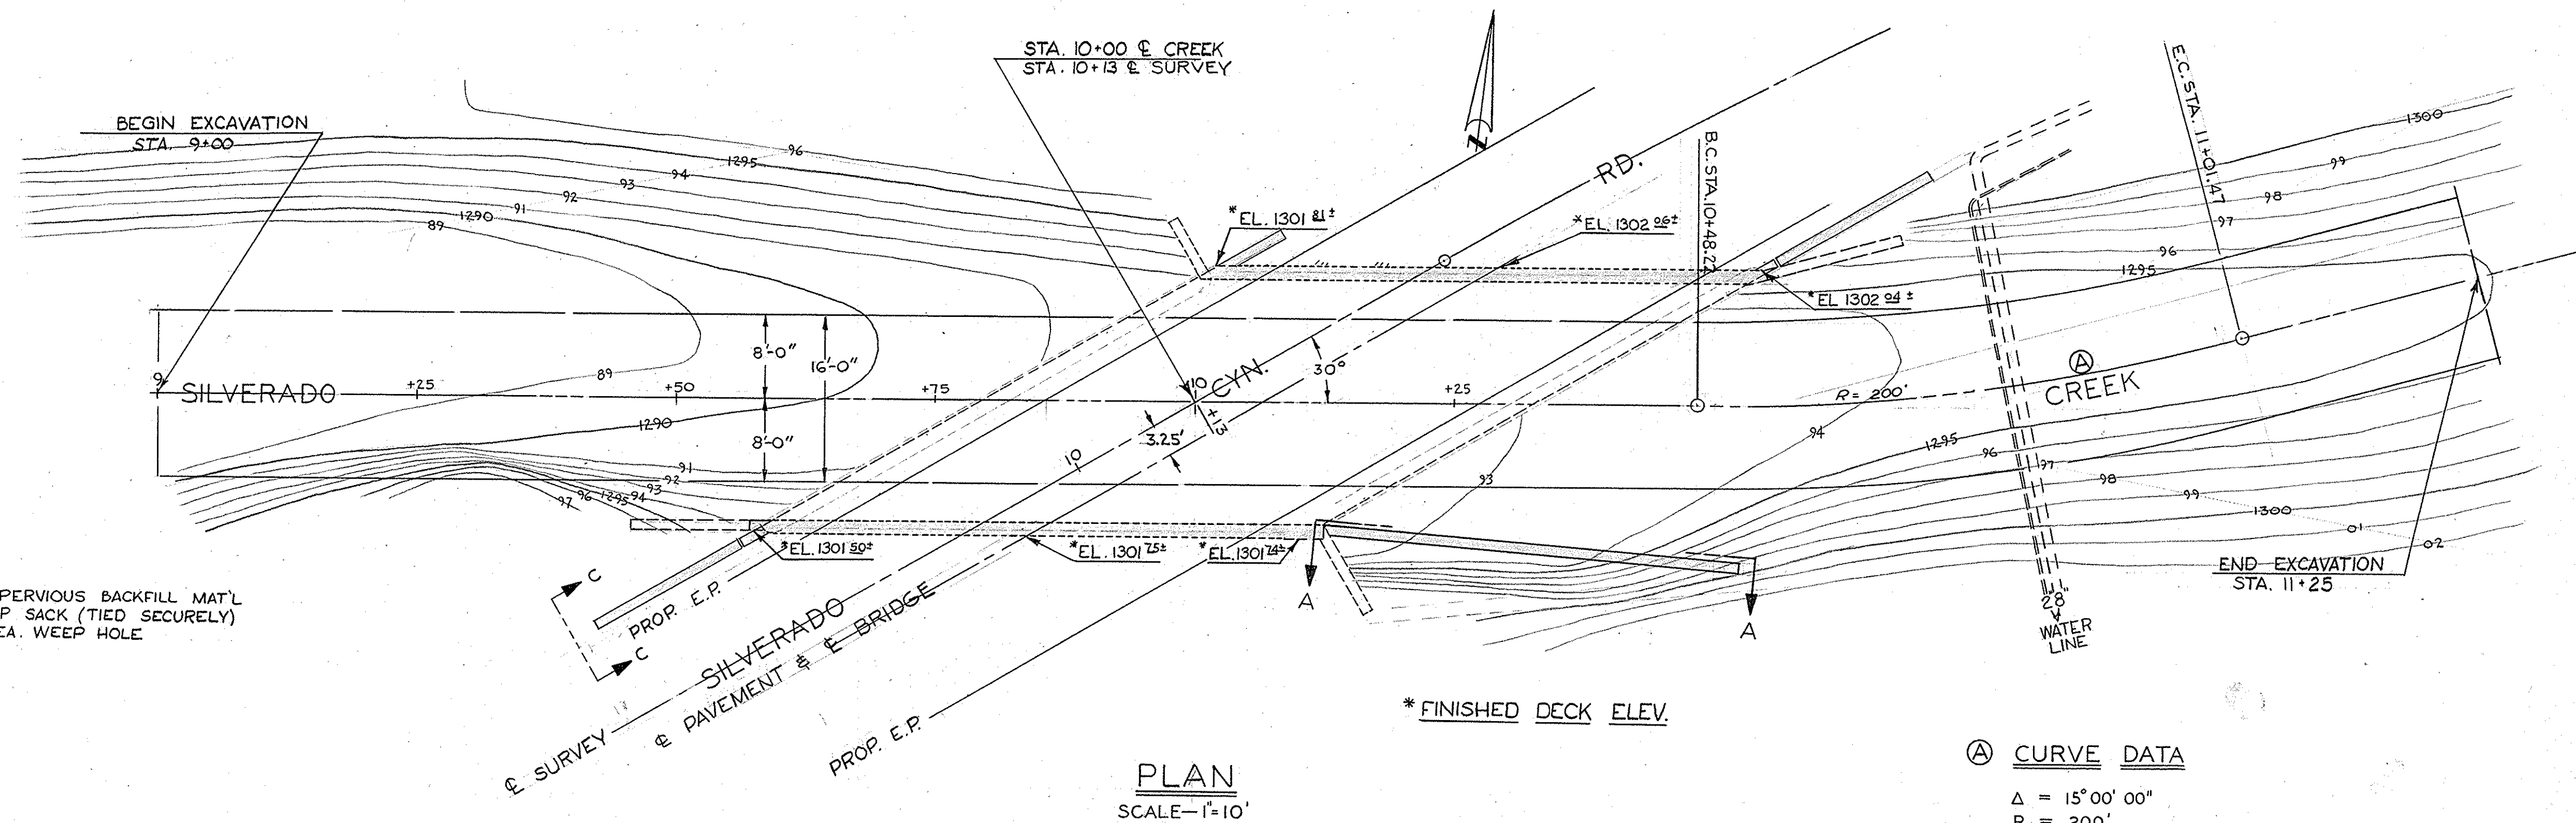
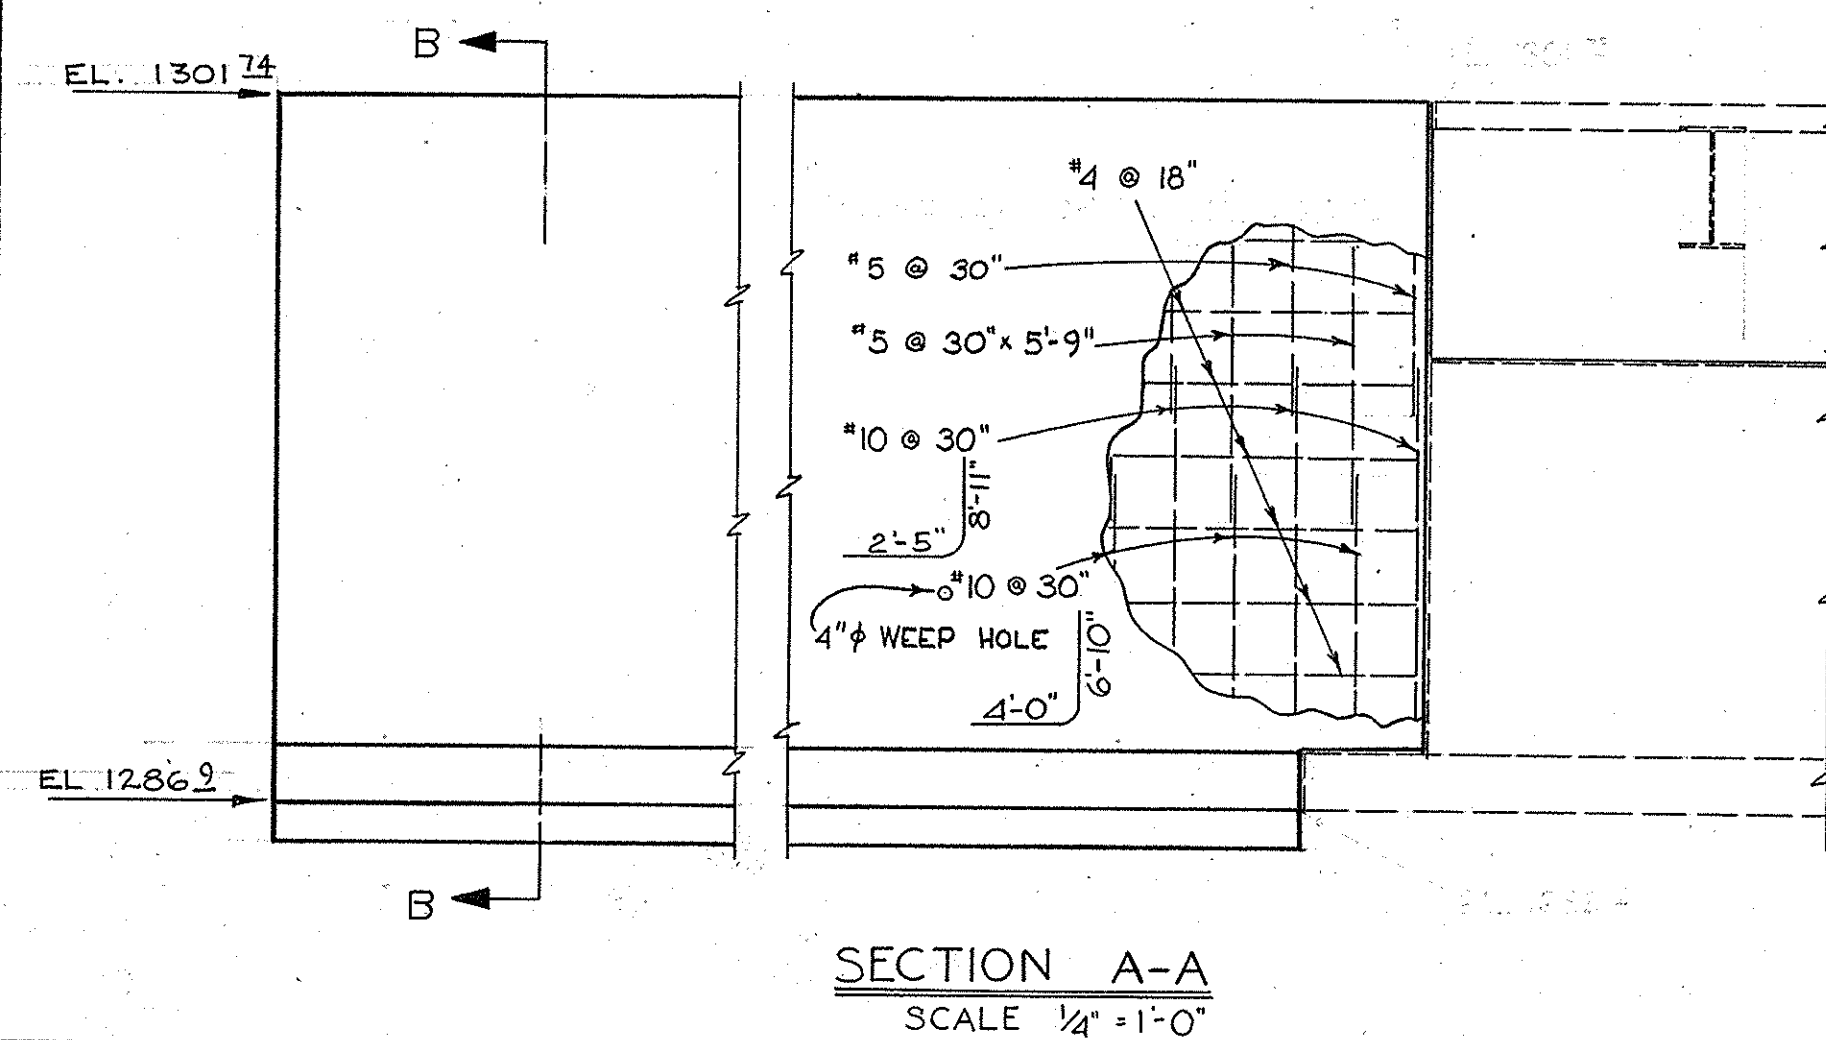


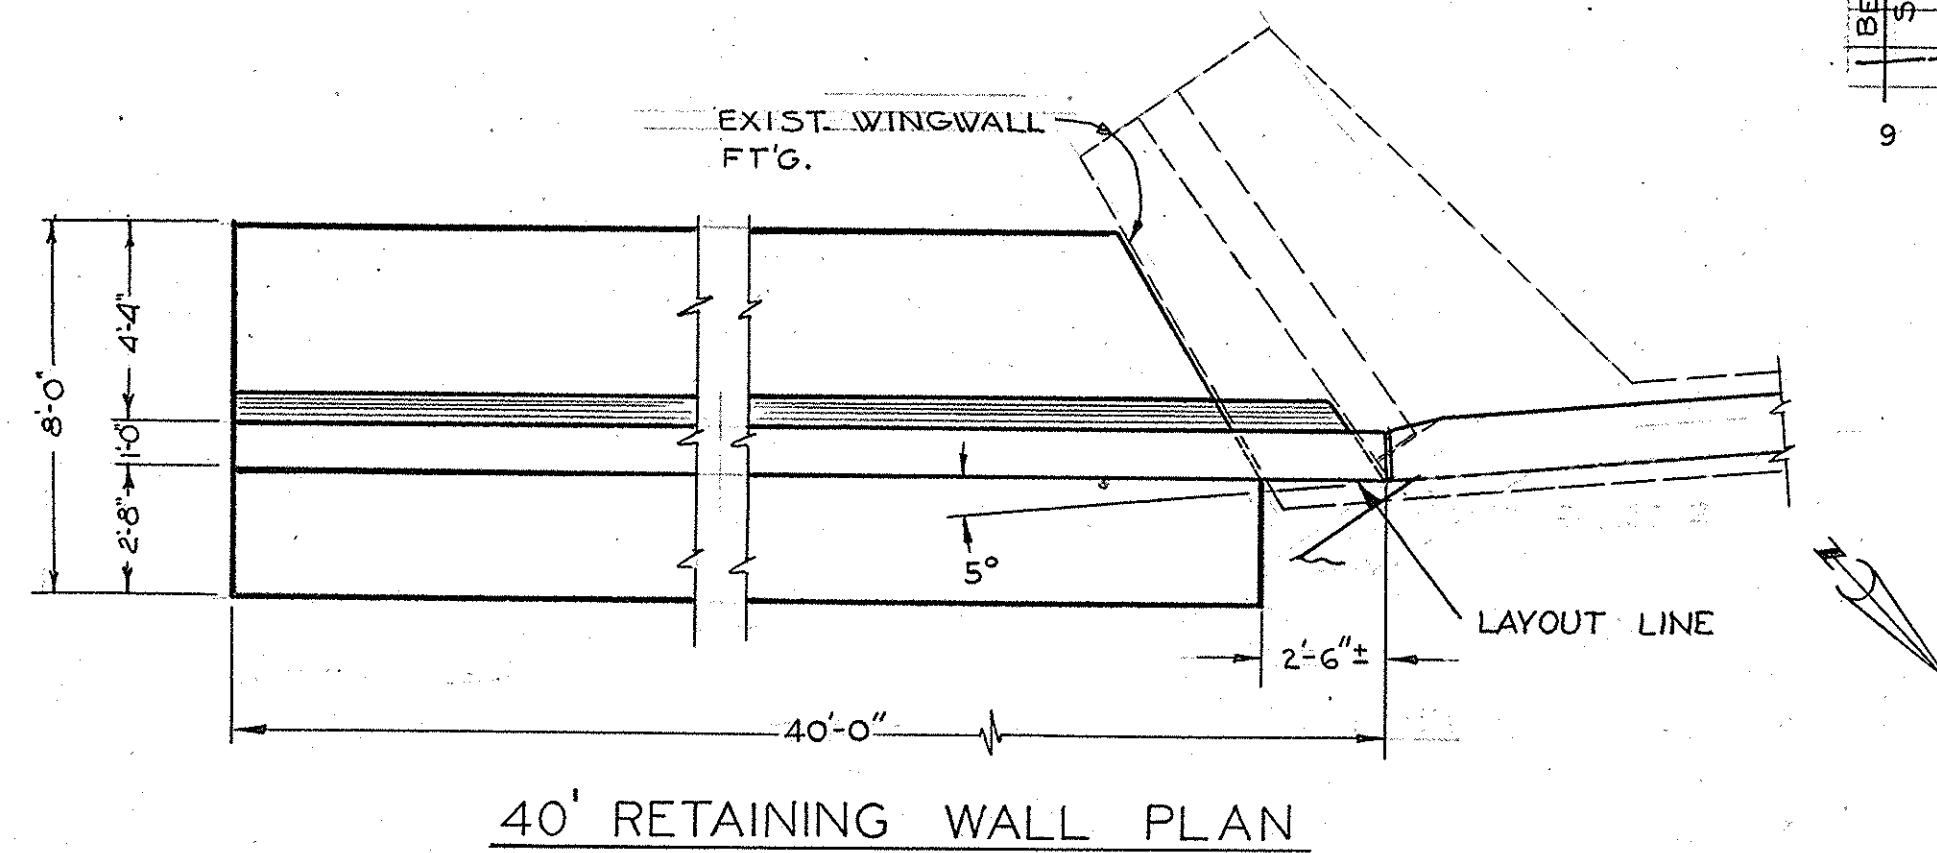

① CURVE DATA

Δ	= 15° 00' 00"
R	= 200'
L	= 53.25'
T	= 26.78'

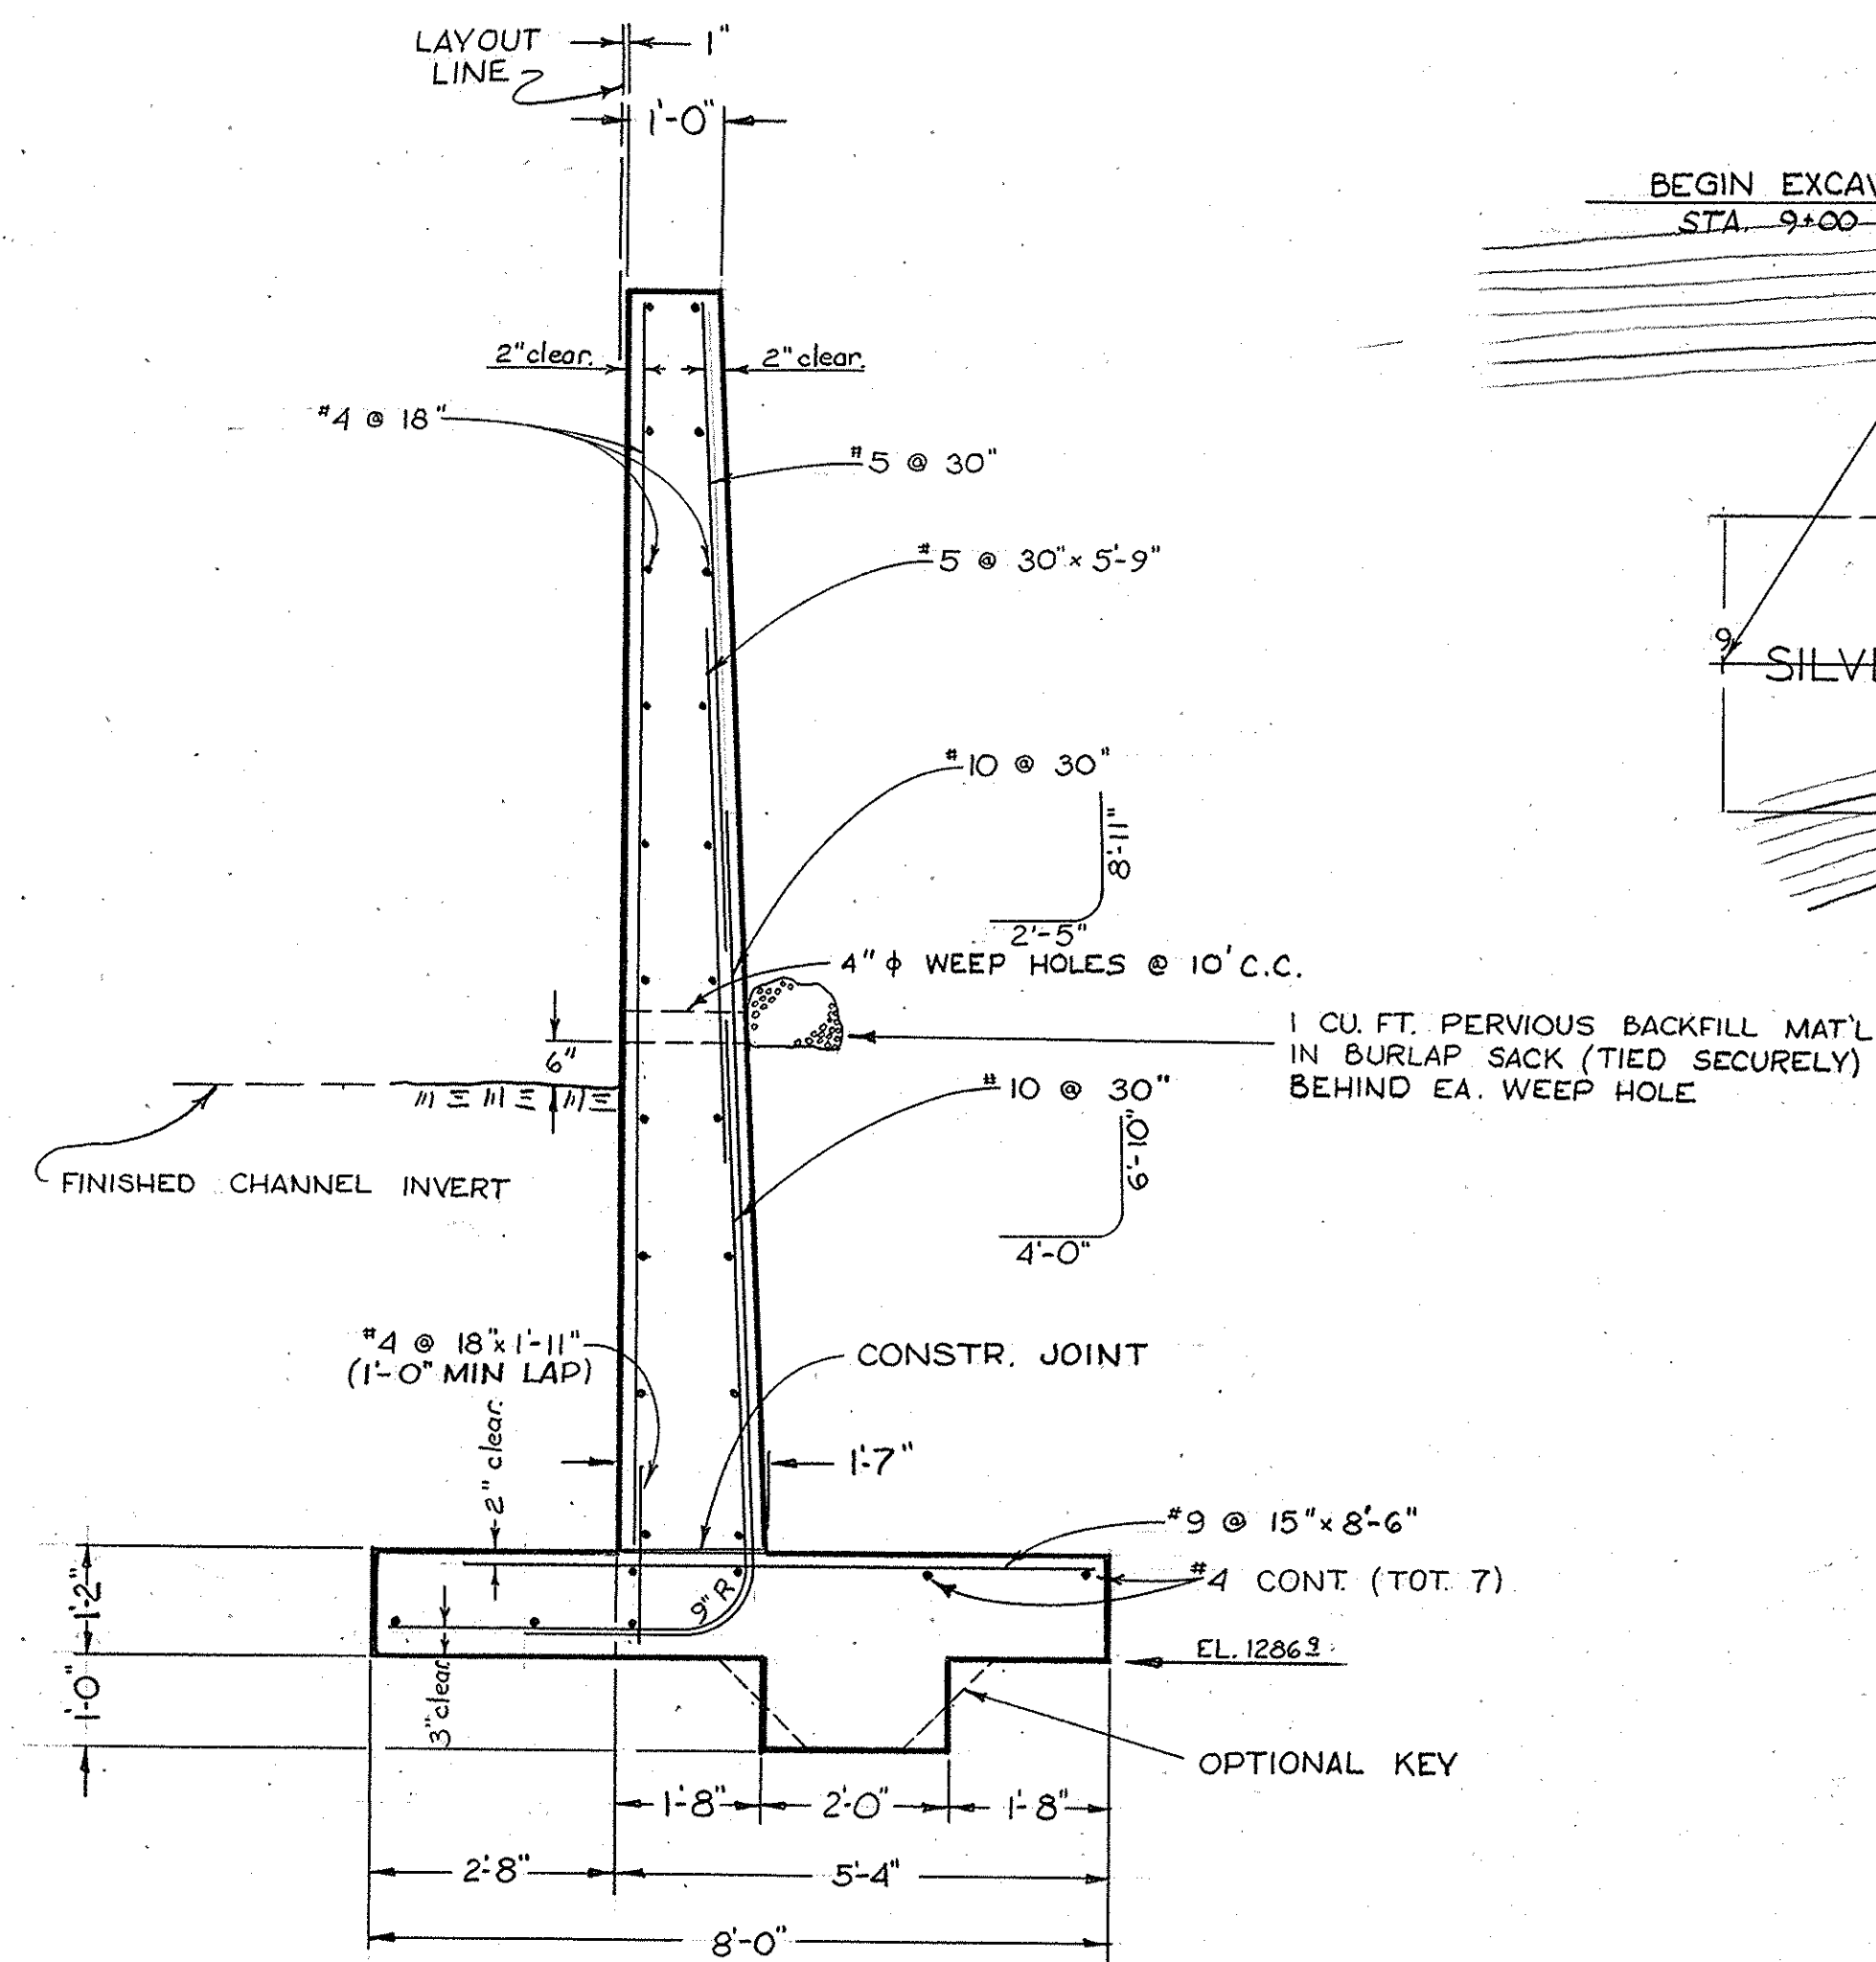