

1/10/10
1/10/10

35 30 25 20 15 10 5 0 5 10 15 20 25 30 35

NOTE: ALL AREAS SHOWN WERE
PLANNED BEFORE
DECISION TO RAVE DETOUR
WAS MADE. NO QUANTITIES
WAS QUANTIFIED.


1305

1300

CUT 0.00 SQ. IN.
FILL 2.73 SQ. IN.

1295

1290

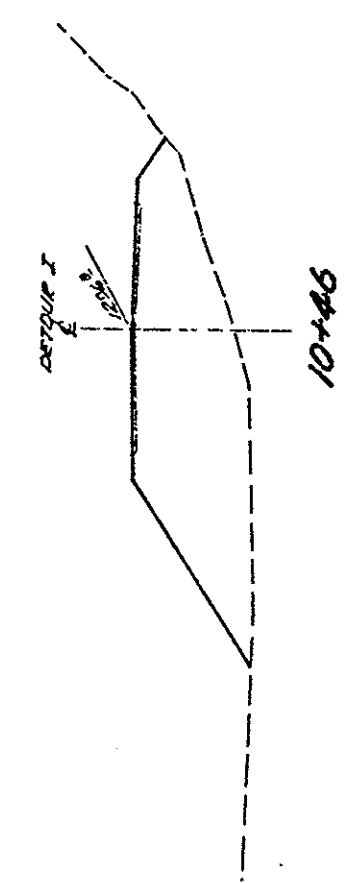

DETOUR REMOVAL (SHADED)
CUT 2.73 SQ. IN.
FILL 0.00 SQ. IN.


1305

1300

CUT 0.00 SQ. IN.
FILL 3.12 SQ. IN.

1295

1290

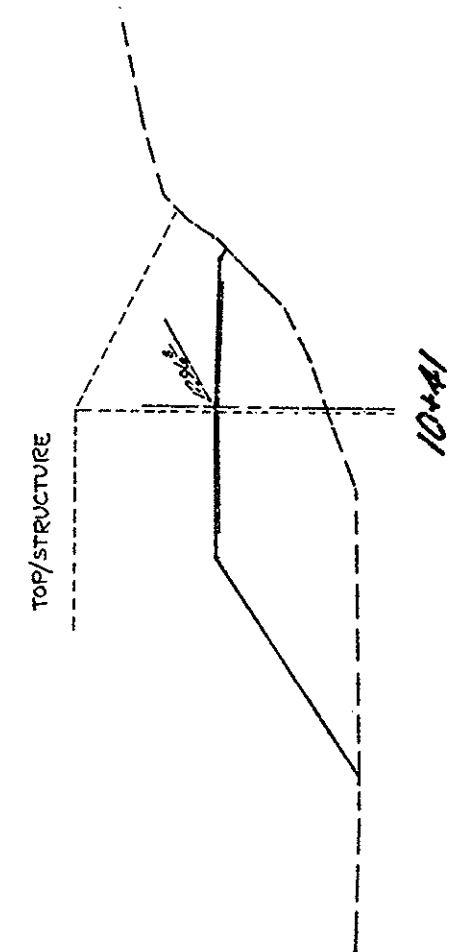

CUT 0.00 SQ. IN.
FILL 3.12 SQ. IN.


1305

1300

CUT 1.18 SQ. IN.
FILL 1.18 SQ. IN.

1295

1290

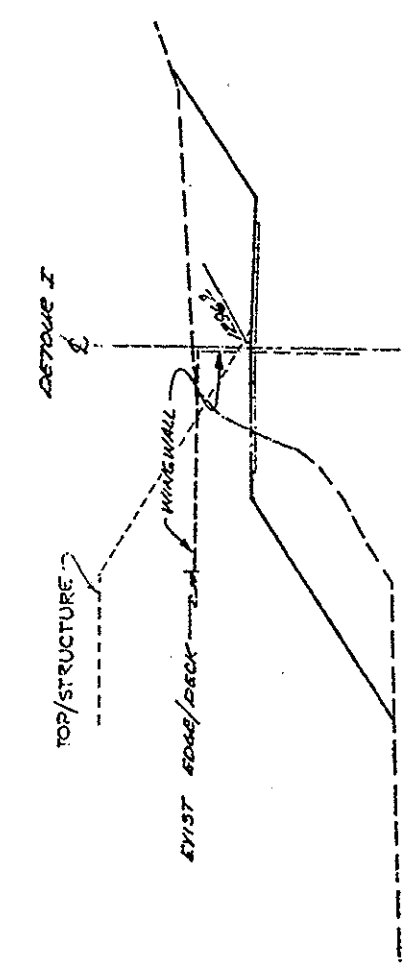


DETOUR REMOVAL (SHADED)
CUT 0.00 SQ. IN.
FILL 1.00 SQ. IN.

1305

1300

CUT 1.62 SQ. IN.
FILL 0.00 SQ. IN.

1295

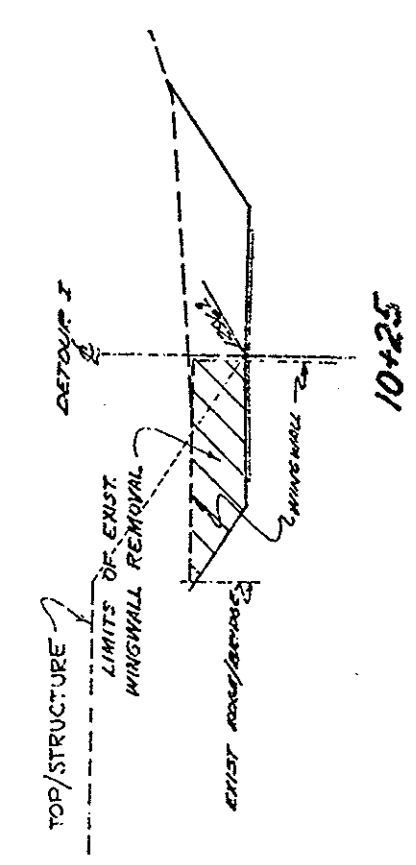


DETOUR REMOVAL (SHADED)
CUT 0.00 SQ. IN.
FILL 0.98 SQ. IN.

1305

1300

CUT 0.90 SQ. IN.
FILL 0.00 SQ. IN.

1295

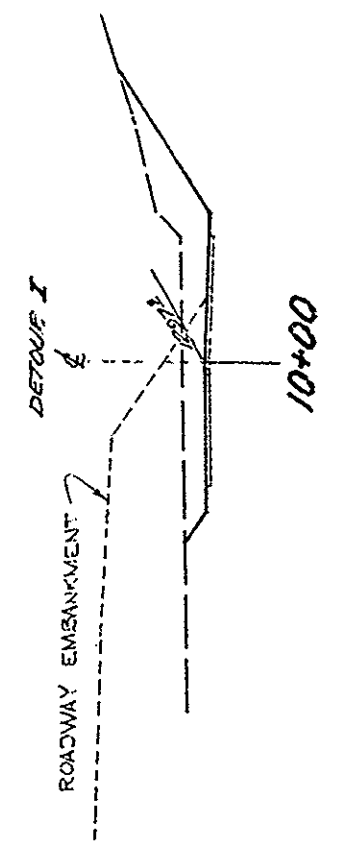


DETOUR REMOVAL (SHADED)
CUT 0.00 SQ. IN.
FILL 0.45 SQ. IN.

1305

1300

CUT 0.18 SQ. IN.
FILL 0.00 SQ. IN.

1295

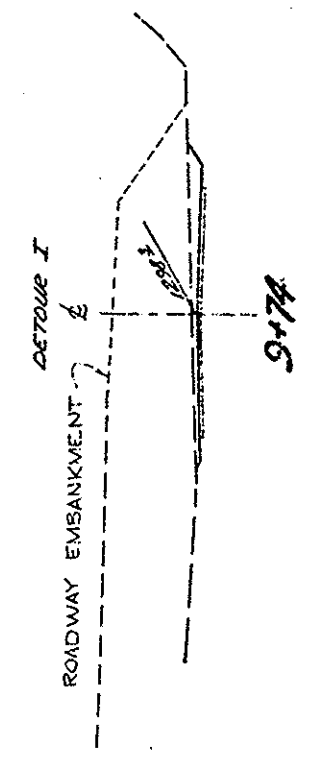


DETOUR REMOVAL (SHADED)
CUT 0.00 SQ. IN.
FILL 0.00 SQ. IN.

1305

1300

CUT 0.02 SQ. IN.
FILL 0.00 SQ. IN.

1295

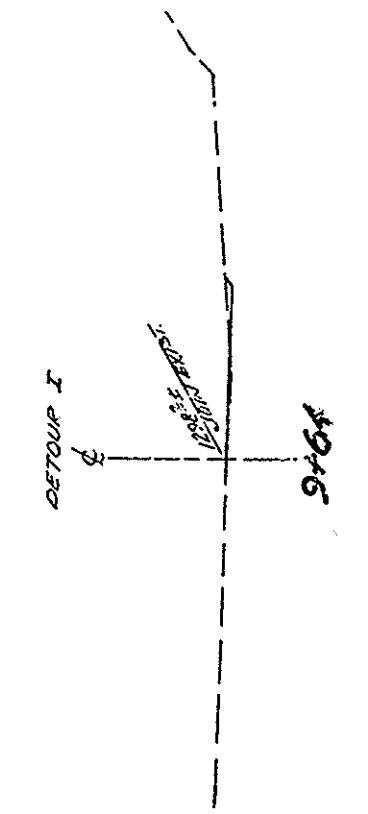

AS BUILT

CONSTRUCTION FILE
Silverado Canyon Road Bridge
Sheet 3 of 19
Red. 22.5:1 Scale: as shown
Velling

SILVERADO CANYON BRIDGE 5/10
10/21/10 (VET) 7-5

35 30 25 20 15 10 5 0 5 10 15 20 25 30 35

EXACT®

STRAIGHT EDGE RULE 84-11