


6/13/74  
4/10/70

35 30 25 20 15 10 5 4 5 10 15 20 25 30 35

NOTE: ALL IDEAS SHOWN WERE  
PUNTERED BEFORE  
DECISION TO HAVE DETOUR  
WAS MADE. ADJUST QUANTITIES  
ACCORDINGLY.

1305  
1300  
1295


CUT ..... SQ. IN.  
FILL ..... SQ. IN.

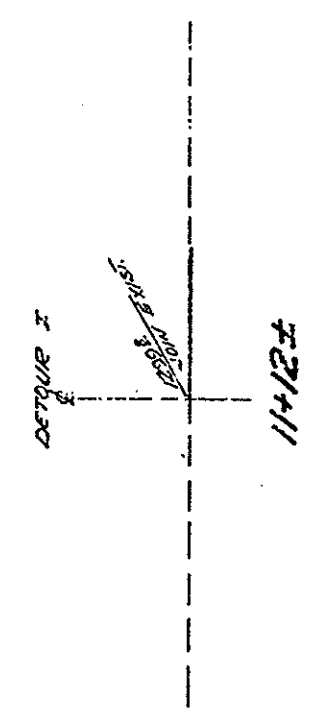

DETOUR REMOVAL (SHADE)  
CUT ..... SQ. IN.  
FILL ..... SQ. IN.

1305  
1300  
1295


CUT ..... SQ. IN.  
FILL ..... SQ. IN.

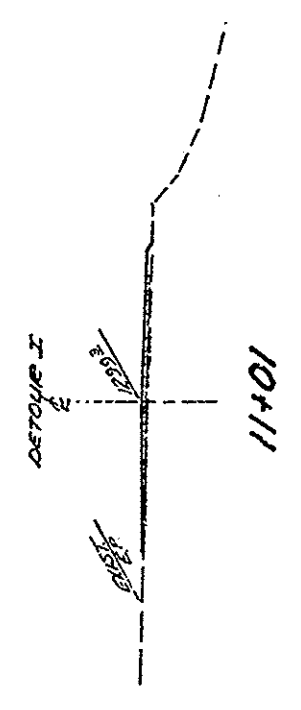

DETOUR REMOVAL (SHADE)  
CUT ..... SQ. IN.  
FILL ..... SQ. IN.

1305  
1300  
1295  
1290

CUT ..... SQ. IN.  
FILL ..... SQ. IN.

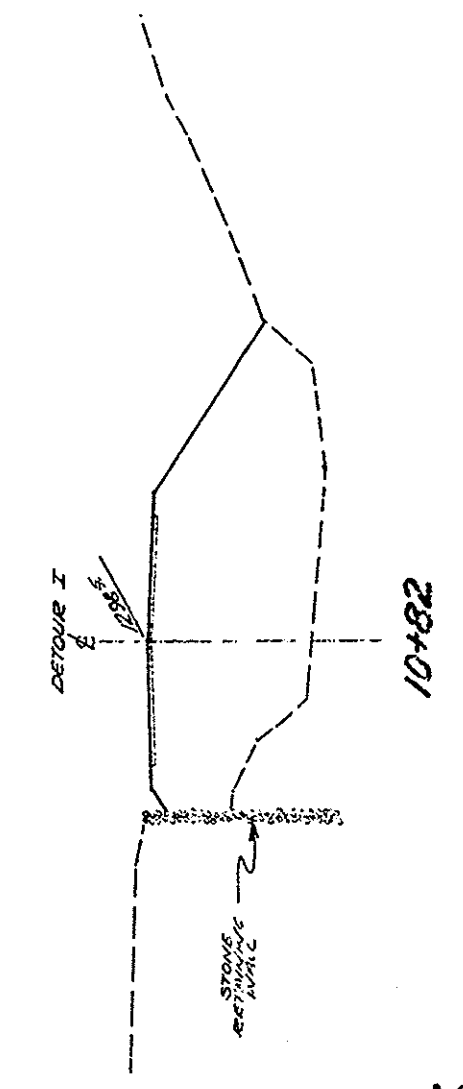


DETOUR REMOVAL (SHADE)  
CUT ..... SQ. IN.  
FILL ..... SQ. IN.

AS BUILT

CONSTRUCTION PLANS  
Silverado Canyon Road Bridge  
Sheet 4 of 19  
Red. 77.5:1 Scale: as shown  
Vall...

1305  
1300  
1295  
1290

CUT ..... SQ. IN.  
FILL ..... SQ. IN.

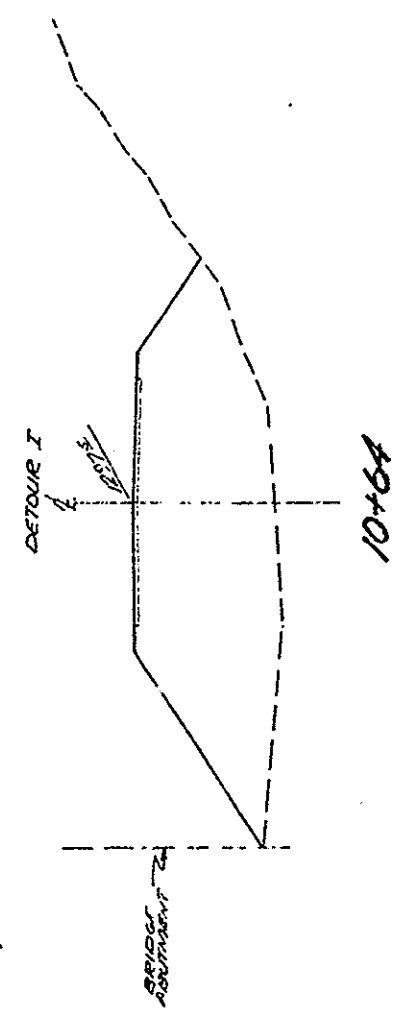

DETOUR REMOVAL (SHADE)  
CUT ..... SQ. IN.  
FILL ..... SQ. IN.

SILVERADO CANYON RD. BRIDGE 34-10  
100' FEET 1"=5'

35 30 25 20 15 10 5 4 5 10 15 20 25 30 35