






6/10/60
J.S.
J.R.

35 30 25 20 15 10 5 6 10 15 20 25 30 35

EXACT®


STRAIGHT EDGE RULE SE-48

NOTE: ALL AREAS SHOWN WERE
PLANIMETERED BEFORE
DECISION TO PAVE DETOUR
WAS MADE. ADJUST QUANTITIES
1:200000/100.

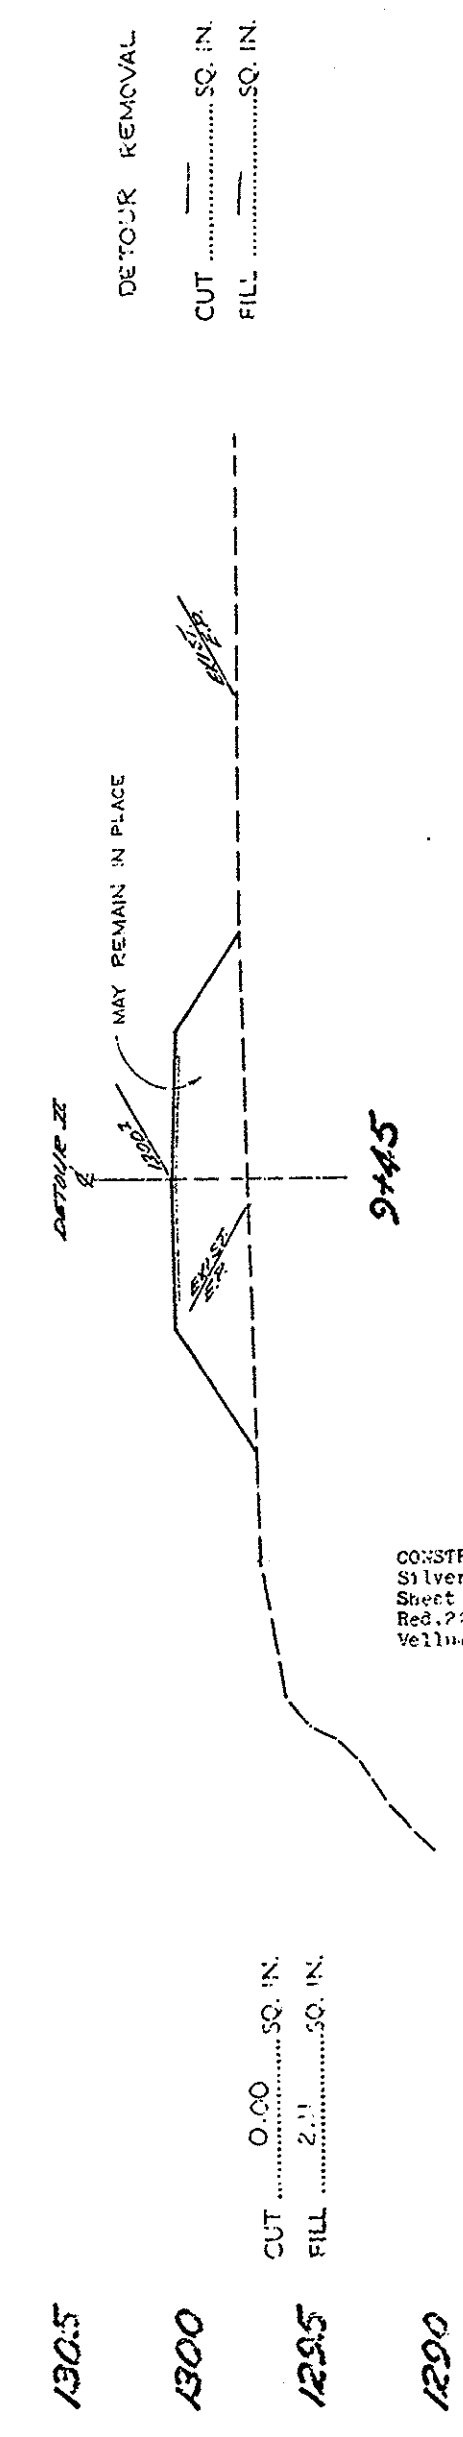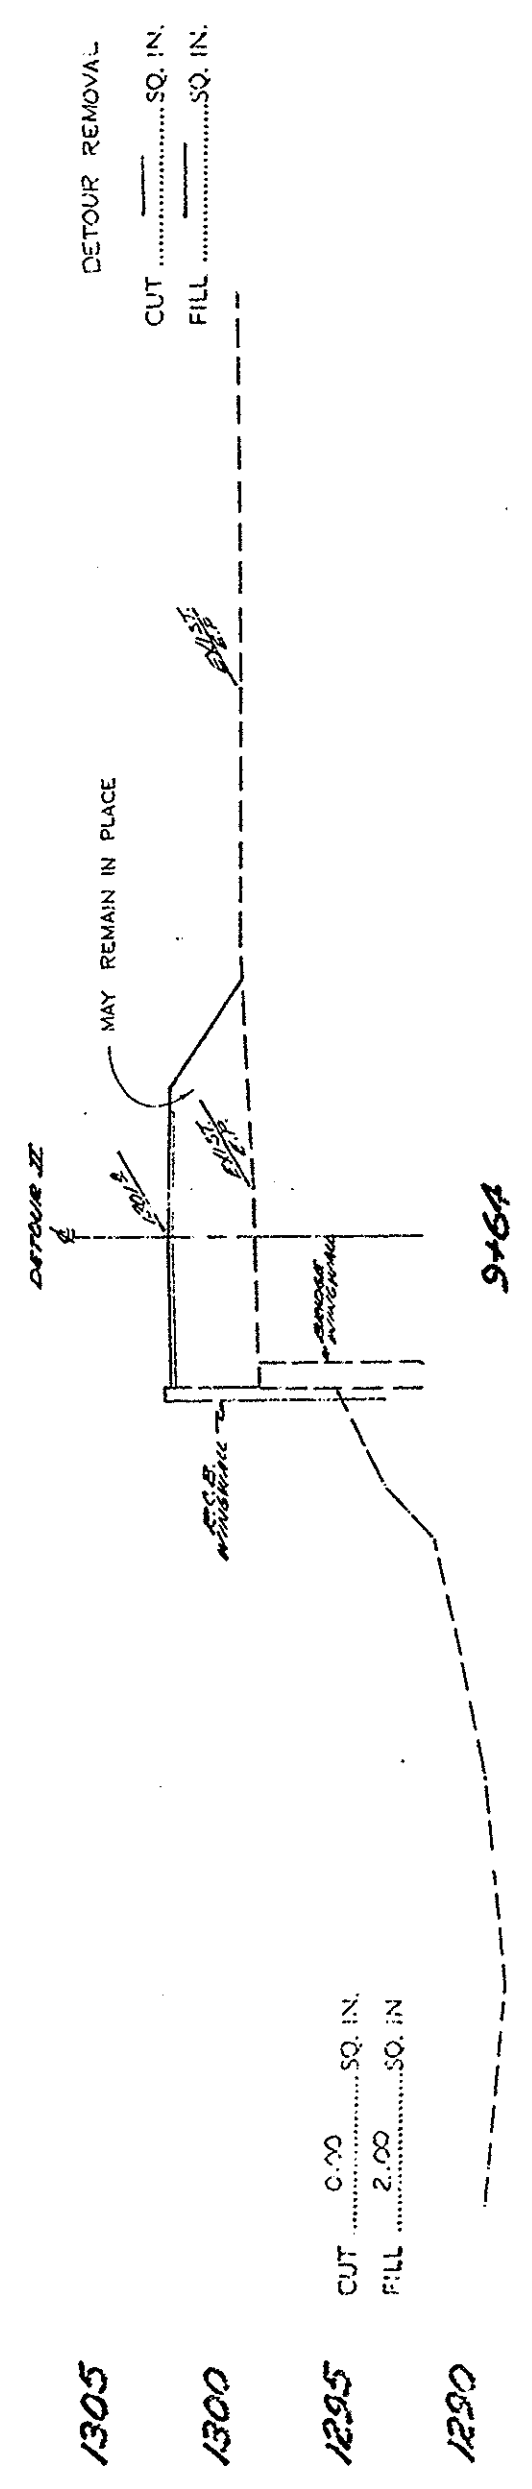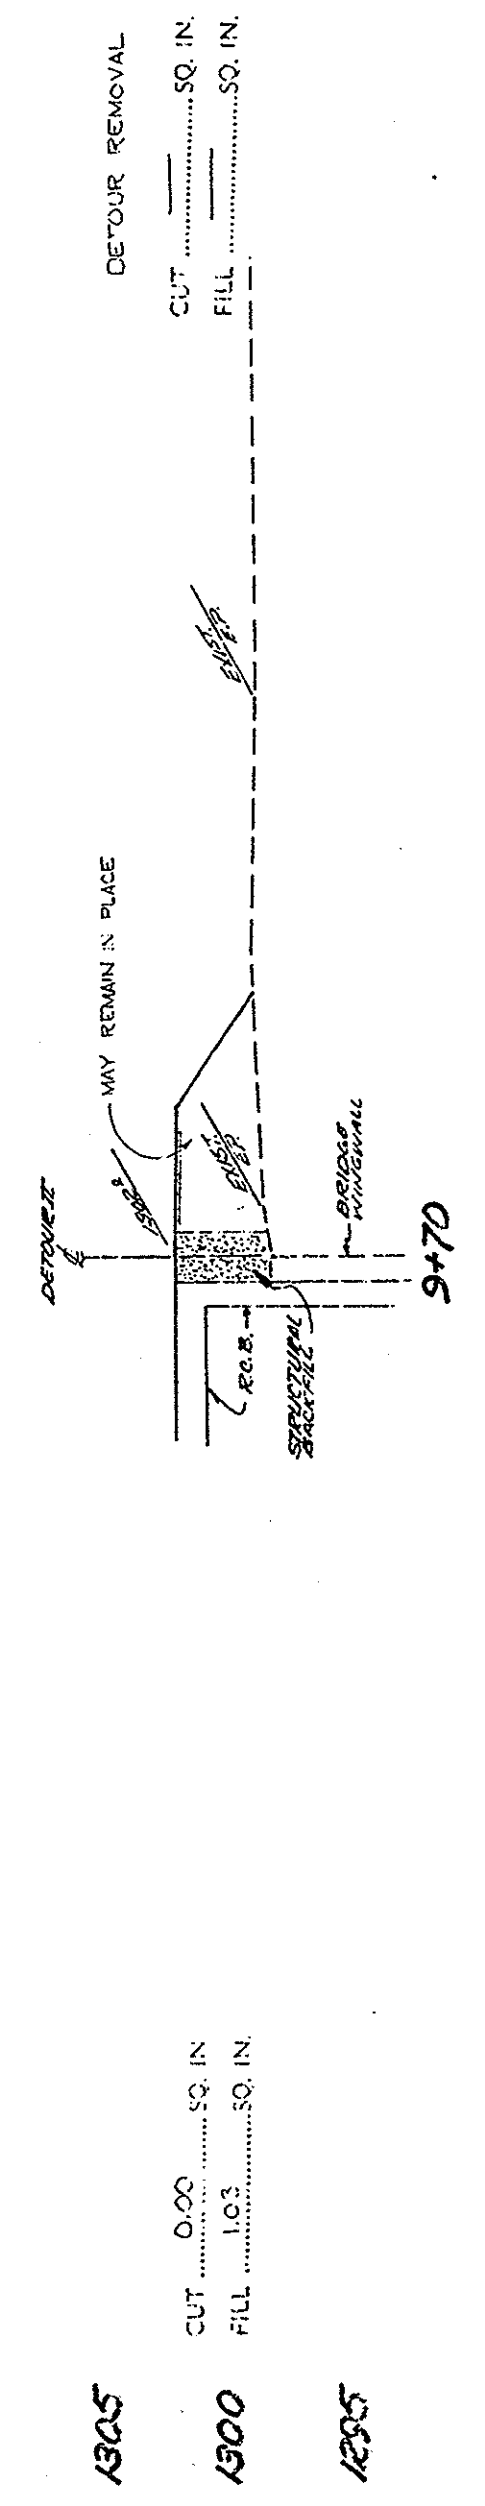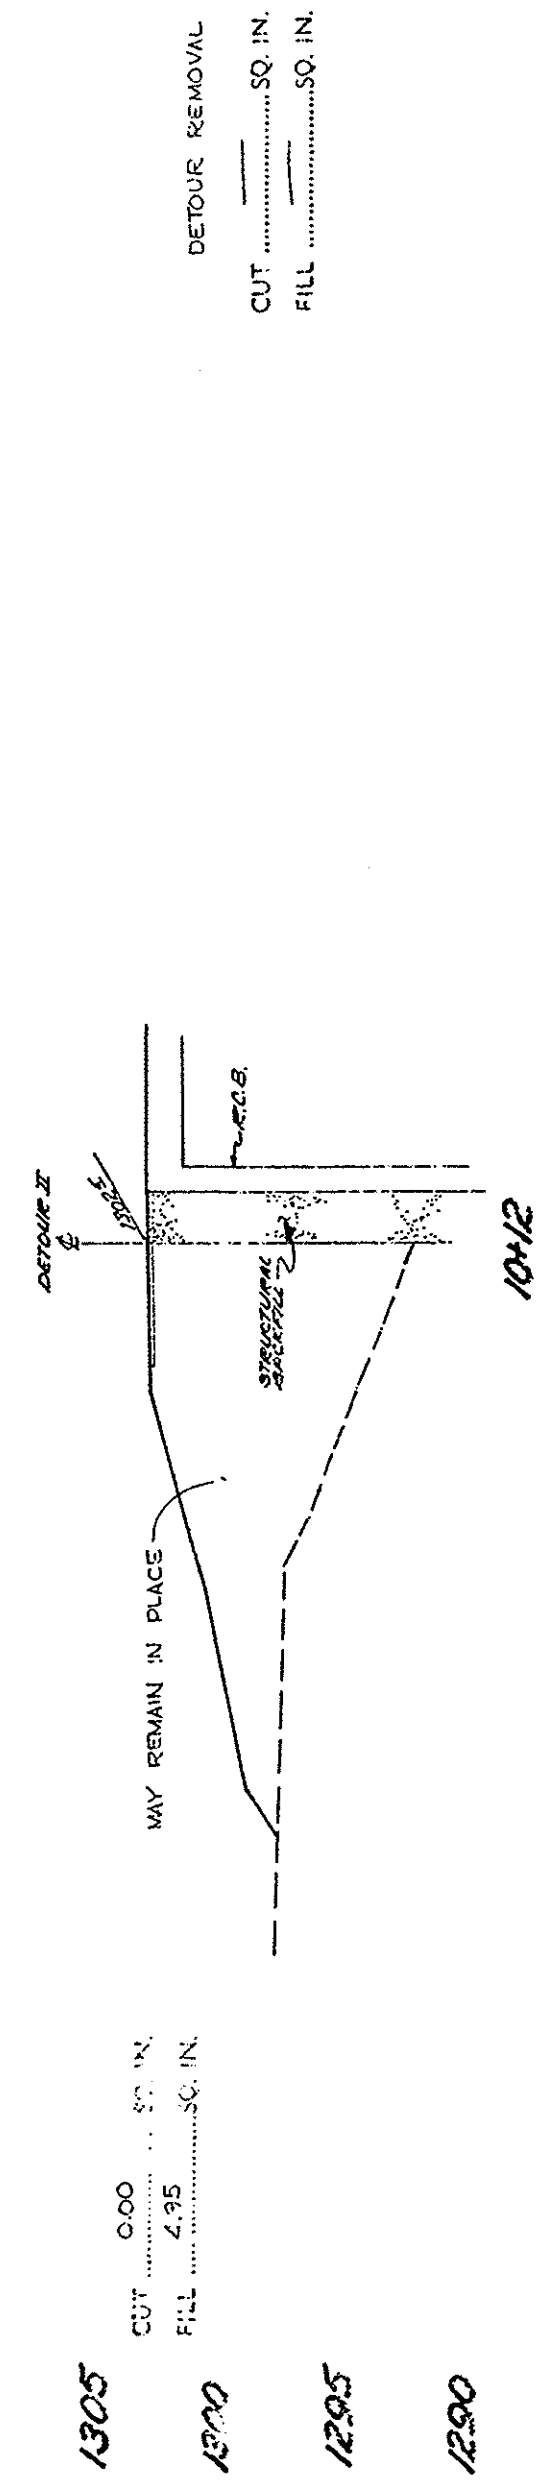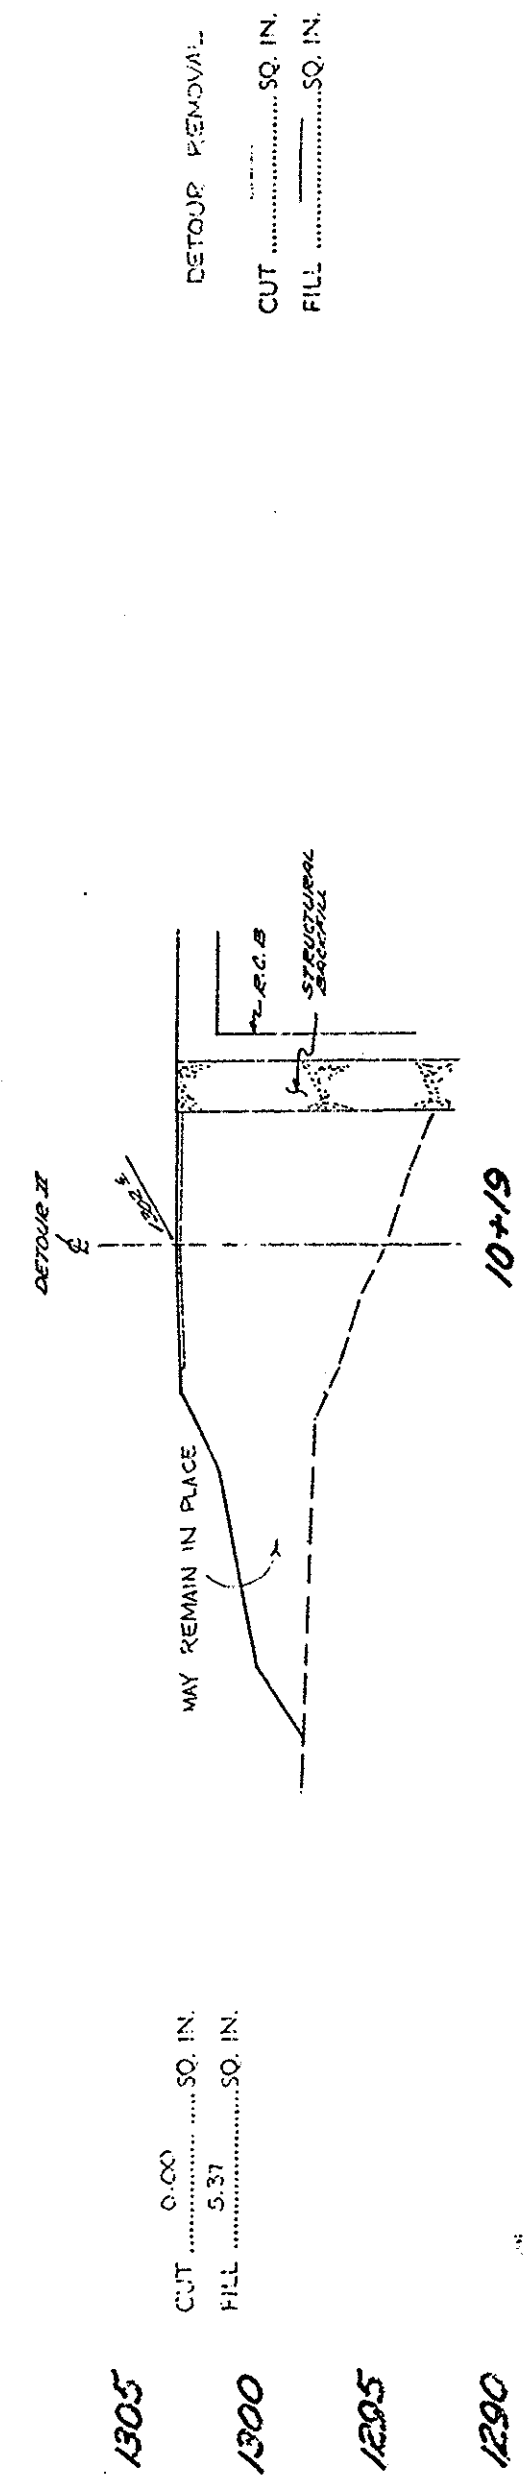

AS BUILT

CONSTRUCTION PLANS
Silverado Canyon Road Bridges
Sheet 5 of 19
Red. 22.5:1 Scale: as shown
Velling

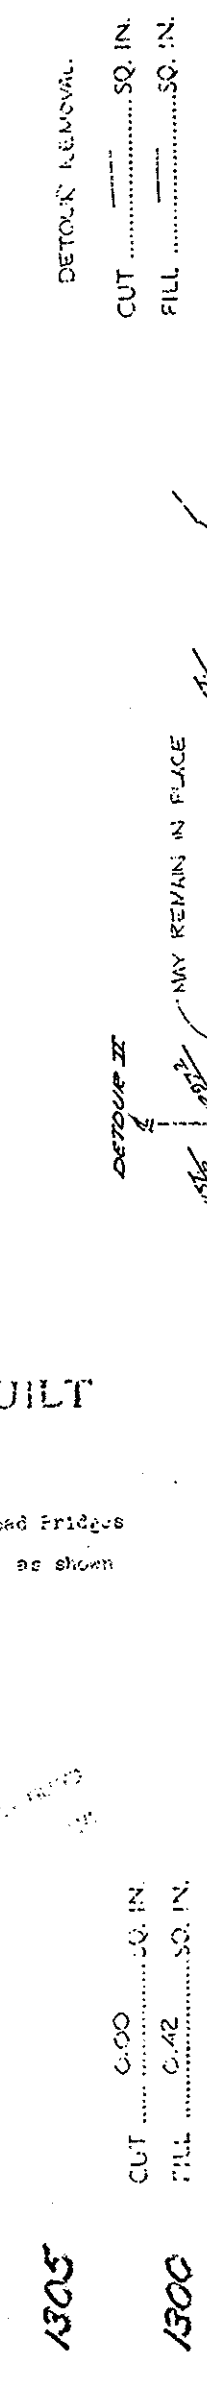

SILVERADO CANYON RD. BRIDGE 5110
MAY 1960 1"=5' 5

35 30 25 20 15 10 5 6 10 15 20 25 30 35