

EXACT®

STRAIGHT EDGE RULE SE-48

NOTE: ALL AREAS SHOWN WERE
PLANIMETERED BEFORE
DESIGN TO FIVE TENTHS
WAS MADE. ADJUST QUANTITIES
ACCORDINGLY.

CUT SQ. IN.
FILL SQ. IN.

CUT SQ. IN.
FILL SQ. IN.

CUT SQ. IN.
FILL SQ. IN.








DETOUR REMOVAL (SHADED)
CUT SQ. IN.
FILL SQ. IN.

DETOUR REMOVAL (SHADED)
CUT SQ. IN.
FILL SQ. IN.

DETOUR REMOVAL (SHADED)
CUT SQ. IN.
FILL SQ. IN.

DETOUR REMOVAL
CUT SQ. IN.
FILL SQ. IN.

SILVERADO CYN. RD. BRIDGE 54-10
ADDITIONAL 1"=5'

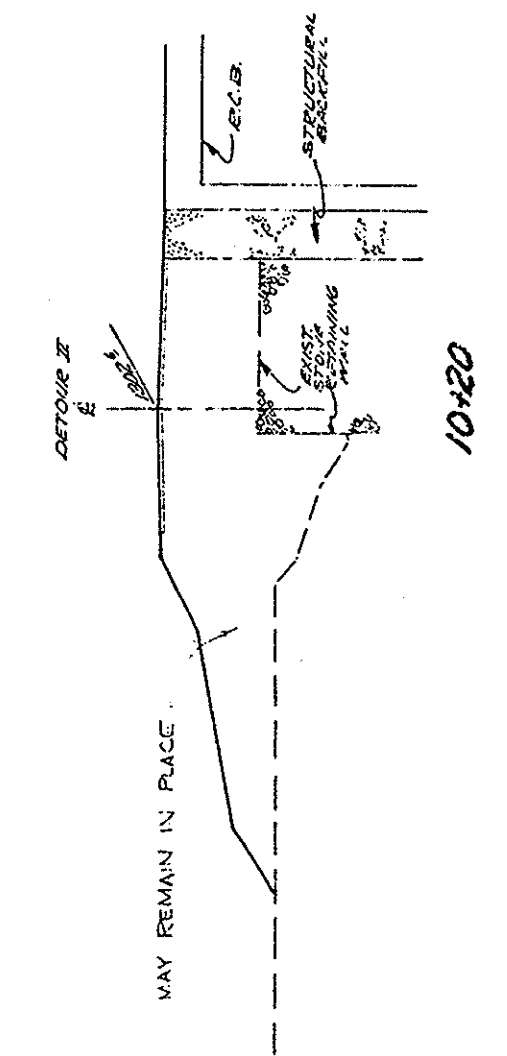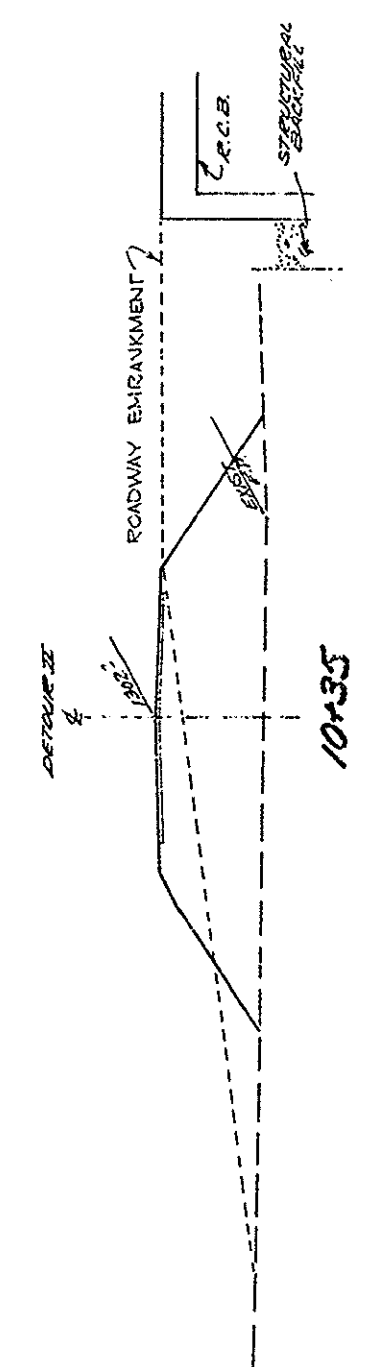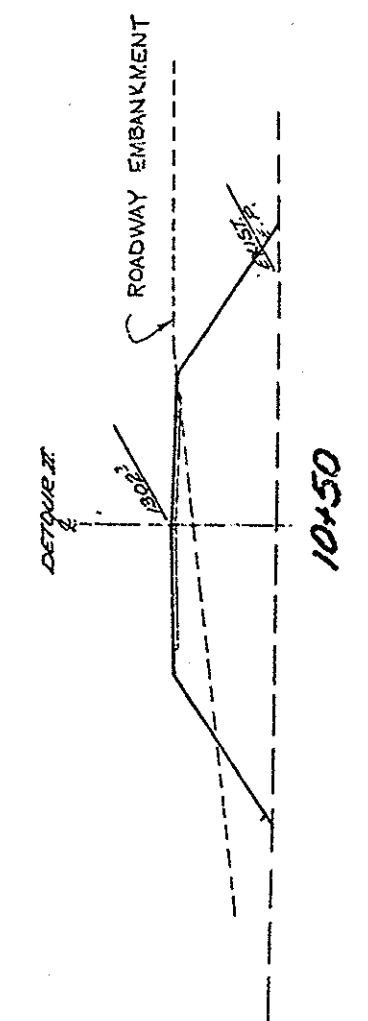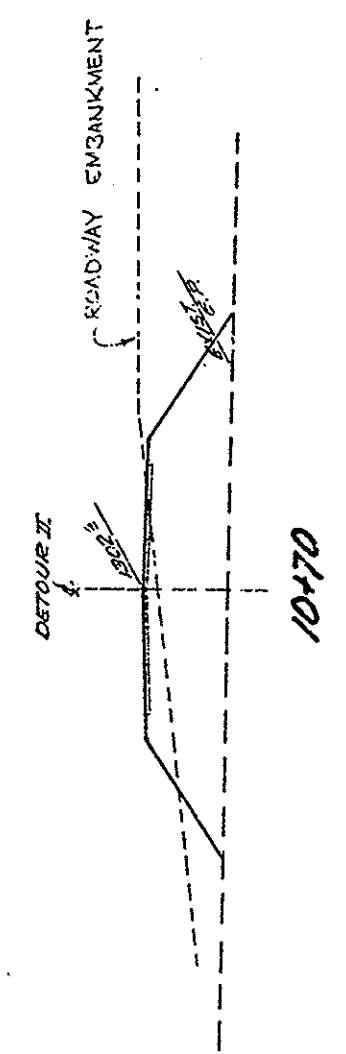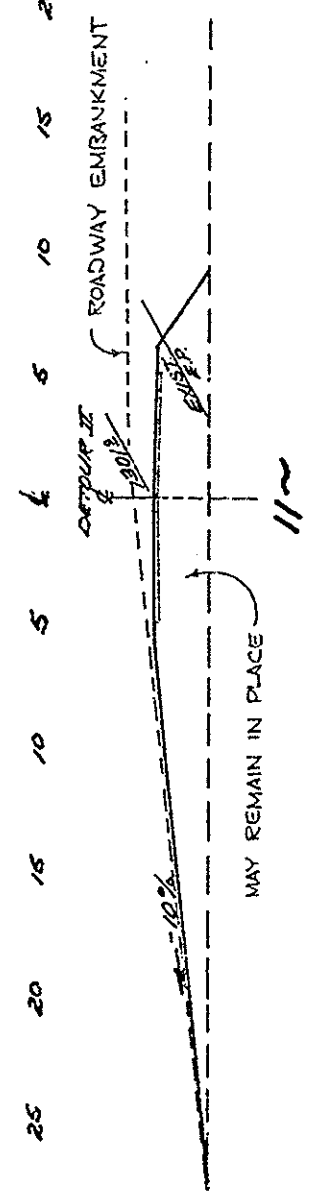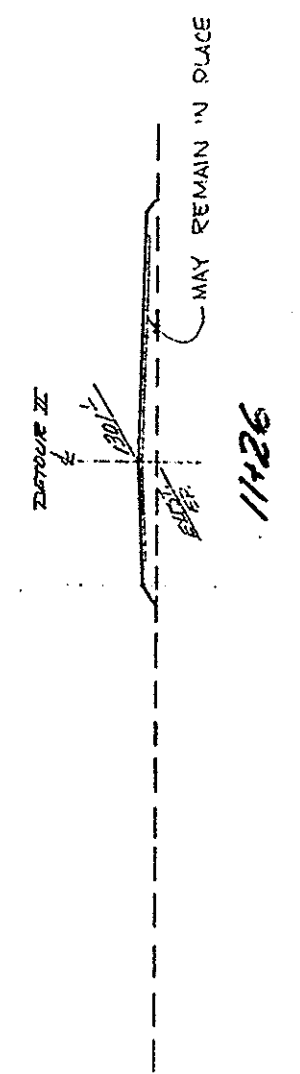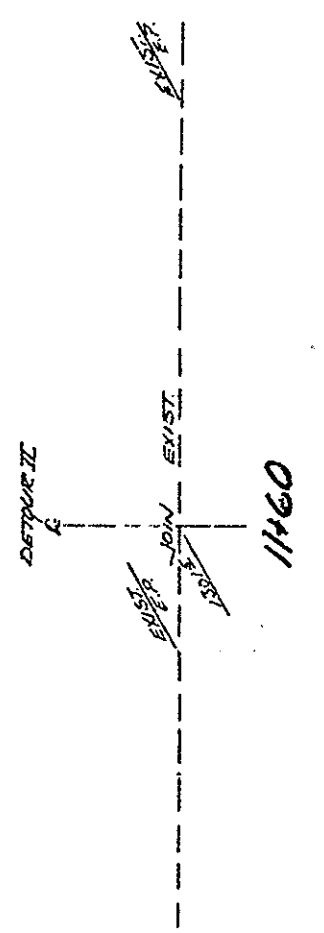

1305
1300

1305
1300
1295

1305
1300
1295

1290

AS BUILT

CONSTRUCTION PLANS
SILVERADO CYN. RD. BRIDGES
Sheet 6 of 10
Red. 22.5' Scale: as shown
Vel. 10'