


NOTE: ALL AREAS SHOWN WERE
PLANNED BEFORE
DECISION TO PAVE DE-
TOUR WAS MADE. ADJUST
QUANTITIES ACCORDINGLY.

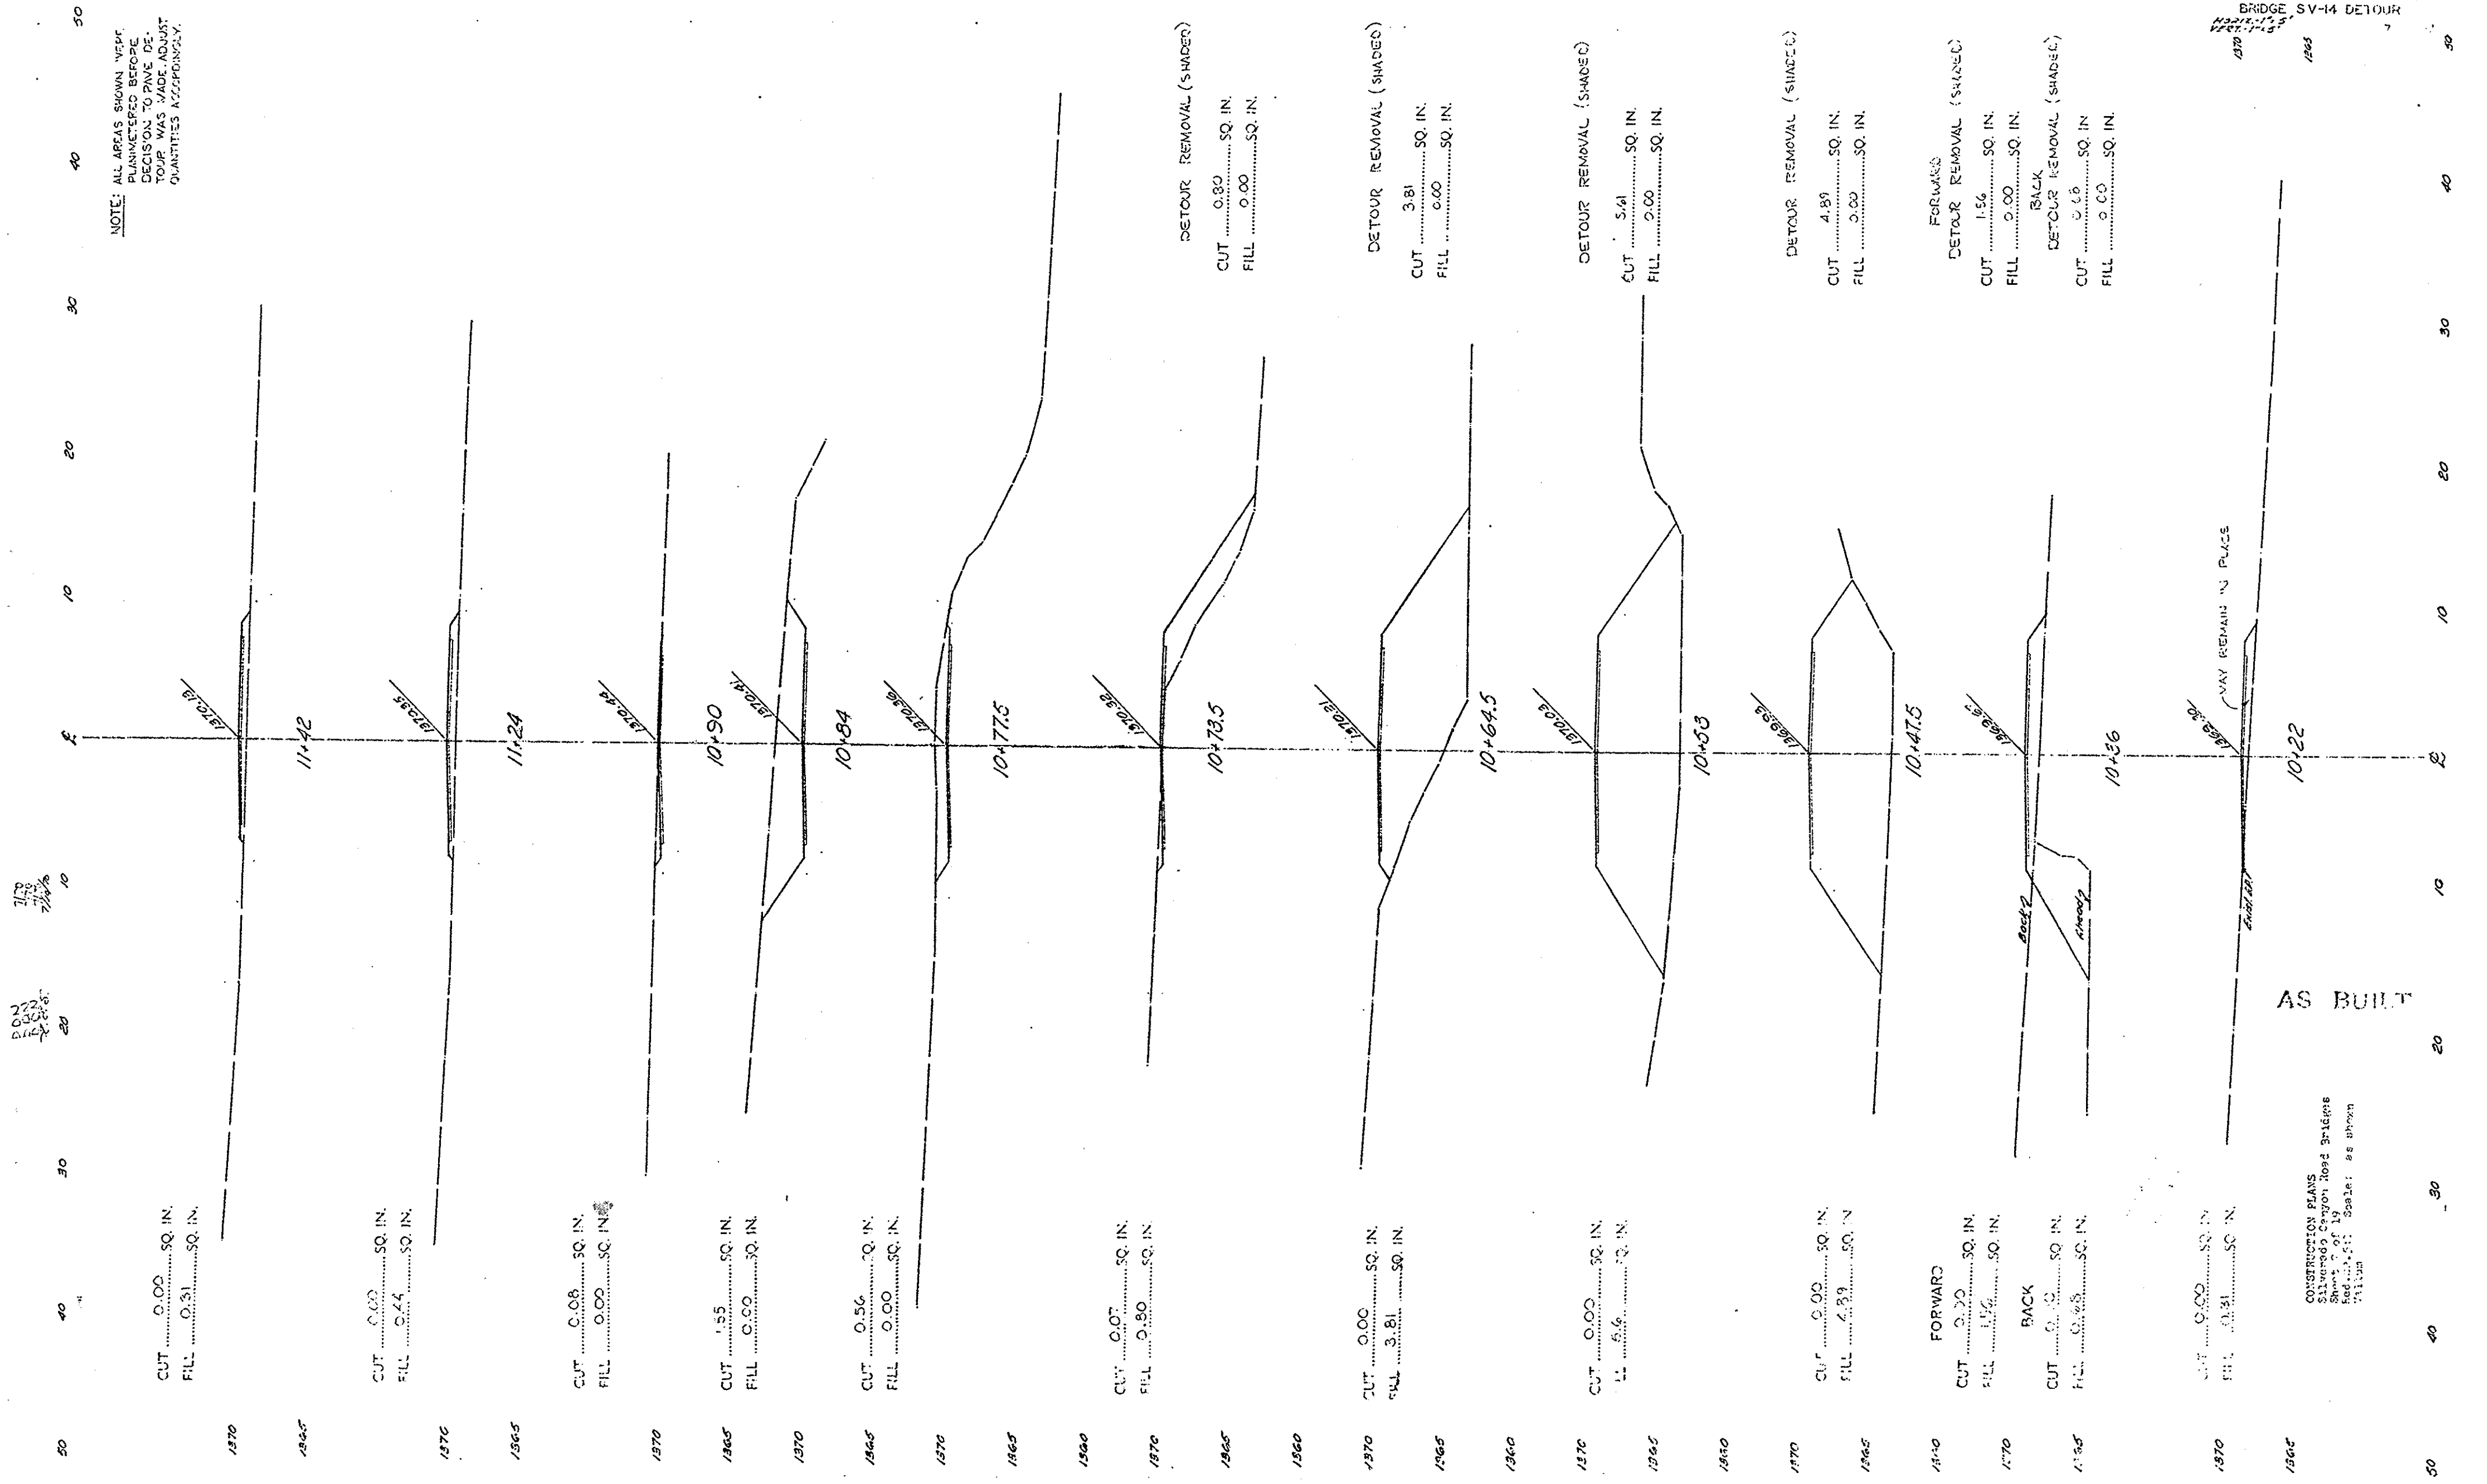

SILVERADO CANYON RD.
BRIDGE SV-14 DETOUR

AS BUILT

CONSTRUCTION PLANS
Silverado Canyon Road Bridge
Federal Highway Administration
Scale: as shown