


000

Ly
O
C
T


1290

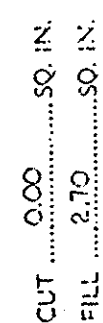

1388


1295

0621

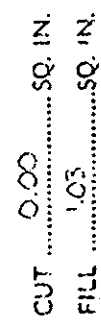

82


22

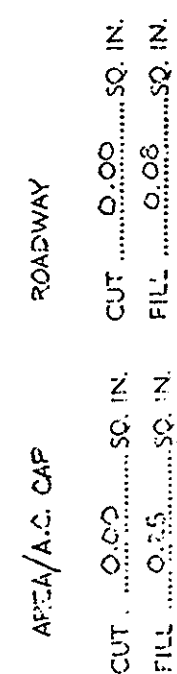

0031

333


002

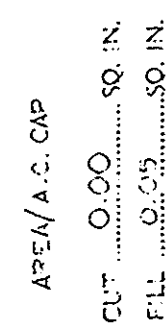

205

1290

123

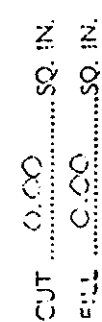

1295

1200

53

AS BUILT

CONSTRUCTION PLANS
Silverado Canyon Road Bridge
Sheet 18 of 19
Red.22.5:1 Scale as shown
yellow

[illegible]