



SILVERADO CYN. RD. BRIDGE SV-10
HORIZ. & VERT. 1"=5'-0"

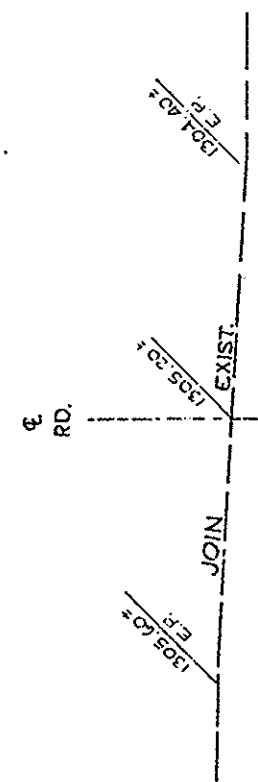


STA 12+50

CUT 0.00 SQ. IN.
FILL 0.00 SQ. IN.

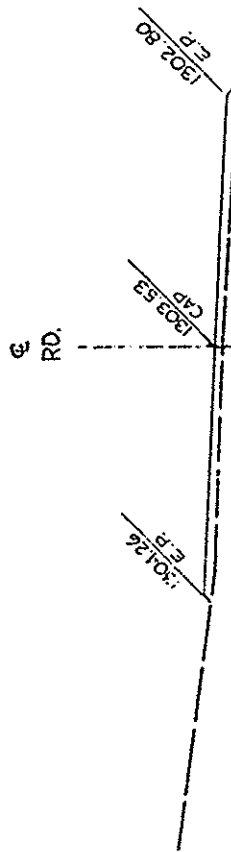

STA 12+00

A.C. CAP
CUT 0.00 SQ. IN.
FILL 0.32 SQ. IN.

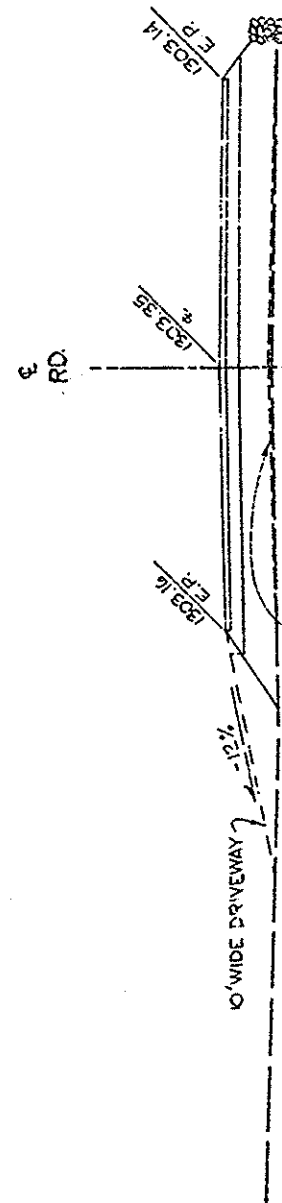

STA 11+50


CUT 0.00 SQ. IN.
FILL 1.20 SQ. IN.

FORWARD


CUT 0.00 SQ. IN.
FILL 0.31 SQ. IN.

BACK

CUT 0.00 SQ. IN.
FILL 2.98 SQ. IN.

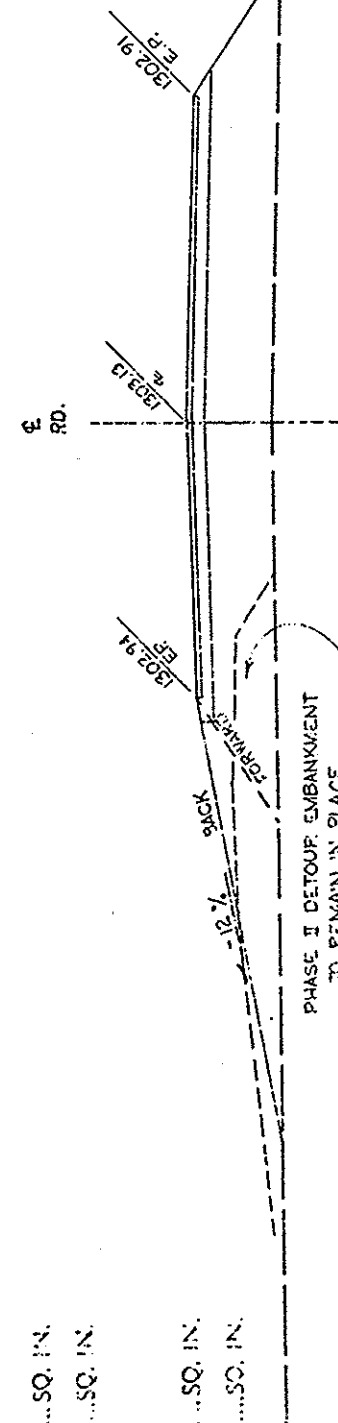


STA 11+10

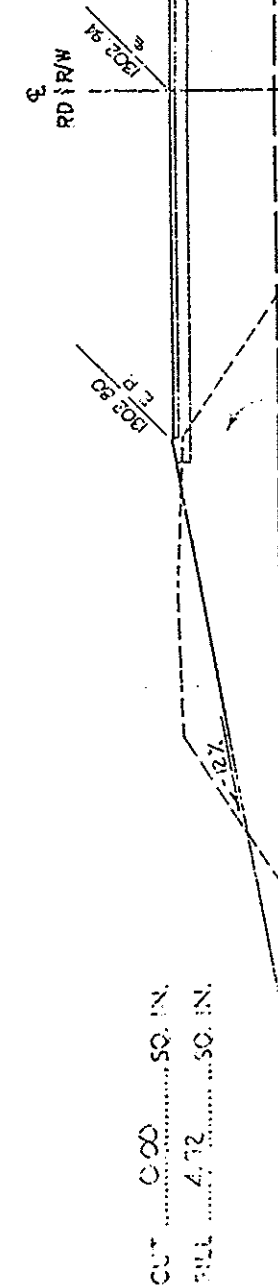

STA 10+40

CUT 0.00 SQ. IN.
FILL 2.72 SQ. IN.

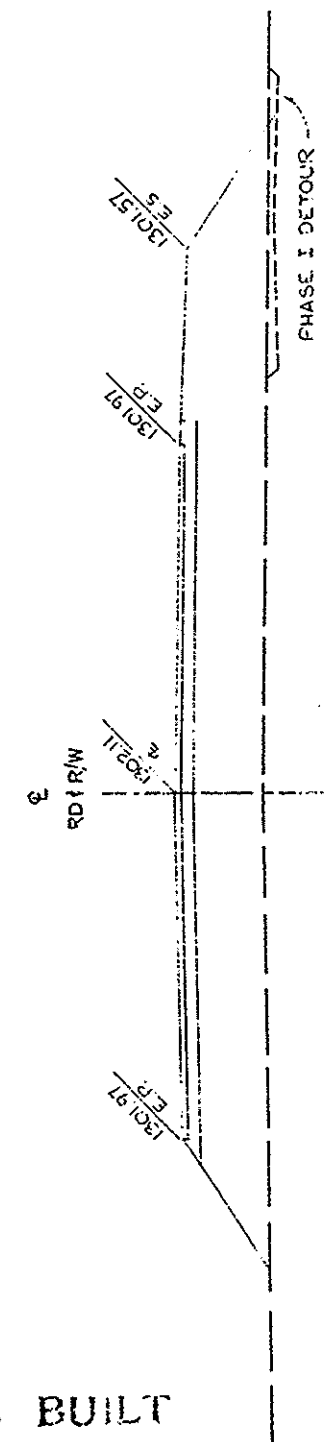

STA 9+82

CUT 0.00 SQ. IN.
FILL 2.72 SQ. IN.

AS BUILT

CONSTRUCTION PLANS
Silverado Canyon Road Bridges
Sheet 11 of 19
Scale: as shown
Veluma